



June 9, 2020

U.S. Environmental Protection Agency
RGP NOI Processing
5 Post Office Square, Suite 100
Mail Code OEP06-4
Boston, MA 02109-3912

**RE: *Notice of Intent (NOI) for Remediation General Permit Discharge
Proposed Stormwater Management System Improvements
Logan International Airport
Boston, Massachusetts
SAGE Project No. M948***

To Whom It May Concern:

On behalf of Bond Civil & Utility Construction, Inc. (BOND), SAGE Environmental, Inc. (SAGE) has prepared this Notice of Intent (NOI) for coverage under the National Pollutant Discharge Elimination System (NPDES) Remediation General Permit (RGP), Massachusetts General Permit (MAG910000), for the discharge of construction dewatering effluent to the Boston Main Channel of the Boston Inner Harbor through the Porter Street Outfall *via* Massport's Logan International Airport (Logan) storm drainage system. The temporary construction dewatering discharge will occur during stormwater management system improvements at Logan in Boston, Massachusetts (hereinafter referred to as the "Project Site"). The Project Site is located upon Logan off Prescott Street and is proximal to an existing fueling storage and distribution facility with associated paved driveway areas. The Project Site location is depicted on an United States Geological Survey (USGS) Quadrangle Project Site Location Map provided as **Figure 1**. A Project Site Plan, which depicts the excavation limits, is included as **Figure 2**.

Portions of the work will be within the limits of an existing Massachusetts Department of Environmental Protection (MassDEP) Disposal Site identified by Release Tracking Number (RTN) 3-13537. A Class A-2 Response Action Outcome (RAO) (i.e., Permanent Solution with No Conditions) was filed for the Disposal Site in 2003, following remedial actions which included excavation and off-site disposal of jet fuel impacted soils. Contaminants of concern (COCs) detected during source water groundwater sampling include inorganics and fuel parameters. Therefore, the project is eligible for discharge as an RGP Activity Category III-A/F and Water Quality Based Effluent Limitations (WQBELs) for Contamination Type A and F apply. The completed NOI form is included as **Attachment A**.

Owner and Applicant/Operator Information

The contact name, address, and telephone number for the current Project Site owner are listed below:

Massport
Ms. Rosanne M. Joyce
One Harborside Drive
East Boston, Massachusetts 02128
Office: (617) 568-3516
Email: RJoyce@massport.com

Please note, Massport is the owner of Logan, a portion of which the Project Site is located. However, Massport is not the Project Site Owner or Operator and is not a co-permittee.

The applicant/operator for this NOI RGP application is:

BOND Civil & Utility Construction, Inc.
Ms. Tara Canavan
10 Cabot Road, Suite 300
Medford, Massachusetts 02155
Office: (617)-394-6368
Email: tcavanaugh@bond-civilutility.com

Please note, BOND is a co-permittee as the applicant/operator.

The project owner for the Project Site is:

Delta Air Lines
Ms. Emily Smith
Chair – BOSFuel Corporation
Dept. 857
1030 Delta Boulevard
Atlanta, Georgia 30354
Office: (404) 773-4469
Email: Emily.L.Smith@delta.com

Please note, BOSFuel Corporation is a co-permittee as the project owner.

The general contractor/design-builder for the Project Site, who on behalf of BOSFuel Corporation (BOSFuel) has operational control over the construction plans and specifications is:

Burns & McDonnell
Mr. Kenneth M. Bilson, P.E.
3650 Mansell Road, Suite 300
Alpharetta, Georgia 30022
Office: (770) 510-4578
Email: kmbilson@burnsmcd.com

Proposed Scope of Construction Activities

This NOI has been prepared for discharge of dewatering effluent during stormwater management system improvements. The overall project consists of the following construction activities:

1. Construction of a pre-fabricated metal equipment enclosure;
2. Installation of a 10,000-gallon underground oil/water separator (OWS) measuring approximately 8 feet in diameter and 30 feet in length;
3. Placement of an underground transfer pump;
4. Installation of a 5,000-gallon underground OWS measuring approximately 6 feet in diameter and 15 feet in length; and
5. Installation of two (2) underground wastewater off-load vaults, each measuring approximately 10 feet by 15 feet and installed at a depth of 15 feet below ground surface (bgs).

The plan set for the project is provided as **Attachment B**.

Project Site History and Project Site Environmental Setting

Portions of the Project Site are within the limits of an existing MassDEP Disposal Site, concerning a release of jet fuel, identified by RTN 3-13537. In 2003, following remedial actions that included excavation and off-site disposal of petroleum impacted soil, a Class A-2 RAO was filed.

According to the MassDEP Bureau of Waste Site Cleanup (BWSC) Phase 1 Site Assessment Map, the Project Site and/or Porter Street Outfall are not located in an area defined as a Natural Heritage & Endangered Species Program (NHESP) Wetland Habitat, Area of Critical Environmental Concern, Approved Interim Wellhead Protection Area, Zone II Wellhead Protection Area, or within a Zone A of a Class A surface water body. In addition, no private wells are located within 500 feet of the Project Site and/or Porter Street Outfall. The Porter Street Outfall is located adjacent to a Federal Emergency Management Agency (FEMA) 100-year floodplain. A copy of the MassDEP BWSC Phase I Site Assessment Map for the Project Site and the Porter Street Outfall are included as **Figures 3A and 3B**, respectively.

Temporary Construction Dewatering

Based upon a review of previous environmental reports and recent gauging of several monitoring wells located at the Project Site, groundwater is present at an approximate depth of two (2) feet bgs. Due to the size of the Project Site (less than 5,000 square feet) and the surrounding surfaces being paved with asphalt and/or concrete, it is infeasible to dewater and reinfiltrate any groundwater or stormwater in the Project Site excavation. Therefore, a dewatering system will be implemented.

The Rain for Rent Engineering Department (RFRED) has proposed a wellpoint dewatering system around the perimeter of the excavation, which will be spaced four (4) feet center to center and jetted to a depth of 22 feet or refusal. The system will consist of approximately 70 well points with one (1) primary and one (1) backup BBA PT90 or PT150 dewatering pumps and 6-inch high density polyethylene (HDPE) SDR 17 wellpoint header pipe. The discharge from each pump to a nearby 21,000-gallon baffled fractionation tank (frac tank) will be 6-inches in diameter. Air/vacuum vents will be required at the pump station and at high points along the pipeline. If necessary, sumps and/or a French Drain may be utilized for nuisance

water and/or to aid in the dewatering process. If a French Drain is used, it will be filled with gravel to help reduce erosion and will be sloped to allow groundwater to travel to low points. Small submersible pumps will be placed in every low point to remove perched water. If higher than expected flows are encountered, an optional backup pump can be operated for the first few days to reduce draw-down time.

Based upon RFRED's calculations, it is estimated that approximately 38 to 179 gallons per minute (gpm) will continuously be pumped from the excavation. This estimation equates to a maximum total of 54,720 to 257,760 gallons per day (gpd). Please note, the dewatering system will be rated to pump a maximum of 200 gpm. RFRED's Engineered Solution and associated calculations are included as **Attachment C**. A plan depicting the catch basin location, stormwater drainage pathway, and the Porter Street Outfall is included as **Figure 4**.

Receiving Water Laboratory Analysis and Calculations

Based upon email correspondence with the United States Environmental Protection Agency (U.S. EPA) on May 5, 2020, the U.S. EPA stated that receiving water quality data reported for the West Outfall (located directly adjacent to the Porter Street Outfall) in a NPDES RGP NOI, dated August 12, 2019, and submitted to the U.S. EPA by GEI Consultants, Inc. (GEI), was acceptable for use as a receiving water sample in this NOI. A copy of the email correspondence is included as **Attachment D**.

On June 24, 2019, the receiving water quality data was collected by CDM Smith, Inc. (CDM) from the vault for the West Outfall. The sample was submitted to a Massachusetts-certified laboratory for analysis of total metals, hardness, and ammonia. The results of the surface water sample collected by CDM are summarized in **Table 1** and the laboratory analytical data report can be referenced in the aforementioned GEI NOI submittal at <https://www3.epa.gov/region1/npdes/remediation/noi/2019/terminal-e-modernization-massport-suffolk-construction-east-boston-mag910871-mag910872.pdf>.

Based upon email correspondence with the U.S. EPA on May 12, 2020, the U.S. EPA stated that for a saltwater receiving body, the dilution factor is 0. The receiving water is a saltwater body and therefore a dilution factor of zero (0) was utilized in calculating the effluent limits. The effluent limits were generated utilizing the NPDES RGP NOI Dilution Factor Calculation Spreadsheet (NOI Spreadsheet). A copy of the email correspondence is included as **Attachment D**. A copy of the *EnterData* and *Saltwater Results* tabs from the NOI Spreadsheet are included as **Attachment E**.

Source Water Laboratory Analysis and Calculations

On May 5, 2020, SAGE collected one (1) groundwater sample from a monitoring well located on the Project Site and representative of the proposed influent concentrations. The monitoring well was not identified on any plans related to RTN 3-13537 and therefore SAGE termed the monitoring well UNK-101. A plan depicting the groundwater monitoring well location is included as **Figure 2**.

Prior to collecting the groundwater sample, the monitoring well was gauged with an interface probe to determine the depth to groundwater and assess for the presence and/or absence of non-aqueous phase liquid (NAPL). No NAPL was detected nor observed. Measured depth to groundwater was 2.56 feet bgs below the top of the PVC casing (btoc). The monitoring well was purged of a minimum of three (3) static well volumes utilizing a low-flow peristaltic pump with dedicated tubing. In addition, a YSI 556

multiparameter water quality meter was utilized to collect field measurements of temperature and pH. pH was measured at 6.5 standard units (S.U.) and is within the 2017 RGP saltwater effluent limitation of 6.5 to 8.5 S.U.

Upon completion of purging, groundwater samples were collected from the monitoring well and submitted under chain-of-custody protocol to a Massachusetts-certified laboratory for analysis of the parameters required by the NPDES RGP. The analytical results reported the detection of methyl tert-butyl ether, iron, zinc, total hardness, ammonia, and chloride. The results of the groundwater sample and field measurements collected by SAGE are summarized in **Table 2** and the laboratory analytical report is included as **Attachment F**.

Based upon the calculations included as **Attachment E**, concentrations of analytes in the source water are less than the applicable technology-based effluent limitation (TBEL) and/or water quality-based effluent limitation (WQBEL) standards for each analyte.

Groundwater Treatment

Based on the results of the above-referenced groundwater analysis, dewatering can meet applicable effluent limitations established by the U.S. EPA *via* the use of existing stormwater infrastructure on the Project Site in combination with an engineered filtration system. Dewatering activities are expected to start in June 2020 and continue into August 2020. Anticipated treated effluent discharge rates are proposed to be 200 gpm or less.

The construction dewatering system design begins with the wellpoint dewatering system along the perimeter of the excavation area. The wellpoint dewatering system will discharge from each pump *via* six-inch diameter line to a nearby frac tank. Four 21,000-gallon baffled frac tanks equipped with high water detection/alarms will be utilized as settling tanks to remove gross fine soils prior to treatment. The frac tanks will be manifolded together *via* piping, and water will be transferred between each frac tank via sump pumps located on an upper shelf on the interior. Effluent from the final in-line frac tank will be pumped to a treatment system equipped with the following treatment train:

1. Two (2) 25-micron and two (2) 10-micron bag filters (in series) to remove fine sediment;
2. A totalizing flow meter;
3. Discharging to the Inner Boston Harbor at the Porter Street Outfall *via* the Massport Logan underground stormwater infrastructure.

Please note, additional frac tanks may be utilized, as necessary. Additional treatment may include two (2) 5,000-pound granular activated carbon (GAC) filtration units, an oil/water separator, iron removal (*via* flocculation/coagulation and clarifying), ion exchange resin, and pH adjustment, as necessary. As necessary, chemical additives treatment may include a metered sulfuric acid system and oxidizers. These chemical additives are not expected to exceed applicable effluent limits, water quality standards, or alter conditions of the receiving water and will not add any pollutants that would justify additional permit conditions. The proposed conceptual treatment system is provided as **Figure 5**. Example Safety Data Sheets (SDS) and product information are included as **Attachment G**.

Endangered Species Act Eligibility

A review of the information provided by the United States Fish and Wildlife Service (U.S. FWS) Information, Planning, and Conservation (IPAC) online database did not identify any threatened, endangered, or candidate species or critical habitats at the Project Site or the Porter Street Outfall. A copy of the database reports are included as **Attachment H**.

The proposed effluent discharge is to a nearshore marine water, and there has been no consultation with the National Marine Fisheries Services (NMFS) for this project. However, SAGE has reviewed the U.S. EPA determination made during consult with the NMFS and dated December 18, 2016. Pursuant to Appendix I: Endangered Species Act (ESA) Guidance and Eligibility Criteria in the NPDES RGP, the Atlantic Sturgeon, Shortnose Sturgeon, four species of sea turtles, and two species of whales are the only ESA-listed species under NMFS jurisdiction that may have a critical habitat in the Massachusetts Bay (inclusive of the Boston Harbor). The turtles and whales are highly unlikely to be present in the vicinity of the effluent discharge at the Porter Street Outfall and sturgeon are expected to be present transiently. Based upon the lifecycles of the sturgeon, contaminants of concern/concentrations and the location of the outfall (which is offshore and not near coastal river mouths), the discharge is not expected to affect either population.

National Historic Preservation Requirements

A review of the online United States National Register of Historic Places (USNRHP) and the Massachusetts Cultural Resource Information System (MACRIS) did not identify the Project Site or the Porter Street Outfall as a National Historic Place. The MACRIS Report is included as **Attachment I**.

It should be noted, that due to the Project Site being a part of Logan and lacking a street address, Prescott Street was used to characterize any possible historical areas which may be impacted by construction activities.

NPDES RGP Eligibility

Based upon SAGE's evaluation of Project Site-specific information, it is SAGE's opinion that the proposed discharge is eligible for coverage under the NPDES RGP. On behalf of Bond, SAGE is requesting coverage for the discharge of treated construction dewatering effluent to the surface waters of the Boston Main Channel of the Boston Inner Harbor.

If you have any questions or concerns, please contact either of the undersigned at (401) 723-9900.

Sincerely,
SAGE Environmental, Inc.

Anthony M. Rossato
Project Manager


Jacob H. Butterworth, MS, LSP
Vice President

AMR/JHB:alm


Notice of Intent for Remediation General Permit Discharge
Proposed Stormwater Management System Improvements
Logan International Airport, Boston, Massachusetts
June 2020

Figure 1	USGS Quadrangle Project Site Location Map
Figure 2	Project Site Plan
Figure 3A	MassDEP BWSC Phase I Site Assessment Map – Project Site
Figure 3B	MassDEP BWSC Phase I Site Assessment Map – Porter Street Outfall
Figure 4	Effluent Discharge Plan
Figure 5	Process Flow Diagram
Table 1	Summary of Surface Water Sample Chemical Analysis Results
Table 2	Summary of Groundwater Sample Chemical Analysis Results
Attachment A	Notice of Intent Form
Attachment B	Design Plan Set
Attachment C	Dewatering System Documentation
Attachment D	EPA Correspondence
Attachment E	NPDES RGP NOI Dilution Factor Calculation Spreadsheet
Attachment F	Source Water Laboratory Analytical Data Report
Attachment G	Treatment System Product Information
Attachment H	U.S. FWS IPAC Documentation
Attachment I	USNRHP/MACRIS Documentation

FIGURES

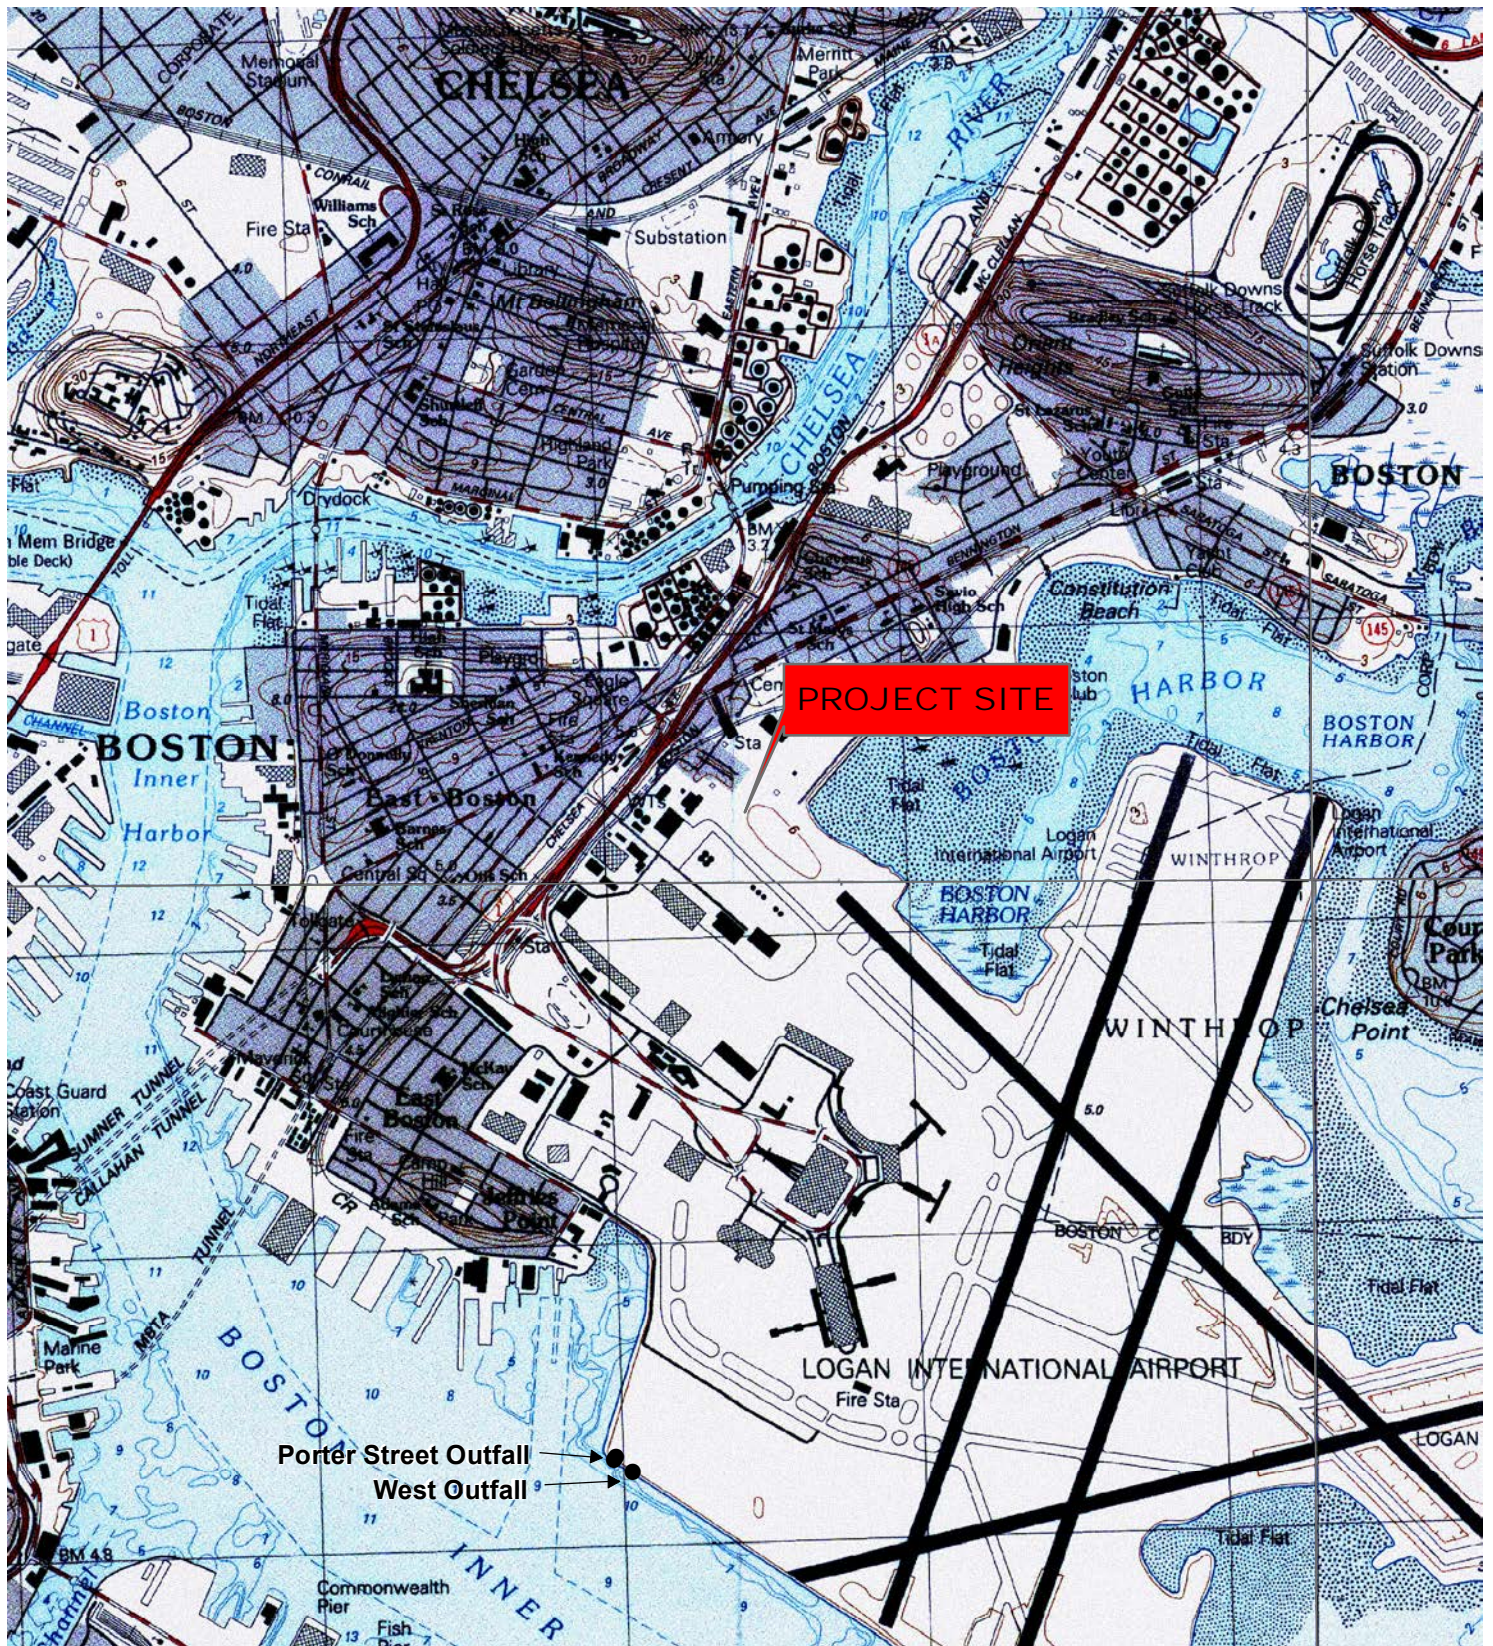

USGS QUADRANGLE
BOSTON NORTH, MASSACHUSETTS

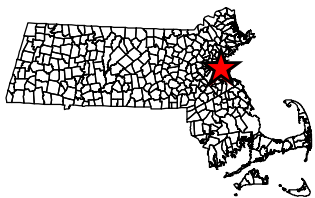

★ Site Location

USGS Quadrangle Project Site Location Map

Logan International Airport
Boston, Massachusetts

DATE: 03/31/2020

JOB #: M948

CREATED BY: ALM




0 550 1,100 2,200 Feet

Data Provided by MassGIS

Figure 1



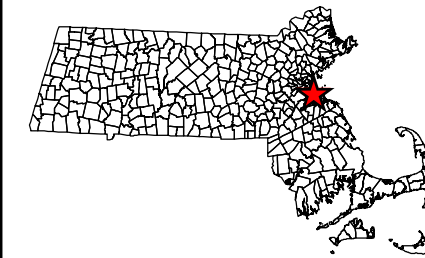

★ Site Location

Legend

- Approximate Excavation Area Location
- + Approximate Monitoring Well Location

0 25 50 100 Feet

Data Provided by MassGIS

March 30, 2017

Orthoimagery provided by nearmap.com



Project Site Plan

Boston Logan
International Airport
Boston, Massachusetts

Date: 05/13/2020

Job #: M948

Created By: ALM/jl

Figure 2



MassDEP - Bureau of Waste Site Cleanup

Phase 1 Site Assessment Map: 500 feet & 0.5 Mile Radii

Site Information:

PRESCOTT ST BOSTON, MA


NAD83 UTM Meters:
4693498mN , 333387mE (Zone: 19)
May 13, 2020

The information shown is the best available at the date of printing. However, it may be incomplete. The responsible party and LSP are ultimately responsible for ascertaining the true conditions surrounding the site. Metadata for data layers shown on this map can be found at:
<https://www.mass.gov/orgs/massgis-bureau-of-geographic-information>



MassDEP

Commonwealth of Massachusetts
Department of Environmental Protection

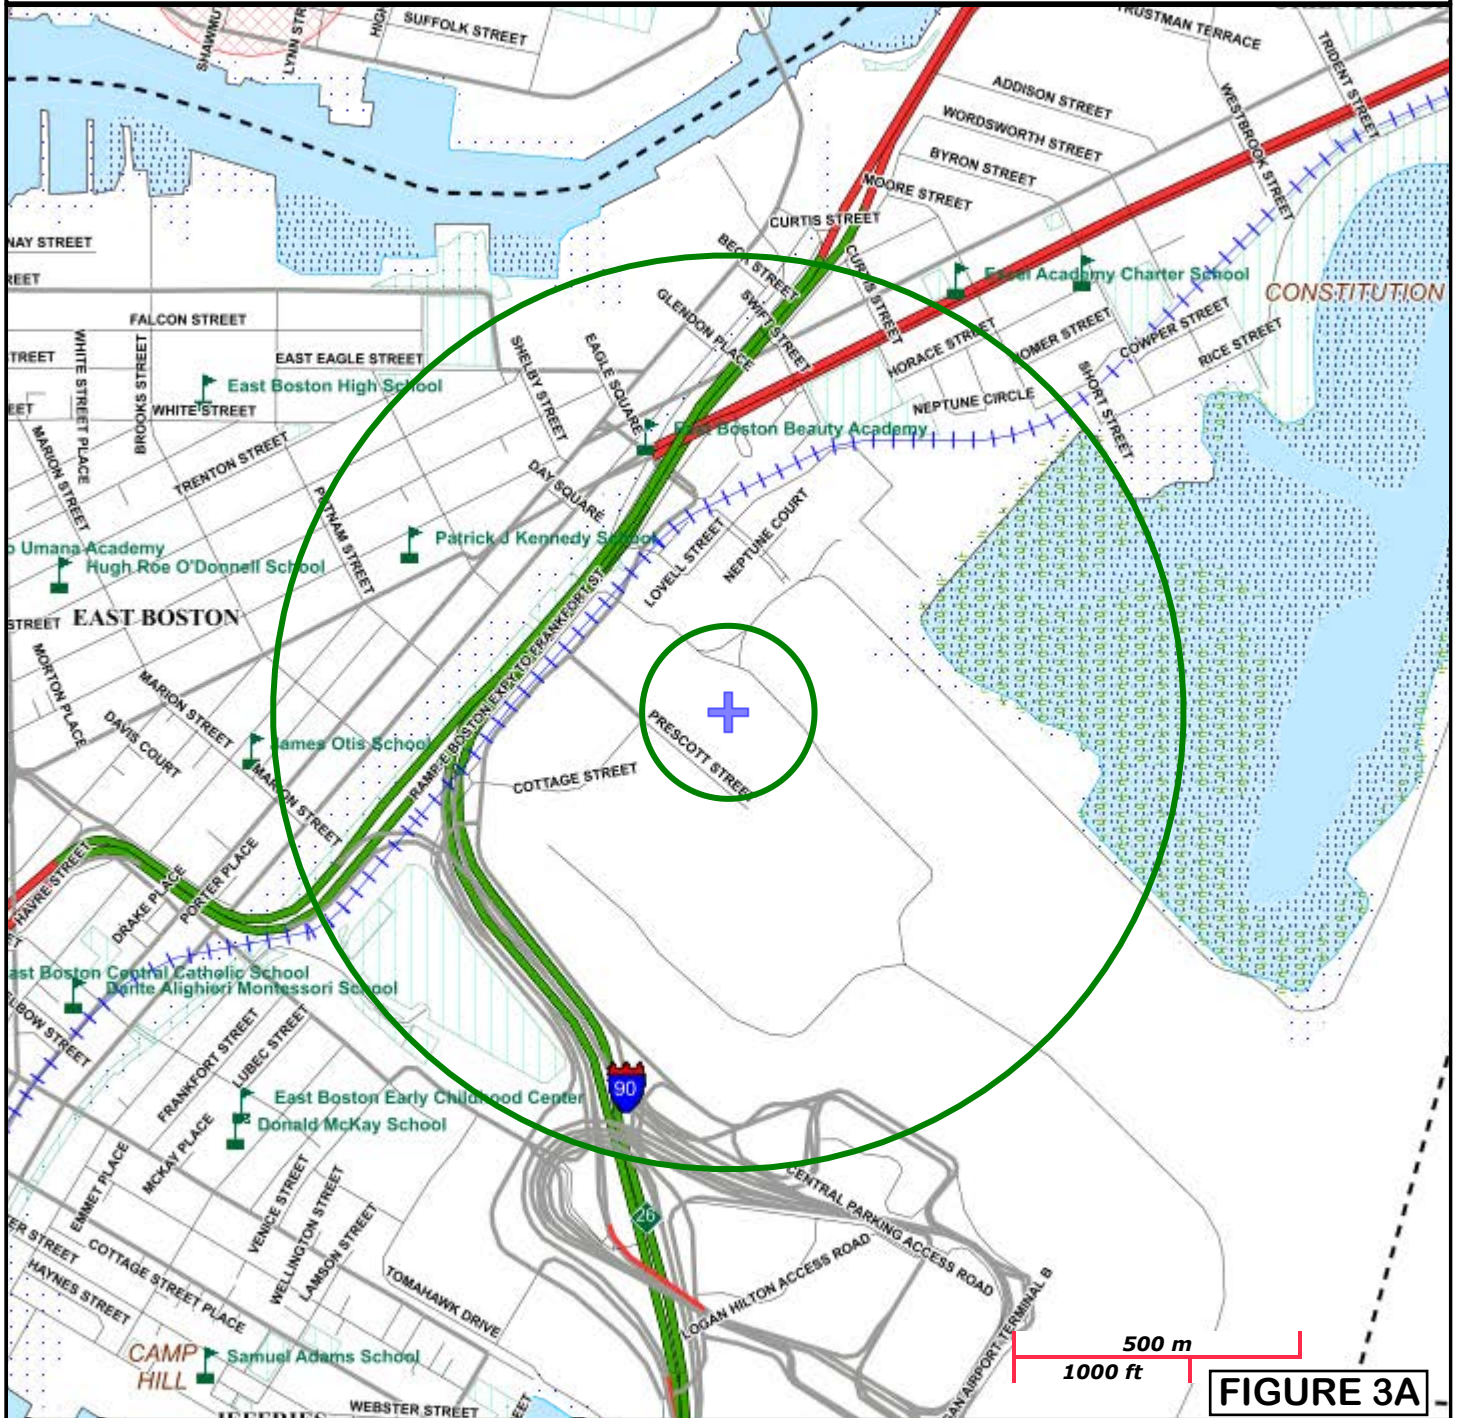

500 m
1000 ft

FIGURE 3A

Roads: Limited Access, Divided, Other Hwy, Major Road, Minor Road, Track, Trail	PWS Protection Areas: Zone II, IWPA, Zone A
Boundaries: Town, County, DEP Region; Train; Powerline; Pipeline; Aqueduct	Hydrography: Open Water, PWS Reservoir, Tidal Flat
Basins: Major, PWS; Streams: Perennial, Intermittent, Man Made Shore, Dam	Wetlands: Freshwater, Saltwater, Cranberry Bog
Aquifers: Medium Yield, High Yield, EPA Sole Source	FEMA 100yr Floodplain; Protected Open Space; ACEC
Non Potential Drinking Water Source Area: Medium, High (Yield)	Est. Rare Wetland Wildlife Hab; Vernal Pool: Cert., Potential
	Solid Waste Landfill; PWS: Com. GW, SW, Emerg., Non-Com.

MassDEP - Bureau of Waste Site Cleanup

Phase 1 Site Assessment Map: 500 feet & 0.5 Mile Radii

Site Information:

PRESCOTT STREET BOSTON, MA

NAD83 UTM Meters:
4691505mN , 333010mE (Zone: 19)
May 13, 2020

The information shown is the best available at the date of printing. However, it may be incomplete. The responsible party and LSP are ultimately responsible for ascertaining the true conditions surrounding the site. Metadata for data layers shown on this map can be found at:
<https://www.mass.gov/orgs/massgis-bureau-of-geographic-information>



MassDEP

Commonwealth of Massachusetts
Department of Environmental Protection


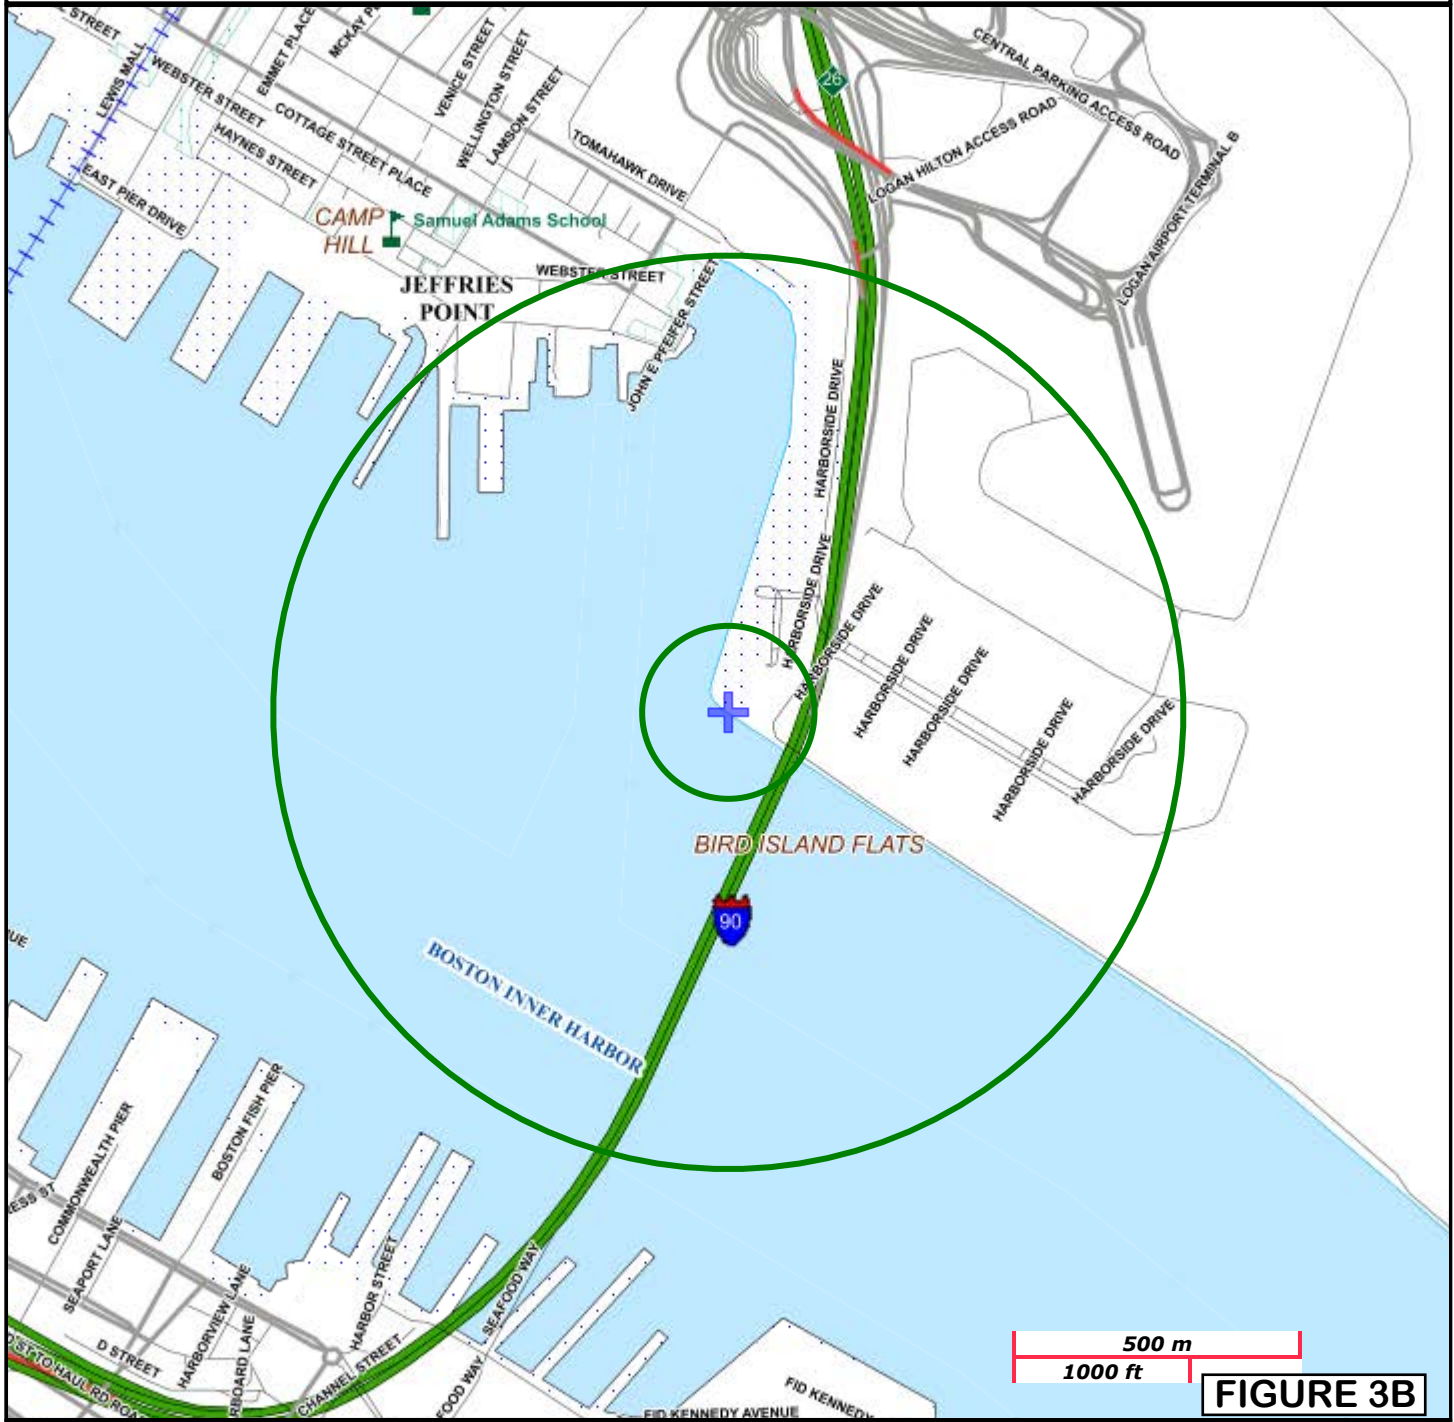


FIGURE 3B

Roads: Limited Access, Divided, Other Hwy, Major Road, Minor Road, Track, Trail	PWS Protection Areas: Zone II, IWPA, Zone A		
Boundaries: Town, County, DEP Region; Train; Powerline; Pipeline; Aqueduct	Hydrography: Open Water, PWS Reservoir, Tidal Flat		
Basins: Major, PWS; Streams: Perennial, Intermittent, Man Made Shore, Dam	Wetlands: Freshwater, Saltwater, Cranberry Bog		
Aquifers: Medium Yield, High Yield, EPA Sole Source	FEMA 100yr Floodplain; Protected Open Space; ACEC		
Non Potential Drinking Water Source Area: Medium, High (Yield)	Est. Rare Wetland Wildlife Hab; Vernal Pool: Cert., Potential		
	Solid Waste Landfill; PWS: Com. GW, SW, Emerg., Non-Com.		

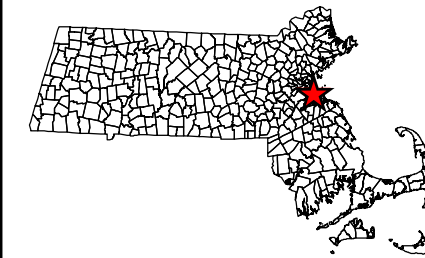


★ Site Location

Legend

- Boston Inner Harbor
- Approximate Excavation Area Location
- Approximate Location of Stormwater Drainage Pathway

0 500 1,000 Feet

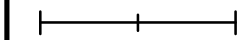

Data Provided by MassGIS

March 30, 2017

Orthoimagery provided by nearmap.com



Effluent Discharge Plan

Boston Logan International Airport
Boston, Massachusetts


Date: 05/21/2020

Job #: M948


Created By: ALM/jl

Figure 4



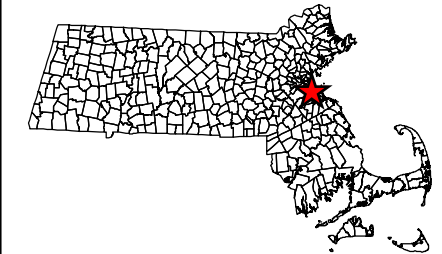

★ Site Location

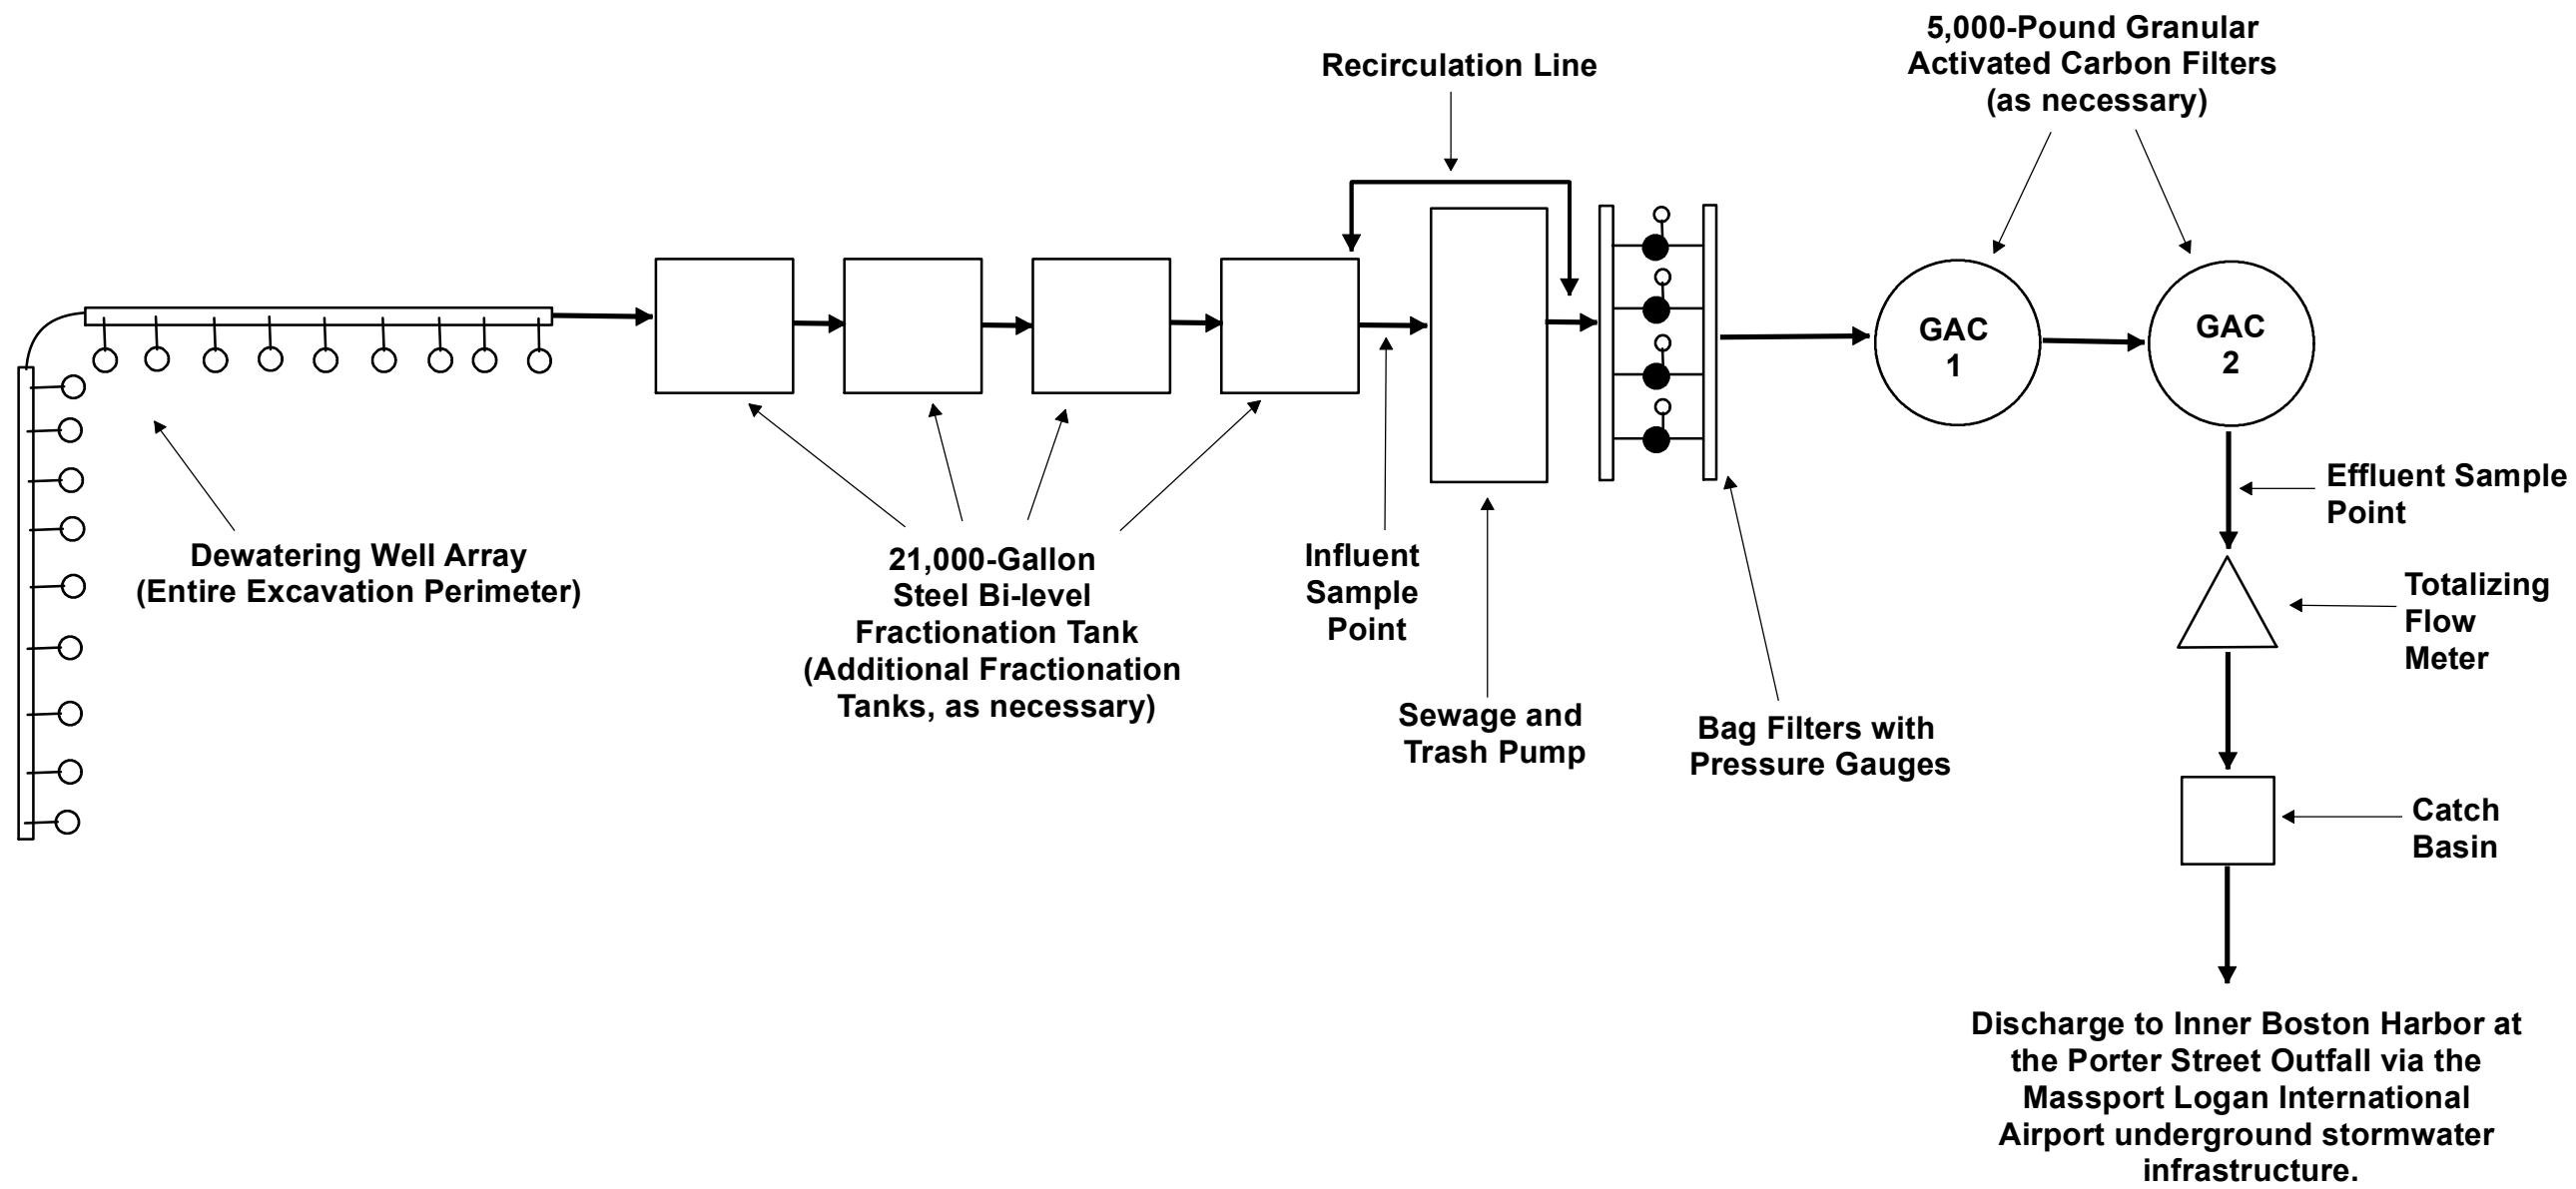

Legend

Process Flow Diagram

Boston Logan International Airport
Boston, Massachusetts

Date: 05/21/2020

Job #: M948

Created By: ALM/jl

Figure 5



TABLES

Table 1
Summary of Surface Water Sample Chemical Analysis Results
Receiving Water - Boston Inner Harbor

		Sample ID:	West RGP
		Date Sampled:	6/24/2019
Analyte	Method in report	Sample Result	
Total Metals (µg/l)			
Antimony	200.8	<4	
Arsenic	200.8	3.03	
Cadmium	200.8	<0.2	
Chromium, Trivalent	107	<10	
Chromium, Hexavalent	7196A	<10	
Chromium (Total)	200.8	<1	
Copper	200.8	5.22	
Iron	200.7	2,780	
Lead	200.8	<1	
Mercury	245.1	<0.2	
Nickel	200.8	2.18	
Selenium	200.8	<5	
Silver	200.8	<0.4	
Zinc	200.8	41.9	
Other			
Hardness (µg/l)	200.7	595,000	
Ammonia as Nitrogen (µg/l)	4500NH3-BH	989	
Salinity (ppt)	Field	5.72	
pH (S.U.)	Field	6.72	

General Notes:

1. For a complete list of analytes, refer to the laboratory analytical data report.
2. "<" = Analyte not detected at a concentration above the laboratory reporting limit.
3. µg/l = micrograms per liter
4. ppt = parts per thousand
5. S.U. = standard units

Table 2
Summary of Groundwater Sample Chemical Analysis Results
Source Water - Logan Airport

				Sample ID:	UNK-101
				Date Sampled:	05/05/2020
Analyte	Method	MCP RCGW-2	Site Specific Effluent Limits	Sample Result	
Volatile Organic Compounds (VOCs) (µg/l)					
Benzene	524.2	1,000	5	<0.5	
1,4-Dioxane	8270D SIM	6,000	200	<0.25	
Phenols	420.1	NE	1,080	<50	
Total BTEX	524.2	NE	100	<0.5	
Total Non-Halogenated VOCs ¹	Various	NE	NE	<0.25 - <0.5	
Total Halogenated VOCs ²	Various	NE	NE	<0.2 - <0.5	
Semivolatile Organic Compounds (SVOCs) (µg/l)					
Total Phthalates	625.1 SIM	NE	190	<2.34	
Total Group I PAHs ³	625.1 SIM	NE	1	<0.05	
Acenaphthene	625.1 SIM	6,000	NE	<0.19	
Acenaphthylene	625.1 SIM	40	NE	<0.19	
Fluorene	625.1 SIM	40	NE	<0.19	
Naphthalene	625.1 SIM	700	20	<0.19	
Phenanthrene	625.1 SIM	10,000	NE	<0.19	
Total Group II PAHs ⁴	625.1 SIM	NE	100	<0.19	
Fuel Parameters (µg/l)					
Total Petroleum Hydrocarbons	1664A	5,000	5,000	<5,000	
Ethanol	ASTM D3695	NE	Report	<10,000	
Methyl-tert-Butyl Ether	524.2	5,000	70	0.6	
Inorganic Compounds					
Ammonia as Nitrogen (mg/l)	350.1	NE	Report	0.28	
Chloride (mg/l)	300.0	NE	Report	61.3	
Total Residual Chlorine (ug/l)	4500CID	NE	7,500	<20	
Total Suspended Solids (mg/l)	2540D	NE	30	<5	
Antimony (µg/l)	200.7	8,000	206	<10	
Arsenic (µg/l)	3113B	900	104	<2.5	
Cadmium (µg/l)	200.8	4	10.2	<0.5	
Chromium, Total (µg/l)	200.7	300	10.2	<2	
Chromium III (µg/l)	200.7	600	323	<10	
Chromium VI (µg/l)	3500Cr B-2009	300	323	<10	
Copper (µg/l)	200.7	100,000	242	<2	
Iron (µg/l)	200.7	NE	5,000	128	
Lead (µg/l)	200.7	10	160	<2	
Mercury (µg/l)	245.1	20	0.739	<0.2	
Nickel (µg/l)	200.7	200	1,450	<5	
Selenium (µg/l)	3113B	100	235.8	<5	
Silver (µg/l)	200.7	7	35.1	<1	
Zinc (µg/l)	200.7	900	420	5.8	
Total Cyanide (mg/l)	4500 CN CE	30	178	<0.005	
Polychlorinated Biphenyls (PCBs) (µg/l)					
Total PCBs	608.3	5	0.000064	<0.09	
Other					
Hardness (µg/l)	CALC	NE	NE	131,000	
Temperature (°C)	Field	NE	NE	15.52	
pH (S.U.)	Field	NE	6.5 - 8.5	6.5	

General Notes:

- For a complete list of analytes, refer to the laboratory analytical data report.
- "<" = Analyte not detected at a concentration above the laboratory reporting limit.
- MCP = 310 CMR 40.0000 Massachusetts Contingency Plan with revisions effective April 25, 2014.
- RCGW-2 = Reportable Concentration for category GW-2 Groundwater
- µg/l = micrograms per liter
- mg/l = milligram per liter
- °C = Degrees Celsius
- S.U. = standard units
- ND = Not detected. NE = No standard has been established for this analyte.
- Dilution Factor of 0 used to establish effluent limits.
- Effluent limits calculated using NPDES RGP NOI Dilution Factor Spreadsheet.
- Total Non-Halogenated VOCs include benzene, ethylbenzene, toluene, and xylenes (BTEX), acetone, 1,4-dioxane, and phenols.
- Total Halogenated VOCs include carbon tetrachloride, 1,2-dichlorobenzene, 1,3-dichlorobenzene, 1,4-dichlorobenzene, 1,1-dichloroethane, 1,2-dichloroethane, 1,2-dichloroethene, ethylene dibromide, methylene chloride, 1,1,1-trichloroethane, 1,1,2-trichloroethane, trichloroethylene, tetrachloroethylene, cis-1,2-dichloroethylene, and vinyl chloride.
- Group I PAHs include benzo(a)anthracene, benzo(a)pyrene, benzo(b)fluoranthene, benzo(k)fluoranthene, chrysene, dibenz(a,h)anthracene, and ideno(1,2,3-cd)pyrene.
- Group II PAHs include: acenaphthene, acenaphthylene, anthracene, benzo(g,h,i)perylene, fluoranthene, fluorene, naphthalene, phenanthrene, and pyrene.

ATTACHMENT A

II. Suggested Format for the Remediation General Permit Notice of Intent (NOI)

A. General site information:

1. Name of site: Stormwater Management System Improvements	Site address: Logan International Airport		
	Street: Prescott Street		
	City: East Boston	State: MA	Zip: 02128
2. Site owner (Project Owner) BOSFuel Corporation Owner is (check one): <input type="checkbox"/> Federal <input type="checkbox"/> State/Tribal <input checked="" type="checkbox"/> Private <input type="checkbox"/> Other; if so, specify:	Contact Person: Emily Smith		
	Telephone: (404) 773-4469	Email: Emily.L.Smith@delta.com	
	Mailing address: Dept. 857 1030 Delta Boulevard		
	Street:		
	City: Atlanta	State: GA	Zip: 30354
3. Site operator, if different than owner BOND Civil & Utility Construction, Inc.	Contact Person: Tara Canavan		
	Telephone: (617) 394-6368	Email: tcanavan@bond-civilutility.com	
	Mailing address: 10 Cabot Road, Suite 300		
	Street:		
	City: Medford	State: MA	Zip: 02155
4. NPDES permit number assigned by EPA: NPDES permit is (check all that apply): <input checked="" type="checkbox"/> RGP <input type="checkbox"/> DGP <input type="checkbox"/> CGP <input type="checkbox"/> MSGP <input type="checkbox"/> Individual NPDES permit <input type="checkbox"/> Other; if so, specify:	5. Other regulatory program(s) that apply to the site (check all that apply): <input checked="" type="checkbox"/> MA Chapter 21e; list RTN(s): RTN 3-13537 <input type="checkbox"/> NH Groundwater Management Permit or Groundwater Release Detection Permit: <input type="checkbox"/> CERCLA <input type="checkbox"/> UIC Program <input type="checkbox"/> POTW Pretreatment <input type="checkbox"/> CWA Section 404		

B. Receiving water information:

1. Name of receiving water(s): Boston Inner Harbor	Waterbody identification of receiving water(s): MA70-02	Classification of receiving water(s): SB(CSO)
Receiving water is (check any that apply): <input type="checkbox"/> Outstanding Resource Water <input type="checkbox"/> Ocean Sanctuary <input type="checkbox"/> territorial sea <input type="checkbox"/> Wild and Scenic River		
2. Has the operator attached a location map in accordance with the instructions in B, above? (check one): <input checked="" type="checkbox"/> Yes <input type="checkbox"/> No Are sensitive receptors present near the site? (check one): <input type="checkbox"/> Yes <input checked="" type="checkbox"/> No If yes, specify:		
3. Indicate if the receiving water(s) is listed in the State’s Integrated List of Waters (i.e., CWA Section 303(d)). Include which designated uses are impaired, and any pollutants indicated. Also, indicate if a final TMDL is available for any of the indicated pollutants. For more information, contact the appropriate State as noted in Part 4.6 of the RGP. Impaired Water Body - See attached Table 1.		
4. Indicate the seven day-ten-year low flow (7Q10) of the receiving water determined in accordance with the instructions in Appendix V for sites located in Massachusetts and Appendix VI for sites located in New Hampshire.	NA (saltwater)	
5. Indicate the requested dilution factor for the calculation of water quality-based effluent limitations (WQBELs) determined in accordance with the instructions in Appendix V for sites in Massachusetts and Appendix VI for sites in New Hampshire.	0 (saltwater)	
6. Has the operator received confirmation from the appropriate State for the 7Q10 and dilution factor indicated? (check one): <input type="checkbox"/> Yes <input checked="" type="checkbox"/> No If yes, indicate date confirmation received: NA (saltwater)		
7. Has the operator attached a summary of receiving water sampling results as required in Part 4.2 of the RGP in accordance with the instruction in Appendix VIII? (check one): <input checked="" type="checkbox"/> Yes <input type="checkbox"/> No		

C. Source water information:

1. Source water(s) is (check any that apply):			
<input checked="" type="checkbox"/> Contaminated groundwater Has the operator attached a summary of influent sampling results as required in Part 4.2 of the RGP in accordance with the instruction in Appendix VIII? (check one): <input checked="" type="checkbox"/> Yes <input type="checkbox"/> No	<input type="checkbox"/> Contaminated surface water Has the operator attached a summary of influent sampling results as required in Part 4.2 of the RGP in accordance with the instruction in Appendix VIII? (check one): <input type="checkbox"/> Yes <input type="checkbox"/> No	<input type="checkbox"/> The receiving water <input type="checkbox"/> A surface water other than the receiving water; if so, indicate waterbody:	<input type="checkbox"/> Potable water; if so, indicate municipality or origin: <input type="checkbox"/> Other; if so, specify:

2. Source water contaminants: Methyl tert-butyl ether, iron, zinc, total hardness, ammonia, and chloride.	
a. For source waters that are contaminated groundwater or contaminated surface water, indicate any contaminants present that are not included in the RGP? (check one): <input type="checkbox"/> Yes <input checked="" type="checkbox"/> No If yes, indicate the contaminant(s) and the maximum concentration present in accordance with the instructions in Appendix VIII.	b. For a source water that is a surface water other than the receiving water, potable water or other, indicate any contaminants present at the maximum concentration in accordance with the instructions in Appendix VIII? (check one): <input type="checkbox"/> Yes <input type="checkbox"/> No
3. Has the source water been previously chlorinated or otherwise contains residual chlorine? (check one): <input type="checkbox"/> Yes <input checked="" type="checkbox"/> No	

D. Discharge information

1. The discharge(s) is a(n) (check any that apply): <input type="checkbox"/> Existing discharge <input checked="" type="checkbox"/> New discharge <input type="checkbox"/> New source	
Outfall(s): Porter Street Outfall	Outfall location(s): (Latitude, Longitude) 42°21'28" N -71°01'39" W
Discharges enter the receiving water(s) via (check any that apply): <input type="checkbox"/> Direct discharge to the receiving water <input checked="" type="checkbox"/> Indirect discharge, if so, specify: Indirectly discharged to the Boston Main Channel of the Boston Inner Harbor via Massport's storm drainage system <input checked="" type="checkbox"/> A private storm sewer system <input type="checkbox"/> A municipal storm sewer system If the discharge enters the receiving water via a private or municipal storm sewer system: Has notification been provided to the owner of this system? (check one): <input checked="" type="checkbox"/> Yes <input type="checkbox"/> No Has the operator has received permission from the owner to use such system for discharges? (check one): <input checked="" type="checkbox"/> Yes <input type="checkbox"/> No, if so, explain, with an estimated timeframe for obtaining permission: Has the operator attached a summary of any additional requirements the owner of this system has specified? (check one): <input type="checkbox"/> Yes <input checked="" type="checkbox"/> No	
Provide the expected start and end dates of discharge(s) (month/year): June 2020 - August 2020	
Indicate if the discharge is expected to occur over a duration of: <input checked="" type="checkbox"/> less than 12 months <input type="checkbox"/> 12 months or more <input type="checkbox"/> is an emergency discharge	
Has the operator attached a site plan in accordance with the instructions in D, above? (check one): <input checked="" type="checkbox"/> Yes <input type="checkbox"/> No	

2. Activity Category: (check all that apply)	3. Contamination Type Category: (check all that apply)	
<input type="checkbox"/> I – Petroleum-Related Site Remediation <input type="checkbox"/> II – Non-Petroleum-Related Site Remediation <input checked="" type="checkbox"/> III – Contaminated Site Dewatering <input type="checkbox"/> IV – Dewatering of Pipelines and Tanks <input type="checkbox"/> V – Aquifer Pump Testing <input type="checkbox"/> VI – Well Development/Rehabilitation <input type="checkbox"/> VII – Collection Structure Dewatering/Remediation <input type="checkbox"/> VIII – Dredge-Related Dewatering	<p style="text-align: center;">a. If Activity Category I or II: (check all that apply)</p> <input type="checkbox"/> A. Inorganics <input type="checkbox"/> B. Non-Halogenated Volatile Organic Compounds <input type="checkbox"/> C. Halogenated Volatile Organic Compounds <input type="checkbox"/> D. Non-Halogenated Semi-Volatile Organic Compounds <input type="checkbox"/> E. Halogenated Semi-Volatile Organic Compounds <input type="checkbox"/> F. Fuels Parameters	
	<p style="text-align: center;">b. If Activity Category III, IV, V, VI, VII or VIII: (check either G or H)</p>	
	<input checked="" type="checkbox"/> G. Sites with Known Contamination	<input type="checkbox"/> H. Sites with Unknown Contamination
	<p>c. If Category III-G, IV-G, V-G, VI-G, VII-G or VIII-G: (check all that apply)</p> <input checked="" type="checkbox"/> A. Inorganics <input type="checkbox"/> B. Non-Halogenated Volatile Organic Compounds <input type="checkbox"/> C. Halogenated Volatile Organic Compounds <input type="checkbox"/> D. Non-Halogenated Semi-Volatile Organic Compounds <input type="checkbox"/> E. Halogenated Semi-Volatile Organic Compounds <input checked="" type="checkbox"/> F. Fuels Parameters	<p>d. If Category III-H, IV-H, V-H, VI-H, VII-H or VIII-H Contamination Type Categories A through F apply</p>

4. Influent and Effluent Characteristics

Parameter	Known or believed absent	Known or believed present	# of samples	Test method (#)	Detection limit (µg/l)	Influent		Effluent Limitations	
						Daily maximum (µg/l)	Daily average (µg/l)	TBEL	WQBEL
A. Inorganics									
Ammonia		✓	1	350.1	100	280	280	Report mg/L	---
Chloride		✓	1	300.0	5000	61300	61300	Report µg/l	---
Total Residual Chlorine	✓		1	4500 CL D	20	<20	0	0.2 mg/L	
Total Suspended Solids	✓		1	2540D	5000	<5	0	30 mg/L	---
Antimony	✓		1	200.7	10	<10	0	206 µg/L	
Arsenic	✓		1	3113B	2.5	<2.5	0	104 µg/L	
Cadmium	✓		1	200.8	0.5	<0.5	0	10.2 µg/L	
Chromium III	✓		1	200.7	10	<10	0	323 µg/L	
Chromium VI	✓		1	200.7	2	<2	0	323 µg/L	
Copper	✓		1	200.7	2	<2	0	242 µg/L	
Iron		✓	1	200.7	10	128	128	5,000 µg/L	
Lead	✓		1	200.7	2	<2	0	160 µg/L	
Mercury	✓		1	245.1	0.2	<0.2	0	0.739 µg/L	
Nickel	✓		1	200.7	5	<5	0	1,450 µg/L	
Selenium	✓		1	3113B	5	<5	0	235.8 µg/L	
Silver	✓		1	200.7	1	<1	0	35.1 µg/L	
Zinc		✓	1	200.7	5	5.8	5.8	420 µg/L	
Cyanide	✓		1	4500CNC	5	<5	0	178 mg/L	
B. Non-Halogenated VOCs									
Total BTEX	✓		1	524.2	0.5	<0.5	0	100 µg/L	---
Benzene	✓		1	524.2	0.5	<0.5	0	5.0 µg/L	---
1,4 Dioxane	✓		1	8270DSIM	0.25	<0.25	0	200 µg/L	---
Acetone	✓		1	524.2	5	<5	0	7.97 mg/L	---
Phenol	✓		1	420.1	50	<50	0	1,080 µg/L	

Parameter	Known or believed absent	Known or believed present	# of samples	Test method (#)	Detection limit (µg/l)	Influent		Effluent Limitations	
						Daily maximum (µg/l)	Daily average (µg/l)	TBEL	WQBEL
C. Halogenated VOCs									
Carbon Tetrachloride	✓		1	524.2	0.3	<0.3	0	4.4 µg/L	
1,2 Dichlorobenzene	✓		1	524.2	0.5	<0.5	0	600 µg/L	---
1,3 Dichlorobenzene	✓		1	524.2	0.5	<0.5	0	320 µg/L	---
1,4 Dichlorobenzene	✓		1	524.2	0.5	<0.5	0	5.0 µg/L	---
Total dichlorobenzene	✓		1	524.2	0.5	<0.5	0	763 µg/L in NH	---
1,1 Dichloroethane	✓		1	524.2	0.5	<0.5	0	70 µg/L	---
1,2 Dichloroethane	✓		1	524.2	0.5	<0.5	0	5.0 µg/L	---
1,1 Dichloroethylene	✓		1	524.2	0.5	<0.5	0	3.2 µg/L	---
Ethylene Dibromide	✓		1	504.1	0.015	<0.015	0	0.05 µg/L	---
Methylene Chloride	✓		1	524.2	0.5	<0.5	0	4.6 µg/L	---
1,1,1 Trichloroethane	✓		1	524.2	0.5	<0.5	0	200 µg/L	---
1,1,2 Trichloroethane	✓		1	524.2	0.5	<0.5	0	5.0 µg/L	---
Trichloroethylene	✓		1	524.2	0.5	<0.5	0	5.0 µg/L	---
Tetrachloroethylene	✓		1	524.2	0.5	<0.5	0	5.0 µg/L	
cis-1,2 Dichloroethylene	✓		1	524.2	0.5	<0.5	0	70 µg/L	---
Vinyl Chloride	✓		1	524.2	0.2	<0.2	0	2.0 µg/L	---
D. Non-Halogenated SVOCs									
Total Phthalates	✓		1	625.1 SIM	2.34	<2.34	0	190 µg/L	
Diethylhexyl phthalate	✓		1	625.1 SIM	2.34	<2.34	0	101 µg/L	
Total Group I PAHs	✓		1	625.1 SIM	0.05	<0.05	0	1.0 µg/L	---
Benzo(a)anthracene	✓		1	625.1 SIM	0.05	<0.05	0	As Total PAHs	
Benzo(a)pyrene	✓		1	625.1 SIM	0.05	<0.05	0		
Benzo(b)fluoranthene	✓		1	625.1 SIM	0.05	<0.05	0		
Benzo(k)fluoranthene	✓		1	625.1 SIM	0.05	<0.05	0		
Chrysene	✓		1	625.1 SIM	0.05	<0.05	0		
Dibenzo(a,h)anthracene	✓		1	625.1 SIM	0.05	<0.05	0		
Indeno(1,2,3-cd)pyrene	✓		1	625.1 SIM	0.05	<0.05	0		

E. Treatment system information

<p>1. Indicate the type(s) of treatment that will be applied to effluent prior to discharge: (check all that apply)</p> <p><input type="checkbox"/> Adsorption/Absorption <input type="checkbox"/> Advanced Oxidation Processes <input type="checkbox"/> Air Stripping <input checked="" type="checkbox"/> Granulated Activated Carbon (“GAC”)/Liquid Phase Carbon Adsorption <input checked="" type="checkbox"/> Ion Exchange <input checked="" type="checkbox"/> Precipitation/Coagulation/Flocculation <input checked="" type="checkbox"/> Separation/Filtration <input checked="" type="checkbox"/> Other; if so, specify: Additional fractionation tanks, granular activated carbon filtration, oil/water separator, ion exchange resin, and other treatments, as necessary, to meet effluent limits.</p>	
<p>2. Provide a written description of all treatment system(s) or processes that will be applied to the effluent prior to discharge. Four 21,000-gallon baffled fractionation tanks equipped with high water detection/alarms will be utilized as settling tanks to remove gross fine soils prior to treatment. The fractionation tanks will be manifolded together via piping. Effluent from the final in-line fractionation tank will be pumped to a treatment system equipped with the following treatment train: two (2) 25-micron and two (2) 10-micron bag filters (in series) to remove fine sediment, a totalizing flow meter, followed by discharge to the Boston Inner Harbor at the Porter Street Outfall. Other treatments will be added, as necessary, to meet effluent limits.</p> <p>Identify each major treatment component (check any that apply): <input checked="" type="checkbox"/> Fractionation tanks <input type="checkbox"/> Equalization tank <input checked="" type="checkbox"/> Oil/water separator <input type="checkbox"/> Mechanical filter <input type="checkbox"/> Media filter <input type="checkbox"/> Chemical feed tank <input type="checkbox"/> Air stripping unit <input checked="" type="checkbox"/> Bag filter <input checked="" type="checkbox"/> Other; if so, specify: Additional fractionation tanks, granular activated carbon filtration, oil/water separator, ion exchange resin, and other treatments, as necessary, to meet effluent limits.</p> <p>Indicate if either of the following will occur (check any that apply): <input type="checkbox"/> Chlorination <input type="checkbox"/> De-chlorination</p>	
<p>3. Provide the design flow capacity in gallons per minute (gpm) of the most limiting component. Indicate the most limiting component: Granular activated carbon filtration units Is use of a flow meter feasible? (check one): <input checked="" type="checkbox"/> Yes <input type="checkbox"/> No, if so, provide justification:</p>	200
<p>Provide the proposed maximum effluent flow in gpm.</p>	200
<p>Provide the average effluent flow in gpm.</p>	200
<p>If Activity Category IV applies, indicate the estimated total volume of water that will be discharged:</p>	NA
<p>4. Has the operator attached a schematic of flow in accordance with the instructions in E, above? (check one): <input checked="" type="checkbox"/> Yes <input type="checkbox"/> No</p>	

F. Chemical and additive information

<p>1. Indicate the type(s) of chemical or additive that will be applied to effluent prior to discharge or that may otherwise be present in the discharge(s): (check all that apply)</p> <p><input type="checkbox"/> Algaecides/biocides <input type="checkbox"/> Antifoams <input checked="" type="checkbox"/> Coagulants <input type="checkbox"/> Corrosion/scale inhibitors <input type="checkbox"/> Disinfectants <input checked="" type="checkbox"/> Flocculants <input type="checkbox"/> Neutralizing agents <input checked="" type="checkbox"/> Oxidants <input type="checkbox"/> Oxygen <input type="checkbox"/> scavengers <input checked="" type="checkbox"/> pH conditioners <input type="checkbox"/> Bioremedial agents, including microbes <input type="checkbox"/> Chlorine or chemicals containing chlorine <input type="checkbox"/> Other; if so, specify: Chemical additives, as necessary, to meet effluent limits.</p>
<p>2. Provide the following information for each chemical/additive, using attachments, if necessary:</p> <ul style="list-style-type: none">a. Product name, chemical formula, and manufacturer of the chemical/additive;b. Purpose or use of the chemical/additive or remedial agent;c. Material Safety Data Sheet (MSDS) and Chemical Abstracts Service (CAS) Registry number for each chemical/additive;d. The frequency (hourly, daily, etc.), duration (hours, days), quantity (maximum and average), and method of application for the chemical/additive;e. Any material compatibility risks for storage and/or use including the control measures used to minimize such risks; andf. If available, the vendor's reported aquatic toxicity (NOAEL and/or LC50 in percent for aquatic organism(s)).
<p>3. Has the operator attached an explanation which demonstrates that the addition of such chemicals/additives may be authorized under this general permit in accordance with the instructions in F, above? (check one): <input checked="" type="checkbox"/> Yes <input type="checkbox"/> No; if no, has the operator attached data that demonstrates each of the 126 priority pollutants in CWA Section 307(a) and 40 CFR Part 423.15(j)(1) are non-detect in discharges with the addition of the proposed chemical/additive? (check one): <input type="checkbox"/> Yes <input checked="" type="checkbox"/> No</p>

G. Endangered Species Act eligibility determination

<p>1. Indicate under which criterion the discharge(s) is eligible for coverage under this general permit:</p> <ul style="list-style-type: none"><input checked="" type="checkbox"/> FWS Criterion A: No endangered or threatened species or critical habitat are in proximity to the discharges or related activities or come in contact with the “action area”.<input type="checkbox"/> FWS Criterion B: Formal or informal consultation with the FWS under section 7 of the ESA resulted in either a no jeopardy opinion (formal consultation) or a written concurrence by FWS on a finding that the discharges and related activities are “not likely to adversely affect” listed species or critical habitat (informal consultation). Has the operator completed consultation with FWS? (check one): <input type="checkbox"/> Yes <input type="checkbox"/> No; if no, is consultation underway? (check one): <input type="checkbox"/> Yes <input type="checkbox"/> No<input type="checkbox"/> FWS Criterion C: Using the best scientific and commercial data available, the effect of the discharges and related activities on listed species and critical habitat have been evaluated. Based on those evaluations, a determination is made by EPA, or by the operator and affirmed by EPA, that the discharges and related activities will have “no effect” on any federally threatened or endangered listed species or designated critical habitat under the jurisdiction of the FWS. This determination was made by: (check one) <input type="checkbox"/> the operator <input type="checkbox"/> EPA <input type="checkbox"/> Other; if so, specify:

NMFS Criterion: A determination made by EPA is affirmed by the operator that the discharges and related activities will have “no effect” or are “not likely to adversely affect” any federally threatened or endangered listed species or critical habitat under the jurisdiction of NMFS and will not result in any take of listed species. Has the operator previously completed consultation with NMFS? (check one): Yes No

2. Has the operator attached supporting documentation of ESA eligibility in accordance with the instructions in Appendix I, and G, above? (check one): Yes No

Does the supporting documentation include any written concurrence or finding provided by the Services? (check one): Yes No; if yes, attach.

H. National Historic Preservation Act eligibility determination

1. Indicate under which criterion the discharge(s) is eligible for coverage under this general permit:

- Criterion A:** No historic properties are present. The discharges and discharge-related activities (e.g., BMPs) do not have the potential to cause effects on historic properties.
- Criterion B:** Historic properties are present. Discharges and discharge related activities do not have the potential to cause effects on historic properties.
- Criterion C:** Historic properties are present. The discharges and discharge-related activities have the potential to have an effect or will have an adverse effect on historic properties.

2. Has the operator attached supporting documentation of NHPA eligibility in accordance with the instructions in H, above? (check one): Yes No

Does the supporting documentation include any written agreement with the State Historic Preservation Officer (SHPO), Tribal Historic Preservation Officer (TPHO), or other tribal representative that outlines measures the operator will carry out to mitigate or prevent any adverse effects on historic properties? (check one): Yes No

I. Supplemental information

Describe any supplemental information being provided with the NOI. Include attachments if required or otherwise necessary.
Letter Report prepared by SAGE Environmental, Inc.

Has the operator attached data, including any laboratory case narrative and chain of custody used to support the application? (check one): Yes No

Has the operator attached the certification requirement for the Best Management Practices Plan (BMPP)? (check one): Yes No

J. Certification requirement

I certify under penalty of law that this document and all attachments were prepared under my direction or supervision in accordance with a system designed to assure that qualified personnel properly gathered and evaluated the information submitted. Based on my inquiry of the person or persons who manage the system, or those persons directly responsible for gathering the information, the information submitted is, to the best of my knowledge and belief, true, accurate, and complete. I have no personal knowledge that the information submitted is other than true, accurate, and complete. I am aware that there are significant penalties for submitting false information, including the possibility of fine and imprisonment for knowing violations.

A BMPP meeting the requirements of this general permit will be implemented prior to discharge.

BMPP certification statement:

Notification provided to the appropriate State, including a copy of this NOI, if required.

Check one: Yes No

Notification provided to the municipality in which the discharge is located, including a copy of this NOI, if requested.

Check one: Yes No

Notification provided to the owner of a private or municipal storm sewer system, if such system is used for site discharges, including a copy of this NOI, if requested.

Check one: Yes No NA

Permission obtained from the owner of a private or municipal storm sewer system, if such system is used for site discharges. If yes, attach additional conditions. If no, attach explanation and timeframe for obtaining permission.

Check one: Yes No NA

Notification provided to the owner/operator of the area associated with activities covered by an additional discharge permit(s). Additional discharge permit is (check one): RGP DGP CGP MSGP Individual NPDES permit Other; if so, specify:

Check one: Yes No NA

Signature:



Date: 6/18/2020

Print Name and Title:

Emily Smith - Delta Air Lines, Chair - BOSFUEL Corporation

J. Certification requirement

I certify under penalty of law that this document and all attachments were prepared under my direction or supervision in accordance with a system designed to assure that qualified personnel properly gathered and evaluated the information submitted. Based on my inquiry of the person or persons who manage the system, or those persons directly responsible for gathering the information, the information submitted is, to the best of my knowledge and belief, true, accurate, and complete. I have no personal knowledge that the information submitted is other than true, accurate, and complete. I am aware that there are significant penalties for submitting false information, including the possibility of fine and imprisonment for knowing violations.

BMPP certification statement: **A BMPP meeting the requirements of this general permit will be implemented prior to discharge.**

Notification provided to the appropriate State, including a copy of this NOI, if required. Check one: Yes No

Notification provided to the municipality in which the discharge is located, including a copy of this NOI, if requested. Check one: Yes No

Notification provided to the owner of a private or municipal storm sewer system, if such system is used for site discharges, including a copy of this NOI, if requested. Check one: Yes No NA

Permission obtained from the owner of a private or municipal storm sewer system, if such system is used for site discharges. If yes, attach additional conditions. If no, attach explanation and timeframe for obtaining permission. Check one: Yes No NA

Notification provided to the owner/operator of the area associated with activities covered by an additional discharge permit(s). Additional discharge permit is (check one): RGP DGP CGP MSGP Individual NPDES permit Other; if so, specify: Check one: Yes No NA

Signature:  Date: 6-15-2020



Print Name and Title: **Tara Canavan, Project Manager**

Boston Inner Harbor

2014 Assessment Unit ID: MA70-02
Water Name: Boston Inner Harbor
Watershed: Boston Harbor (Proper) **Water Type:** ESTUARY **Water Code:** 70902
Size: 2.56 SQUARE MILES **Class:** SB(CSO) **Qualifier:** **Category:** 5 **TMDL Count:** 0
Description: From the Mystic and Chelsea rivers, Chelsea/Boston, to the line between Governors Island and Fort Independence, Boston (East Boston) (including Fort Point, Reserved and Little Mystic channels).

Use	Attainment	Cause	Polntn_Flg	Source	TMDL DWM Id
Aesthetic	Not Assessed				
Fish Consumption	Not Supporting	PCB in Fish Tissue	Y	Contaminated Sediments	
Fish Consumption	Not Supporting	Other	Y	Wet Weather Discharges (Point Source and Combination of Stormwater, SSO or CSO)	
Fish Consumption	Not Supporting	Other	Y	Contaminated Sediments	
Fish Consumption	Not Supporting	Other	Y	Upstream Source	


Overview | Map Layers | Legend | Map Help | Contact | Query Results

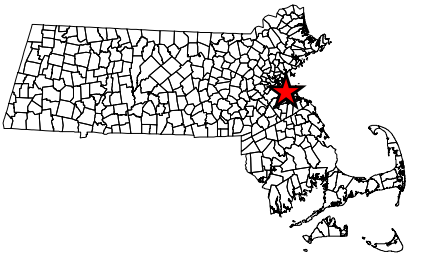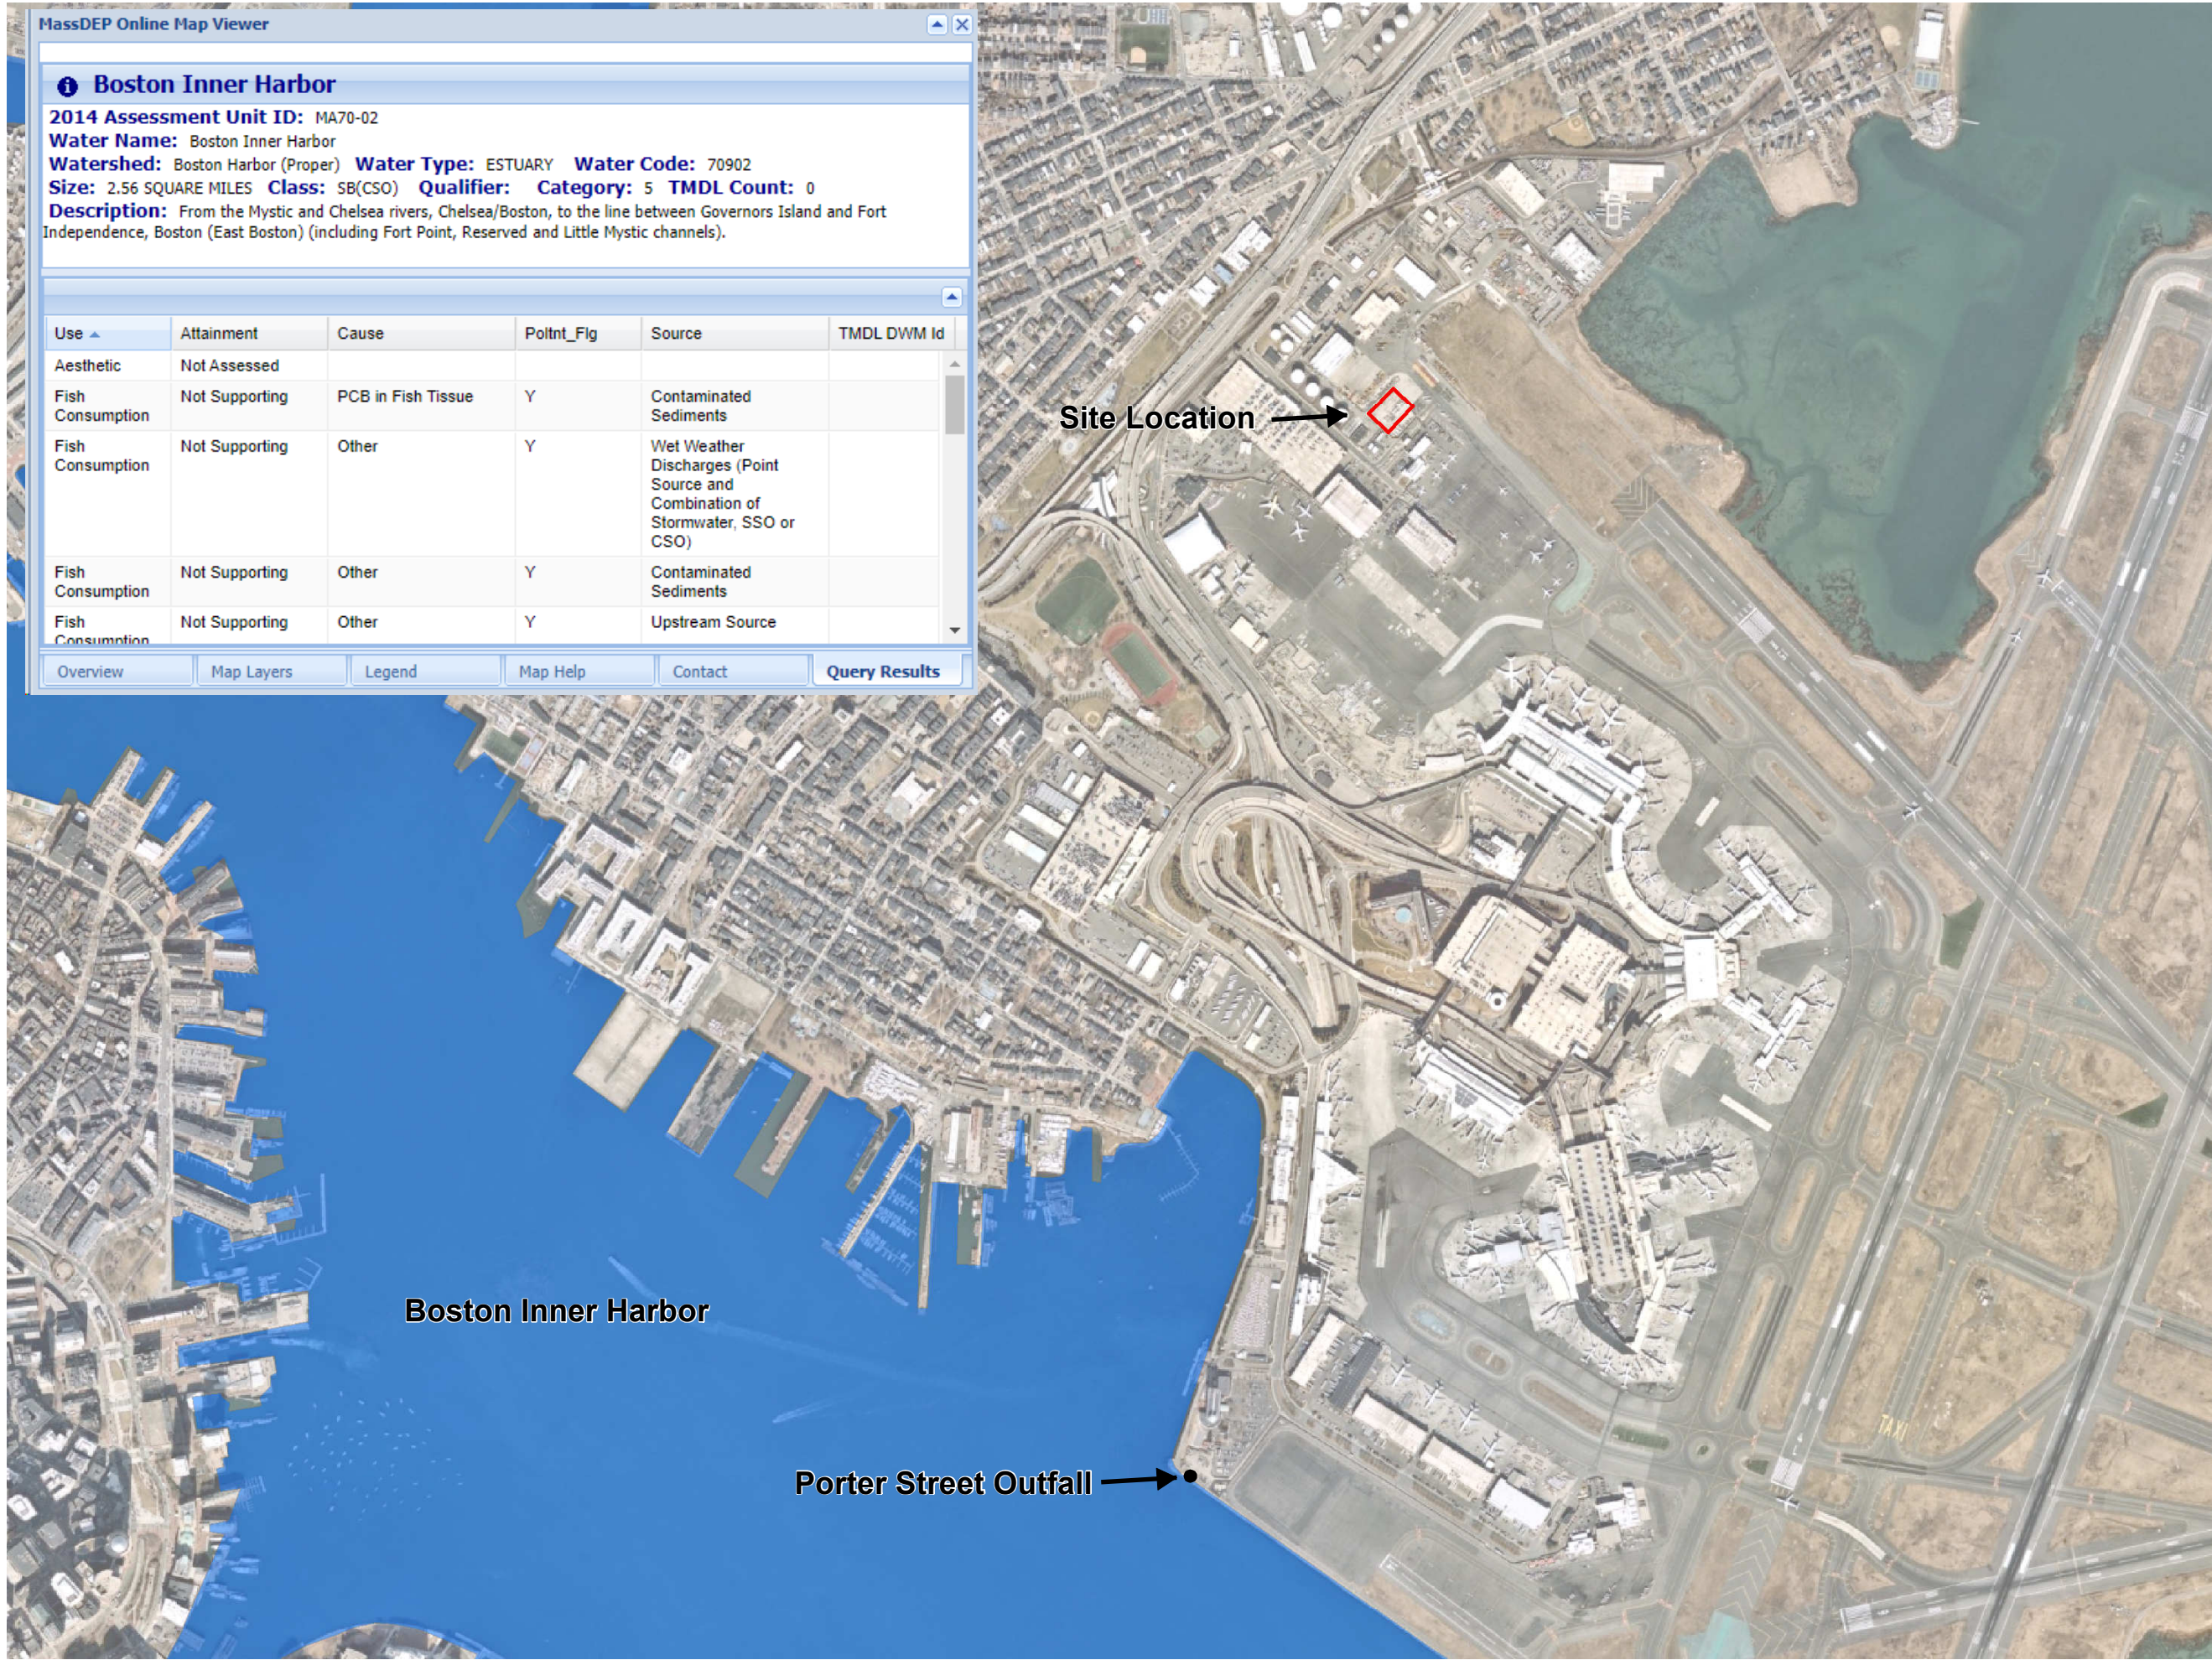

★ Site Location

Legend

- Approximate Excavation Area Location
- Boston Inner Harbor

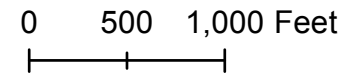

Data Provided by MassGIS

March 30, 2017

Orthoimagery provided by [nearmap.com](#)



2014 Integrated List of Waters Map

Boston Logan International Airport
 Boston, Massachusetts

Date: 05/13/2020

Job #: M948

Created By: ALM

Figure 1



**Table 1: Water Quality Assessment Status for Reporting Year 2014
Boston Inner Harbor**

Designated Use	Designated Use Group	Status
Aesthetic	Aesthetic Value	Impaired
Fish consumption	Aquatic Life Harvesting	Impaired
Fish, Other Aquatic Life and Wildlife	Fish, Shellfish, And Wildlife Protection and Propagation	Impaired
Primary Contact Recreation	Recreation	Impaired
Secondary Contract Recreation	Recreation	Impaired
Shellfish Harvesting	Aquatic Life Harvesting	Impaired


Causes of Impairment for Reporting Year 2014

Cause of Impairment	Cause of Impairment Group	Designated Use(s)	State TMDL Development Status
Dissolved Oxygen	Organic Enrichment/oxygen Depletion	Fish, Other Aquatic Life And Wildlife	TMDL needed
Enterococcus Bacteria	Pathogens	Primary Contact Recreation, Secondary Contact Recreation	TMDL completed
Fecal Coliform	Pathogens	Shellfish Harvesting	TMDL completed
Other Cause	Other Cause	Fish Consumption	TMDL needed
PCB(s) in Fish Tissue	Polychlorinated Biphenyls (PCBs)	Fish Consumption	TMDL needed


Sources:

1. EPA website: https://ofmpub.epa.gov/waters10/attains_index.home on July 8, 2019
2. Final Pathogen TMDL for the Boston Harbor, Weymouth-Weir, and Mystic Watersheds, October 2018. <https://www.mass.gov/files/documents/2018/12/06/bharbor1.pdf>

ATTACHMENT B

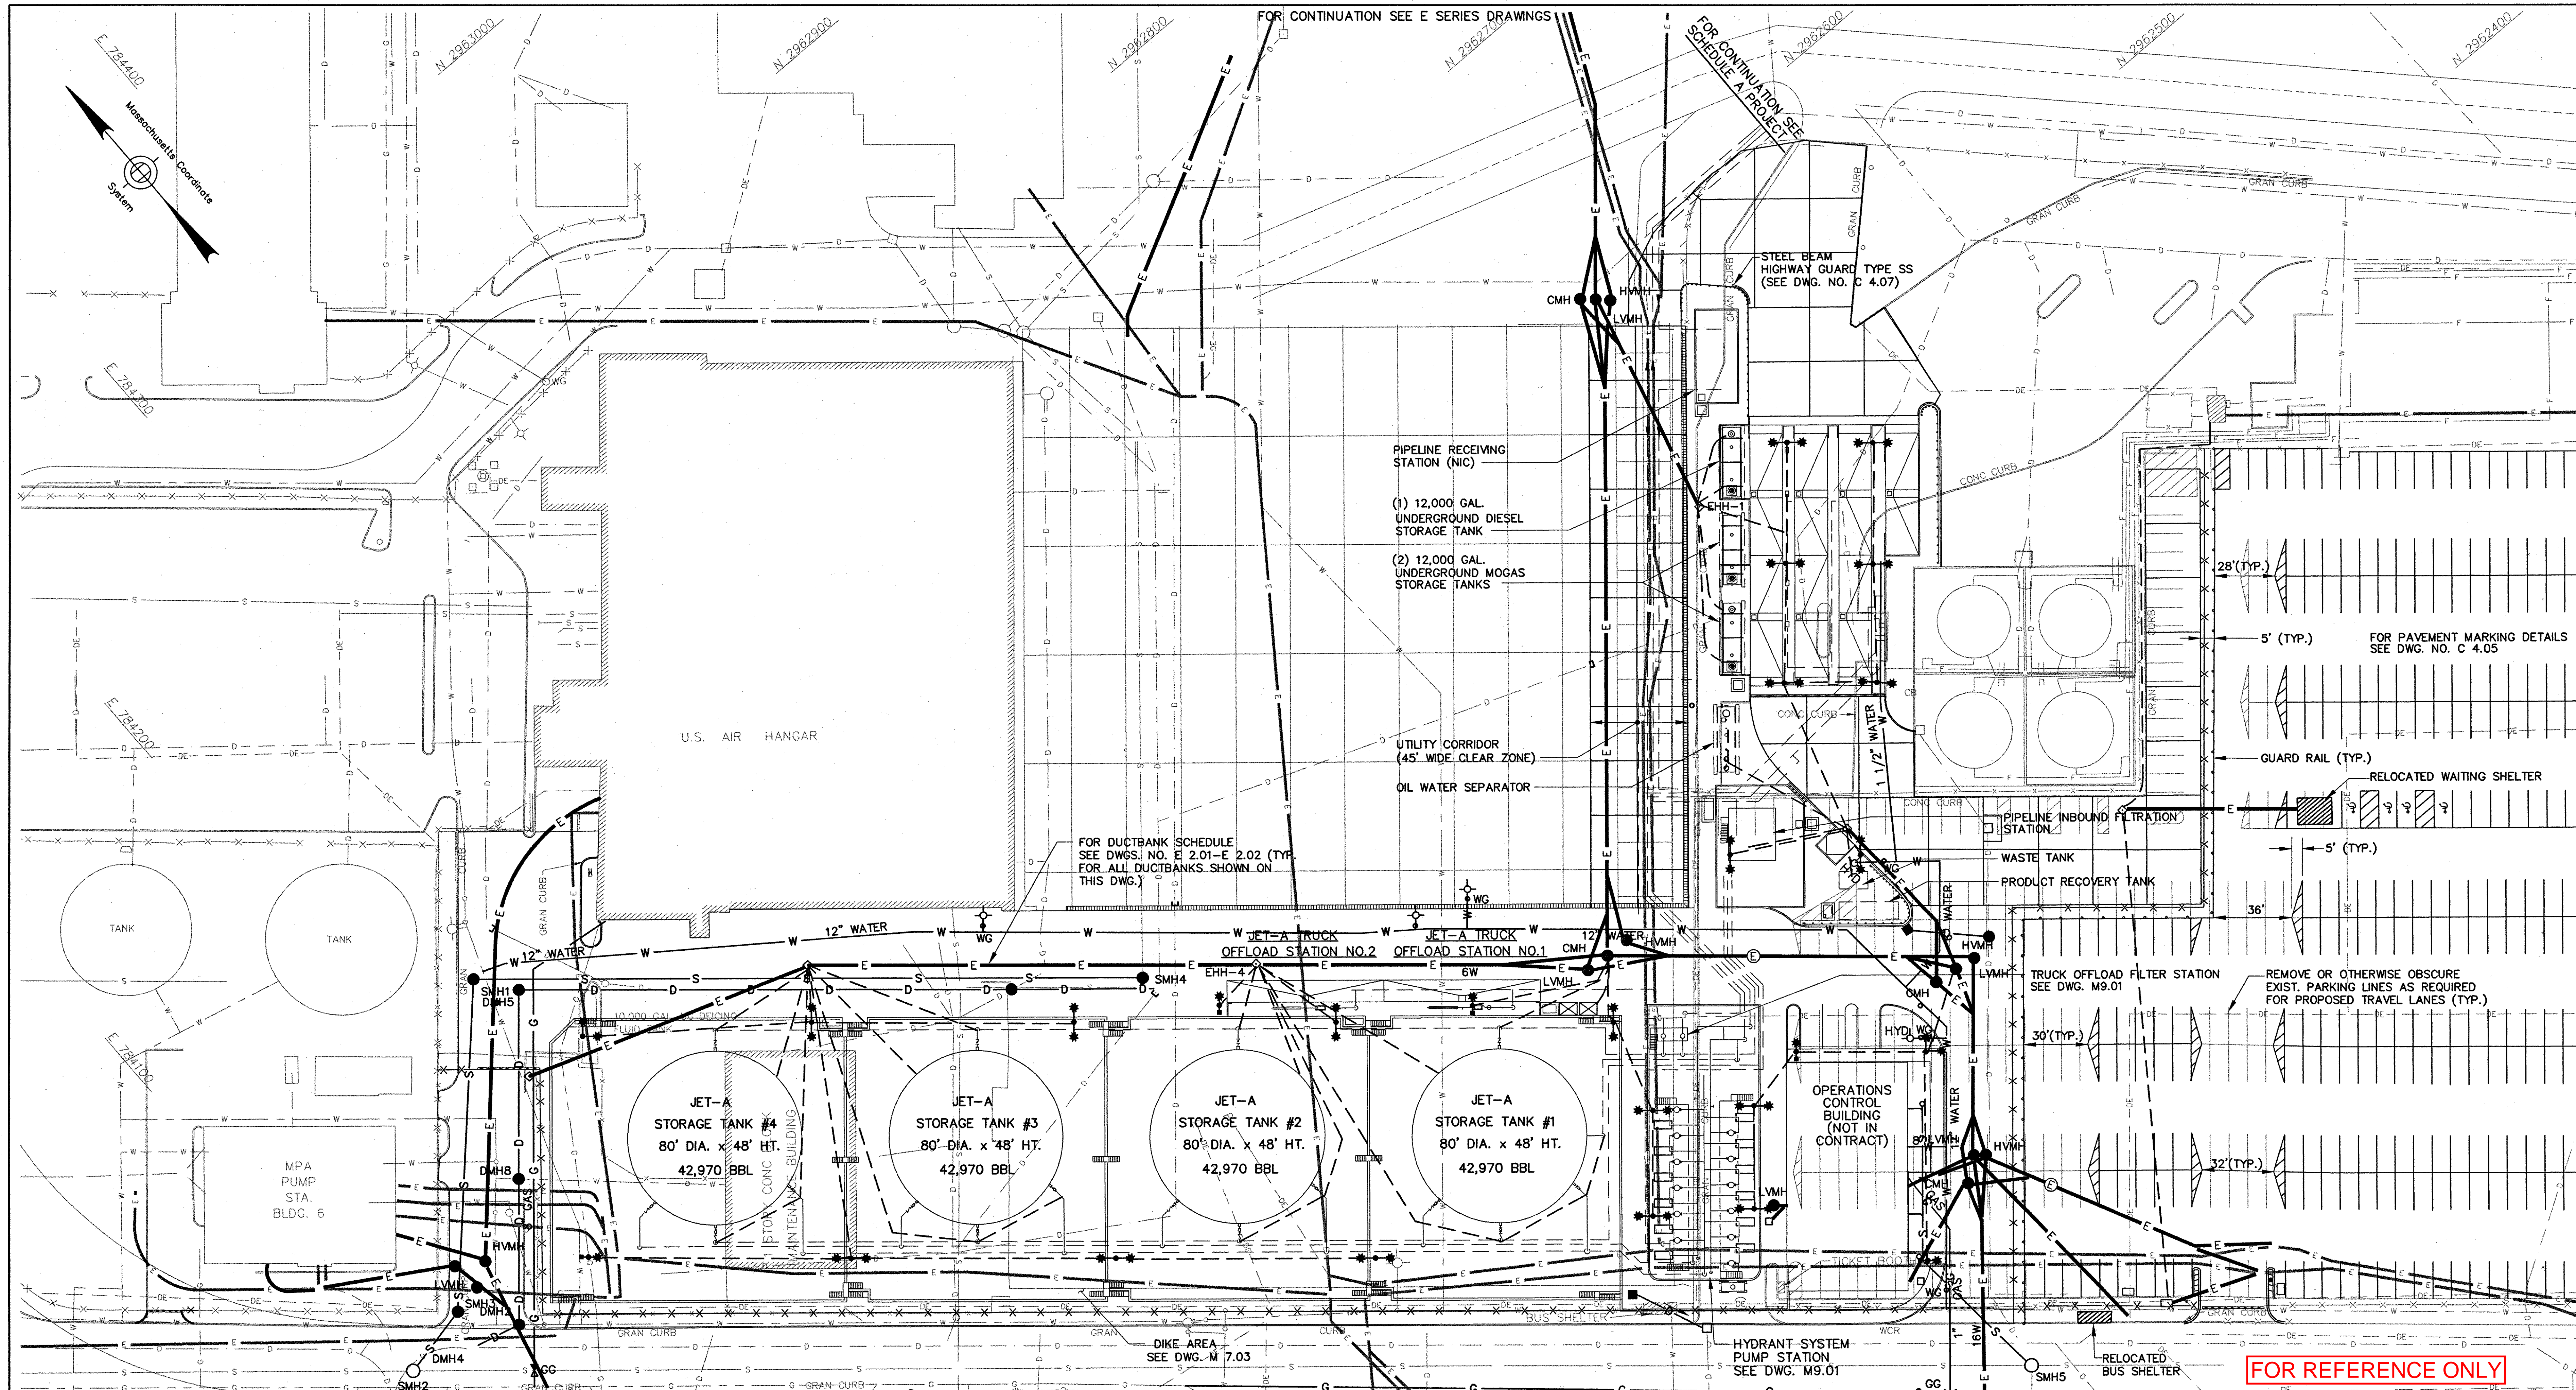

GENERAL LEGEND					
PROPOSED	EXISTING	ITEM	PROPOSED	EXISTING	ITEM
■ CB	□ C.B.	CATCH BASIN	— S —	— S —	SEWERAGE LINE
● SMH	○ SMH	SEWER MANHOLE	— D —	— D —	DRAINAGE LINE
● DMH	○ DMH	DRAIN MANHOLE	— W —	— W —	WATER LINE
● EMH	○ EMH	ELECTRIC MANHOLE	— G —	— G —	GAS LINE
□ EHH	□ EHH	ELECTRIC HANDHOLE	— F —	— F —	FUEL LINE
○ WMH	○ WMH	WATER MANHOLE	— E —	— E —	DUCT BANK
● CMH	○ CMH	CONTROL MANHOLE	— DE —	— DE —	DIRECT BURIED ELECTRICAL CONDUIT
○ TMH	○ TMH	TELEPHONE MANHOLE	— SG —	— SG —	SECURITY GATE
○ WG	○ WG	WATER GATE	— L —	— L —	LIGHT POLE
— HYD	— HYD	FIRE HYDRANT	— B —	— B —	BLAST WALL
— GG	— GG	GAS GATE	— CB —	— CB —	EXISTING CATCH BASIN TO BE MODIFIED
—	—	CURB INLET	— SMH —	— SMH —	EXISTING SEWER MANHOLE TO BE MODIFIED
—	—	CHAIN LINK FENCE	— DMH —	— DMH —	EXISTING DRAIN MANHOLE TO BE MODIFIED

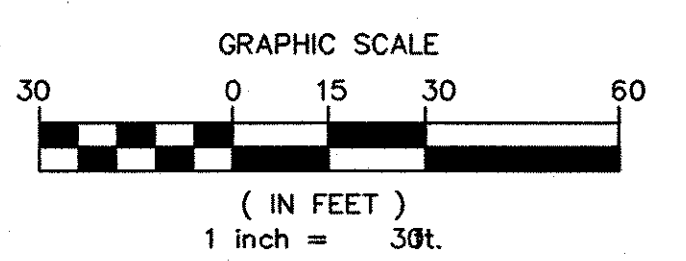

NOTES

- WHEN INSTALLING ANY NEW UTILITIES THE CONTRACTOR DID TAKE WHATEVER MEASURES NECESSARY TO PROTECT ALL EXISTING UTILITIES TO REMAIN. THESE MEASURES INCLUDED SHEETING AND SHORING. ALL SUCH PROTECTIVE MEASURES ARE CONSIDERED INCIDENTAL TO THE VARIOUS WORK ITEMS AND NO SEPARATE PAYMENT WAS MADE FOR THESE MEASURES.
- FOR GRADING PLAN SEE DWG. NO. C 2.03.
- FOR DRAINAGE PLAN SEE DWG. NO. C 2.04.
- FOR SANITARY SEWER PLAN SEE DWG. NO. C 2.05.
- FOR NATURAL GAS AND WATER PLAN SEE DWG. NO. C 2.06.
- FOR DEMOLITION PLAN SEE DWG. NO. C 2.07.
- FOR ELECTRICAL INFORMATION SEE E SERIES DWGS.
- FOR MECHANICAL INFORMATION SEE M SERIES DWGS.



AS CONSTRUCTED PLANS*
I hereby certify that all construction required
by this sheet has been accomplished as indicated
hereon.

EDWARDS AND KELCEY, INC.
BY *Steph E. Kim* DATE 1/9/02

FOR REFERENCE ONLY

1	12/01	AS-CONSTRUCTED	SNA	SEA	ESD
REV. NO.	DATE	DESCRIPTION	MADE BY	CHK. BY	APPD. BY
MASSACHUSETTS PORT AUTHORITY BOSTON, MASSACHUSETTS					
BOSTON LOGAN INTERNATIONAL AIRPORT EAST BOSTON, MASSACHUSETTS					
AIRCRAFT FUELING SYSTEMS SCHEDULE B - FUEL STORAGE FACILITY PROPOSED SITE CONDITIONS					
CONSULTANT AND SUBCONSULTANT:					
GREINER INC. TAMPA, FLORIDA EDWARDS AND KELCEY INC. BOSTON, MASSACHUSETTS					
DRAWN BY: TED		CHKD. BY: DMM		DWG. NO.:	
SCALE: 1"=30'		APPROVED: -		DATE: 1/97	
MPA CONTRACT NO.: MPA 1.646C (R)				SHEET NO. 9 OF 200	

AS BUILT

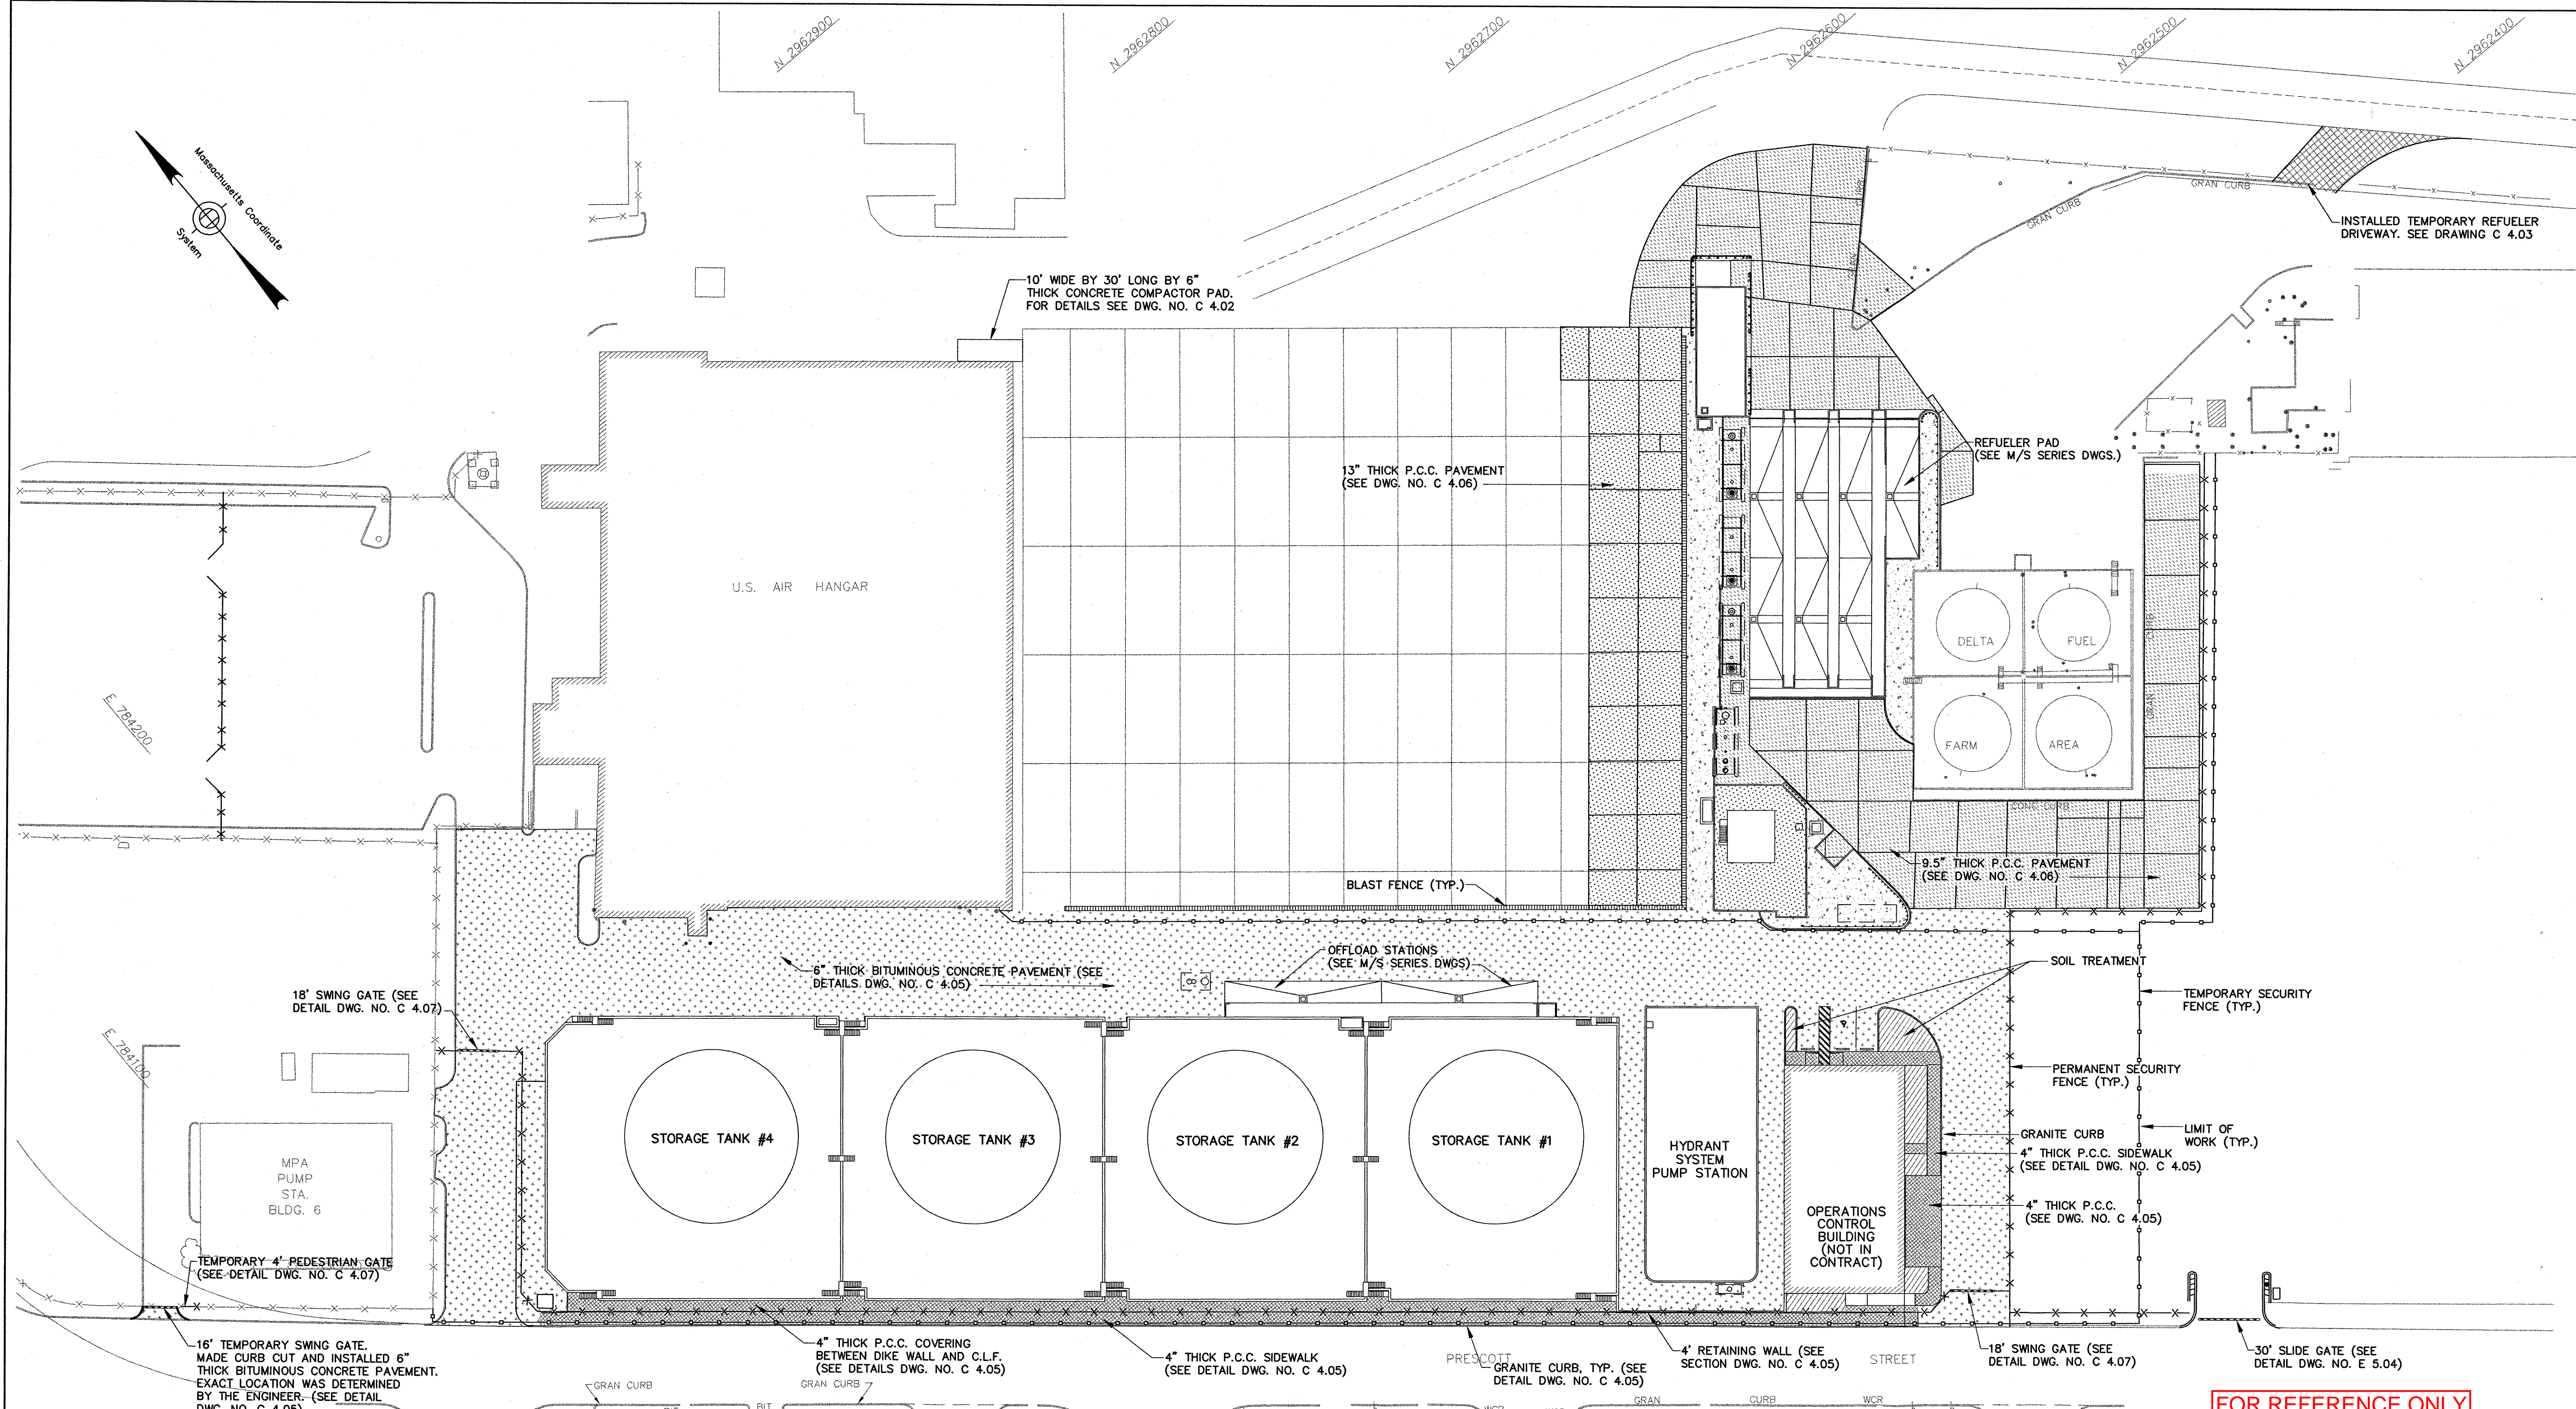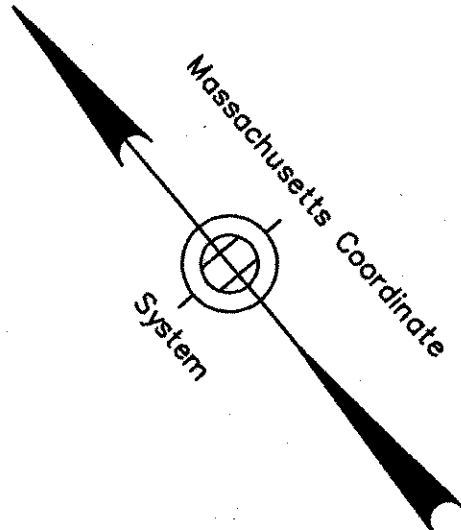


LEGEND		
AS CONSTR	EXISTING	ITEM
[Pattern]	[Pattern]	6" THICK BITUMINOUS CONCRETE PAVEMENT
[Pattern]	[Pattern]	9.5" THICK P.C.C. PAVEMENT
[Pattern]	[Pattern]	13" THICK P.C.C. PAVEMENT
[Pattern]	[Pattern]	4" THICK P.C.C. SIDEWALK
[Pattern]	[Pattern]	6" THICK TEMP. PAVEMENT
[Pattern]	[Pattern]	SOIL TREATMENT (MULCH, SHRUBS, ETC.)
[Pattern]	[Pattern]	6" THICK CRUSHED STONE

NOTES

- FOR PAVEMENT DETAILS SEE DWG. NO. C 4.05.
- FOR P.C.C. PAVEMENT JOINT LAYOUT AND DETAILS SEE DWG. NO. C 4.06.
- FOR GENERAL LEGEND SEE DWG. NO. C 1.02.
- FOR GENERAL PHASING NOTES SEE DWG. NO. PH 1.01.
- FOR PAVEMENT ASSOCIATED WITH FUEL FACILITY STRUCTURES SEE M AND S SERIES DRAWINGS.

AS CONSTRUCTED PLANS
I hereby certify that all construction required by this sheet has been accomplished as indicated hereon.
EDWARDS AND KELCEY, INC.

BY *Steph E. Quinn* DATE 1/9/02

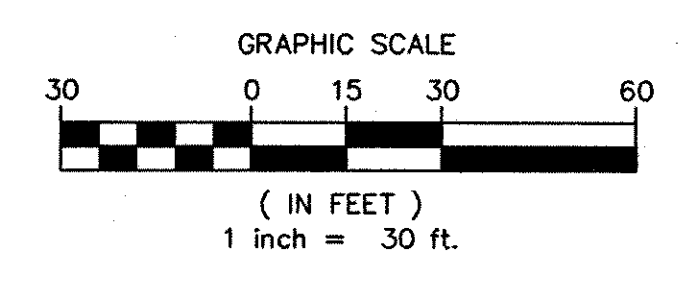

FOR REFERENCE ONLY

REV. NO.	DATE	DESCRIPTION	SNA MADE BY	SEA CHK. BY	ESD APPD. BY
1	12/01	AS CONSTRUCTED			

**MASSACHUSETTS PORT AUTHORITY
BOSTON, MASSACHUSETTS**

**BOSTON LOGAN INTERNATIONAL AIRPORT
EAST BOSTON, MASSACHUSETTS**


**AIRCRAFT FUELING SYSTEMS
SCHEDULE B - FUEL STORAGE FACILITY
SITE PAVEMENT PLAN**

CONSULTANT AND SUBCONSULTANT:
GREINER INC. TAMPA, FLORIDA
EDWARDS AND KELCEY INC. BOSTON, MASSACHUSETTS

DRAWN BY: TED	CHKD. BY: DMM	DWG. NO: C 2.02
SCALE: AS SHOWN	APPROVED: [Signature]	DATE: 11/96

MPA CONTRACT NO.: MPA 1.646C (R) SHEET NO. 11 OF 200

AS BUILT

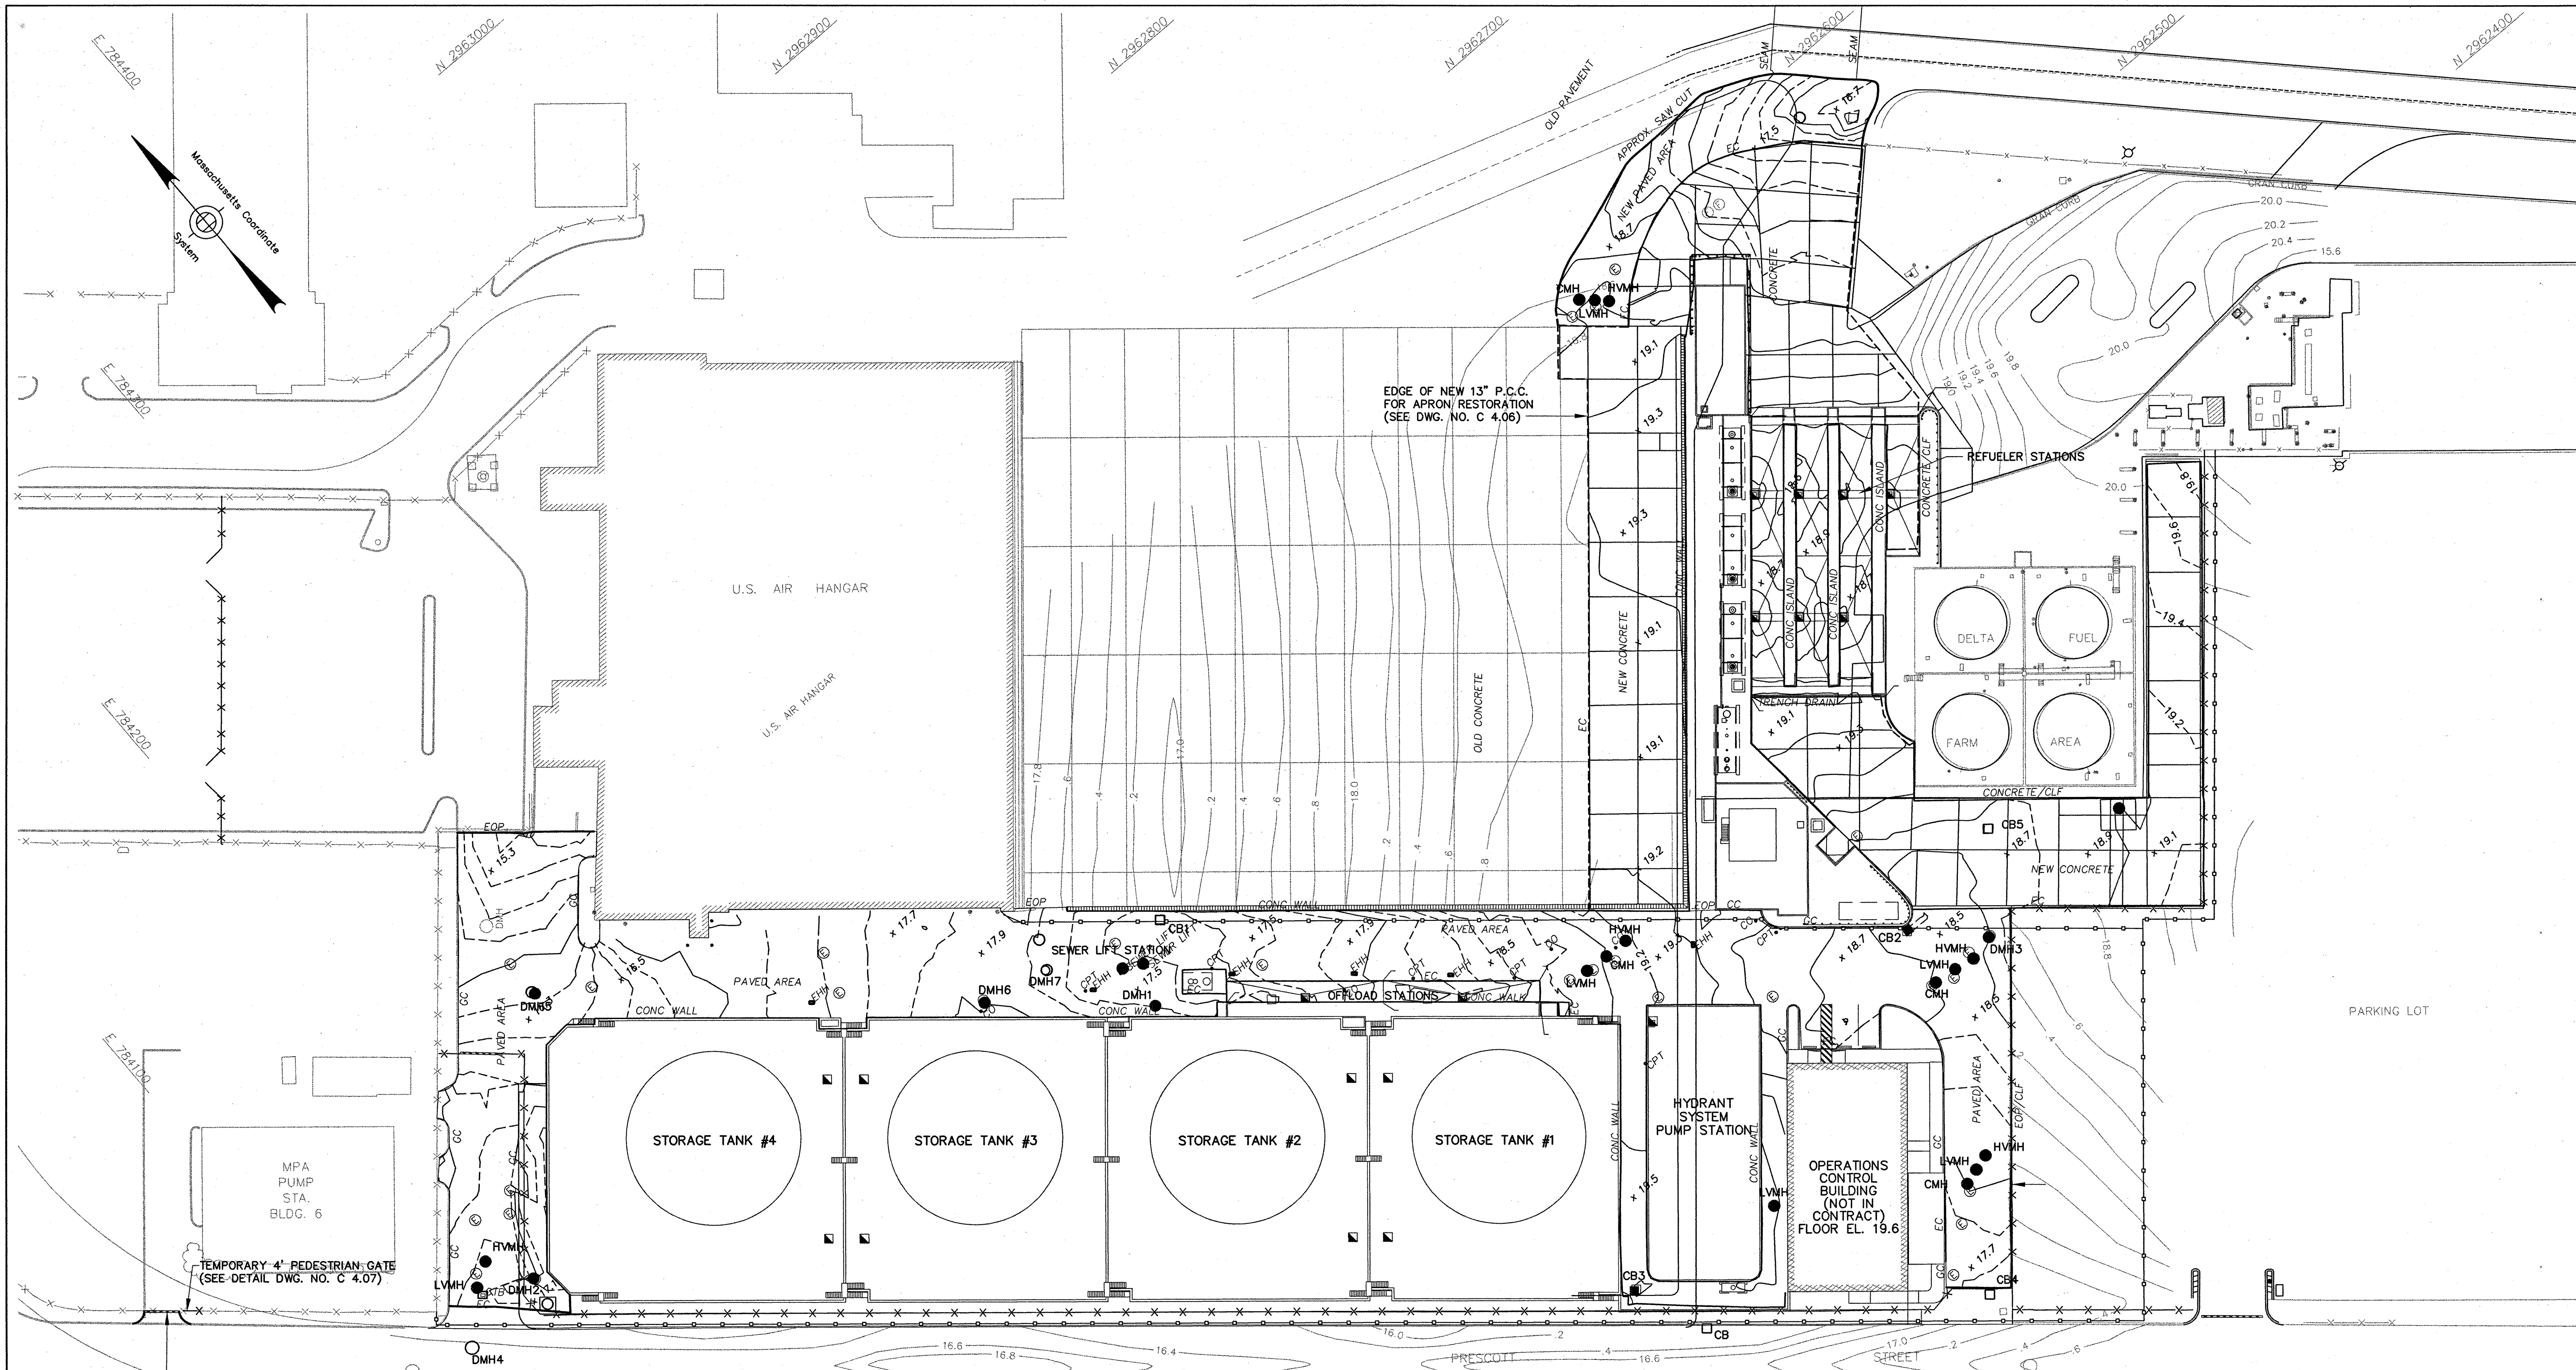

FOR REFERENCE ONLY

REV. NO.	DATE	DESCRIPTION	SNA	SEA	ESD
1	12/01	AS CONSTRUCTED			

MASSACHUSETTS PORT AUTHORITY
BOSTON, MASSACHUSETTS

BOSTON LOGAN INTERNATIONAL AIRPORT
EAST BOSTON, MASSACHUSETTS

AIRCRAFT FUELING SYSTEMS
SCHEDULE B - FUEL STORAGE FACILITY
SITE GRADING PLAN

CONSULTANT AND SUBCONSULTANT:
GREINER INC. TAMPA, FLORIDA
EDWARDS AND KELCEY INC. BOSTON, MASSACHUSETTS


DRAWN BY: TED CHKD. BY: CWB DWG. NO.: C 2.03
 SCALE: AS SHOWN APPROVED: DATE: 11/96

MPA CONTRACT NO.: MPA 1.646C (R) SHEET NO. 17 OF 200

- NOTES**
1. THE CONTRACTOR USED CONCRETE BARRIERS (SEE DWG. NO. SF 2.01) TO DELINEATE WORK AREAS FOR AIRSIDE CONSTRUCTION AS APPROVED BY THE ENGINEER.
 2. THE CONTRACTOR ONLY CLOSED ONE LANE OF TRAFFIC AT A TIME FOR ANY WORK REQUIRED IN PRESCOTT STREET WITH PRIOR APPROVAL BY THE ENGINEER.
 3. FOR OFFLOAD STATION DETAILS SEE M SERIES DWGS.
 4. FOR REFUELER STATION AREA DETAILS SEE M SERIES DWGS.
 5. FOR RIM ELEVATIONS SEE APPROPRIATE UTILITY DWGS.
 6. FOR MECHANICAL INFORMATION SEE M SERIES DWGS.
 7. FOR GENERAL LEGEND SEE DWGS. NO. C 1.02
 8. FOR GENERAL PHASING NOTES SEE DWG. NO. PH 1.01.



AS CONSTRUCTED PLANS
 I hereby certify that all construction required by this sheet has been accomplished as indicated hereon.
 EDWARDS AND KELCEY, INC.

By *Steph E. Ouellet* DATE 1/9/02

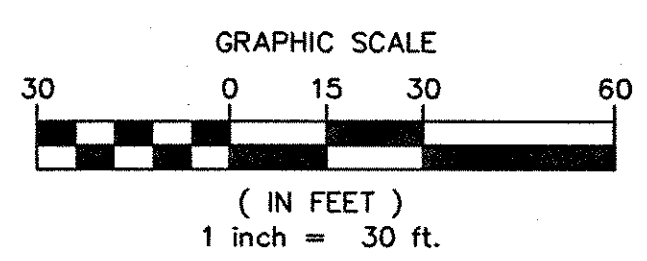


16" TEMPORARY SWING-GATE, MADE CURB CUT AND INSTALLED 6" THICK TEMPORARY BITUMINOUS PAVEMENT. EXACT LOCATION WAS DETERMINED BY ENGINEER. (SEE DETAILS DWG. NO. C 4.05)

AS BUILT

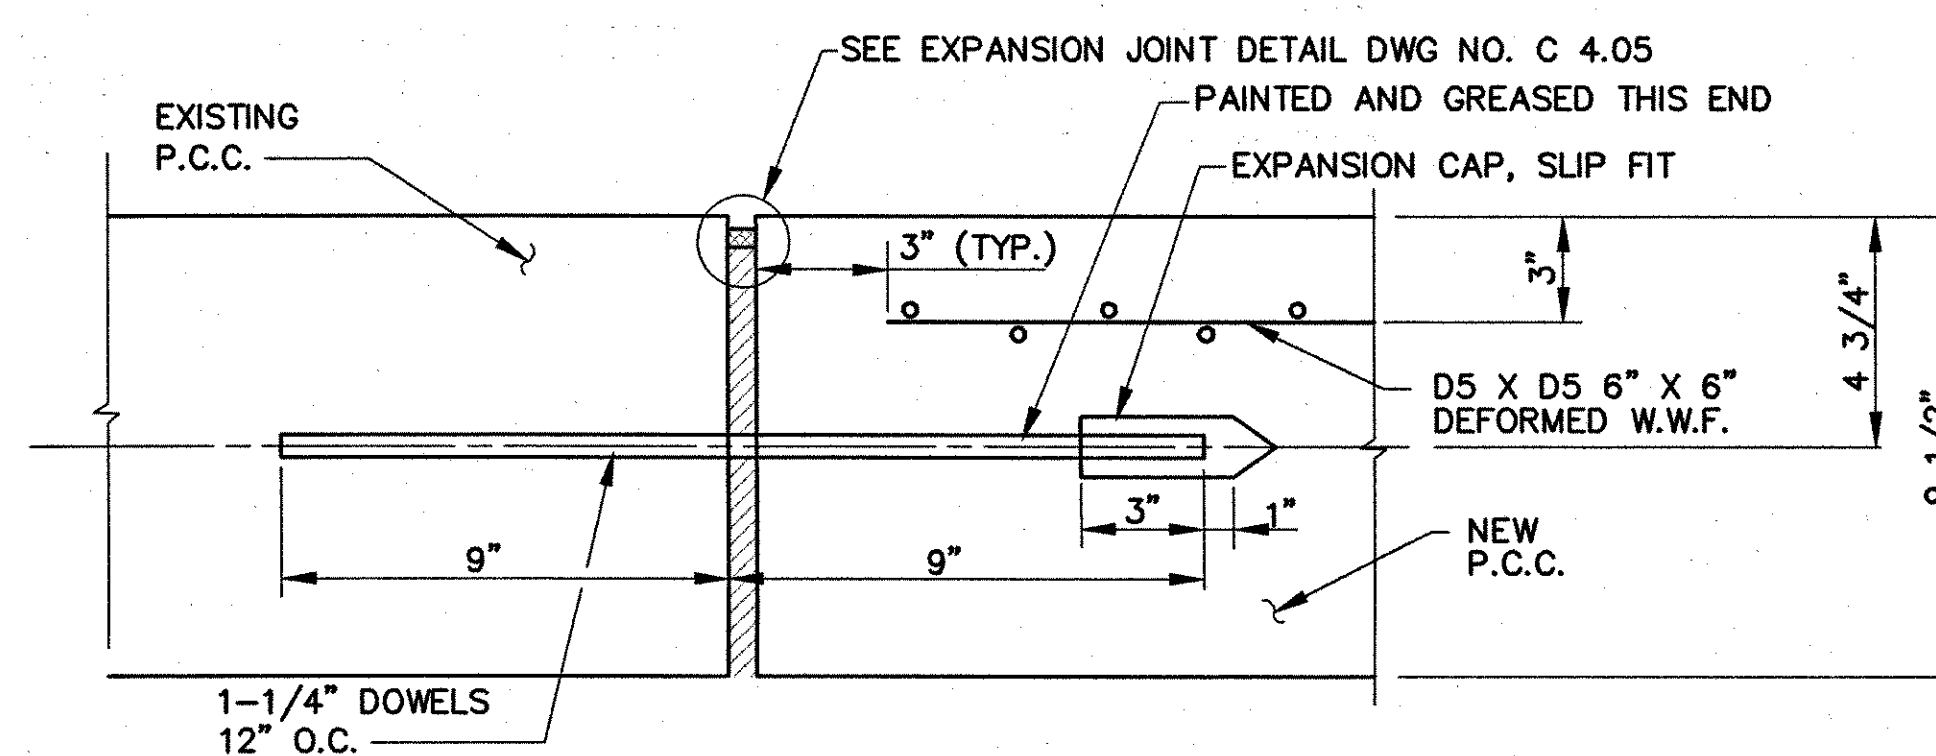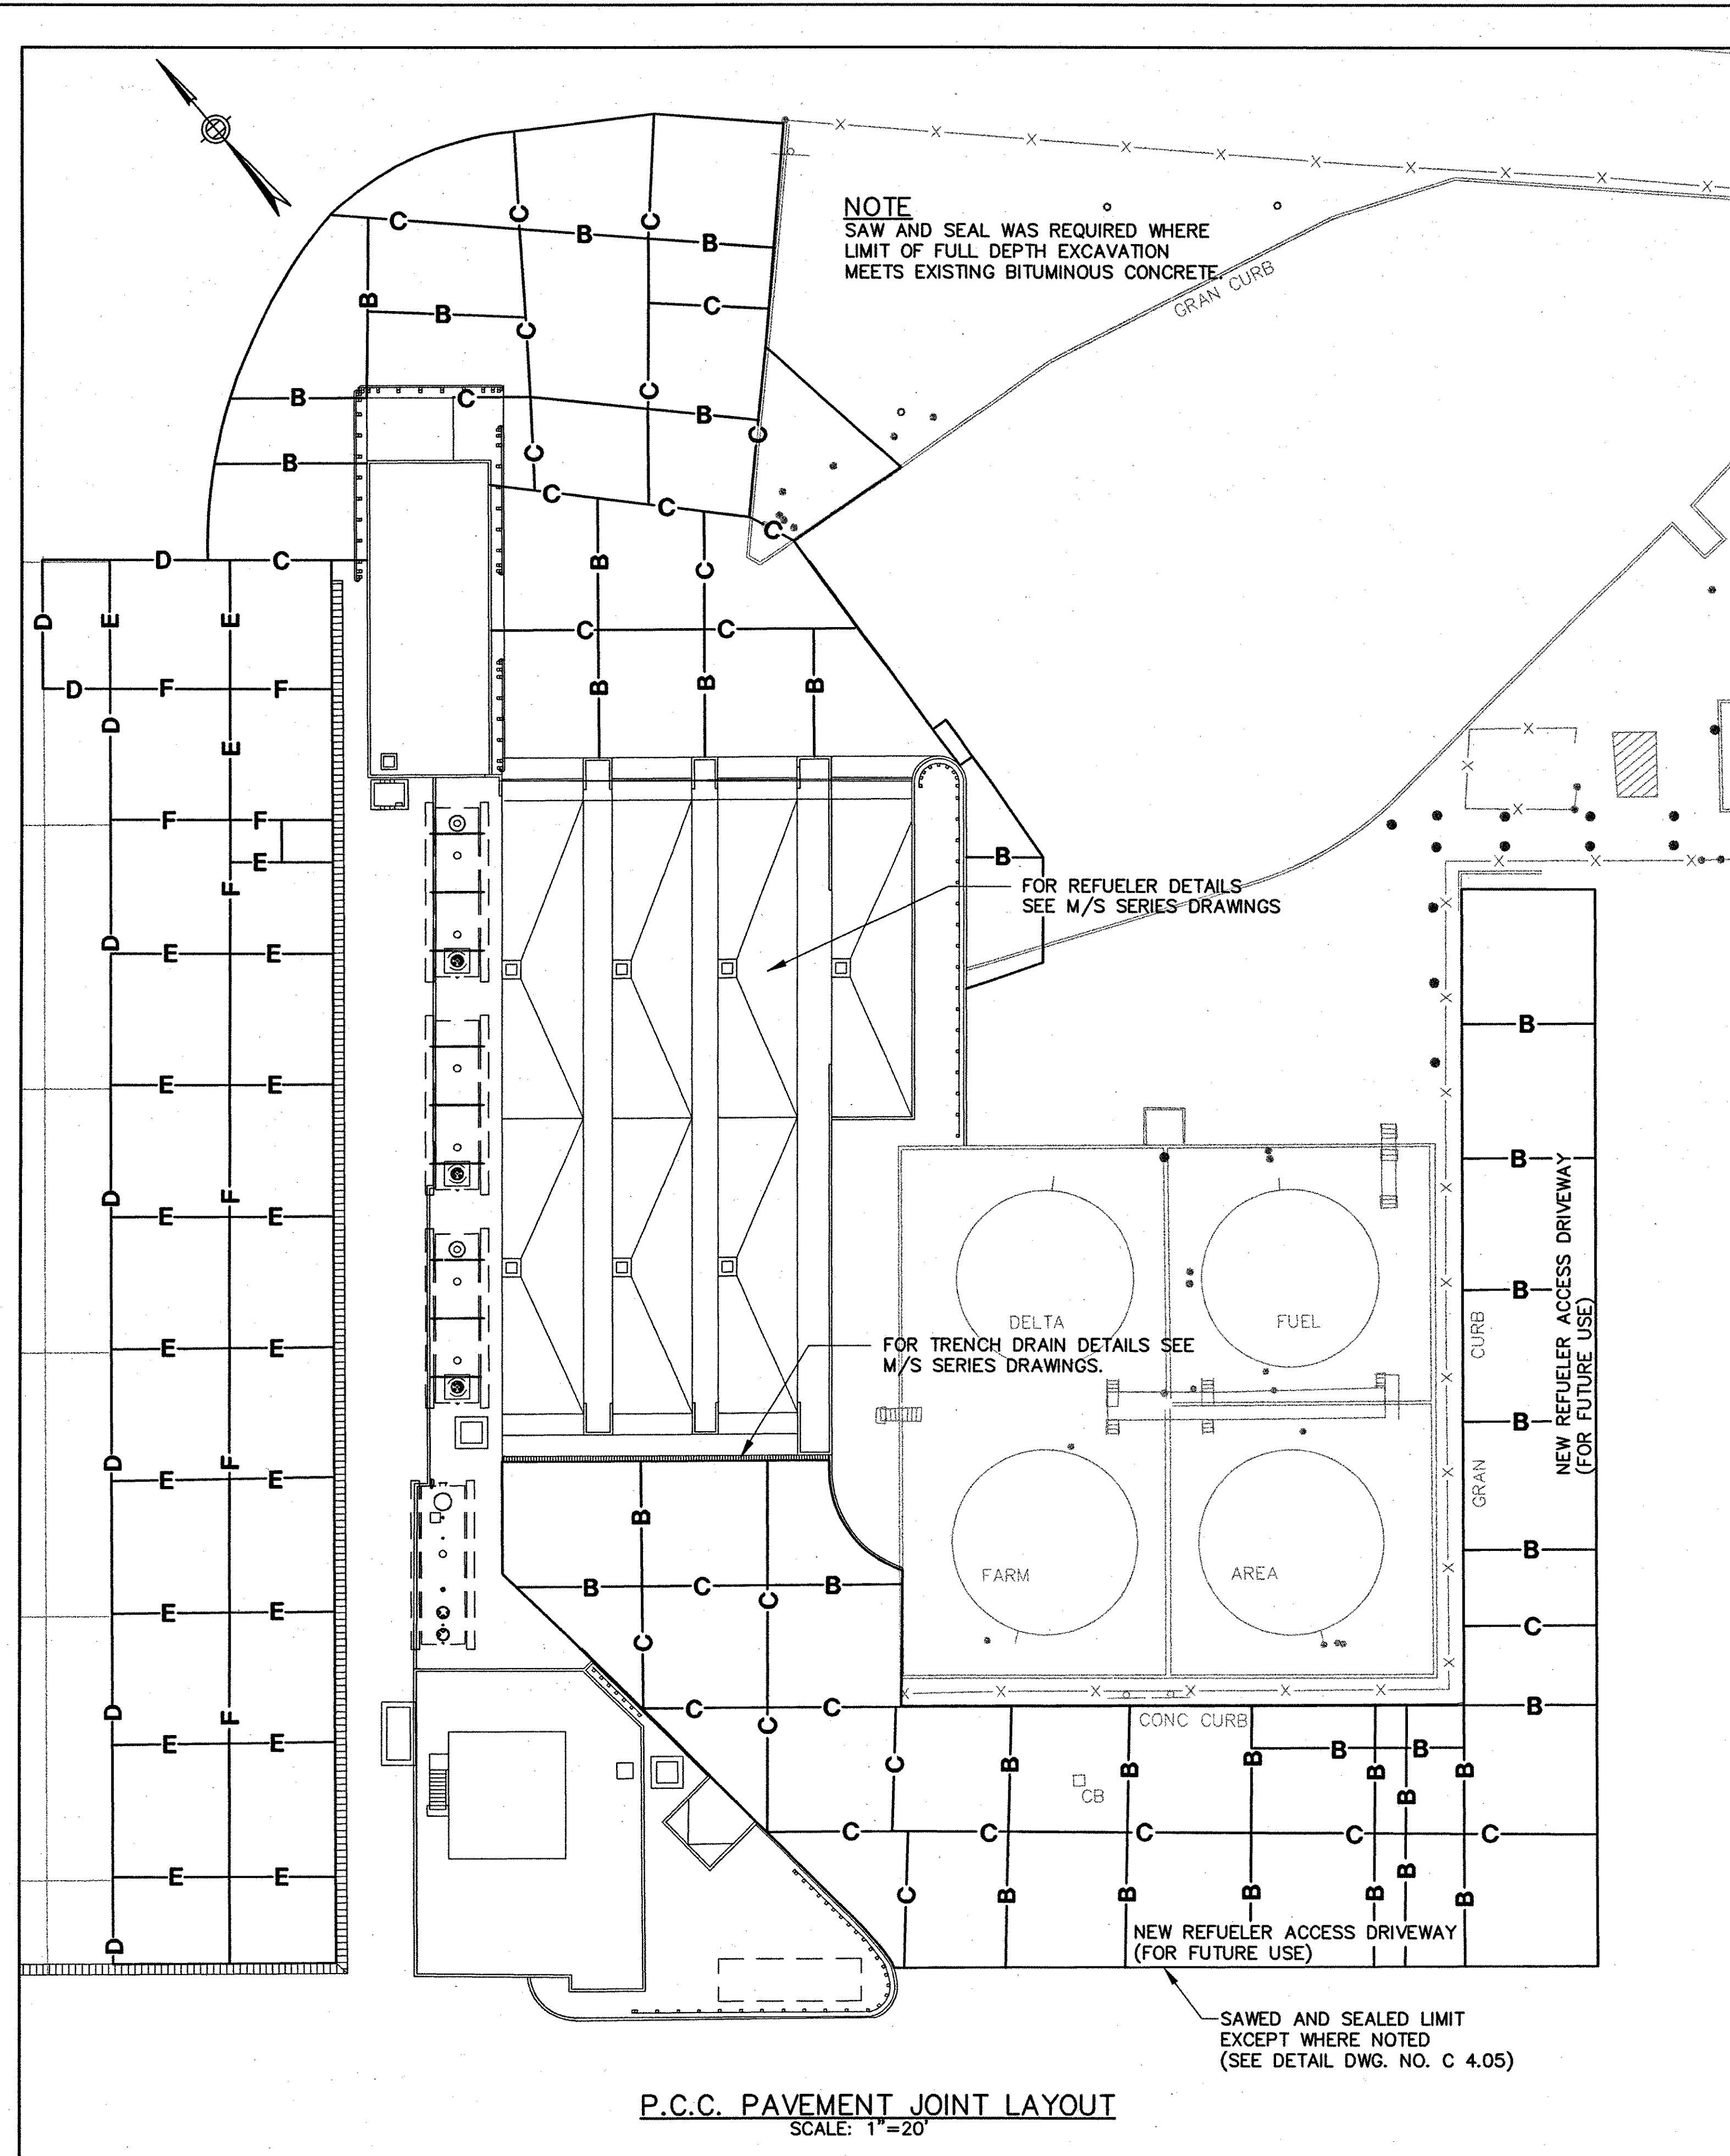


NOTE:
WHEN PROPOSED P.C.C. MET EXISTING P.C.C., CONTRACTOR CORED EXISTING P.C.C. AND EPOXY GROUTED DOWEL IN PLACE.

TYPE "A" - EXPANSION JOINT

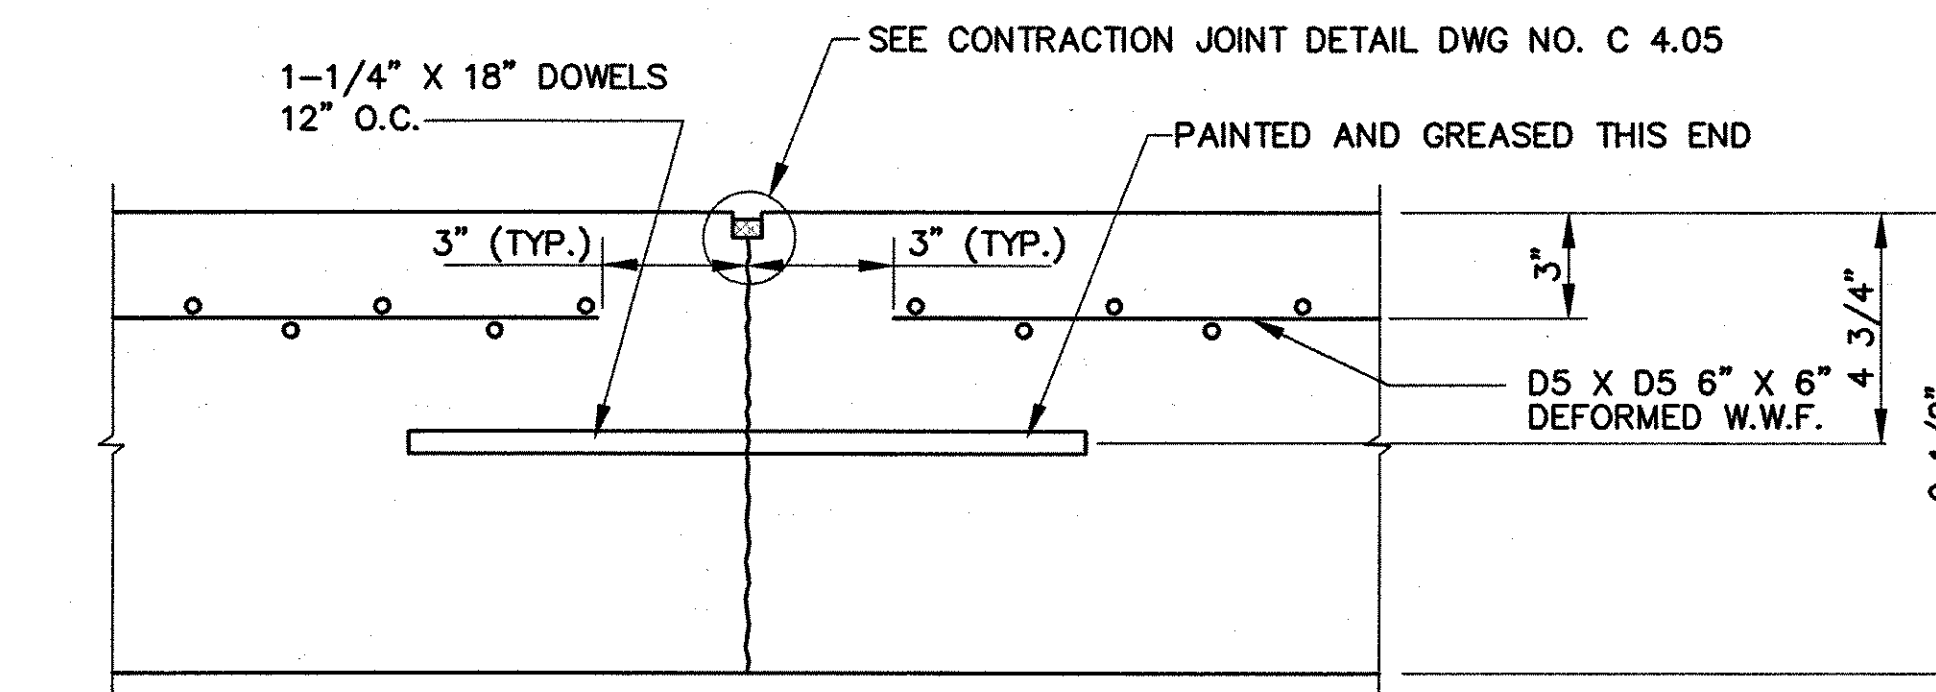


TYPE "B" - CONTRACTION JOINT

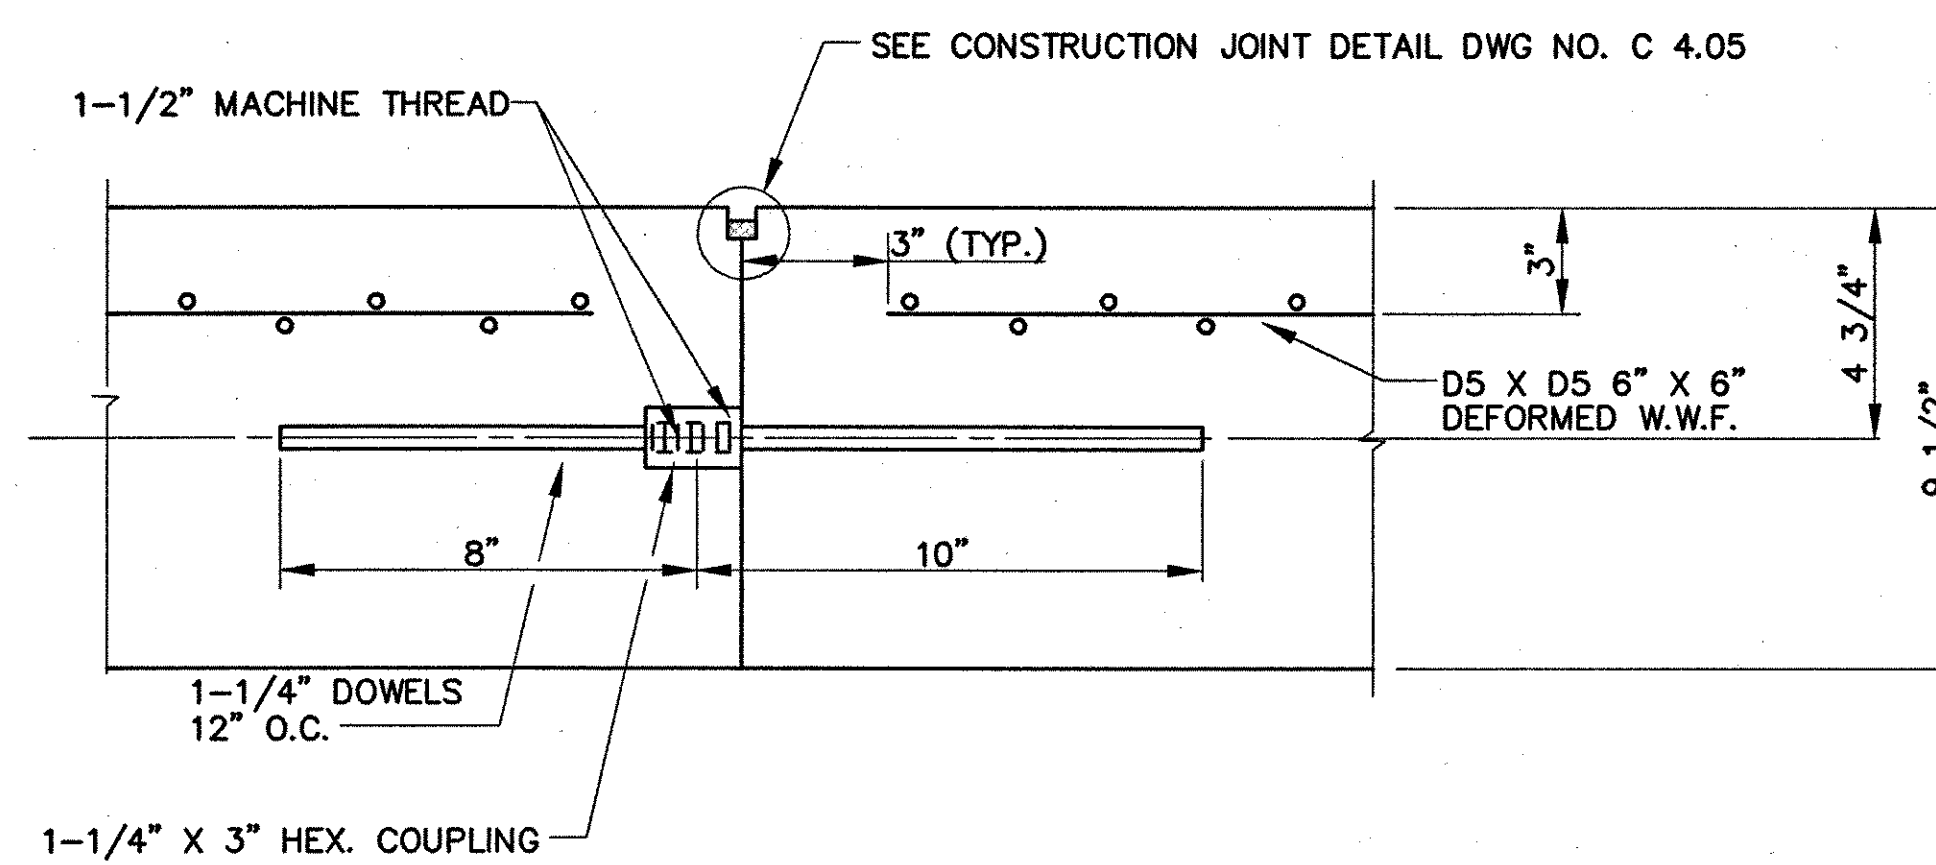


TYPE "C" - CONSTRUCTION JOINT


9.5" THICK REFUELER P.C.C. JOINT DETAILS
NOT TO SCALE

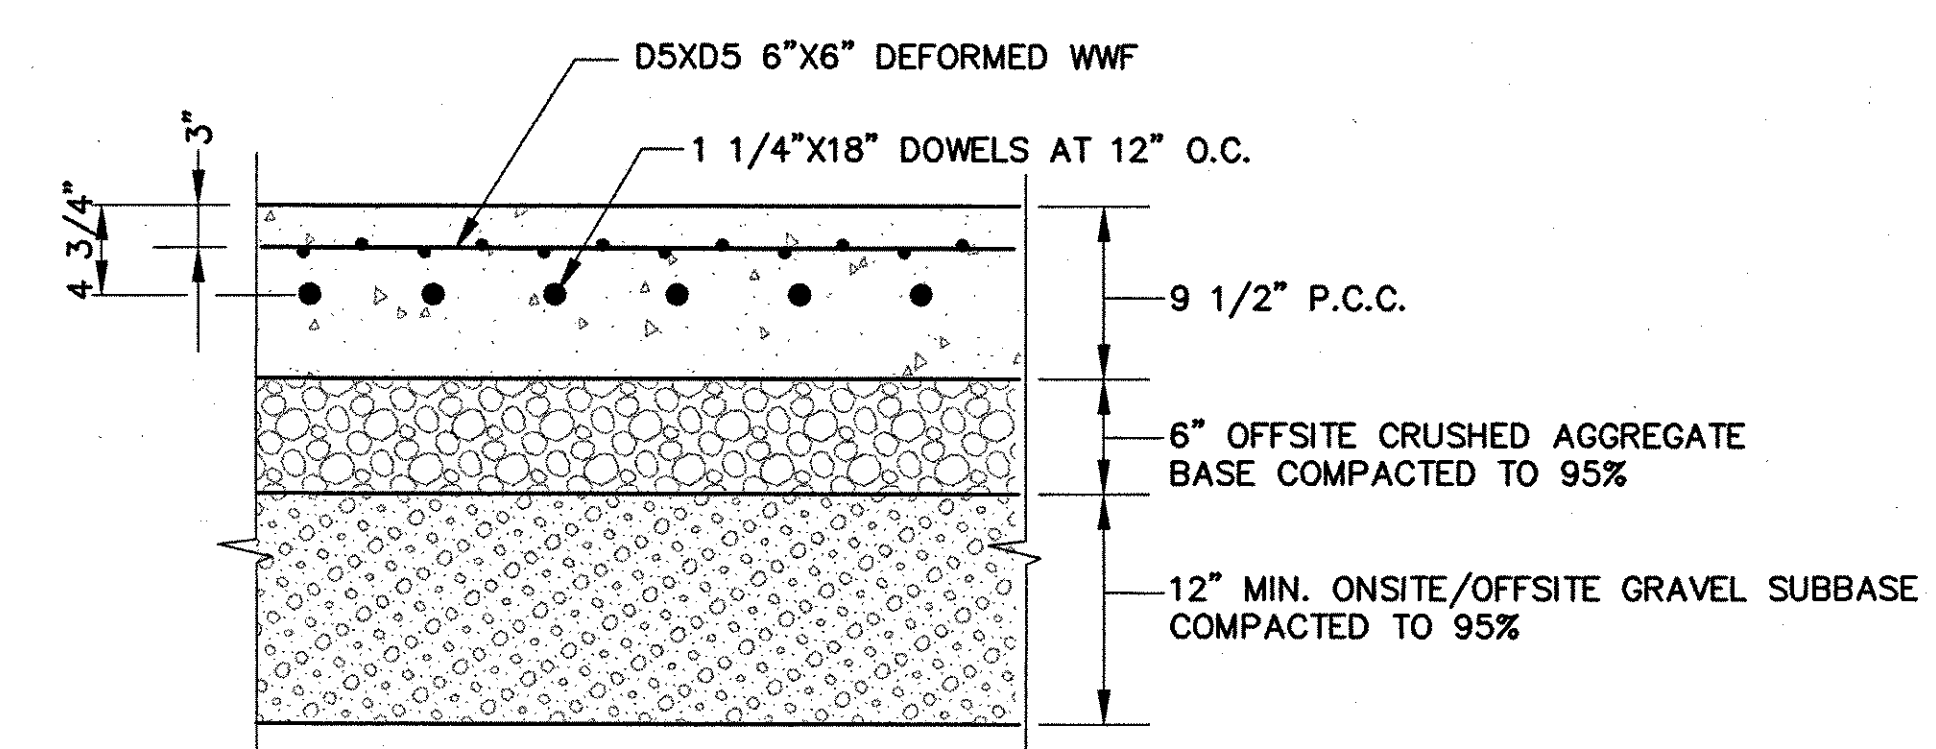

TYPICAL 9.5" REFUELER P.C.C. SECTION
NOT TO SCALE

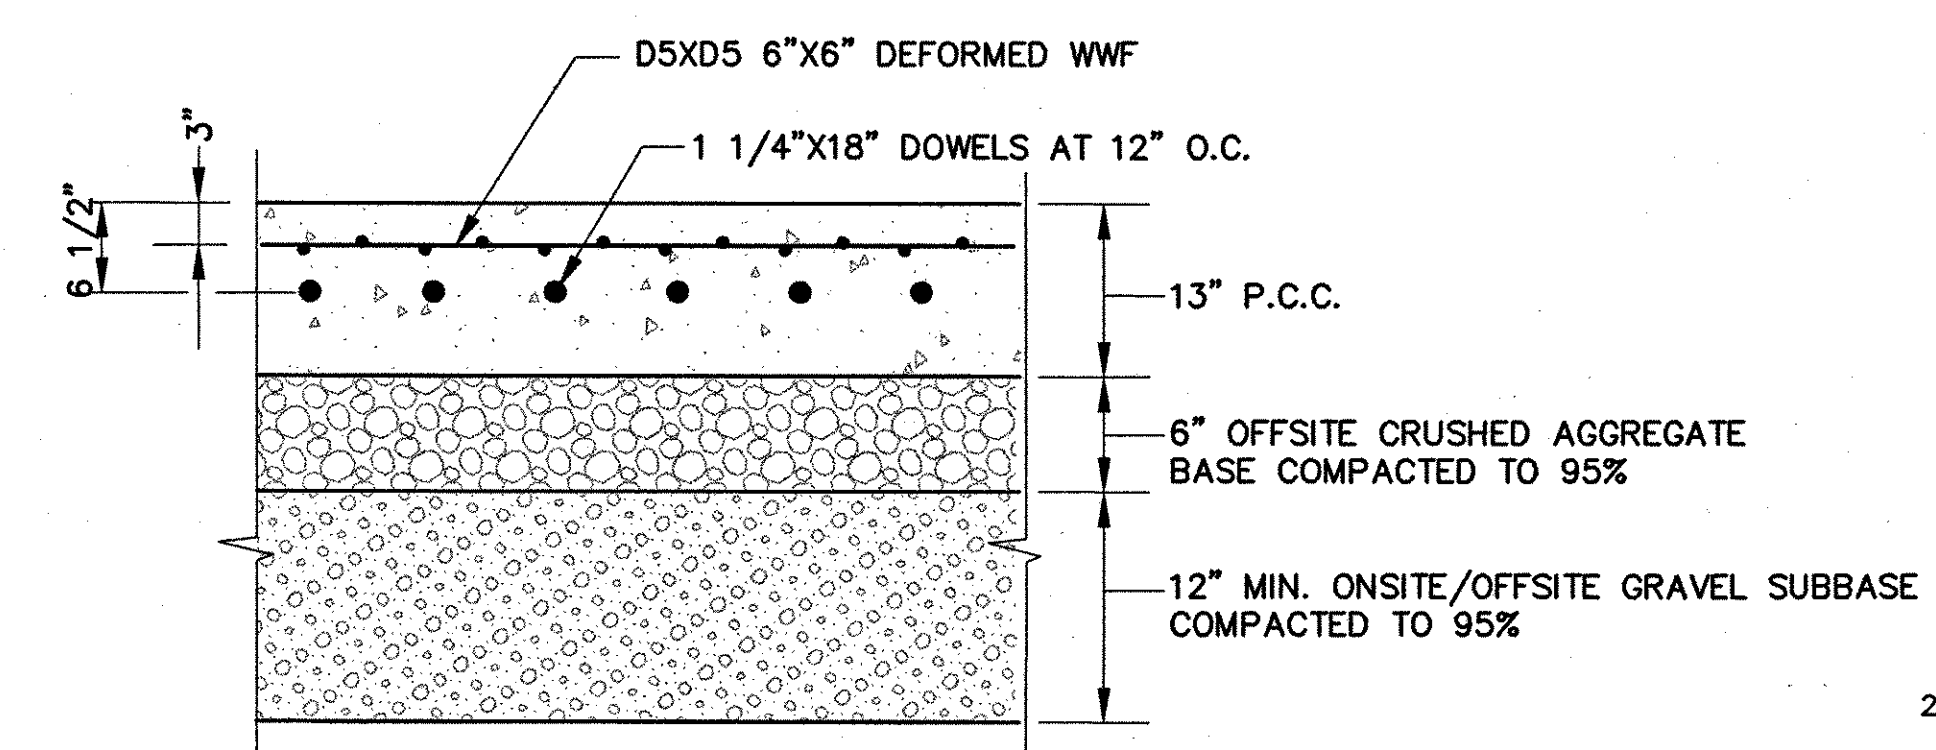


TYPICAL 13" P.C.C. USAIR APRON SECTION
NOT TO SCALE

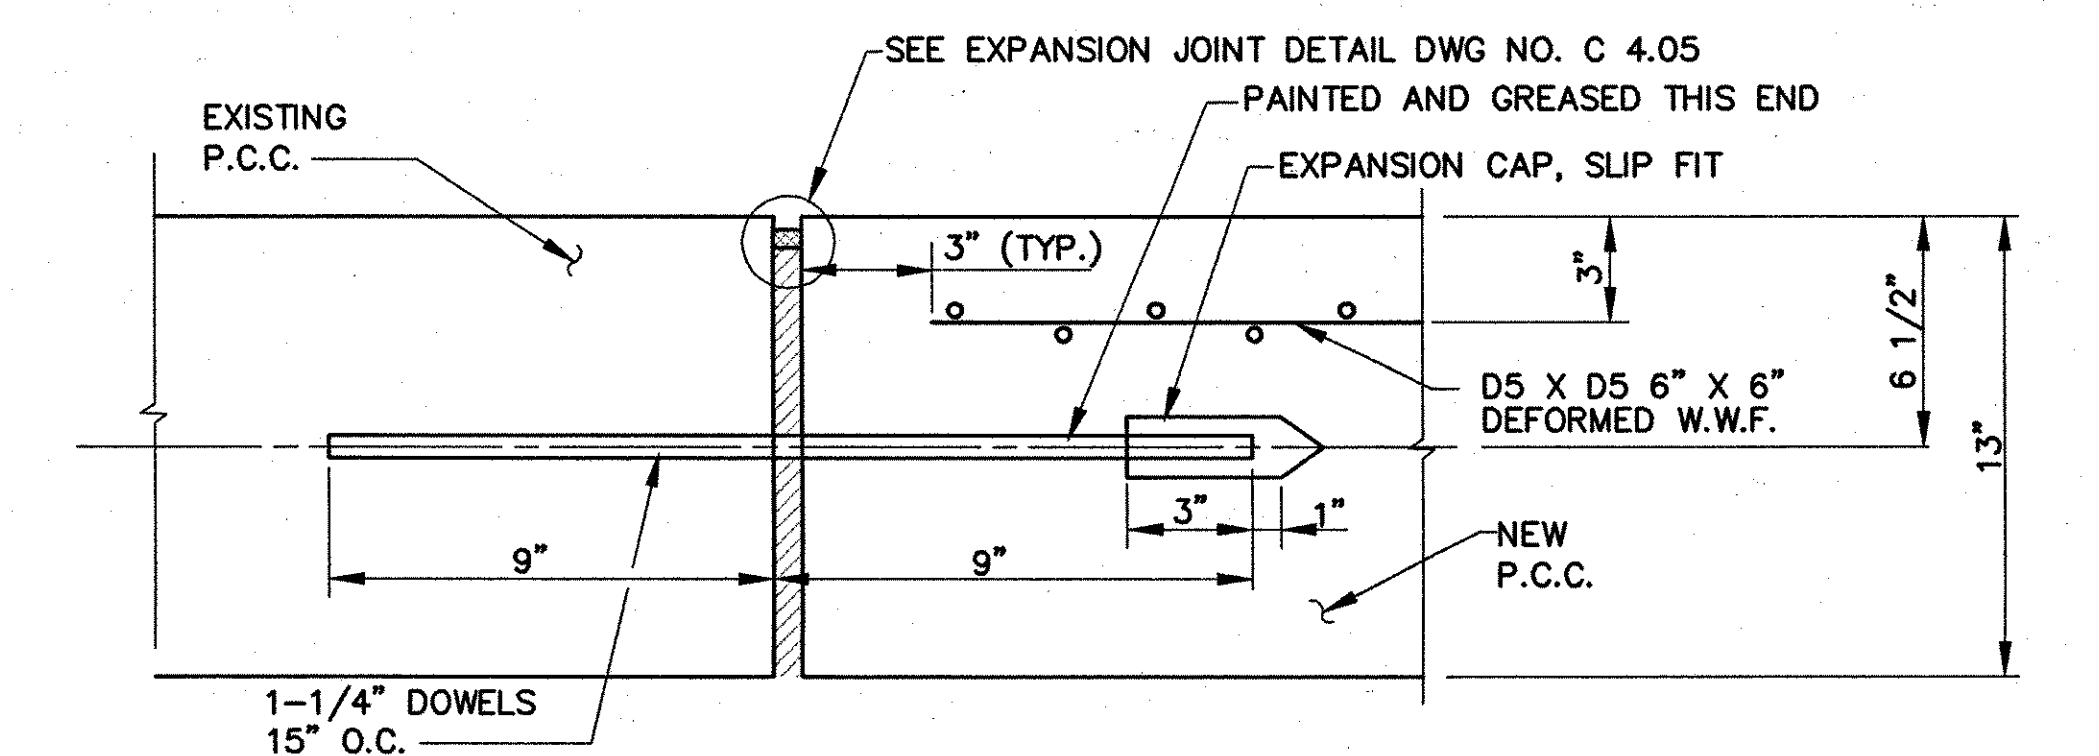


NOTE:
WHEN PROPOSED P.C.C. MET EXISTING P.C.C., CONTRACTOR CORED EXISTING P.C.C. AND EPOXY GROUTED DOWEL IN PLACE.

TYPE "D" - EXPANSION JOINT


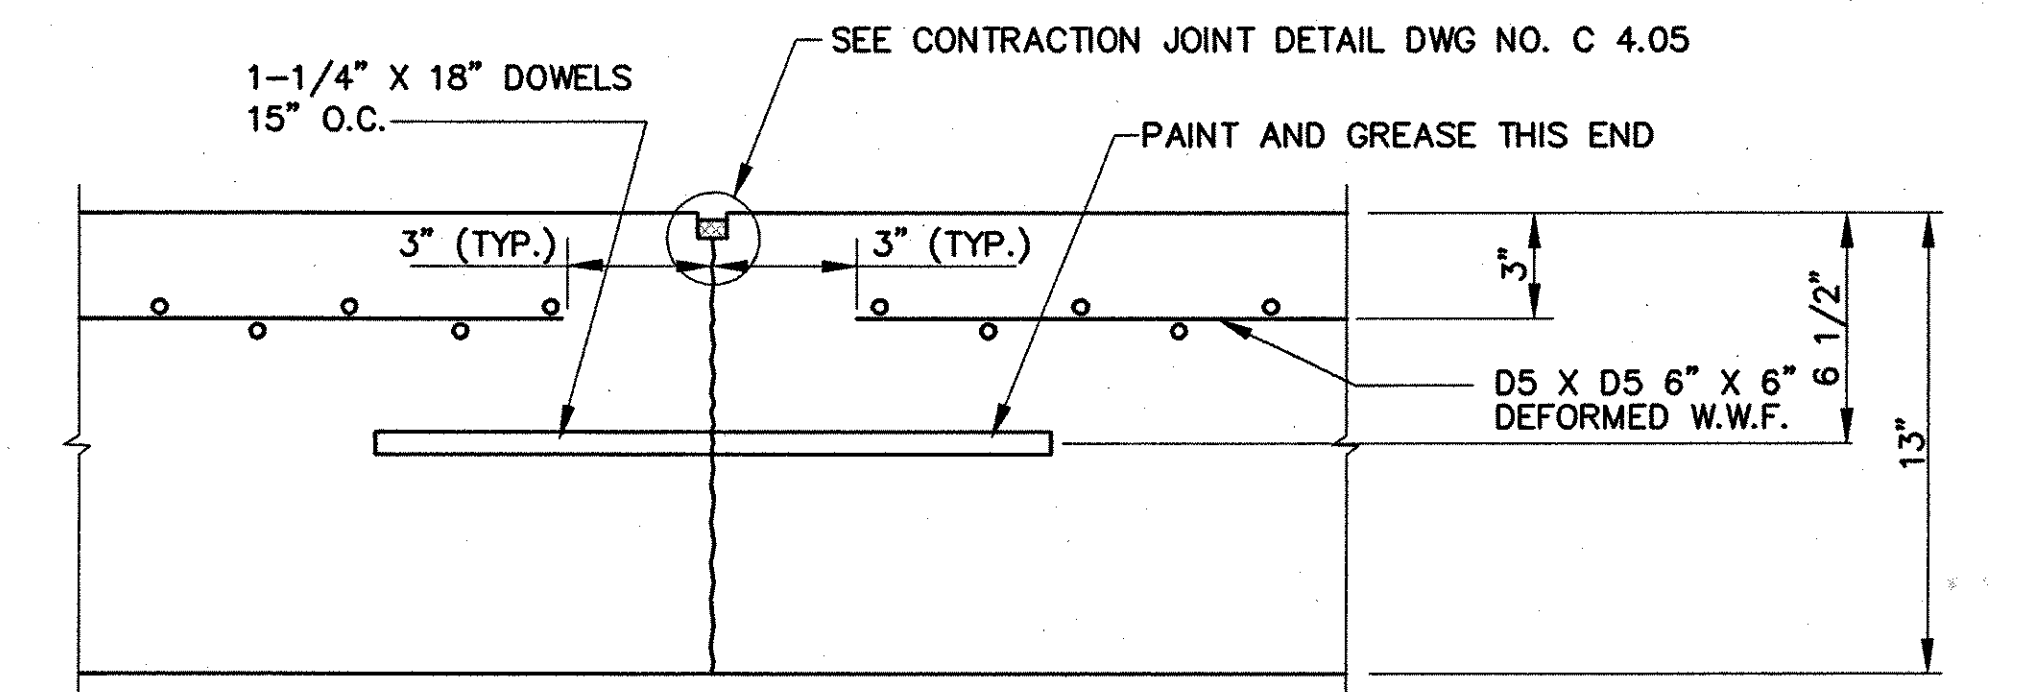


TYPE "E" - CONTRACTION JOINT

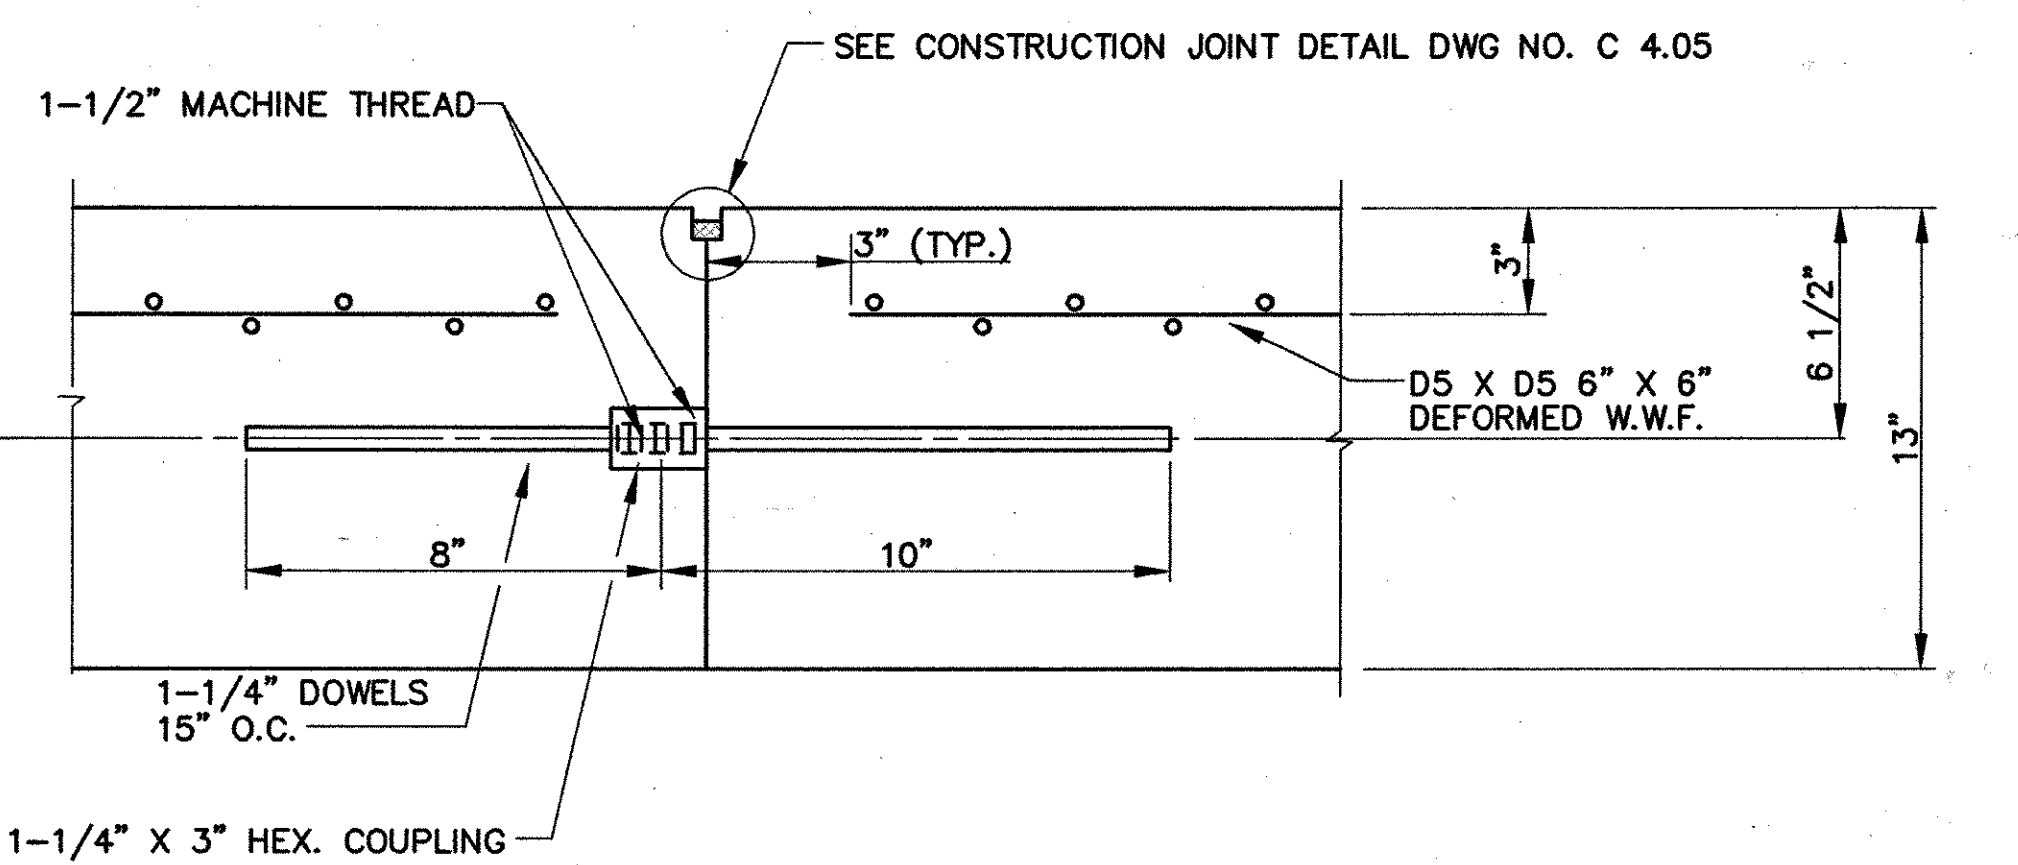

TYPE "F" - CONSTRUCTION JOINT

13" THICK APRON P.C.C. JOINT DETAILS
NOT TO SCALE

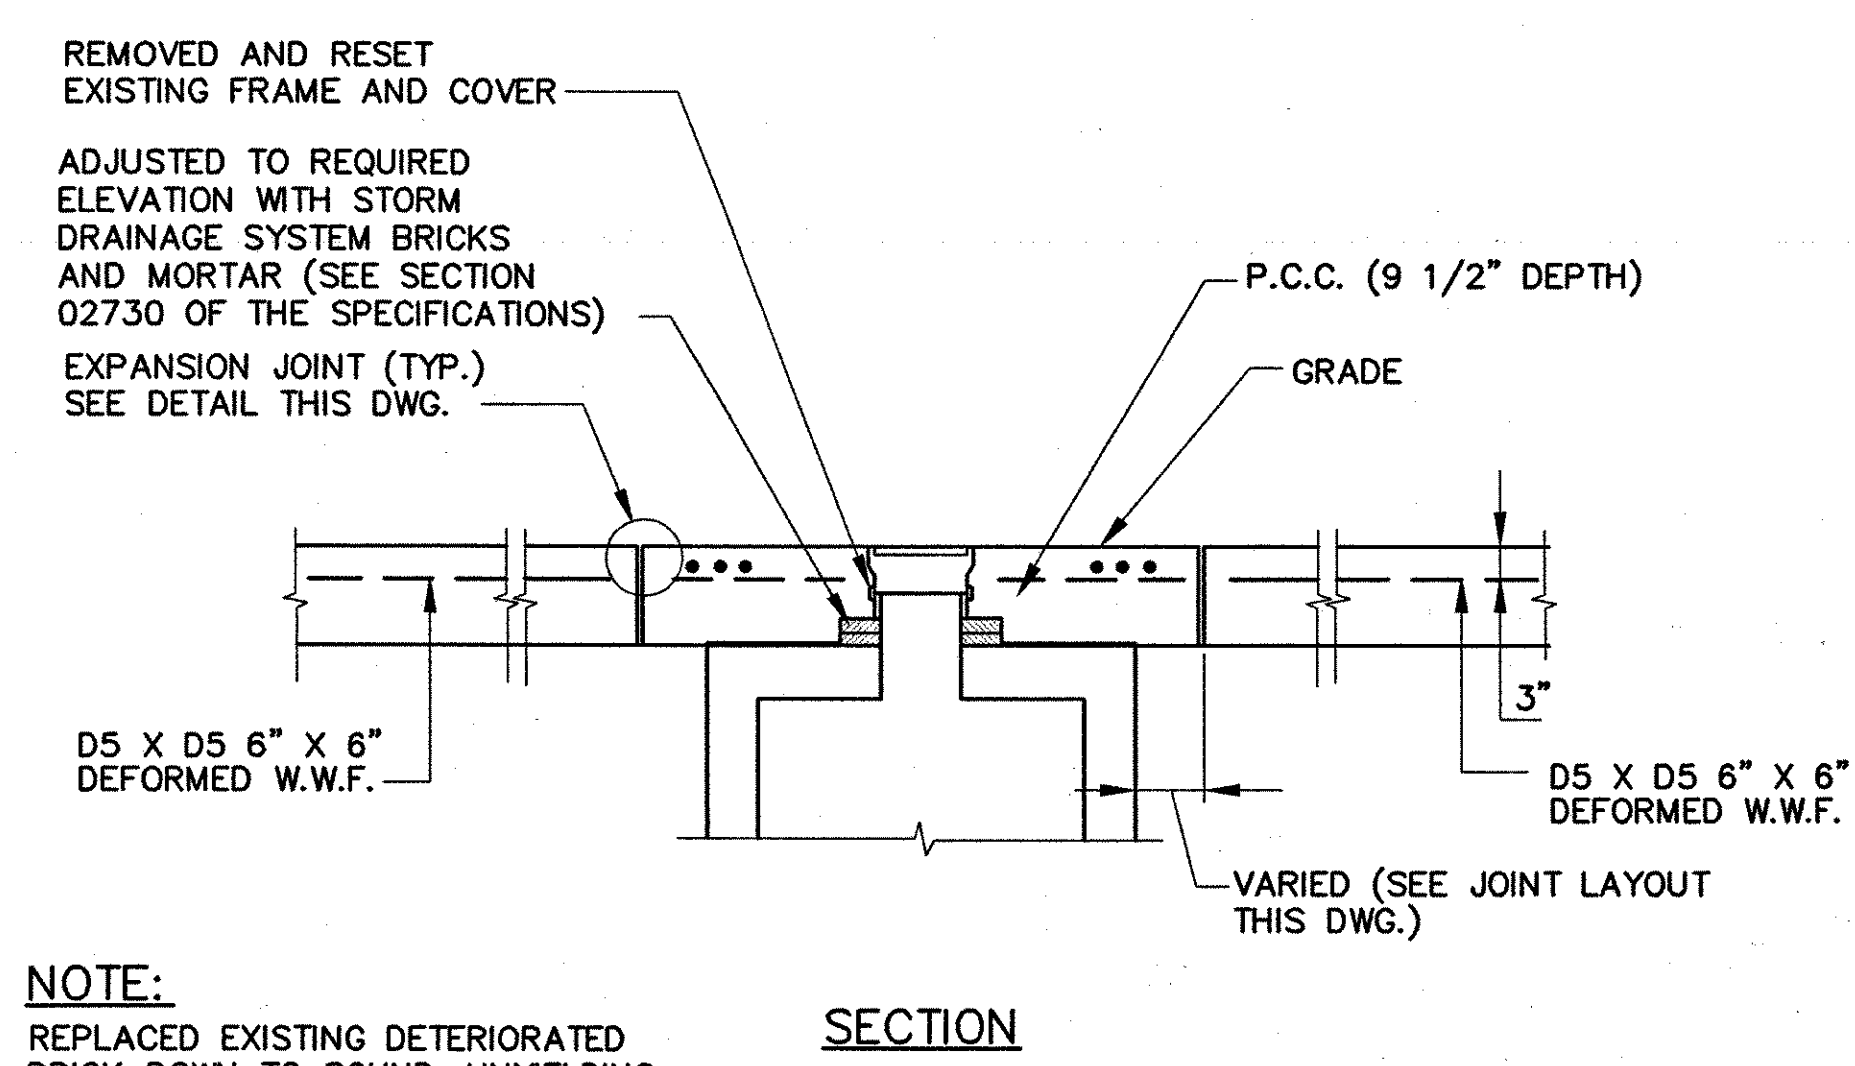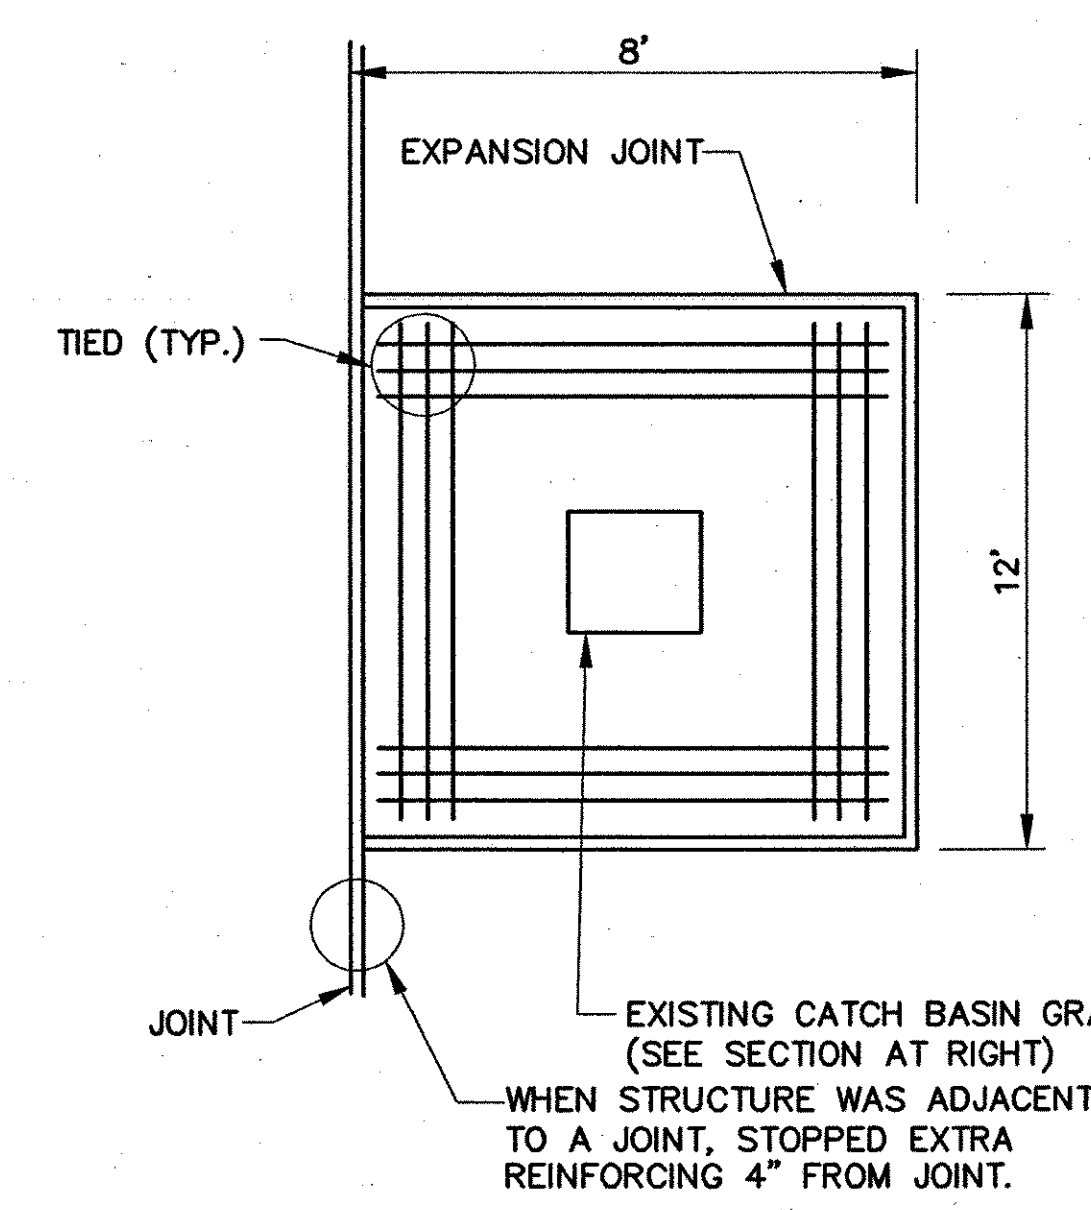

NOTE:
REPLACED EXISTING DETERIORATED BRICK DOWN TO SOUND, UNYIELDING MATERIAL AS NECESSARY

PLAN DETAILS FOR JOINT AND REINFORCEMENT LAYOUT AROUND EXISTING CATCH BASIN IN P.C.C. PAVEMENT
NOT TO SCALE


AS CONSTRUCTED PLANS I hereby certify that all construction required by this sheet has been accomplished as indicated hereon.

EDWARDS AND KELCEY, INC.


BY *Steph E. White* DATE 1/9/02

FOR REFERENCE ONLY


REV. NO.	DATE	DESCRIPTION	MADE BY	CHK. BY	APPD. BY
1	12/01	AS CONSTRUCTED	SNA	SEA	ESD
MASSACHUSETTS PORT AUTHORITY BOSTON, MASSACHUSETTS					
BOSTON LOGAN INTERNATIONAL AIRPORT EAST BOSTON, MASSACHUSETTS					
AIRCRAFT FUELING SYSTEMS SCHEDULE B - FUEL STORAGE FACILITY P.C.C. PAVEMENT JOINT LAYOUT AND DETAILS					
CONSULTANT AND SUBCONSULTANT:					
GREINER INC. TAMPA, FLORIDA EDWARDS AND KELCEY INC. BOSTON, MASSACHUSETTS					
DRAWN BY: TED		CHKD. BY: DMM		DWG. NO: C 4.06	
SCALE: AS SHOWN		APPROVED: -		DATE: 11/96	
MPA CONTRACT NO.: MPA 1.646C (R)				SHEET NO. 22 OF 200	

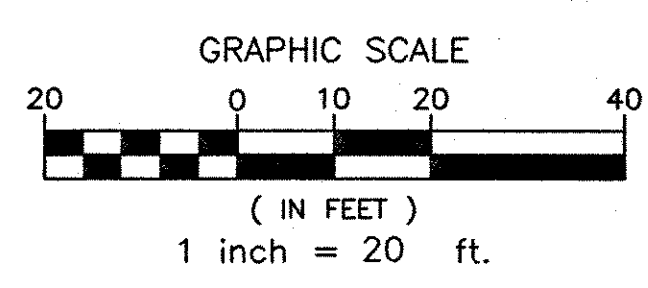


AS BUILT

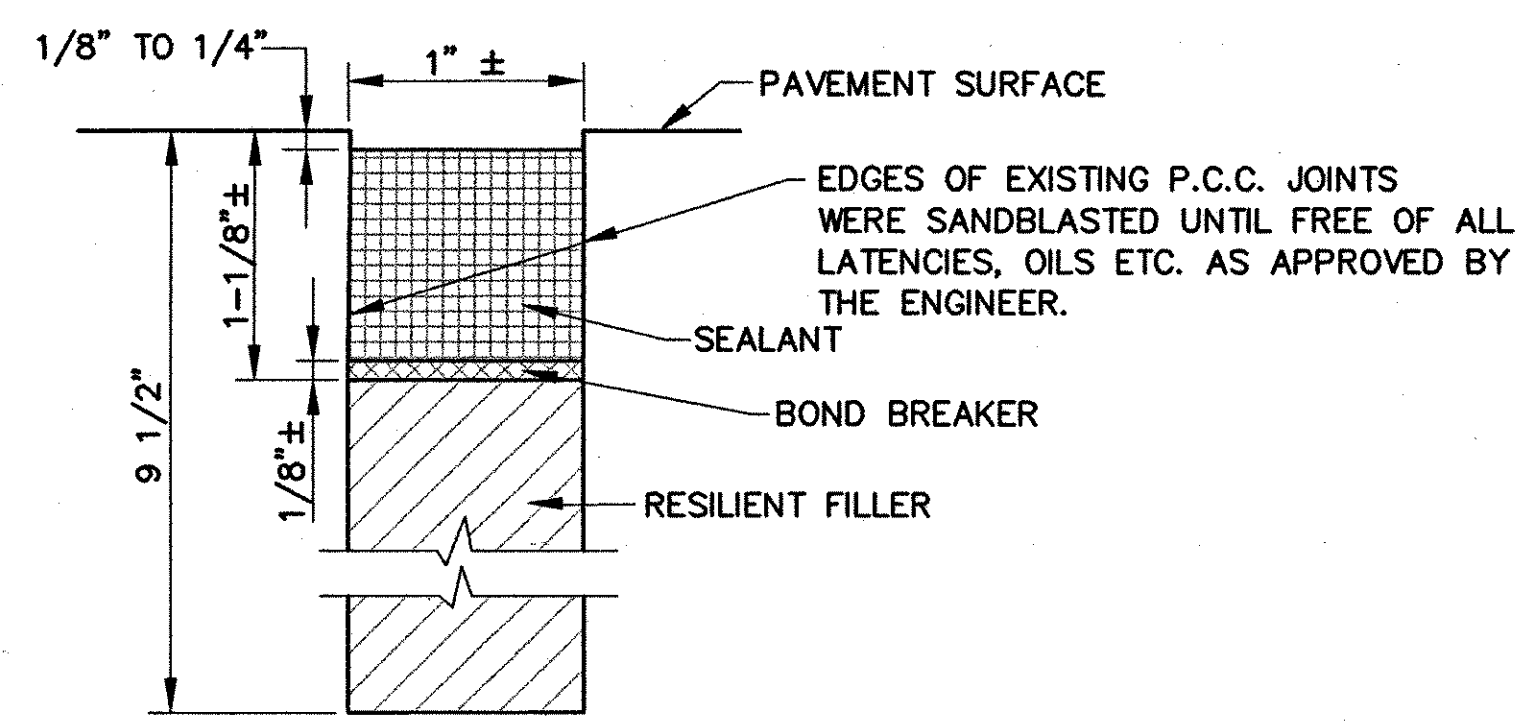


EXPANSION JOINT DETAIL
NOT TO SCALE

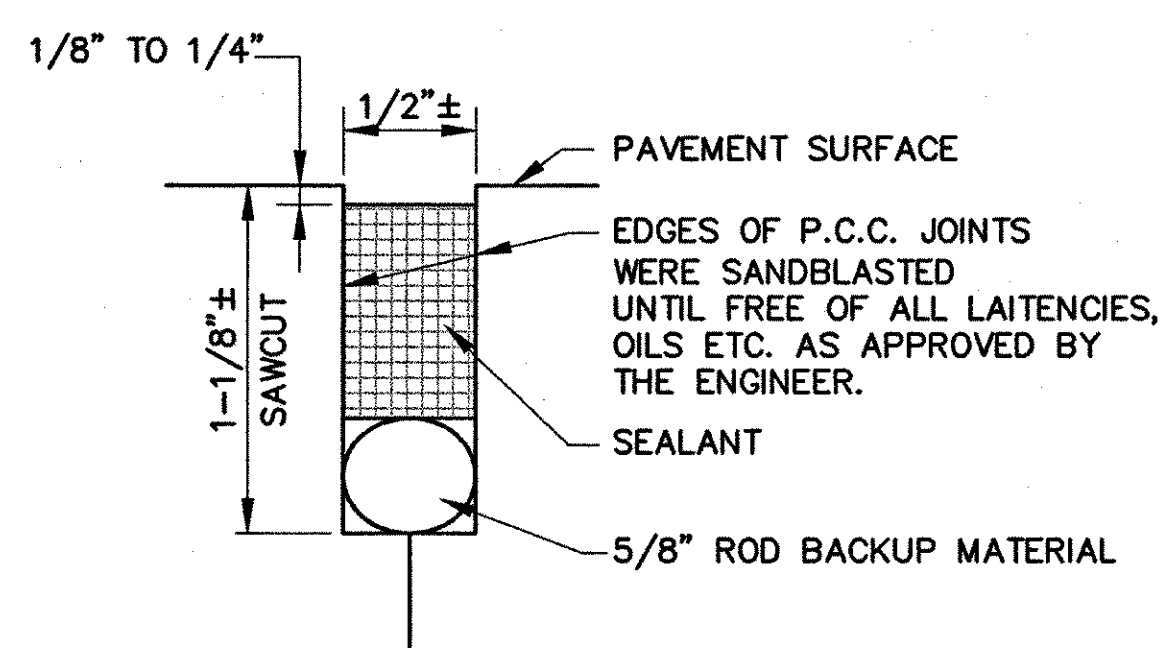


CONSTRUCTION JOINT DETAIL
NOT TO SCALE

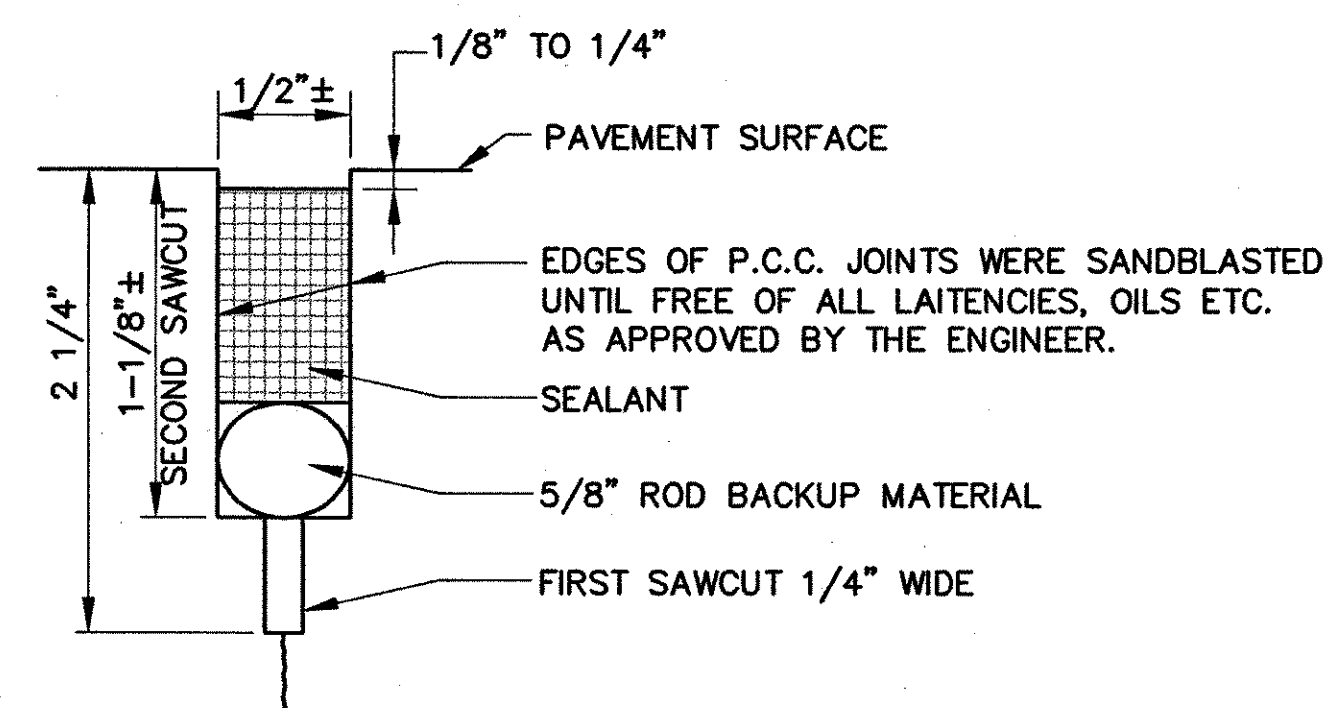


CONTRACTION JOINT DETAIL
NOT TO SCALE

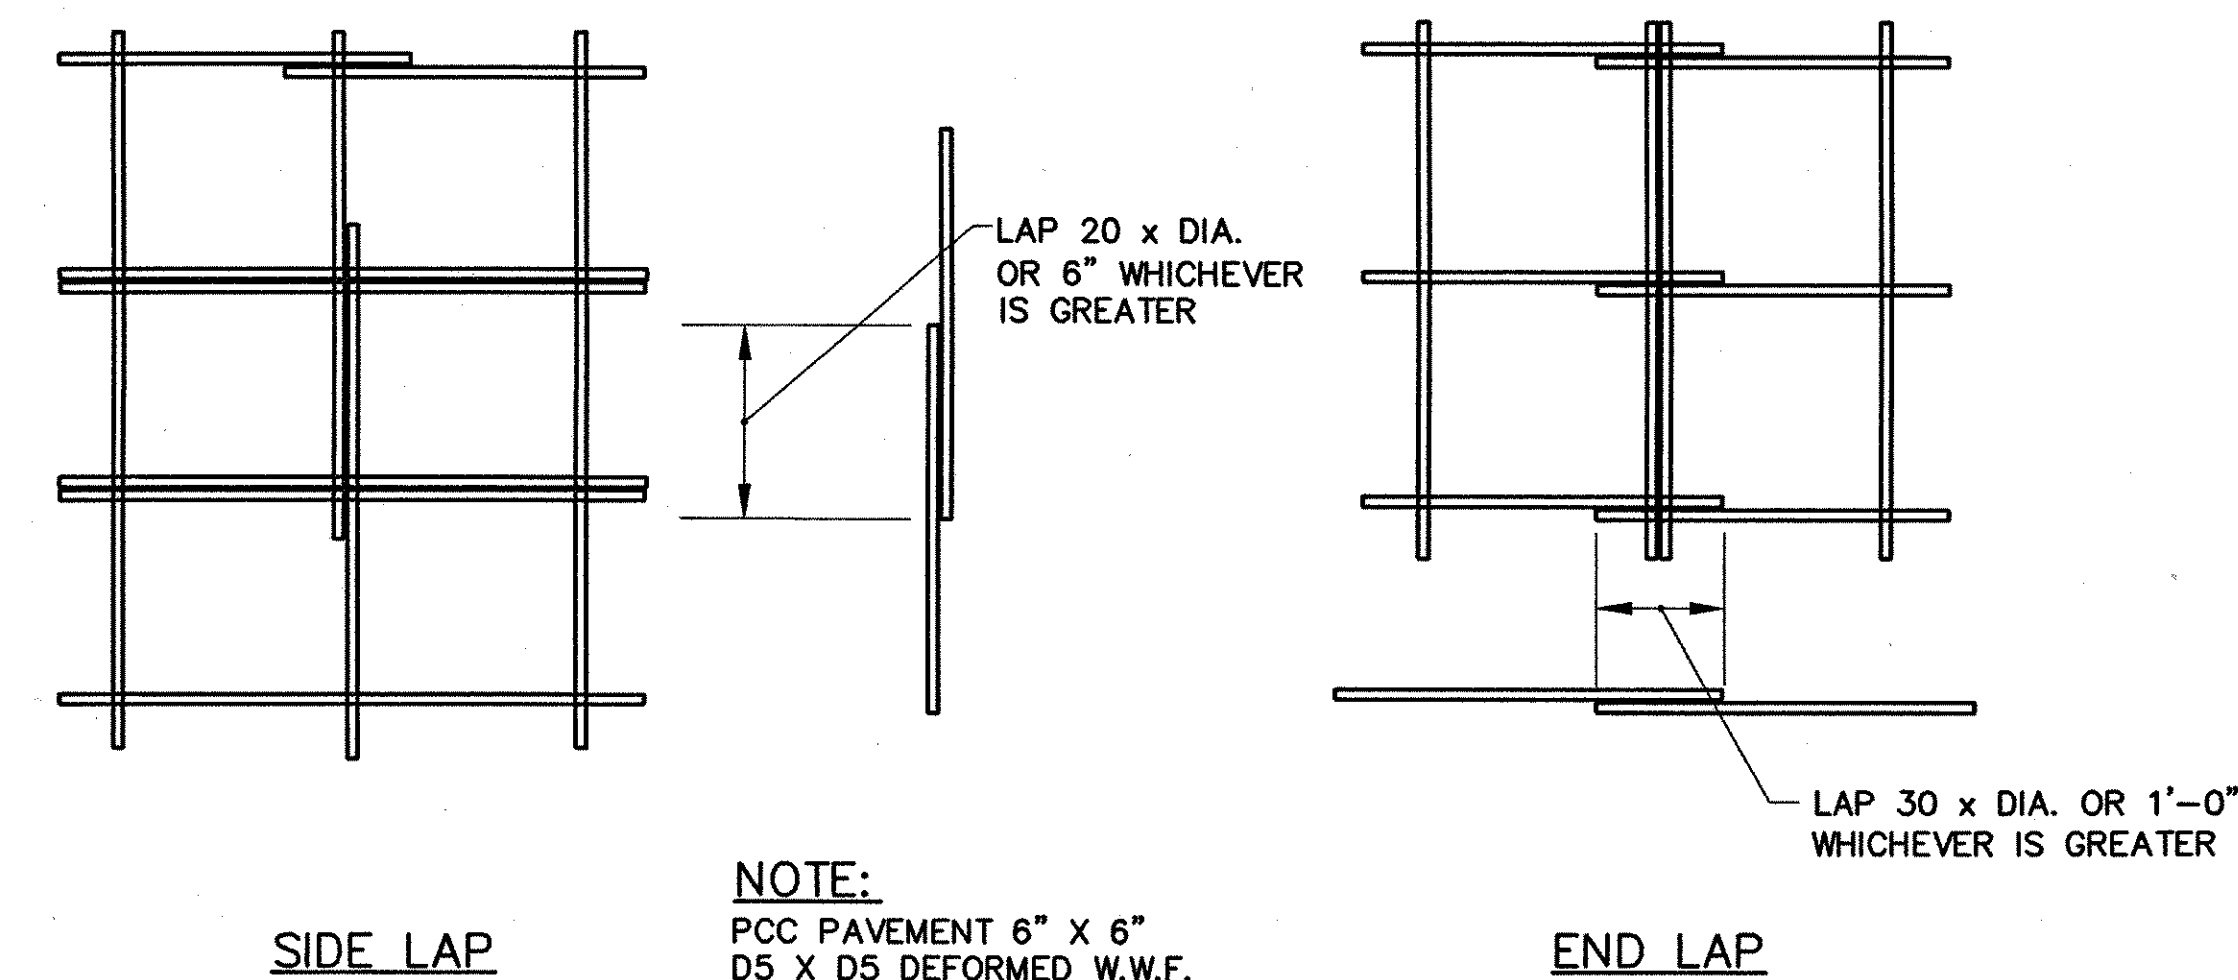


WELDED WIRE FABRIC LAYOUT
NOT TO SCALE

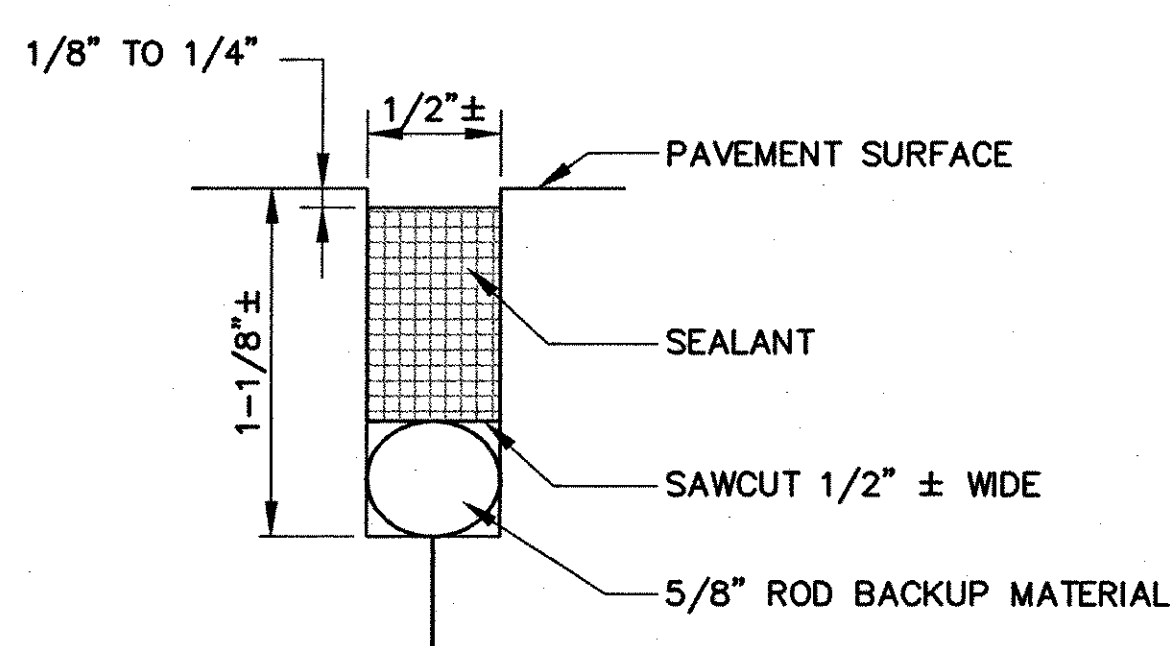

SIDEWALK CONSTRUCTION JOINT DETAIL
NOT TO SCALE

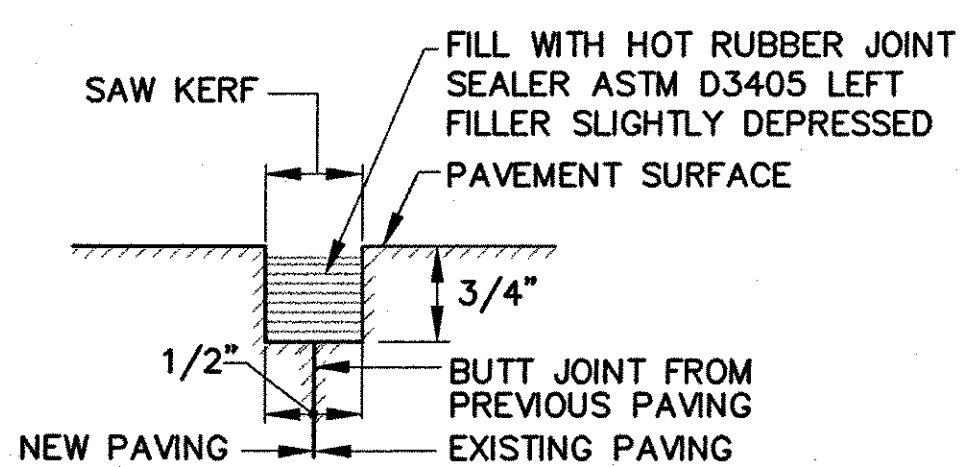


SAW AND SEAL DETAIL
NOT TO SCALE

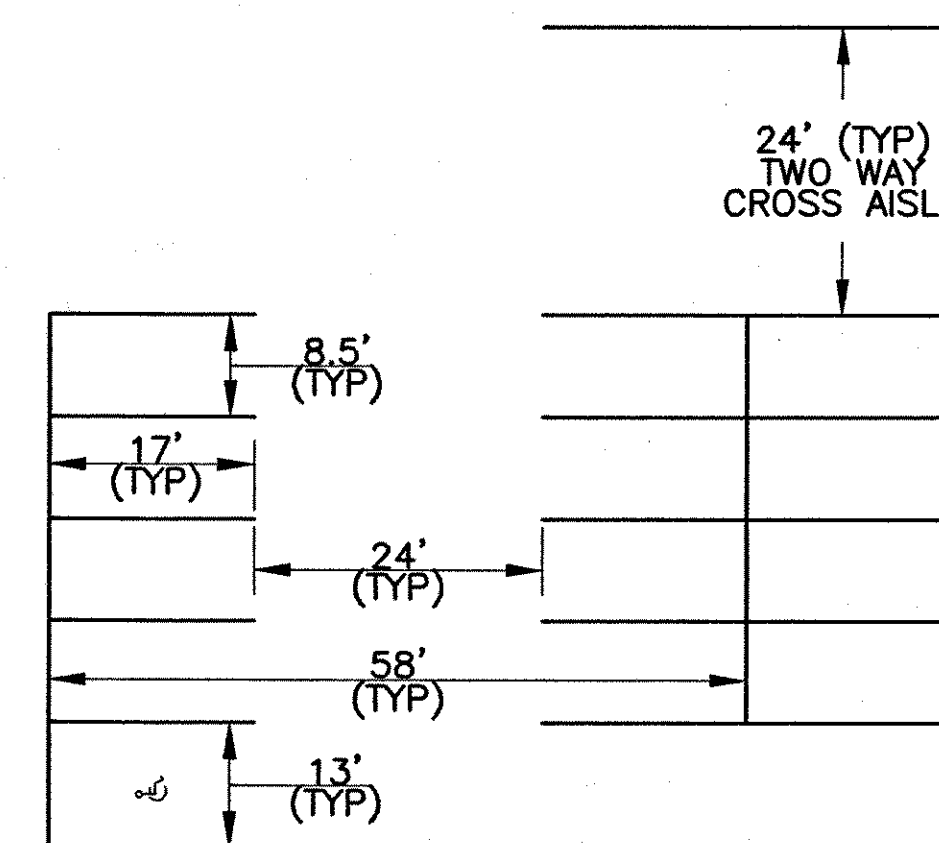


- NOTES:**
1. FOR ACTUAL LAYOUT IN SATELLITE PARKING SEE SHEET C 1.02 - PROPOSED SITE CONDITIONS.
 2. STALLS FOR INDIVIDUALS WITH DISABILITIES ARE 13' x 17'.
 3. IF A SECTION IS DESIGNATED FOR SUBCOMPACT VEHICLES, THESE STALLS CAN BE 8' x 15'.

TYPICAL PARKING LAYOUT DETAIL
NOT TO SCALE

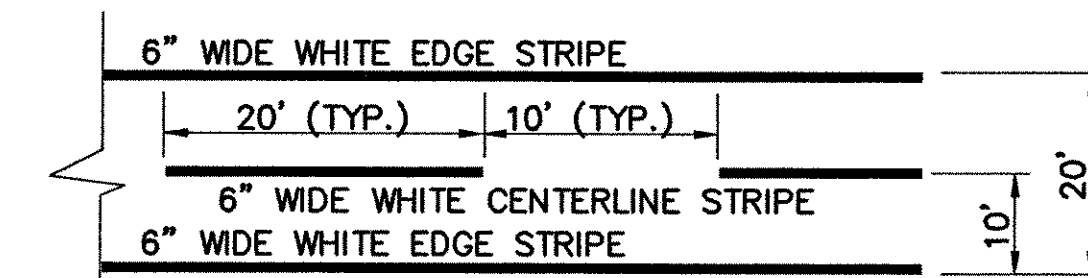


- NOTES**
1. FOR TEMPORARY VSR USE 6 INCH WIDE TEMPORARY PAVEMENT MARKING (WHITE).
 2. FOR PERMANENT VSR USE THERMOPLASTIC PAVEMENT MARKING (WHITE).


VEHICLE SERVICE ROAD (VSR) MARKING DETAIL
NOT TO SCALE

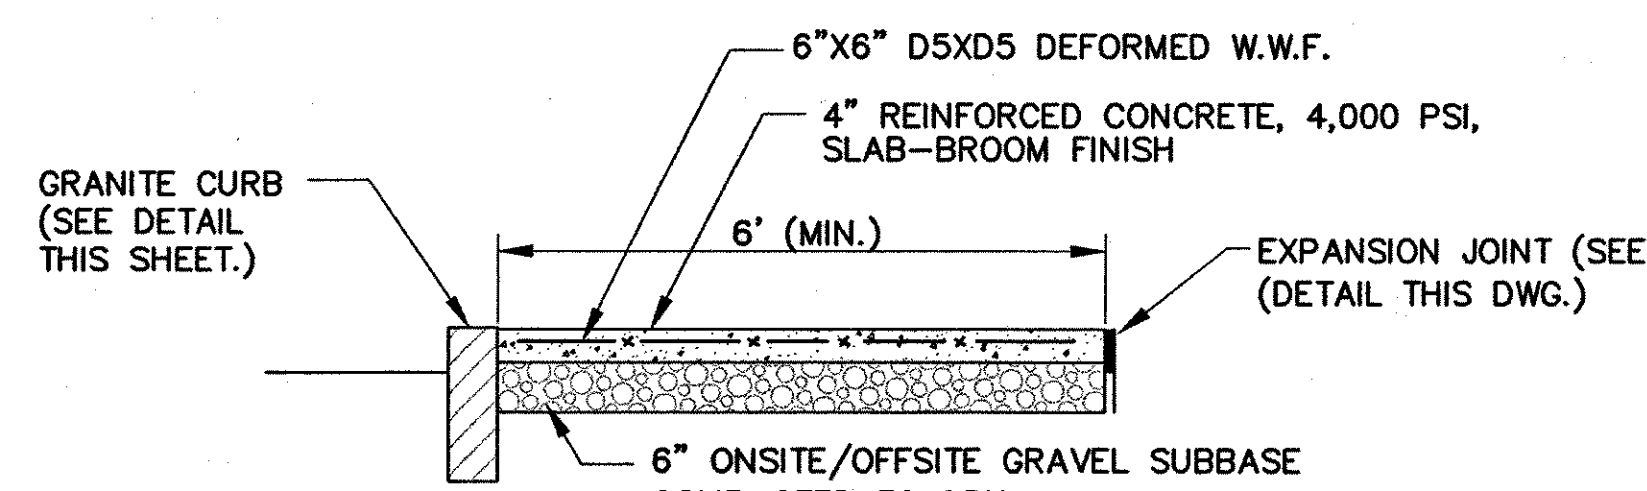

P.C.C. SIDEWALK DETAIL
NOT TO SCALE

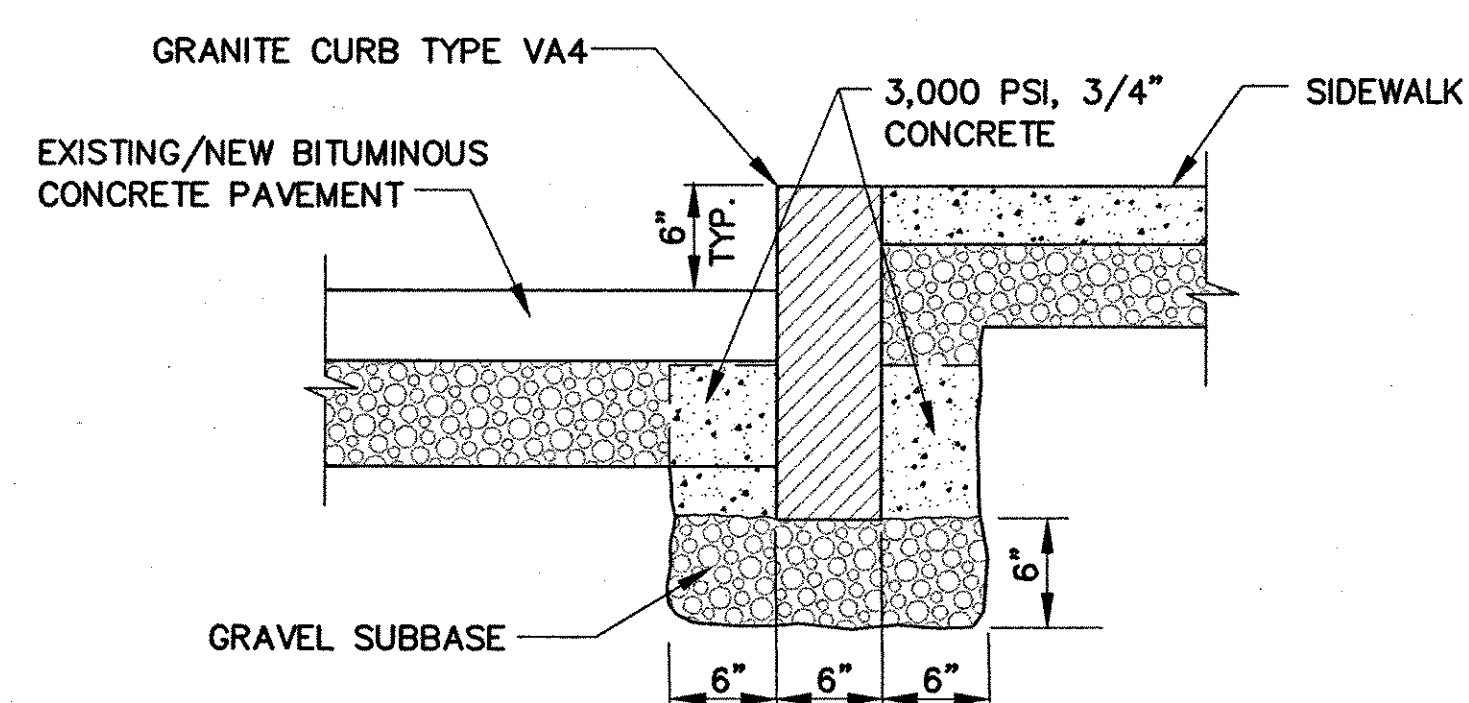


GRANITE CURB DETAIL
NOT TO SCALE

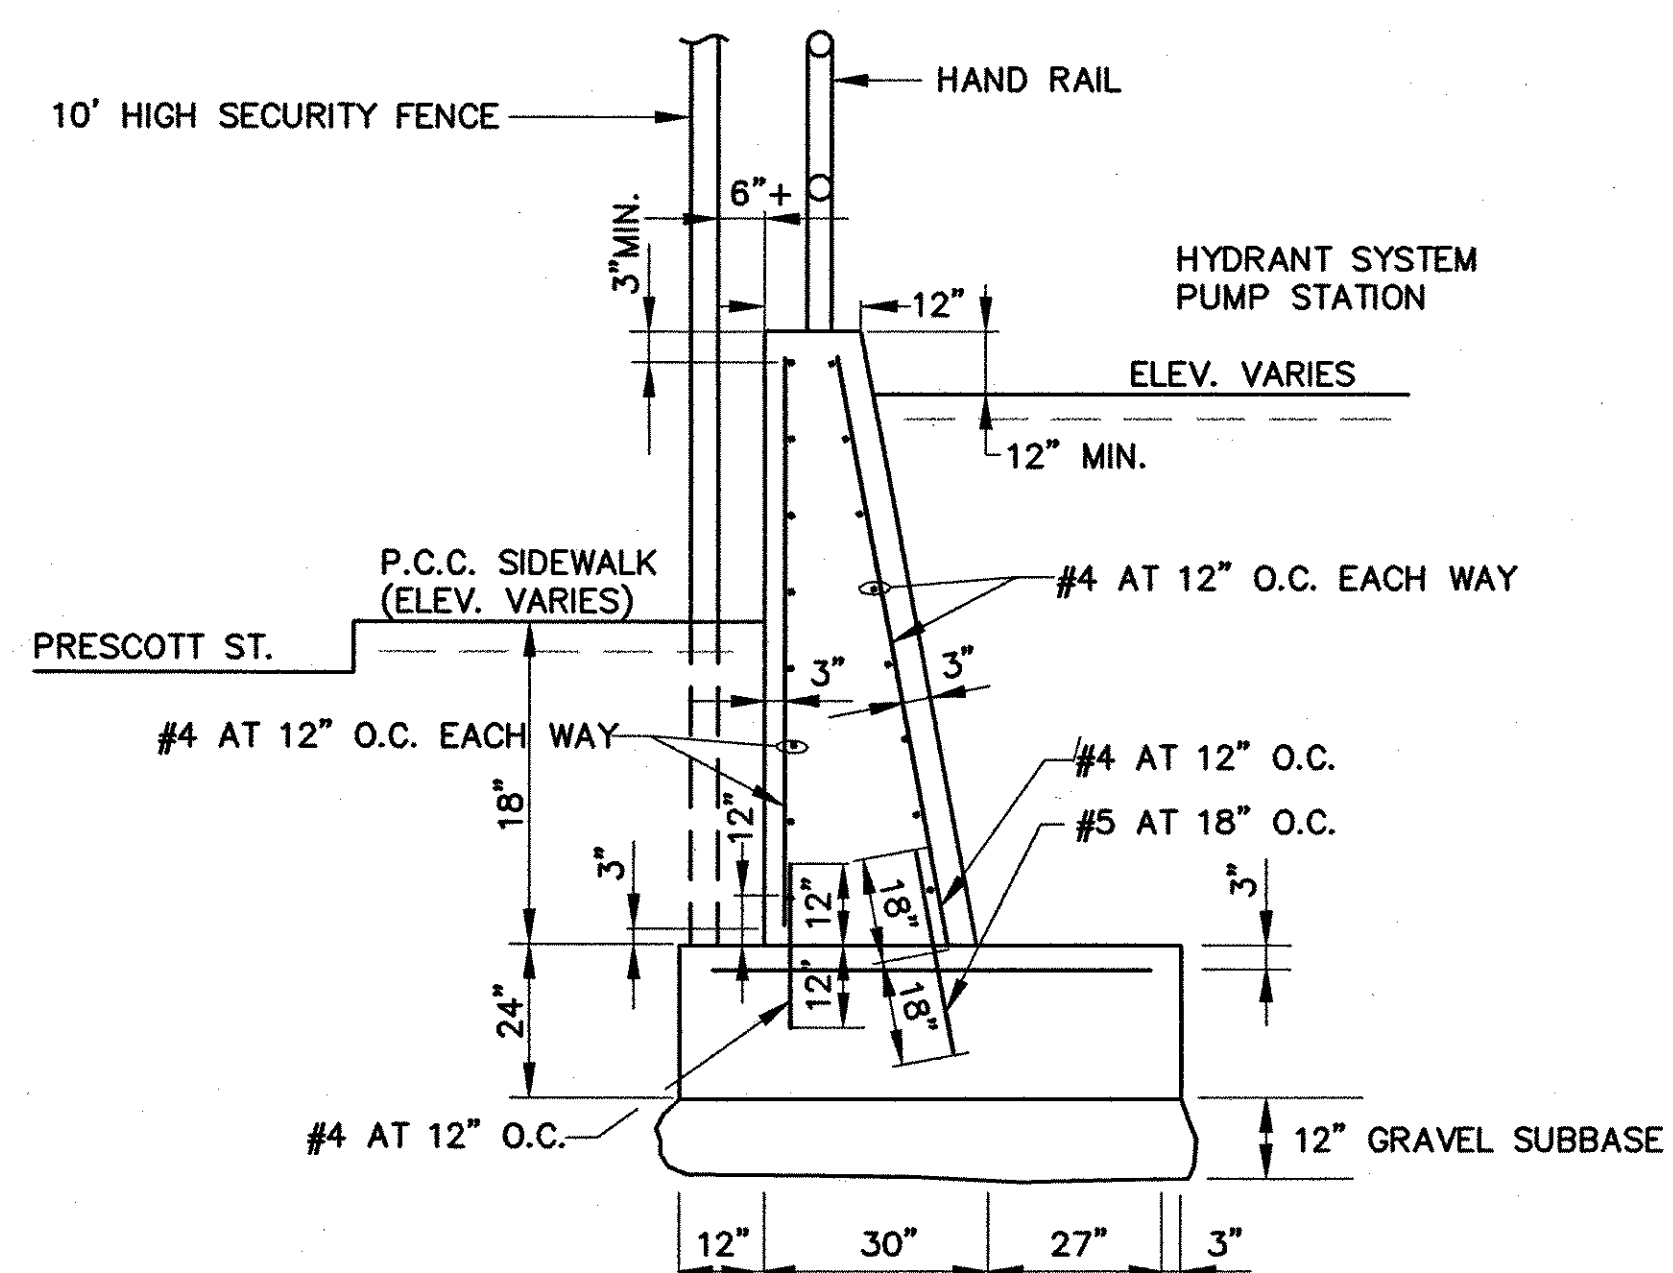


- NOTES**
1. CONCRETE REINFORCEMENT MET REQUIREMENTS OF SPEC SECTION 02550-STRUCTURAL PORTLAND CEMENT CONCRETE FOR 3500 PSI STRENGTH.
 2. FENCE WAS SITED AT BACK OF SIDEWALK.

RETAINING WALL SECTION
NOT TO SCALE

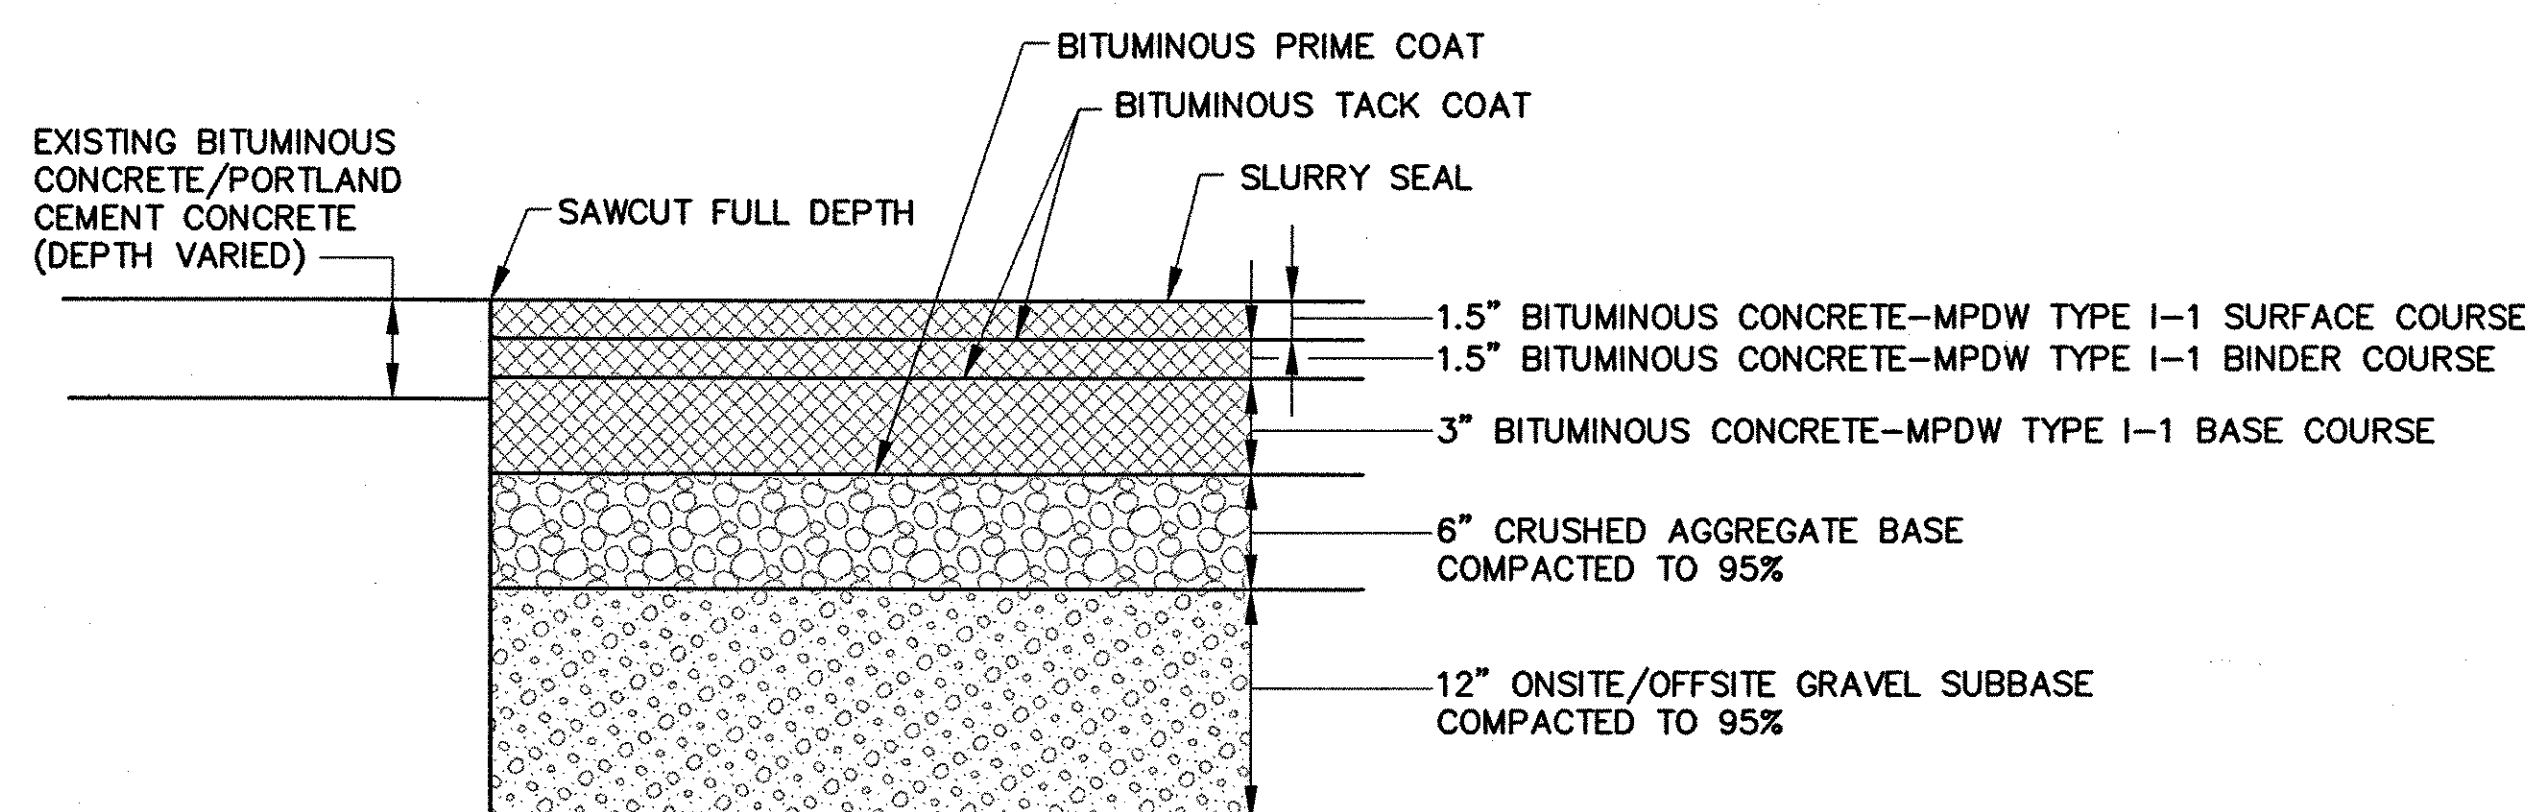

6" THICK BITUMINOUS CONCRETE TYPICAL SECTION
NOT TO SCALE

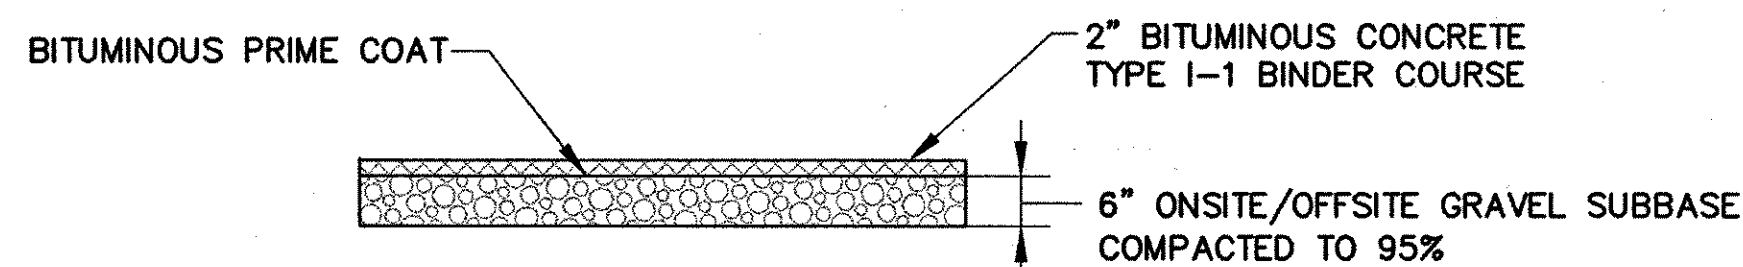

BITUMINOUS CONCRETE COVERING DETAIL
NOT TO SCALE




AS CONSTRUCTED PLANS
I hereby certify that all construction required by this sheet has been accomplished as indicated hereon.
EDWARDS AND KELCEY, INC.

BY Stacy E. Quill DATE 1/9/02

FOR REFERENCE ONLY

REV. NO.	DATE	DESCRIPTION	MADE BY	CHK. BY	APPD. BY
1	12/01	AS CONSTRUCTED	SNA	SEA	ESD
MASSACHUSETTS PORT AUTHORITY BOSTON, MASSACHUSETTS					
BOSTON LOGAN INTERNATIONAL AIRPORT EAST BOSTON, MASSACHUSETTS					
AIRCRAFT FUELING SYSTEMS SCHEDULE B - FUEL STORAGE FACILITY PAVEMENT DETAILS					
CONSULTANT AND SUBCONSULTANT: GREINER INC. TAMPA, FLORIDA EDWARDS AND KELCEY INC. BOSTON, MASSACHUSETTS					
DRAWN BY: TED		CHKD. BY: DMM		DWG. NO: C 4.05	
SCALE: NONE		APPROVED:		DATE: 11/96	
MPA CONTRACT NO.: MPA 1.646C (R)				SHEET NO. 21 OF 200	

AS BUILT

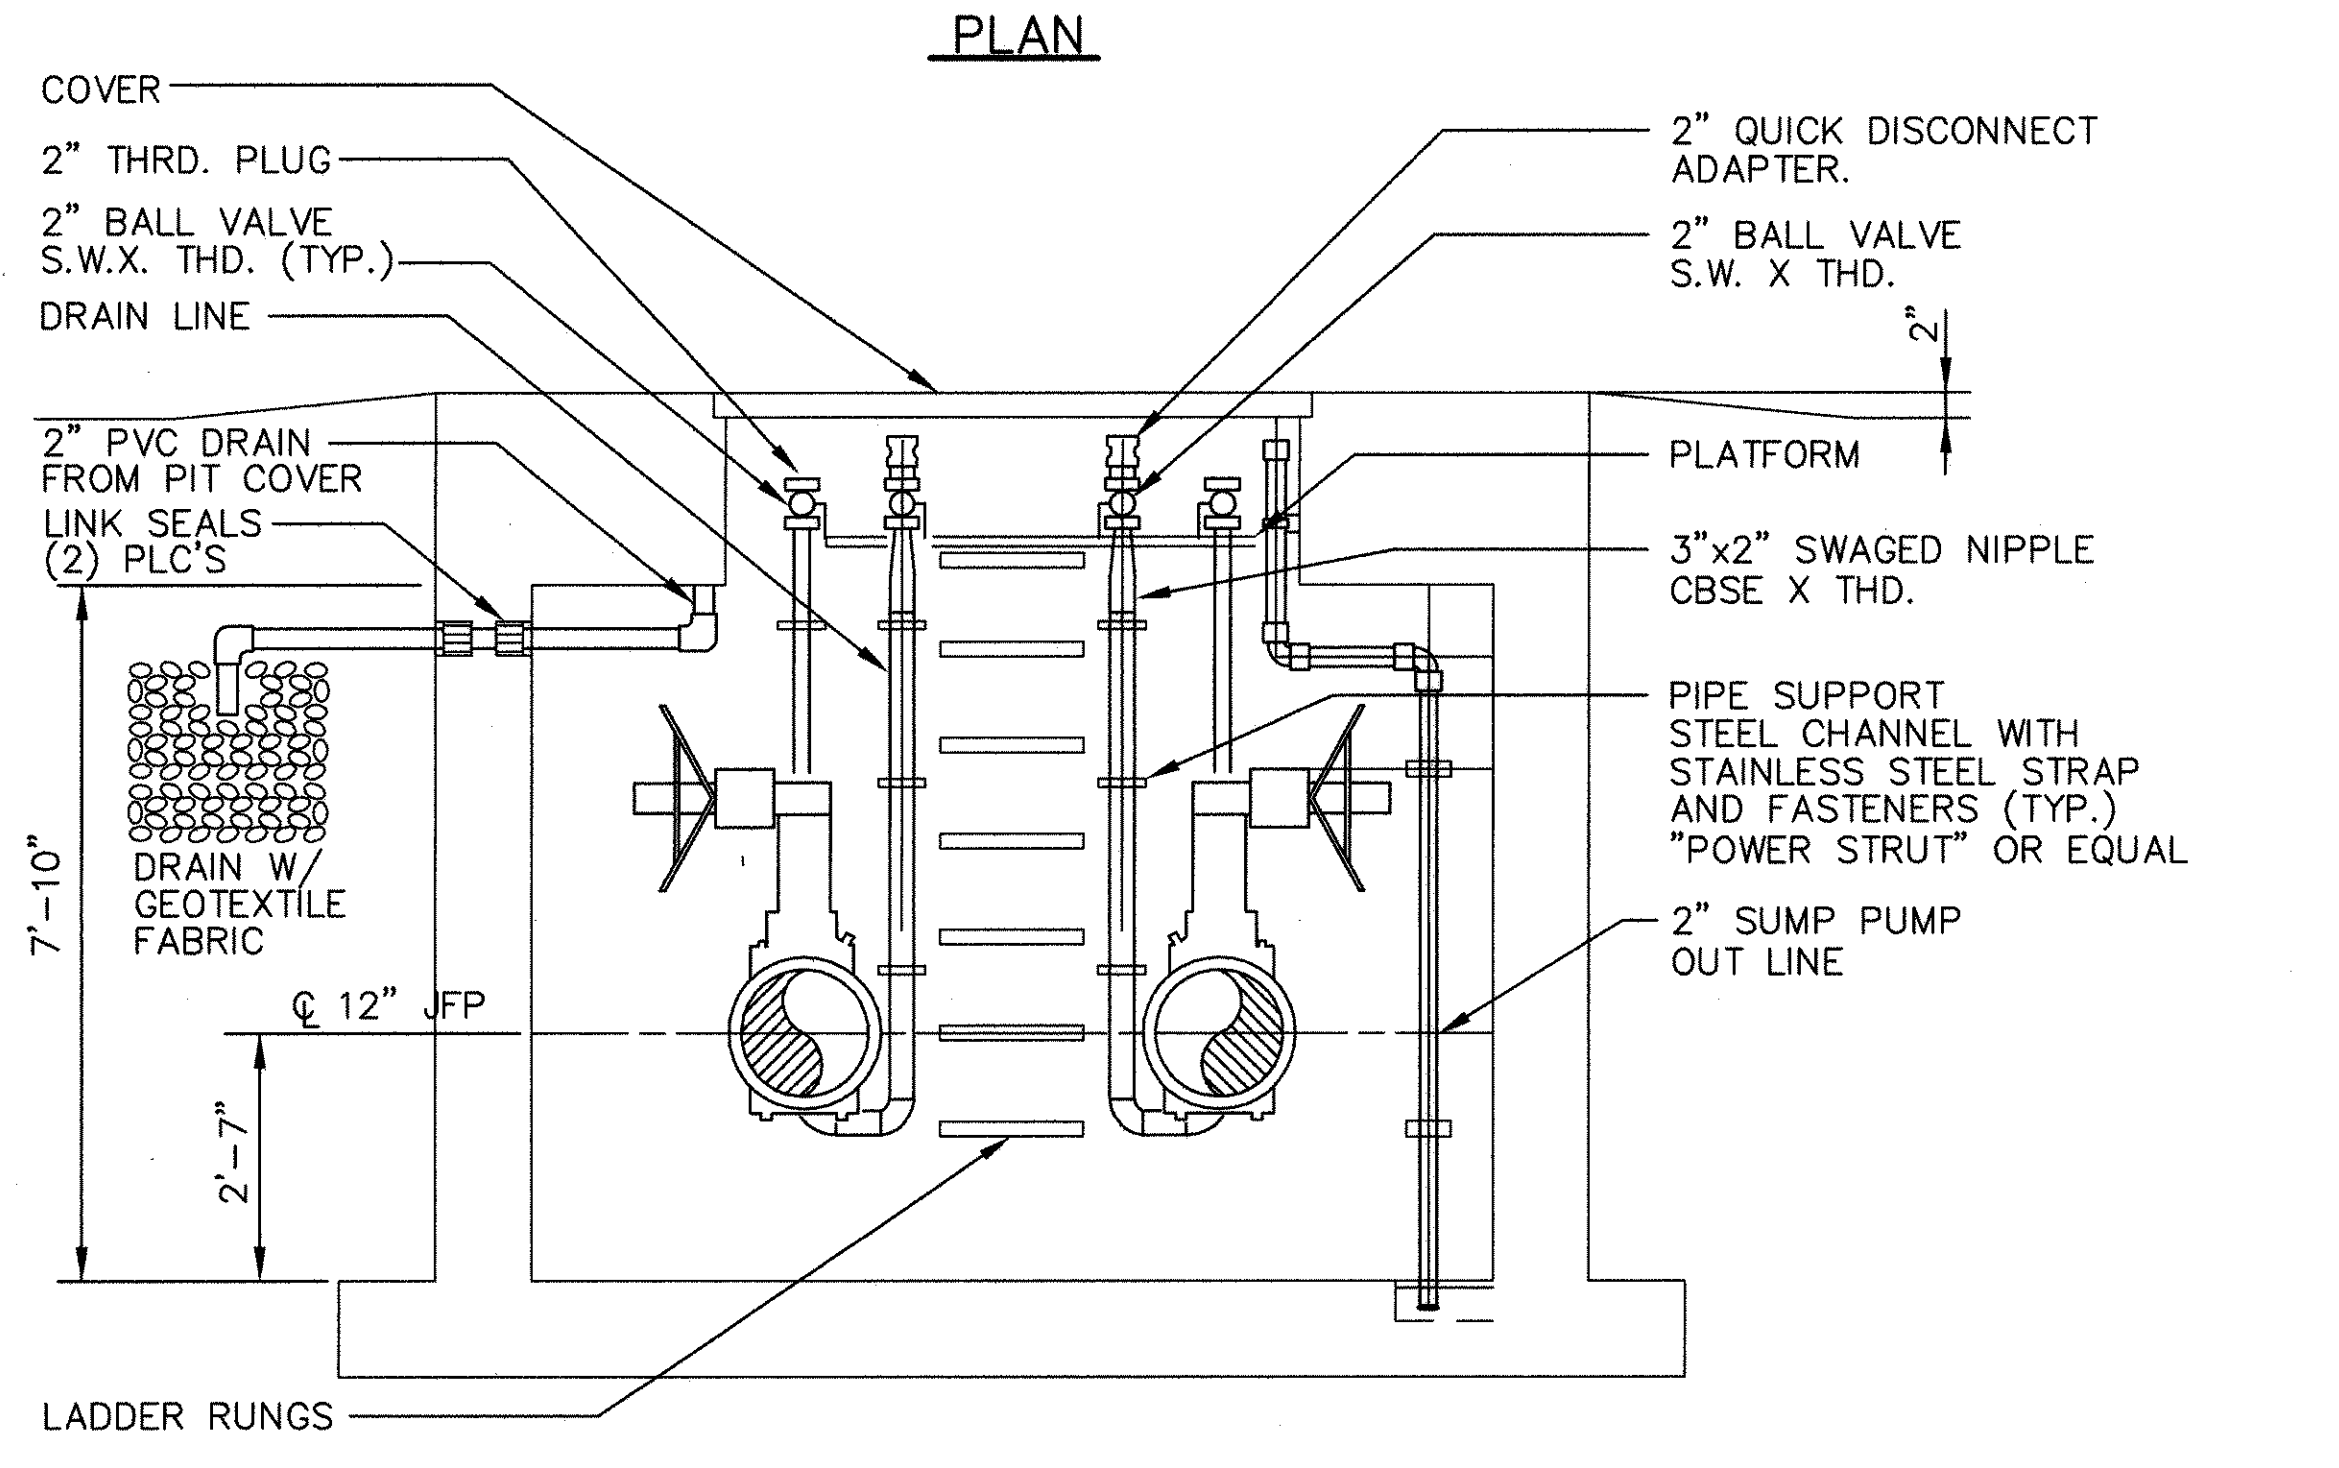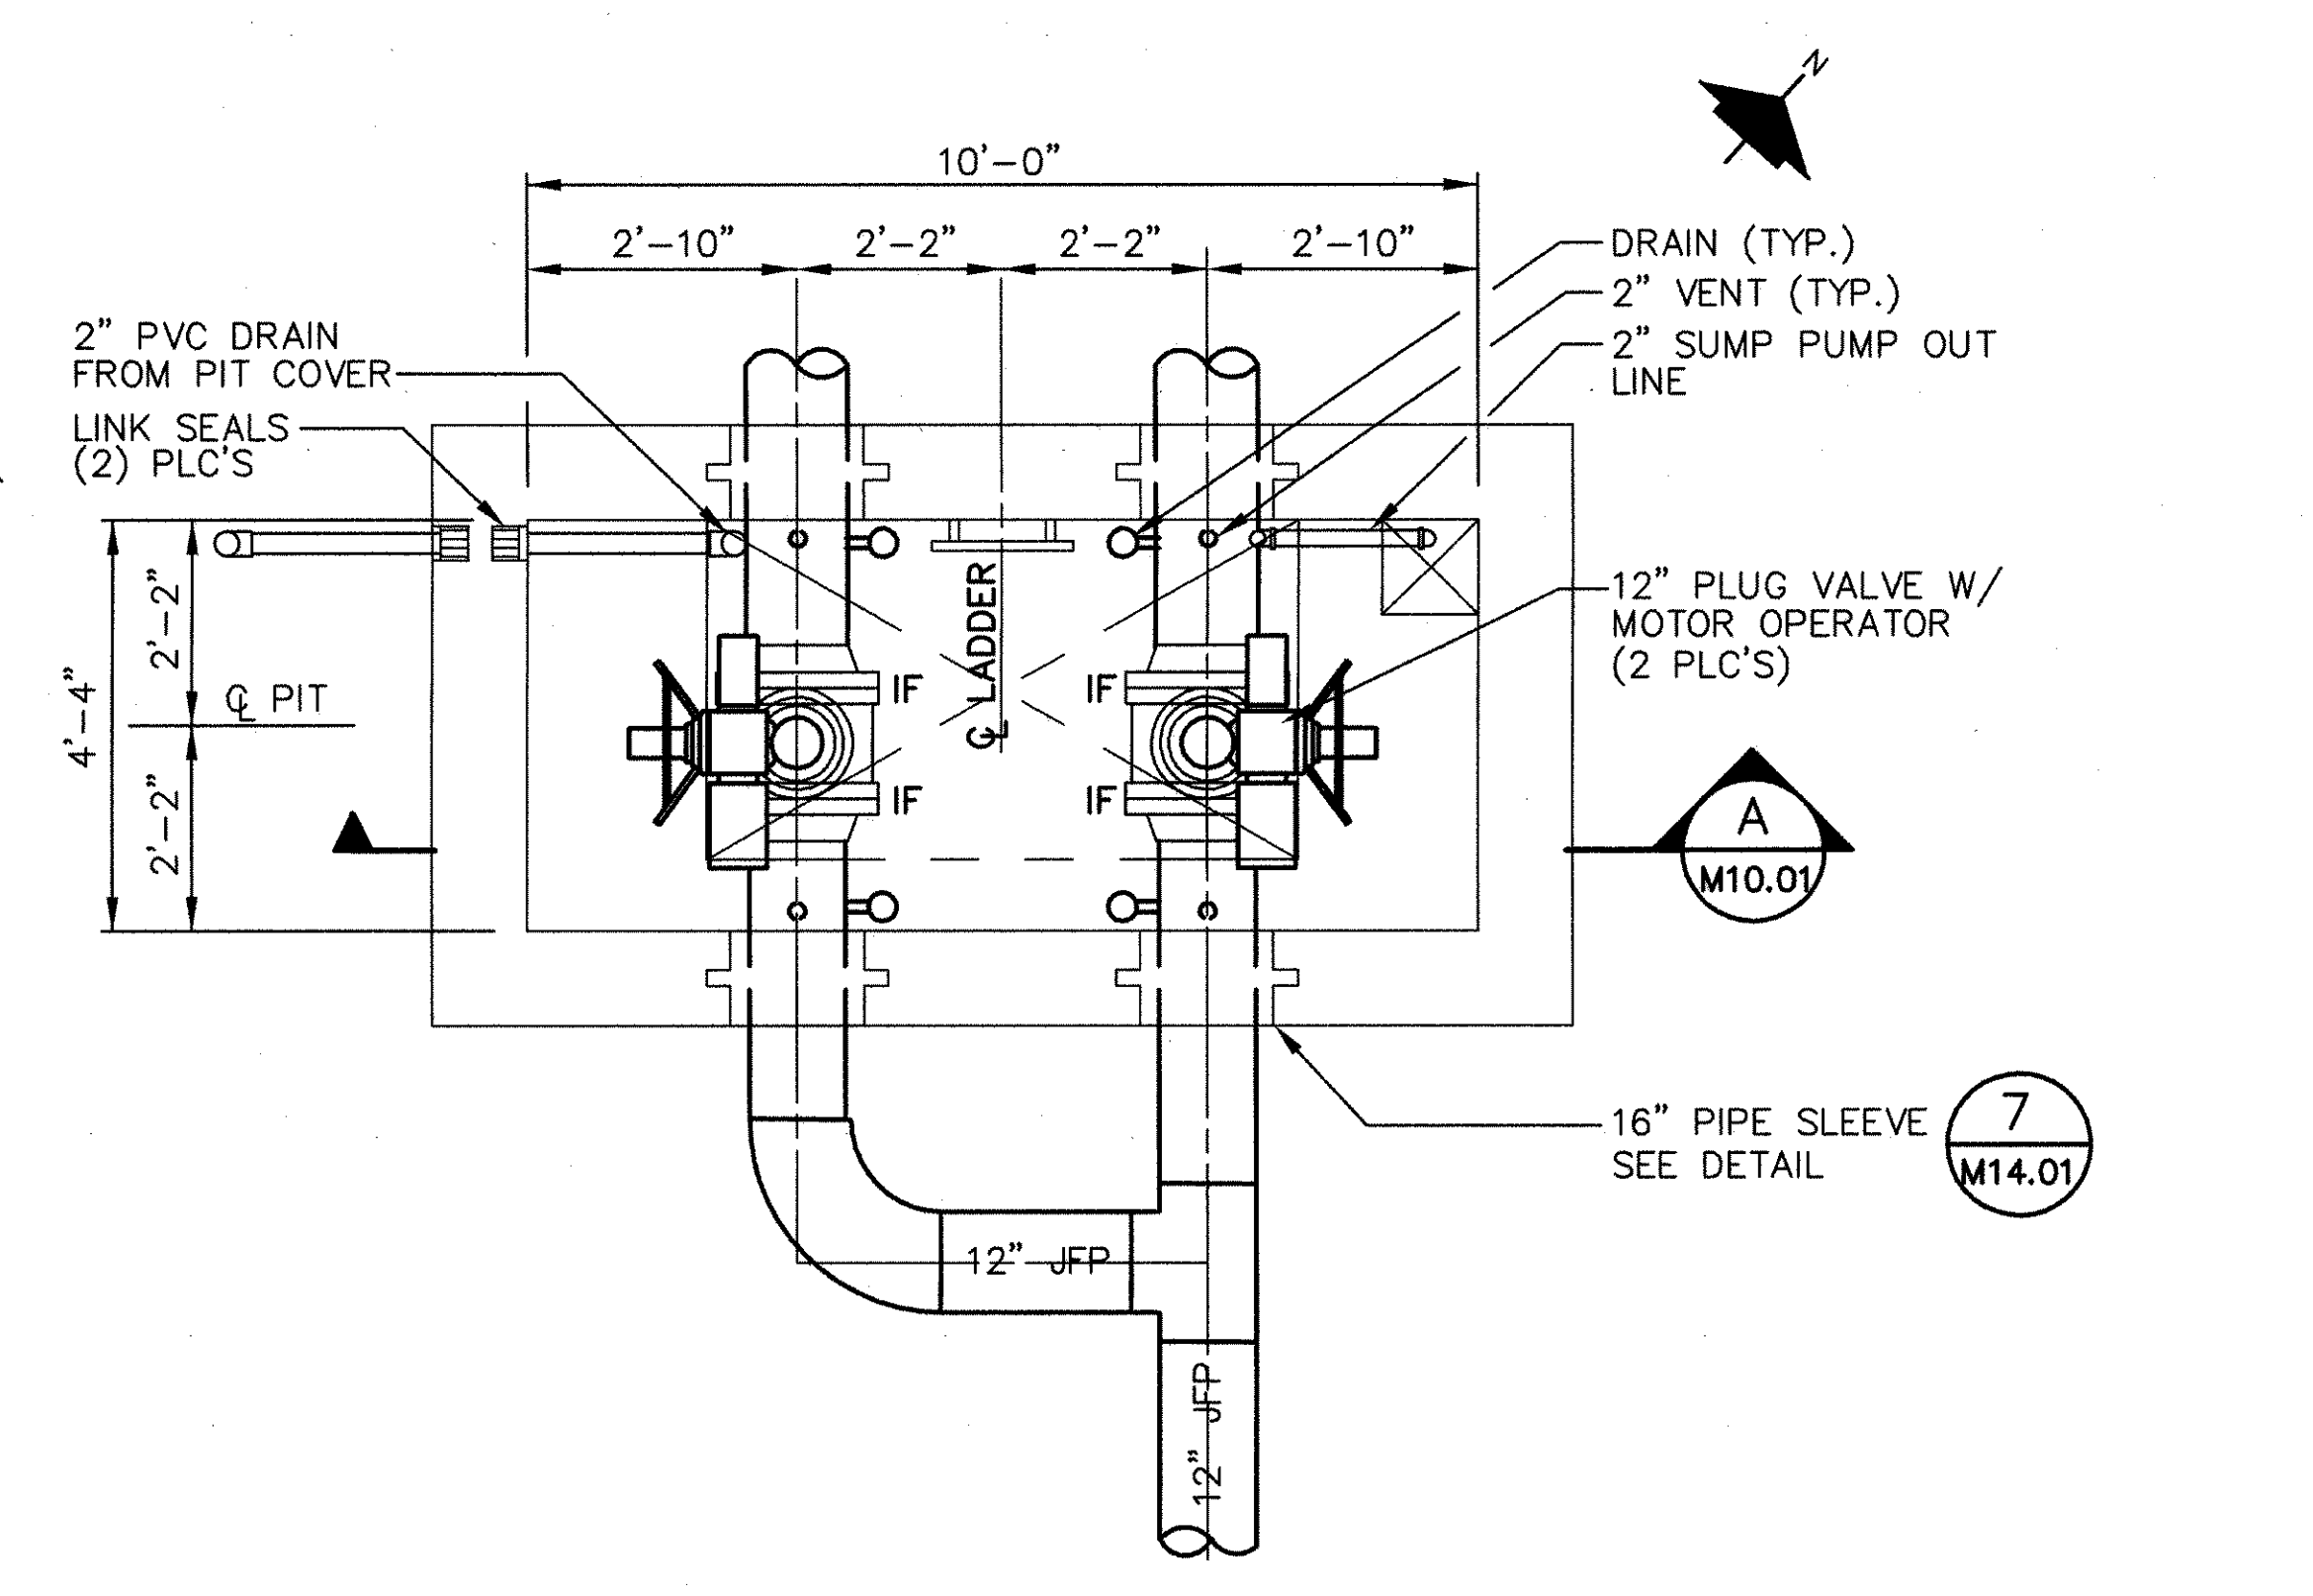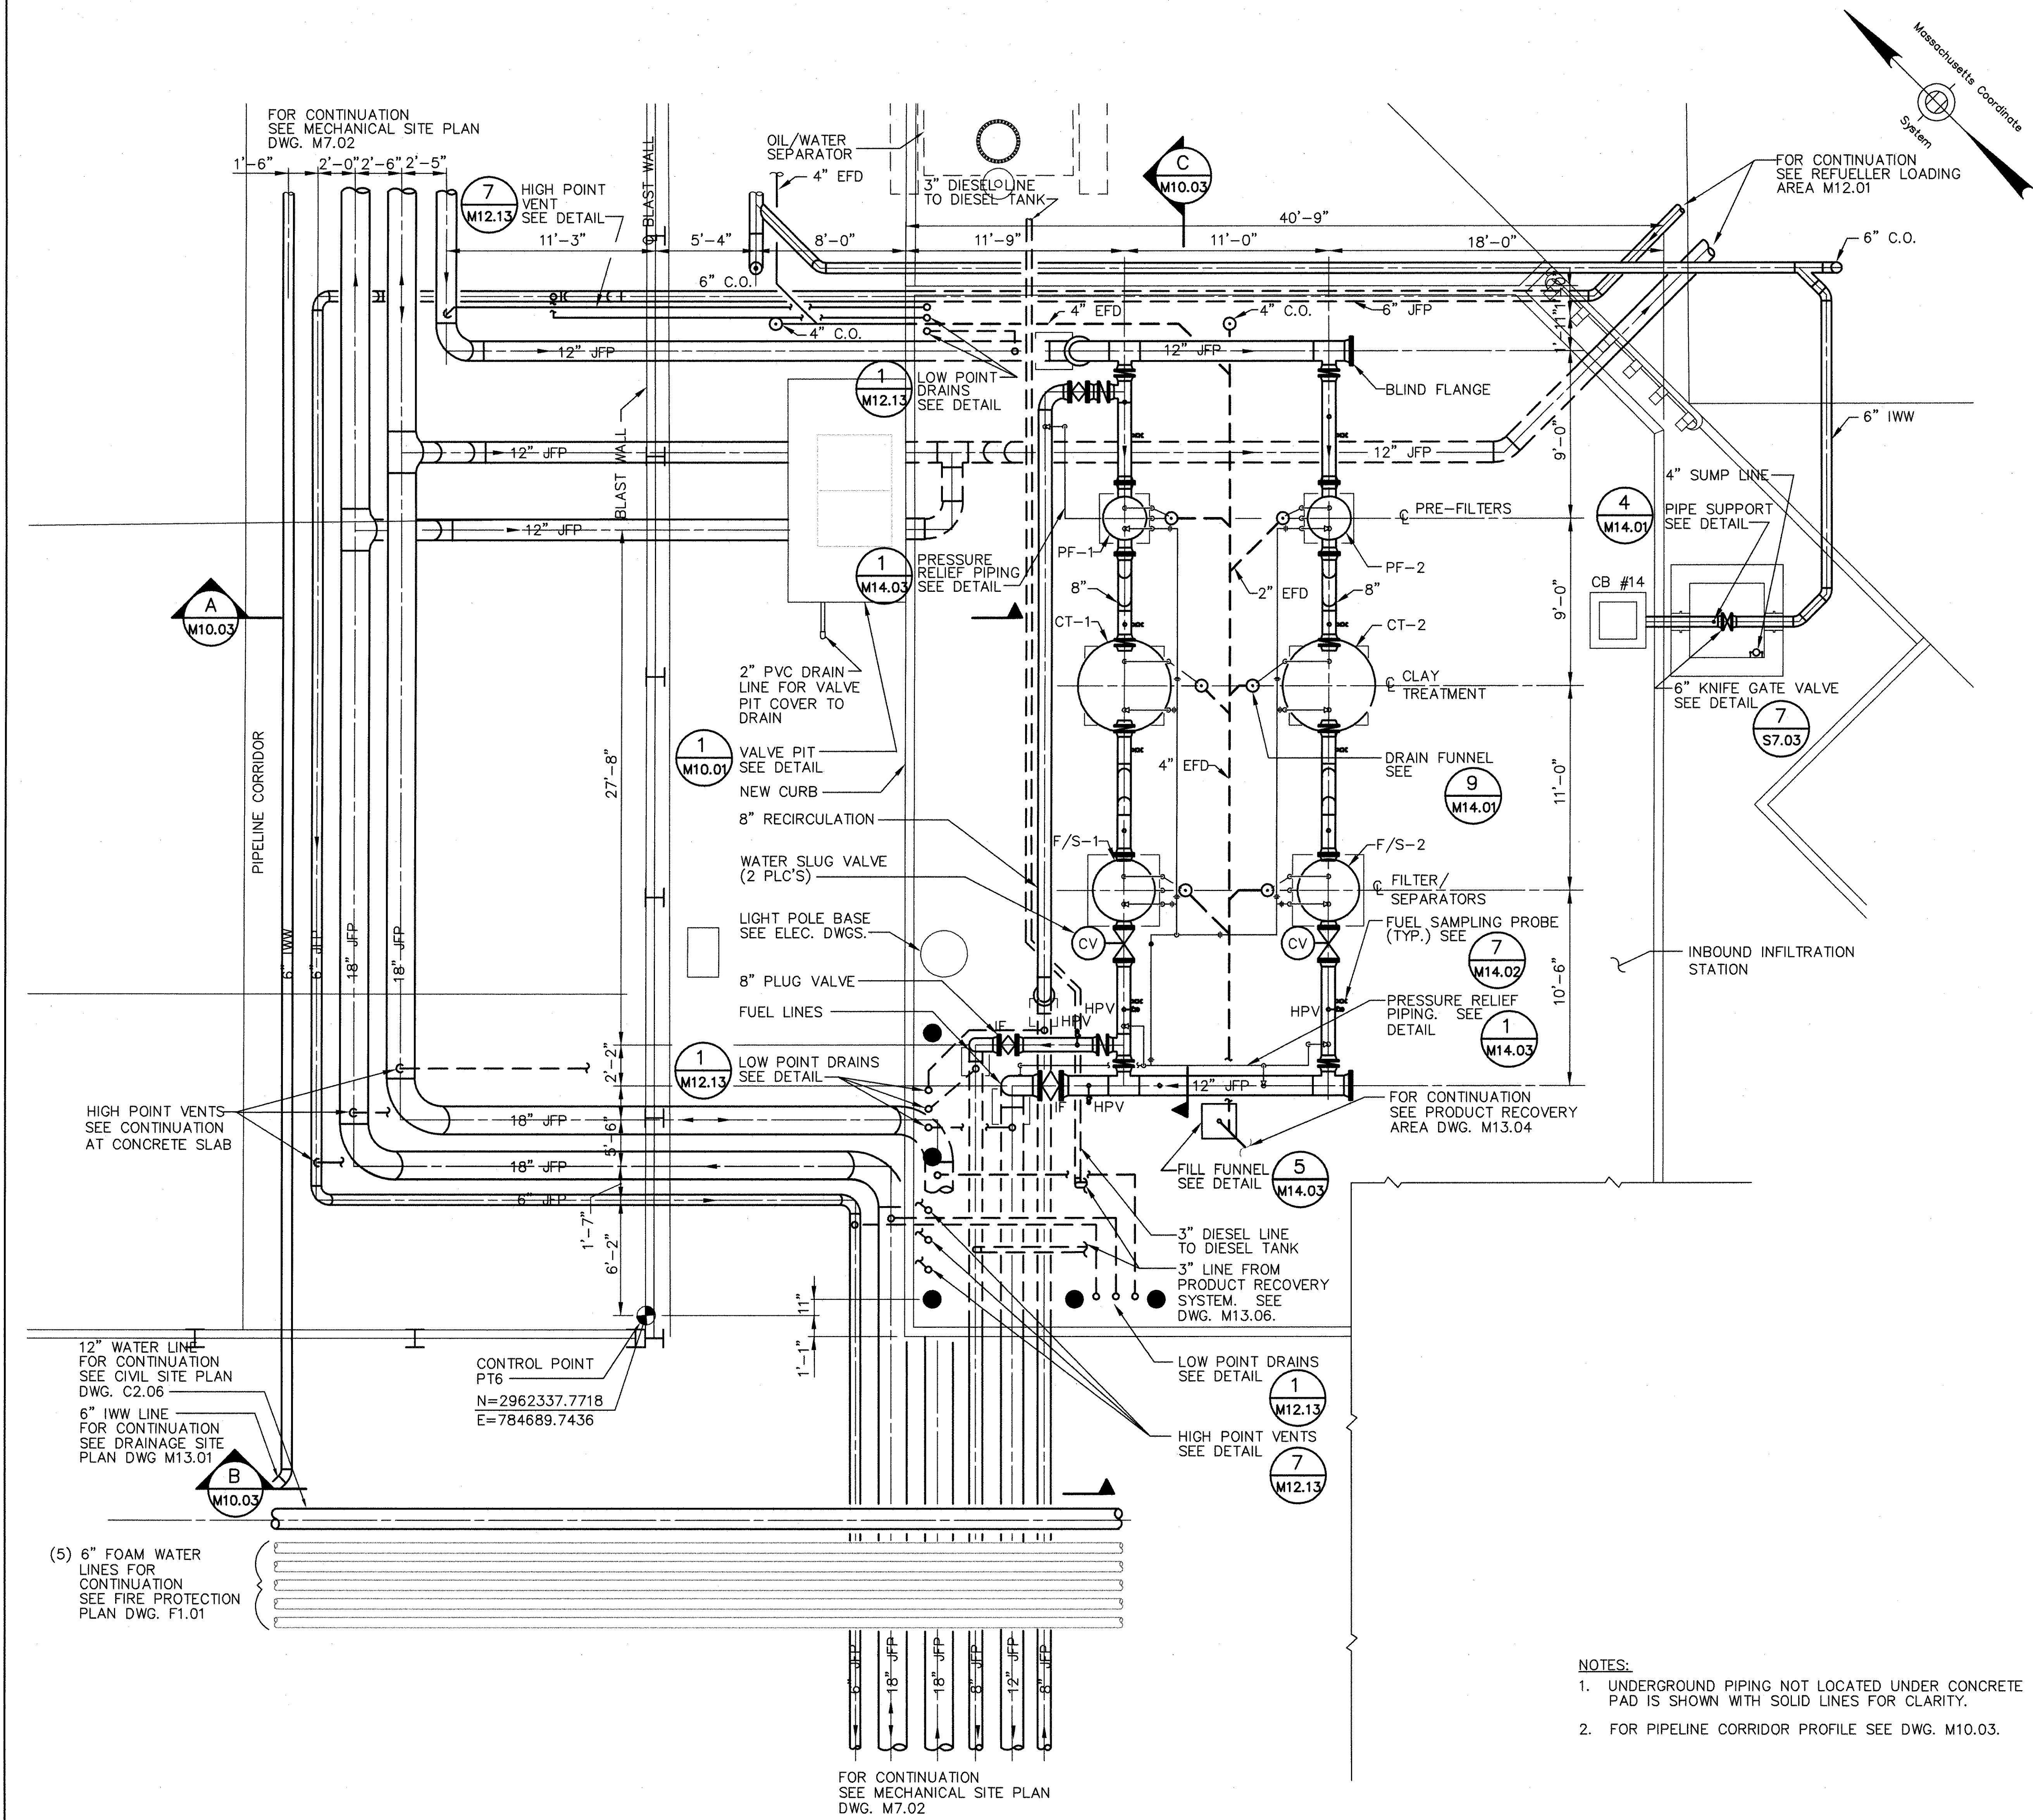

SECTION A
M10.01


VALVE PIT DETAIL 1
SCALE: 1/2"=1'-0"

FOR REFERENCE ONLY

AS CONSTRUCTED PLANS
I hereby certify that all construction required
by this sheet has been accomplished as indicated

JRS Greiner Woodward Clyde, Inc.
BY: [Signature] DATE: 1/9/62



- NOTES:**
- UNDERGROUND PIPING NOT LOCATED UNDER CONCRETE PAD IS SHOWN WITH SOLID LINES FOR CLARITY.
 - FOR PIPELINE CORRIDOR PROFILE SEE DWG. M10.03.

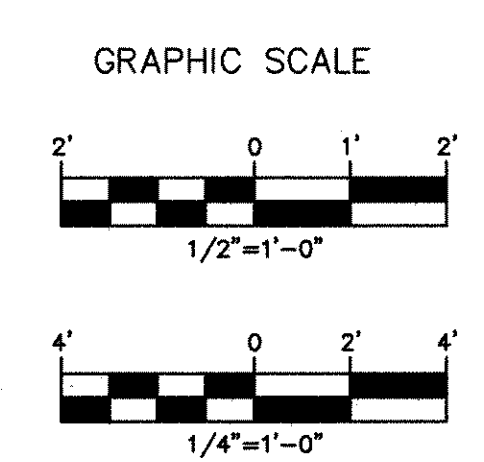

PARTIAL PLAN
SCALE: 1/4" = 1'-0"

REV. NO.	DATE	DESCRIPTION	MADE BY	CHK. BY	APPD. BY
AB	7/99	CONTRACTOR'S AS-BUILT CONDITIONS	DJM	DJM	RAH
MASSACHUSETTS PORT AUTHORITY BOSTON, MASSACHUSETTS					
BOSTON LOGAN INTERNATIONAL AIRPORT EAST BOSTON, MASSACHUSETTS					
AIRCRAFT FUELING SYSTEMS SCHEDULE B - FUEL STORAGE FACILITY INBOUND FILTRATION/PIPELINE CORRIDOR - PARTIAL PLAN					
CONSULTANT AND SUBCONSULTANT: GREINER INC. TAMPA, FLORIDA EDWARDS AND KELCEY INC. BOSTON, MASSACHUSETTS					
DRAWN BY: DM		CHKD. BY: AEP		DWG. NO. M10.01	
SCALE: AS SHOWN		APPROVED: RAH		DATE: 2/97	
MPA CONTRACT NO.: MPA 1.646C (R)				SHEET NO. 12 OF 29	

AS BUILT

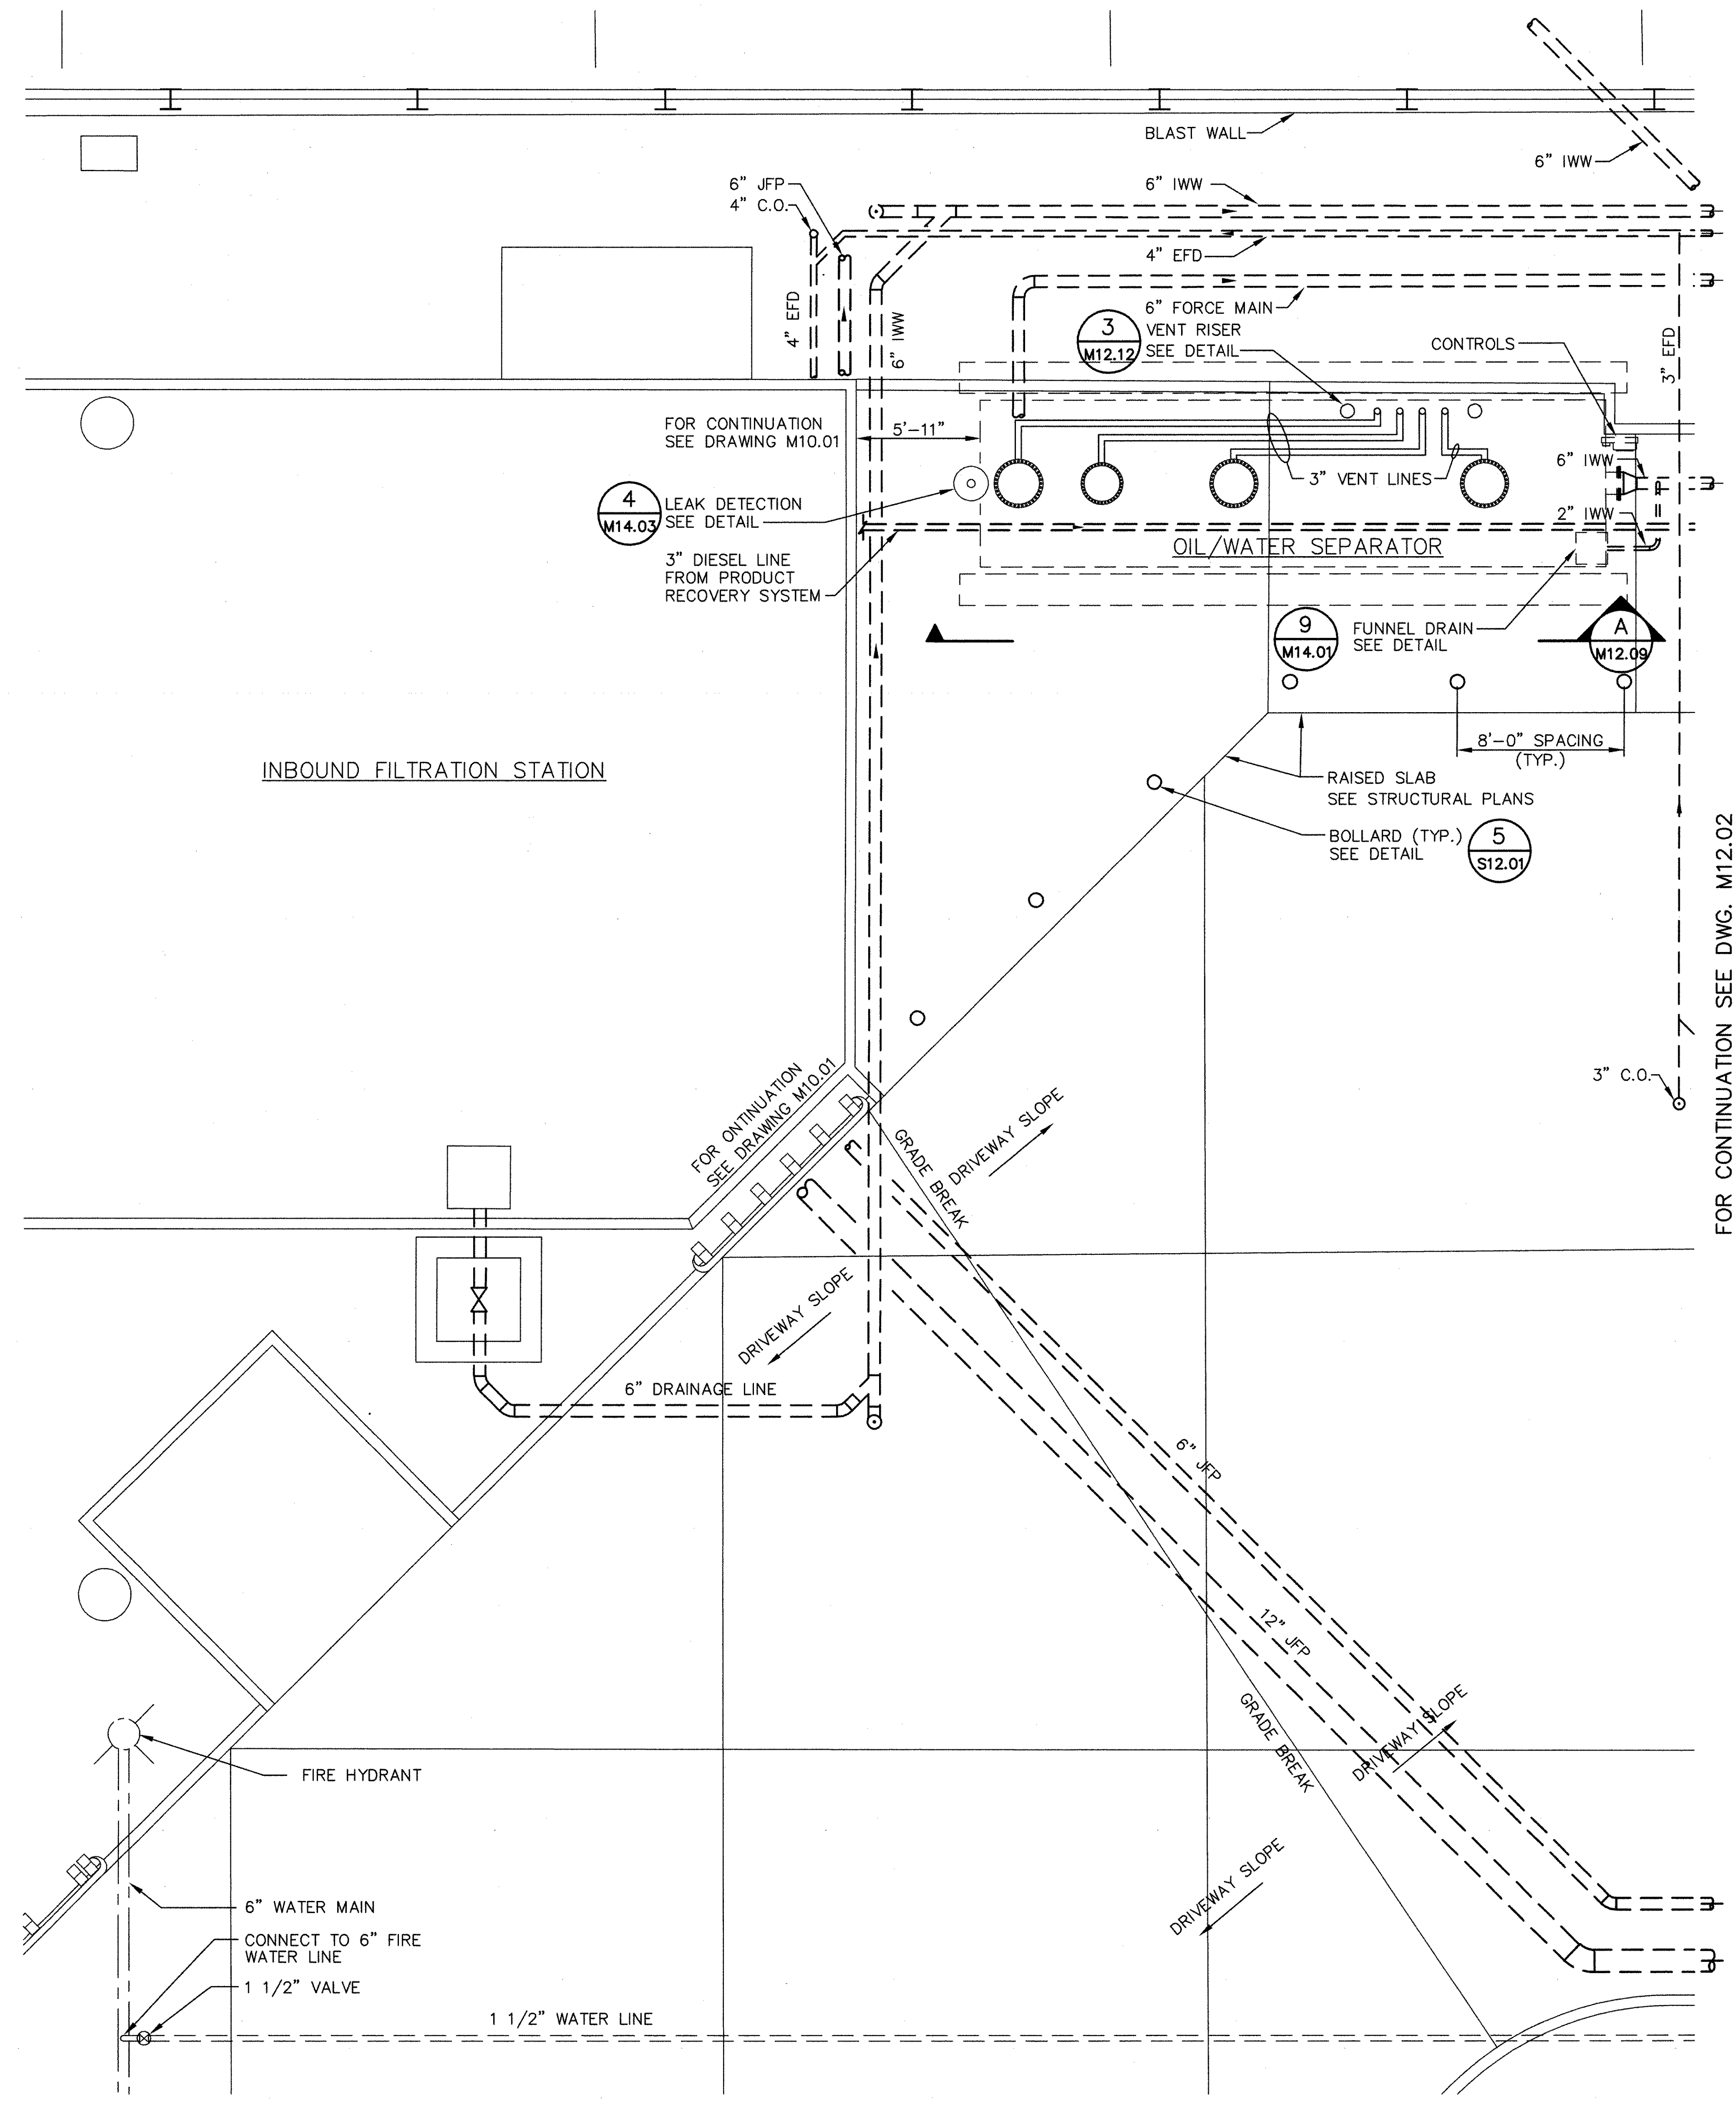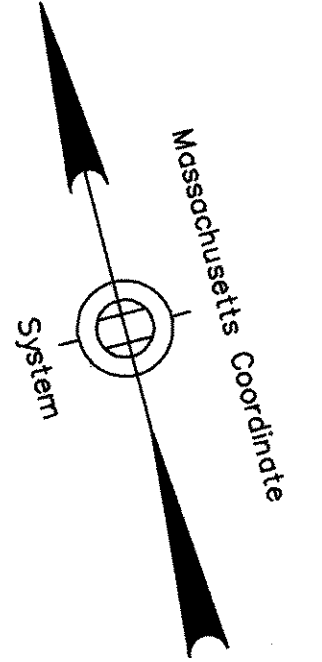

INBOUND FILTRATION STATION


REFUELER LOADING STATION PARTIAL AREA PLAN
SCALE: 1/4" = 1'-0"

FOR REFERENCE ONLY

AS CONSTRUCTED PLANS
I hereby certify that all construction required
by this sheet has been accomplished as indicated



UFS Greiner Woodward Clyde, Inc.
BY: *[Signature]* DATE: 1/9/02

REV. NO.	DATE	DESCRIPTION	MADE BY	CHK. BY	APPD. BY
AB	7/99	CONTRACTOR'S AS-BUILT CONDITIONS		DJM	RAH
MASSACHUSETTS PORT AUTHORITY BOSTON, MASSACHUSETTS					
BOSTON LOGAN INTERNATIONAL AIRPORT EAST BOSTON, MASSACHUSETTS					
AIRCRAFT FUELING SYSTEMS SCHEDULE B - FUEL STORAGE FACILITY REFUELER LOADING STATION - PARTIAL SITE PLAN					
CONSULTANT AND SUBCONSULTANT:					
GREINER INC. TAMPA, FLORIDA EDWARDS AND KELCEY INC. BOSTON, MASSACHUSETTS					
DRAWN BY:	CGH	CHKD. BY:	RAH	DWG. NO:	
SCALE:	1/4" = 1'-0"	APPROVED:	RAH	DATE:	2/97
MPA CONTRACT NO.: MPA 1.646C (R)				SHEET NO. 48 OF 200	

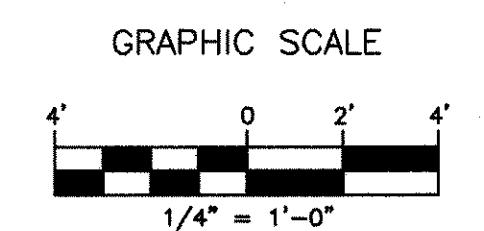

AS BUILT

C:\BOS\FUEL\STDR\MECH-AB\M1201A3C 05/25/99 08:45

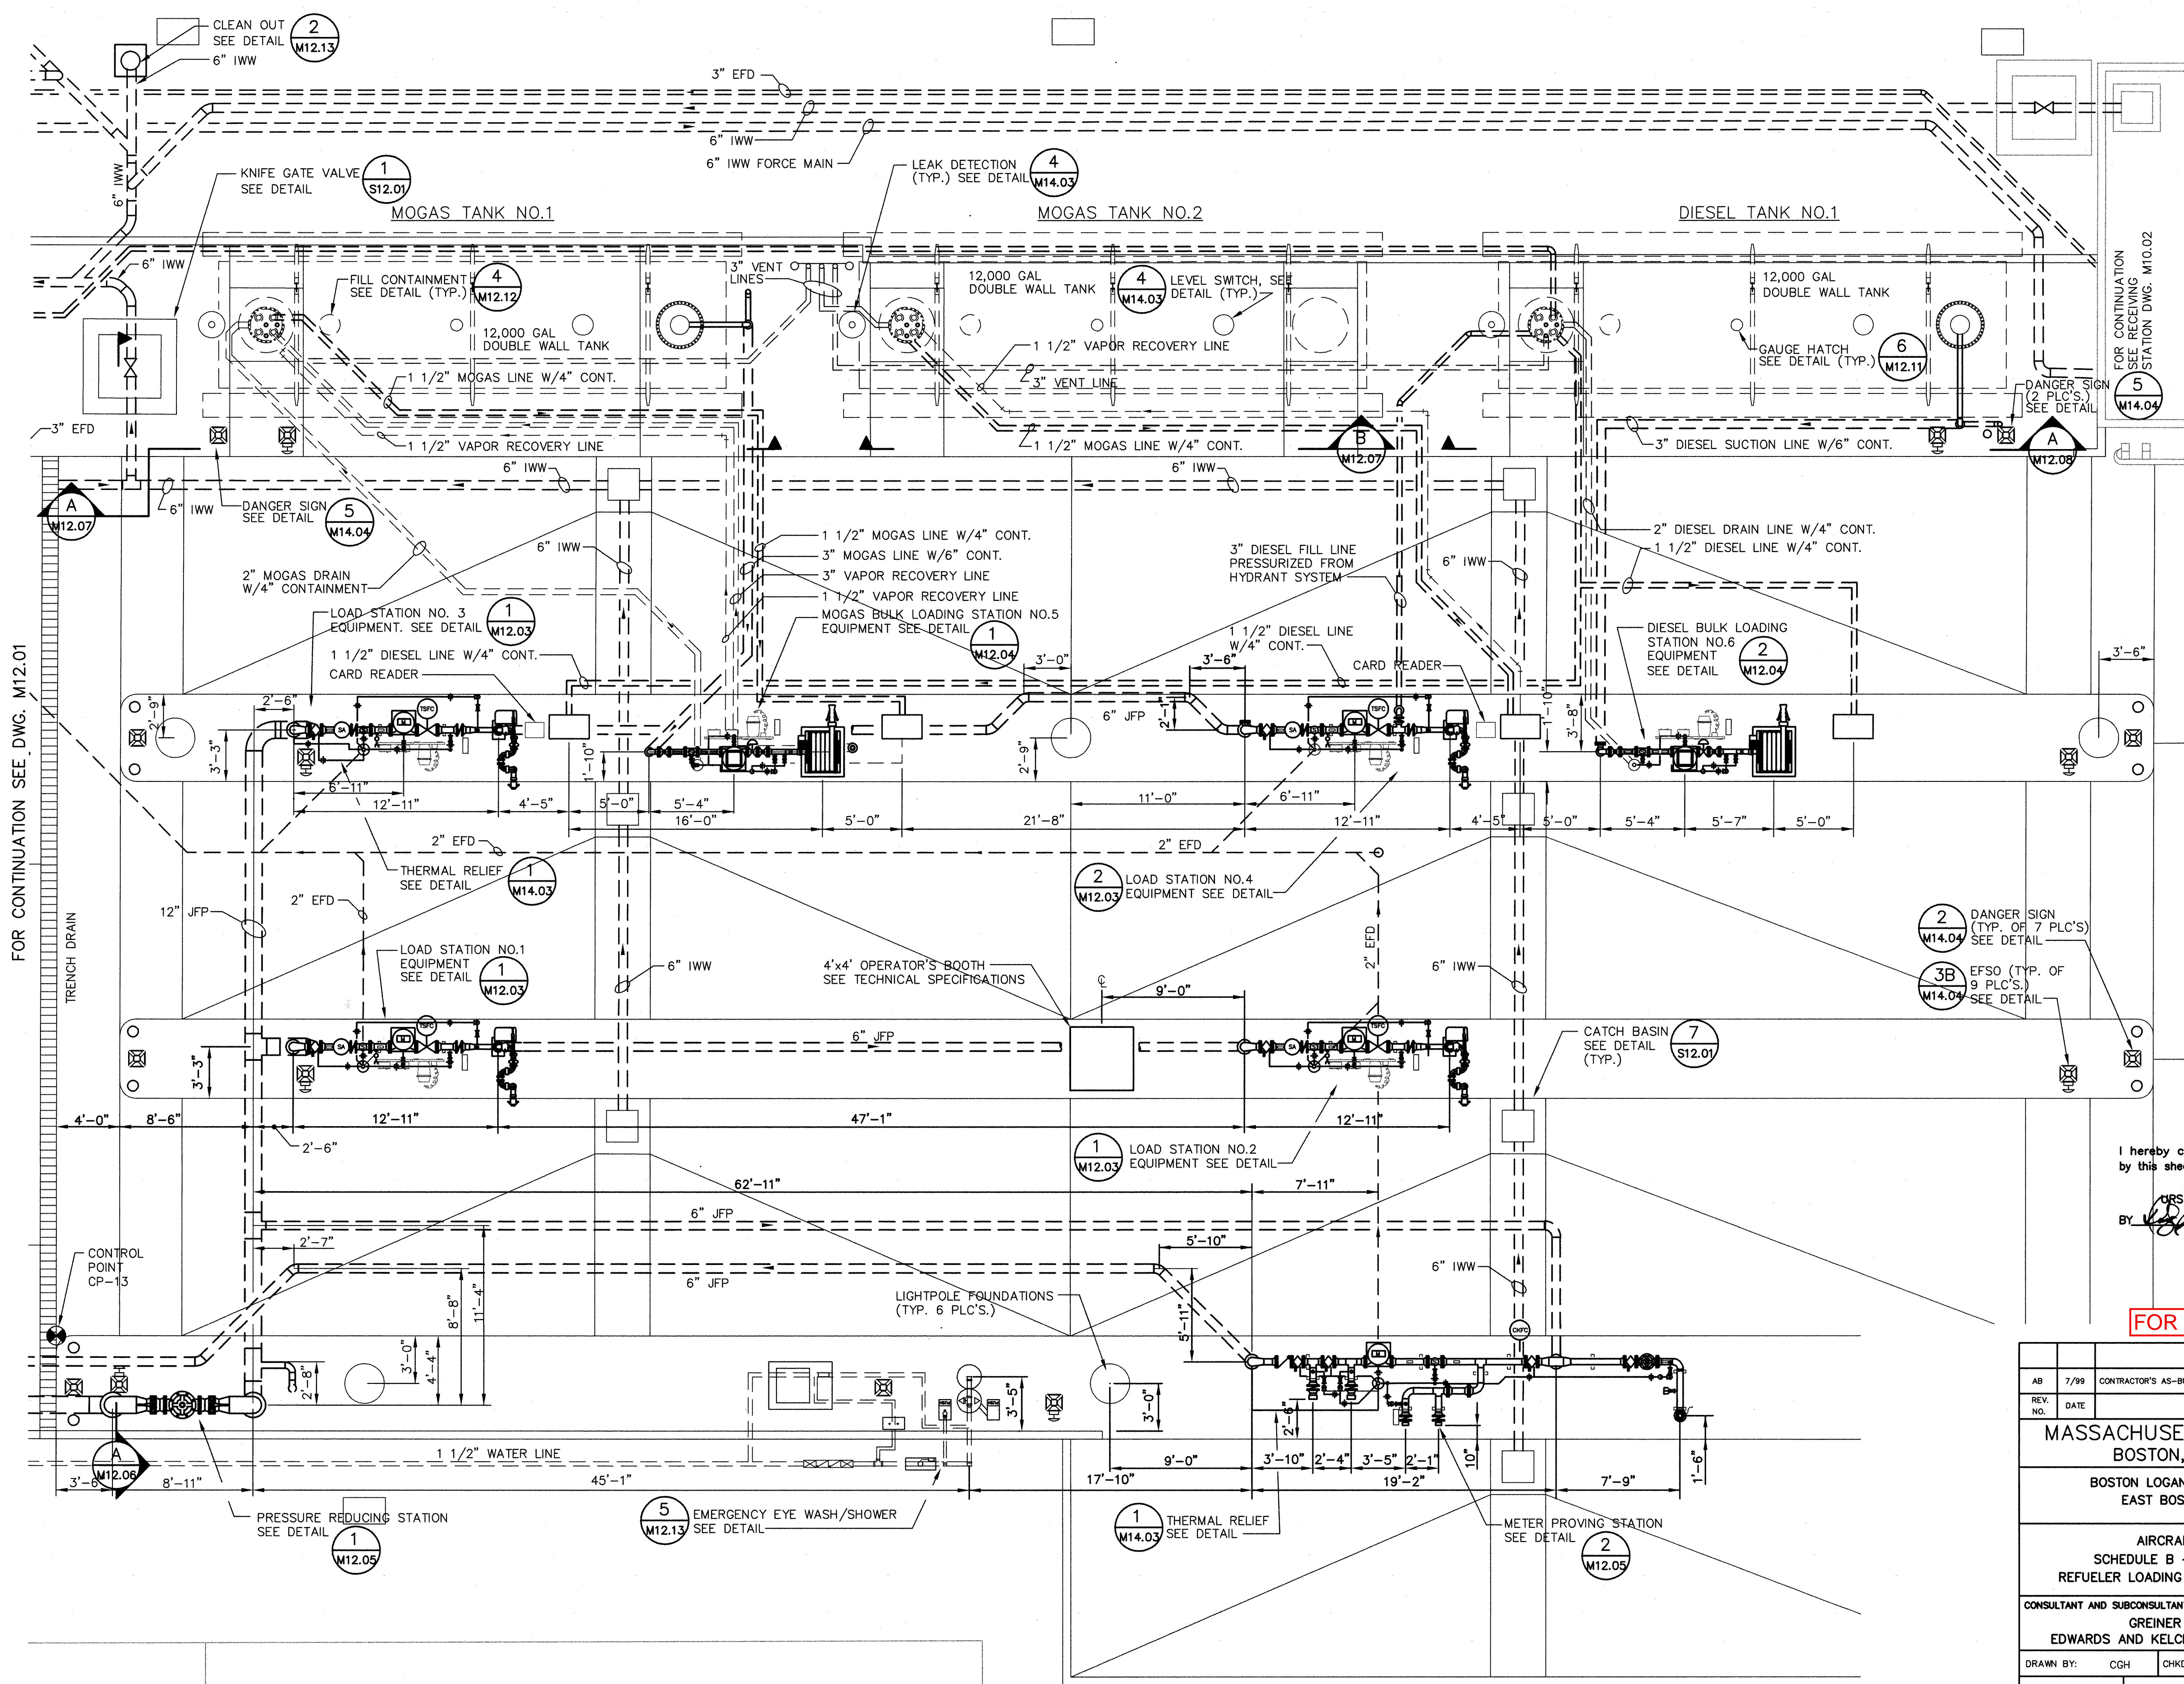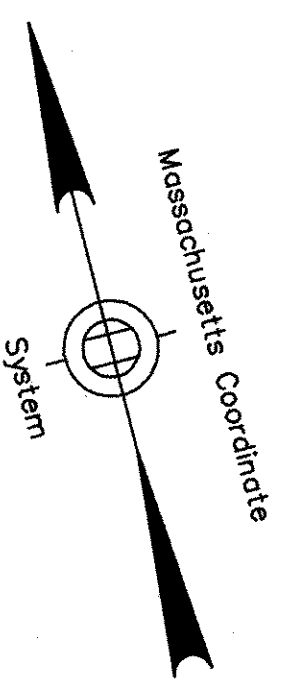

FOR CONTINUATION SEE DWG. M12.01


FOR CONTINUATION SEE RECEIVING STATION DWG. M10.02

AS CONSTRUCTED PLANS
I hereby certify that all construction required
by this sheet has been accomplished as indicated.

URS Greiner Woodward Clyde, Inc.
By: *[Signature]* DATE: 1/962

FOR REFERENCE ONLY


REFUELER LOADING STATION PARTIAL AREA PLAN
SCALE: 1/4"=1'-0"

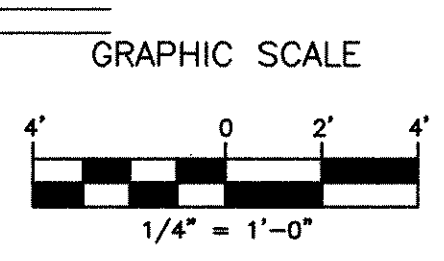

AB	7/99	CONTRACTOR'S AS-BUILT CONDITIONS	DJM	DJM	RAH
REV. NO.	DATE		MADE BY	CHK BY	APPD. BY
MASSACHUSETTS PORT AUTHORITY BOSTON, MASSACHUSETTS					
BOSTON LOGAN INTERNATIONAL AIRPORT EAST BOSTON, MASSACHUSETTS					
AIRCRAFT FUELING SYSTEMS SCHEDULE B - FUEL STORAGE FACILITY REFUELER LOADING STATION - PARTIAL SITE PLAN					
CONSULTANT AND SUBCONSULTANT: GREINER INC. TAMPA, FLORIDA EDWARDS AND KELCEY INC. BOSTON, MASSACHUSETTS					
DRAWN BY: CGH		CHKD. BY: RAH		DWG. NO:	
SCALE: 1/4"=1'-0"		APPROVED: RAH		DATE: 2/97	
MPA CONTRACT NO.: MPA 1.646C (R)				SHEET NO. 42 OF 42	

AS BUILT

C:\BOSFUELV\FUELSTOR\MECH-AB\M1202ABC 09/22/99 17:39

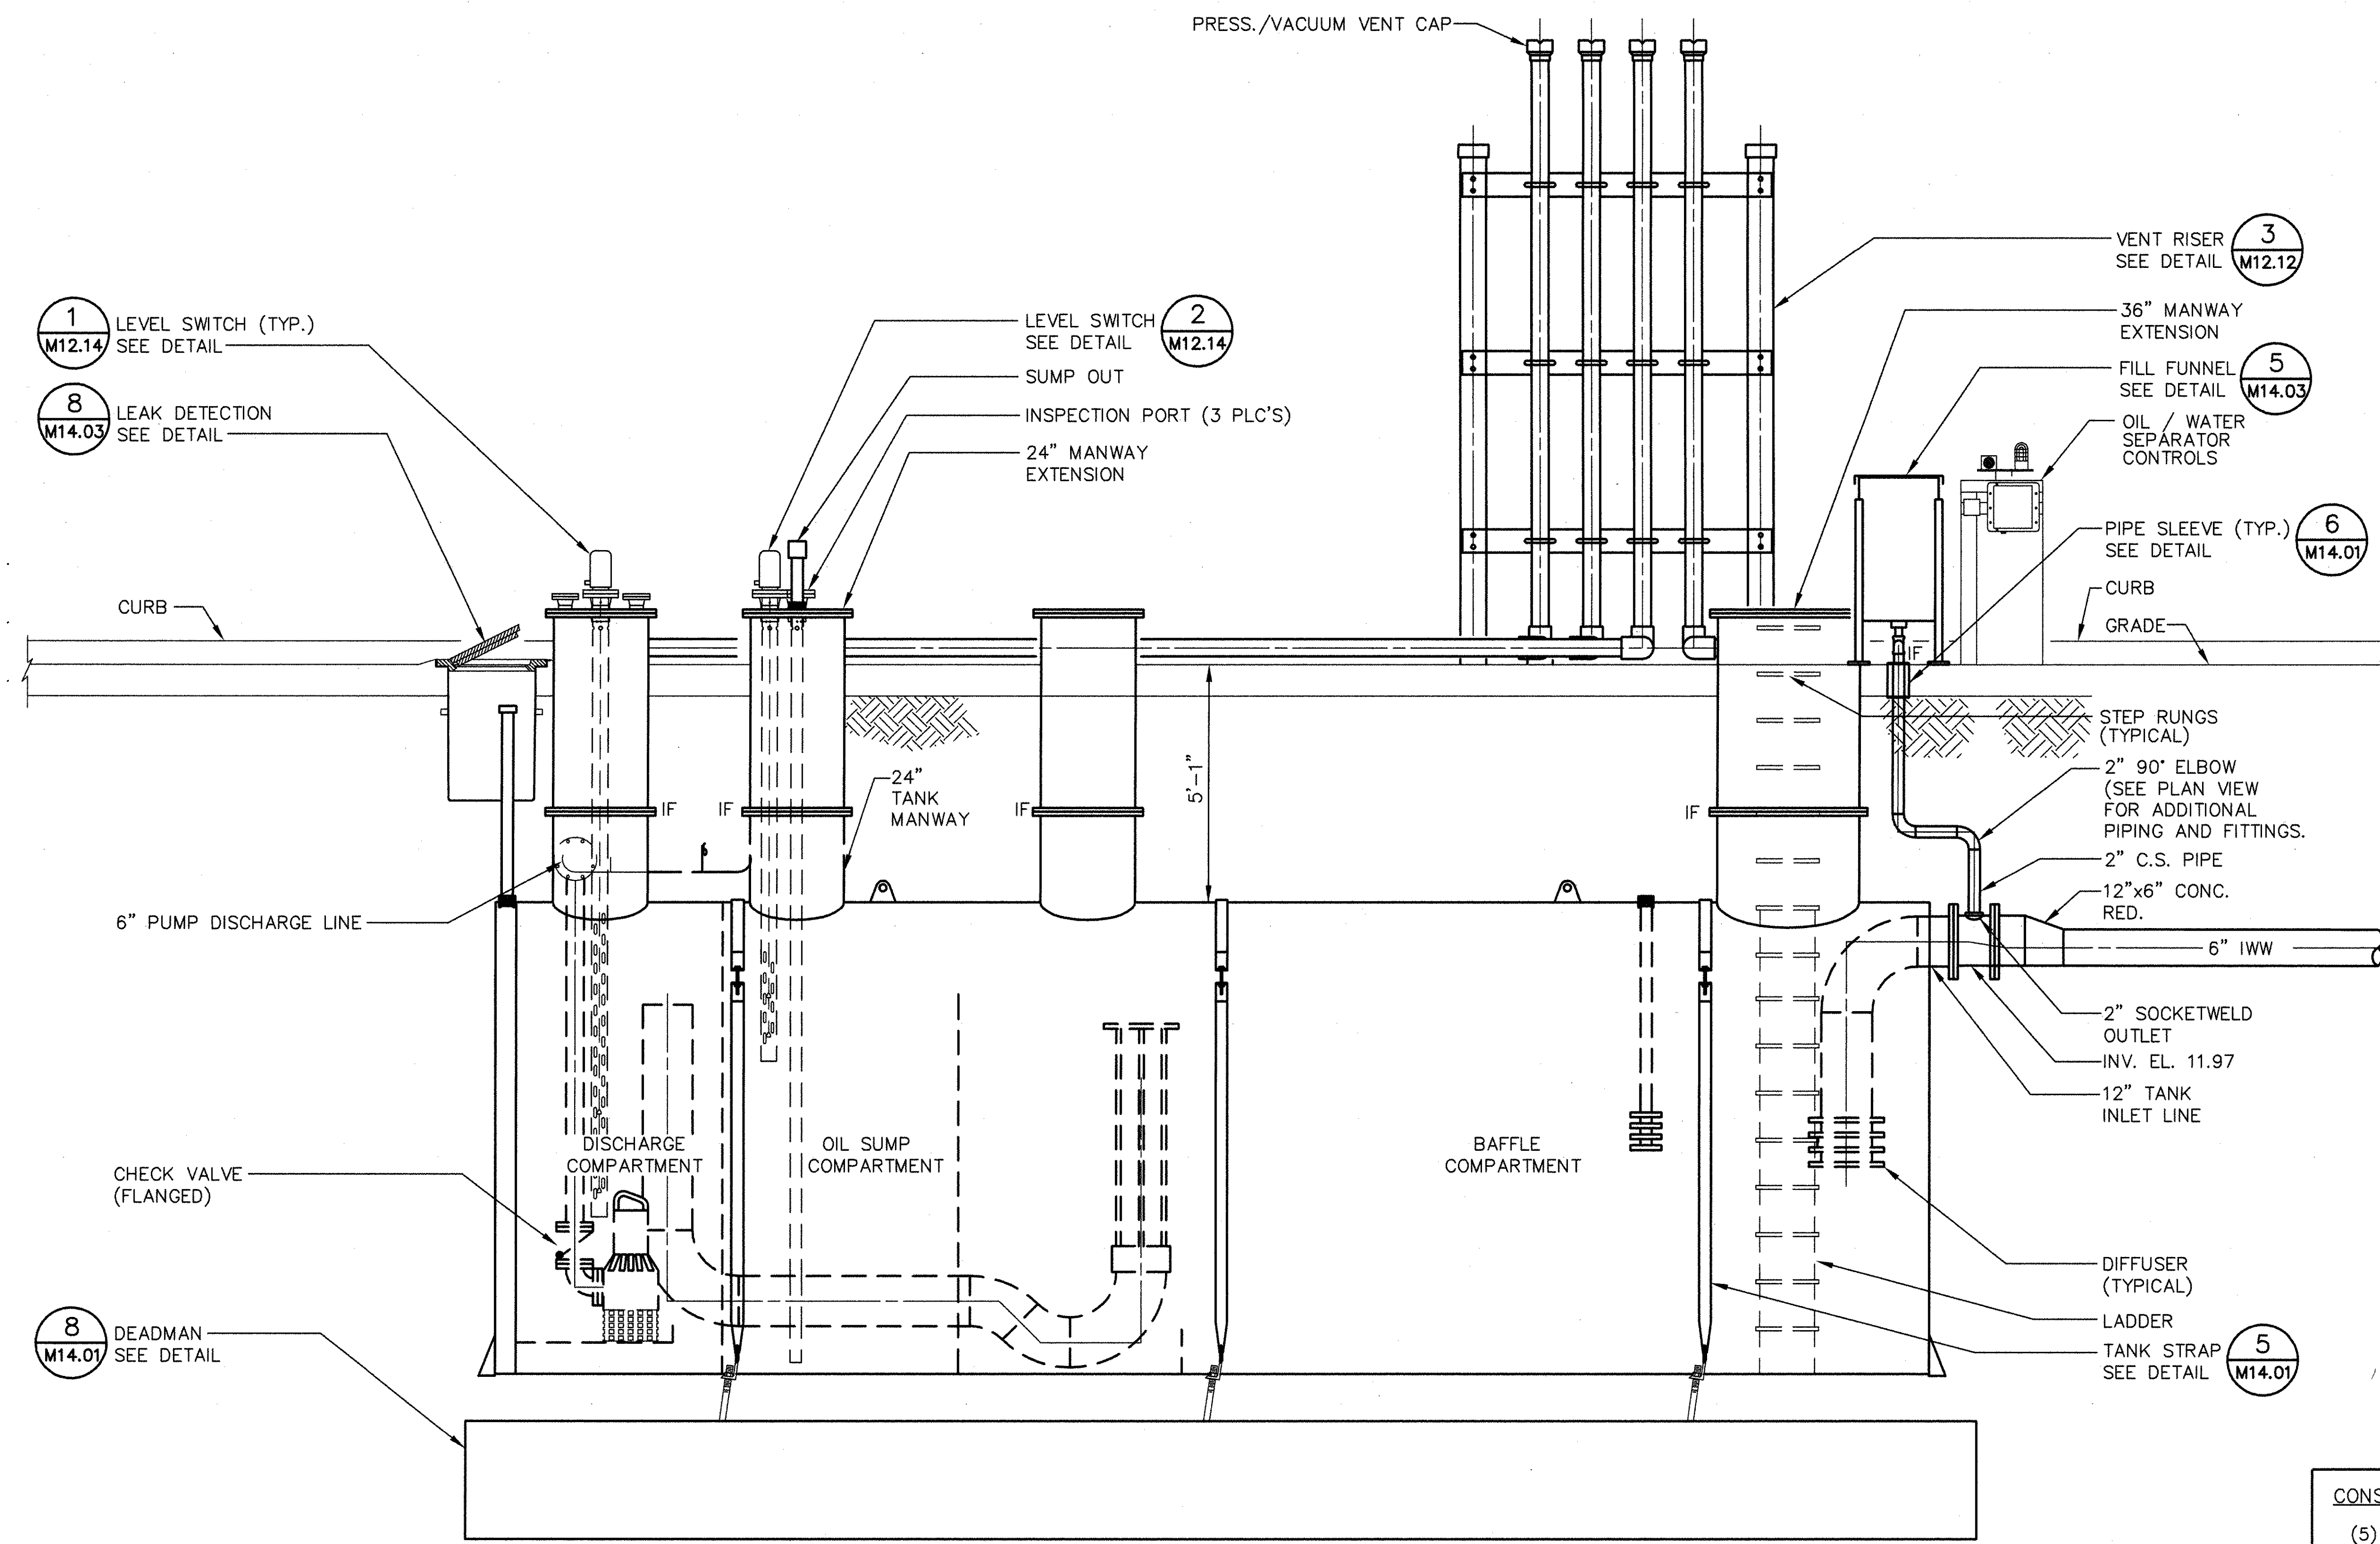

1 LEVEL SWITCH (TYP.)
M12.14 SEE DETAIL

8 LEAK DETECTION
M14.03 SEE DETAIL

2 LEVEL SWITCH
M12.14 SEE DETAIL

SUMP OUT
INSPECTION PORT (3 PLC'S)
24" MANWAY EXTENSION

3 VENT RISER
M12.12 SEE DETAIL

5 36" MANWAY EXTENSION
M14.03 SEE DETAIL

FILL FUNNEL
M14.03 SEE DETAIL

OIL / WATER SEPARATOR CONTROLS

6 PIPE SLEEVE (TYP.)
M14.01 SEE DETAIL

CURB
GRADE

STEP RUNGS (TYPICAL)

2" 90° ELBOW (SEE PLAN VIEW FOR ADDITIONAL PIPING AND FITTINGS.)

2" C.S. PIPE
12"x6" CONC. RED.

6" IWW

2" SOCKETWELD OUTLET
INV. EL. 11.97

12" TANK INLET LINE

DIFFUSER (TYPICAL)

LADDER
TANK STRAP
M14.01 SEE DETAIL

CURB

6" PUMP DISCHARGE LINE

CHECK VALVE (FLANGED)

8 DEADMAN
M14.01 SEE DETAIL

DISCHARGE COMPARTMENT

OIL SUMP COMPARTMENT

BAFFLE COMPARTMENT

24" TANK MANWAY

5'-1"

NOTE:
FOR ADDITIONAL INTERNAL COMPONENTS FOR OIL / WATER SEPARATOR NOT SHOWN ON THIS DRAWING REFER TO THE TECHNICAL SPECIFICATIONS FOR THIS PROJECT

CONSTRUCTION NOTE:
(5) ADDITIONAL ANODES WERE INSTALLED 10' WEST OF THE OIL/WATER SEPARATOR. THE ANODES ARE 5' IN LENGTH, APPROX. 6" IN HEIGHT, INSTALLED HORIZONTALLY WITH A 5' SEPARATION BETWEEN EACH ANODE.

OIL/WATER SEPARATOR SECTION
SCALE: 1/2"=1'-0"

FOR REFERENCE ONLY

AS CONSTRUCTED PLANS
I hereby certify that all construction required by this sheet has been accomplished as indicated

URS Greiner Woodward Clyde, Inc.
BY: [Signature] DATE: 1/97

REV. NO.	DATE	DESCRIPTION	MADE BY	CHK. BY	APPD. BY
AB	7/99	CONTRACTOR'S AS-BUILT CONDITIONS	DJM	DJM	RAH

MASSACHUSETTS PORT AUTHORITY
BOSTON, MASSACHUSETTS


BOSTON LOGAN INTERNATIONAL AIRPORT
EAST BOSTON, MASSACHUSETTS

AIRCRAFT FUELING SYSTEMS
SCHEDULE B - FUEL STORAGE FACILITY
OIL/WATER SEPARATOR SECTION


CONSULTANT AND SUBCONSULTANT:
GREINER INC. TAMPA, FLORIDA
EDWARDS AND KELCEY INC. BOSTON, MASSACHUSETTS

DRAWN BY: CGH CHKD. BY: RAH DWG. NO: M12.09
SCALE: 1/2"=1'-0" APPROVED: RAH DATE: 2/97

MPA CONTRACT NO.: MPA 1.646C (R) SHEET NO. 5 OF 20

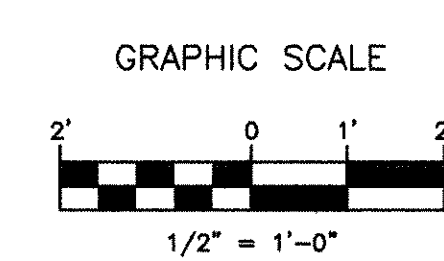


AS BUILT

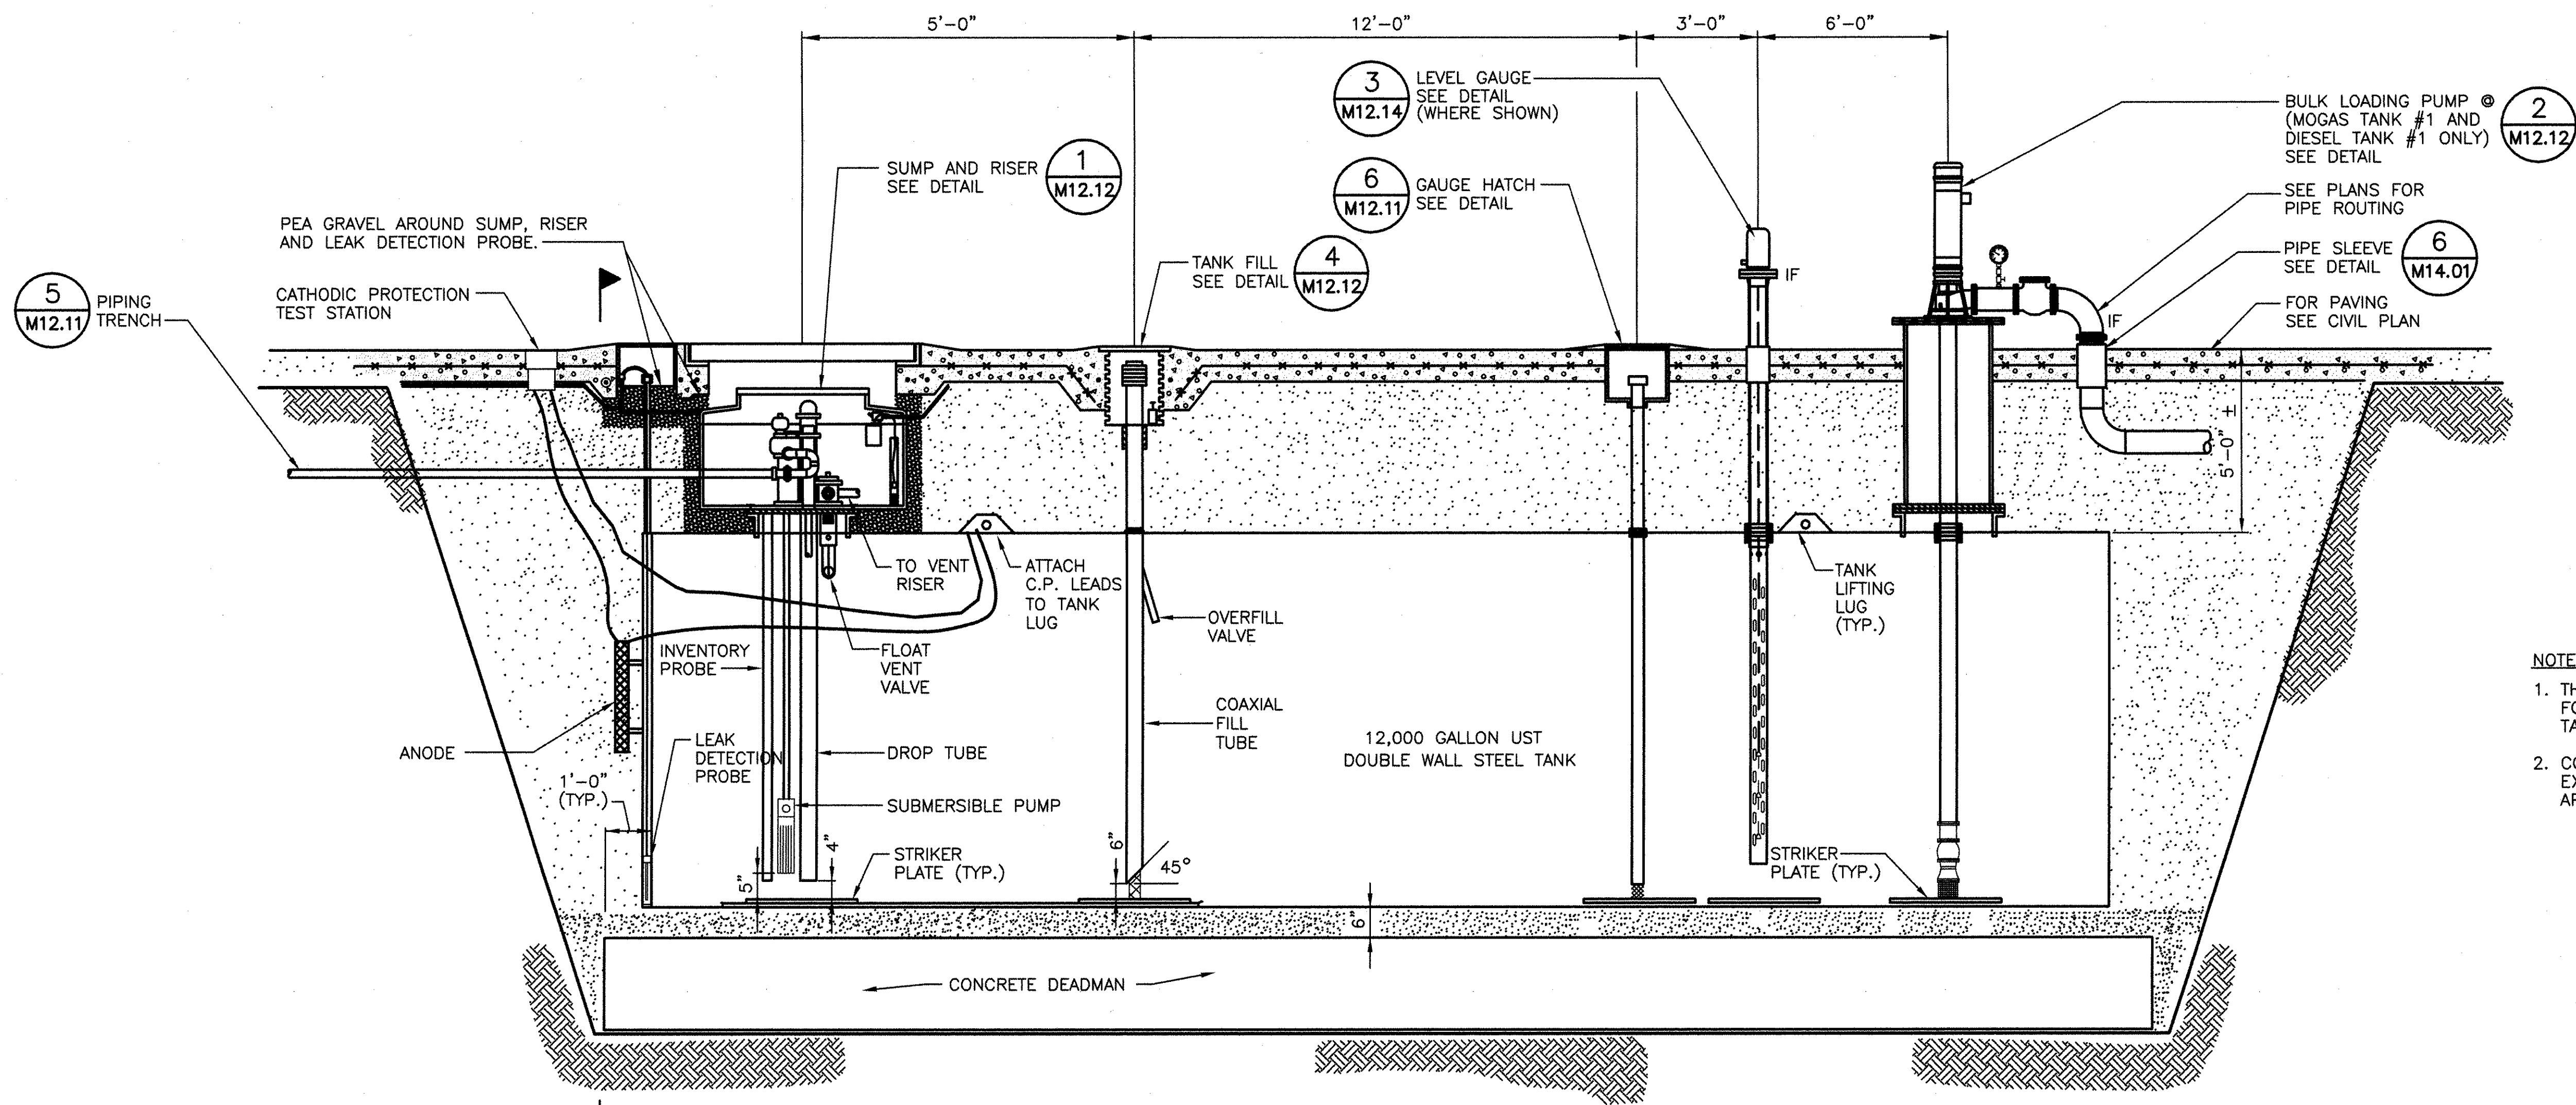

- NOTES:**
1. THIS DRAWING REPRESENTS A TYPICAL INSTALLATION FOR BELOW GROUND FUEL TANKS. REFER TO SPECIFIC TANK SECTIONS FOR IDENTIFICATION OF COMPONENTS.
 2. CONTRACTOR SHALL PROVIDE SHEETING FOR TANK EXCAVATION OR SLOPED WALLS IN ACCORDANCE WITH APPLICABLE SAFETY REGULATIONS.

GENERAL UNDERGROUND MOGAS AND DIESEL TANK ELEVATION
N.T.S.

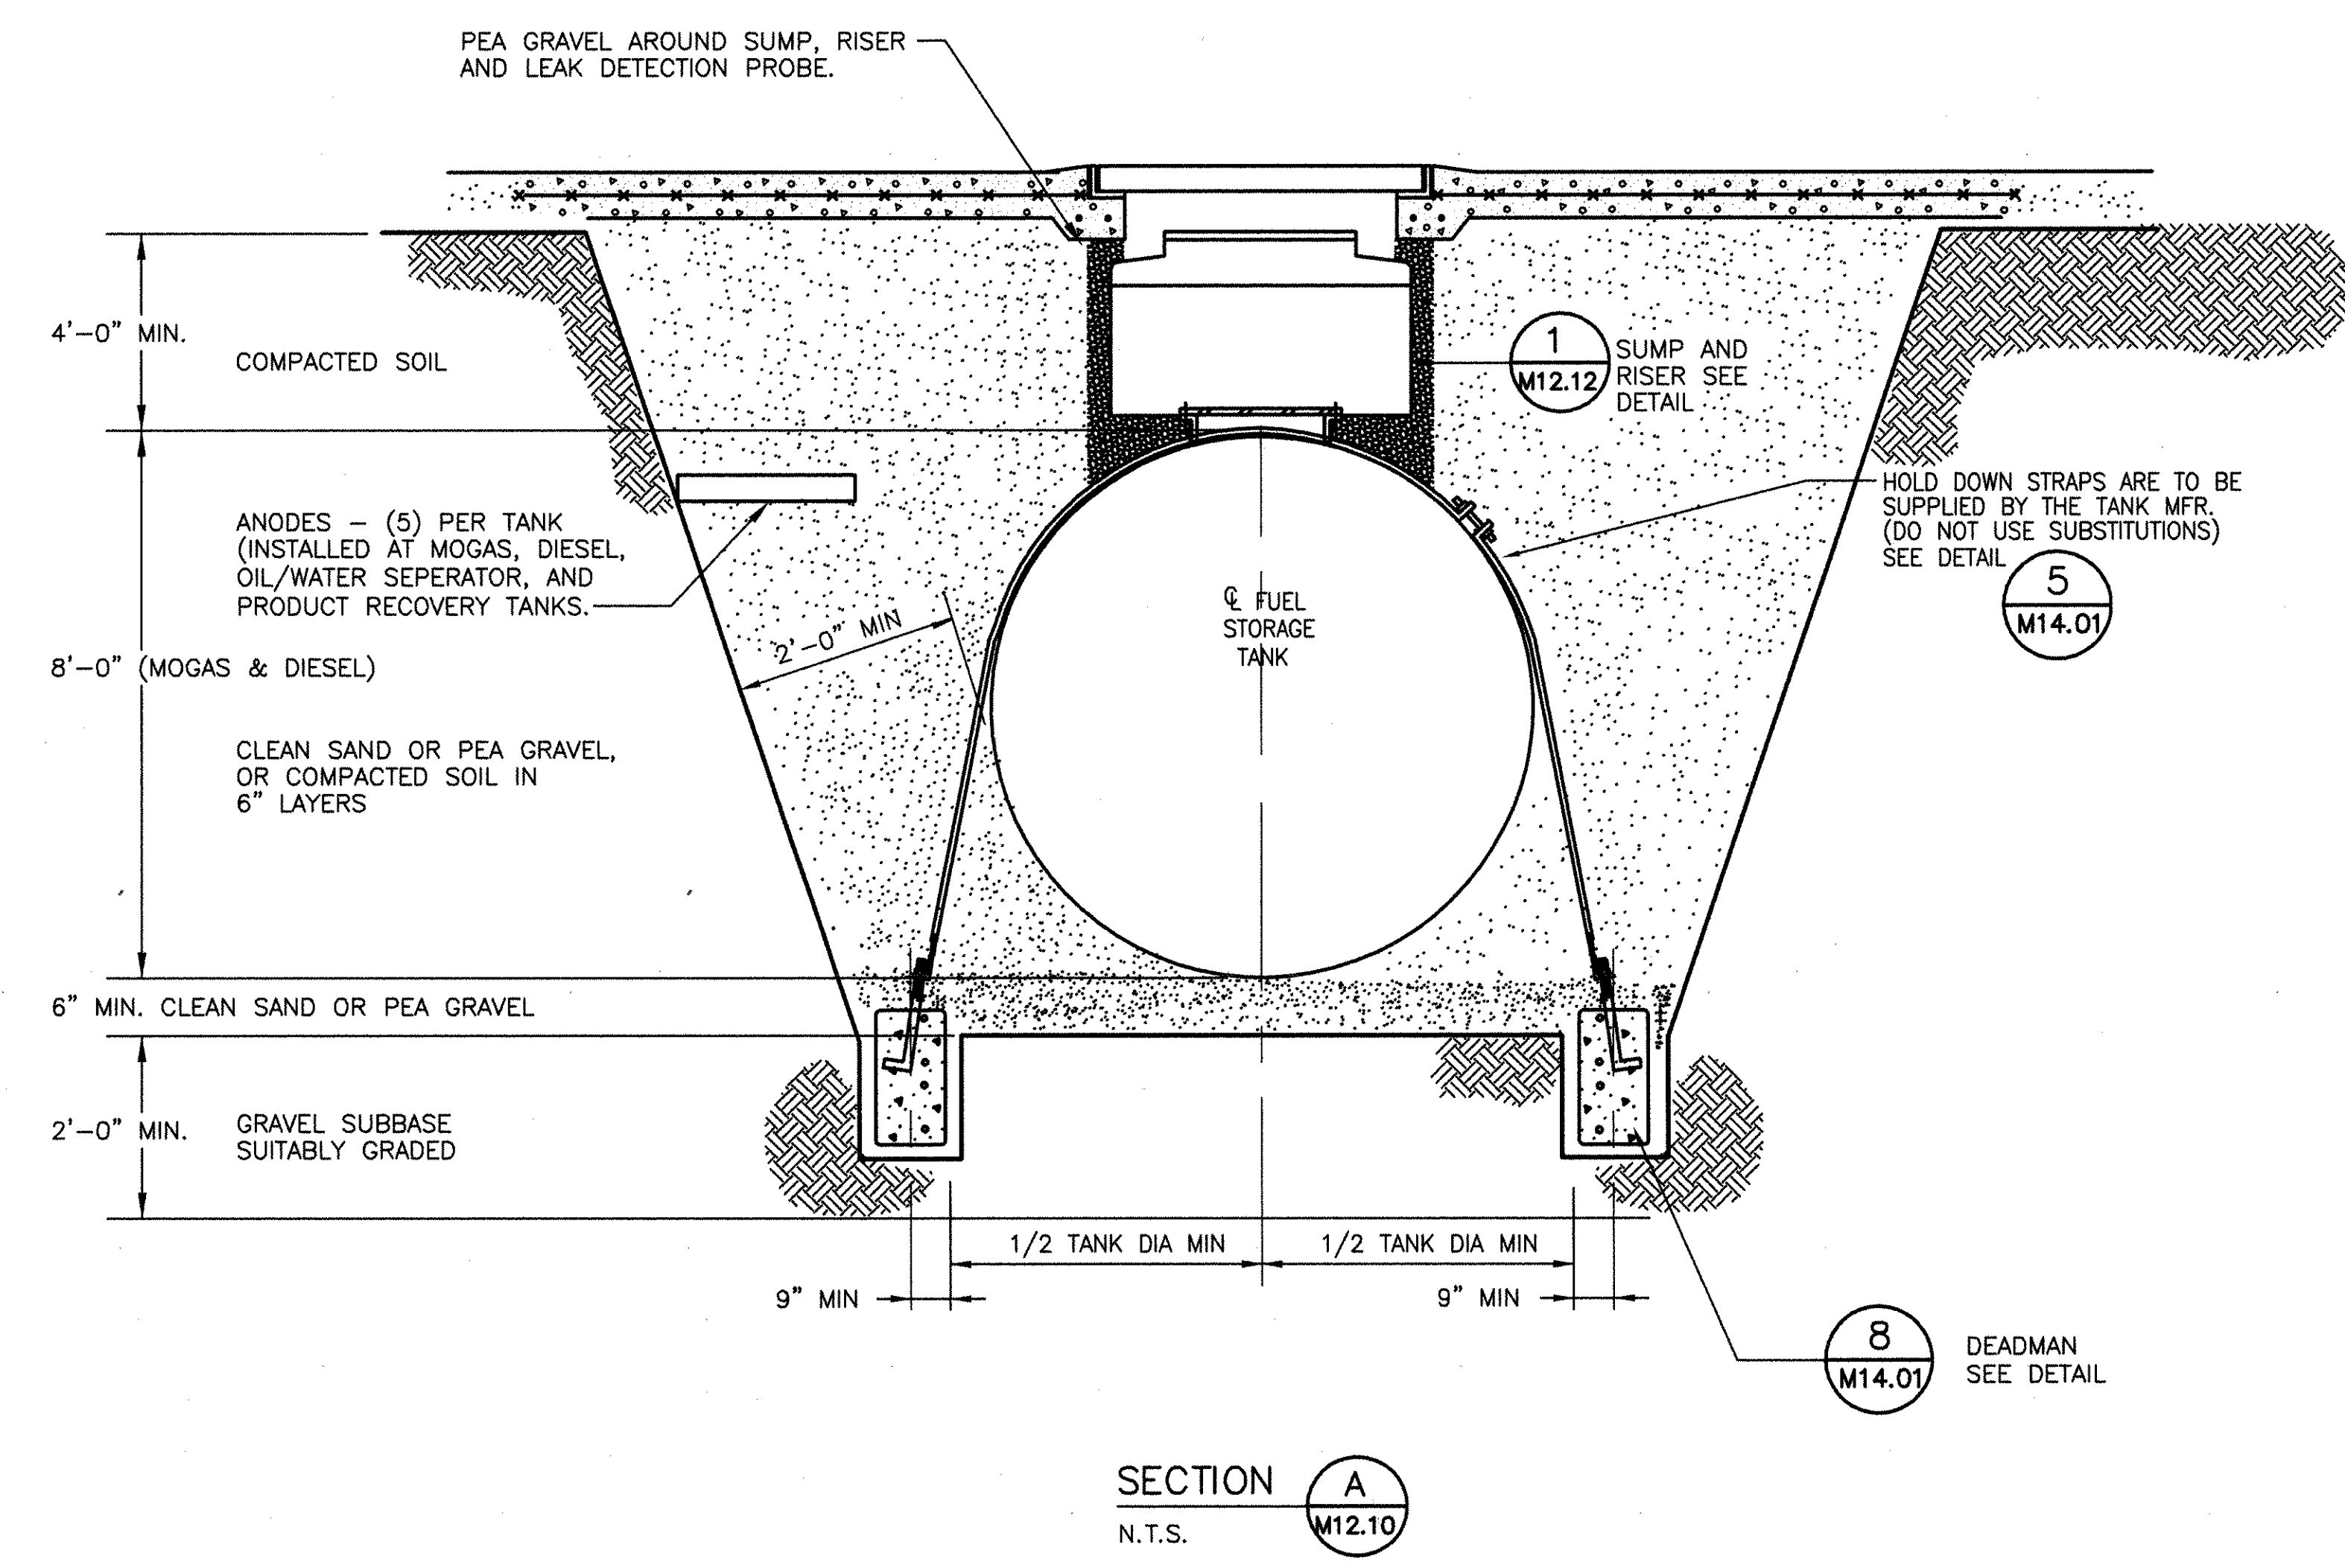

- CONSTRUCTION NOTES:**
1. (5) ADDITIONAL ANODES WERE INSTALLED 10' WEST OF THE FOLLOWING UST'S: MOGAS TANKS 1 & 2, DIESEL TANK, AND OIL/WATER SEPARATOR.
 2. (5) ADDITIONAL ANODES WERE INSTALLED 10' NORTH OF THE PRODUCT RECOVERY TANK.
 3. THE ANODES ARE 5' IN LENGTH, APPROX. 6" IN HEIGHT, INSTALLED HORIZONTALLY WITH A 5' SEPARATION BETWEEN EACH ANODE.


FOR REFERENCE ONLY

AS CONSTRUCTED PLANS
I hereby certify that all construction required
by this sheet has been accomplished as indicated

URS Greiner Woodward Clyde, Inc.
BY: [Signature] DATE: 1/92


REV. NO.	DATE	DESCRIPTION	MADE BY	CHK. BY	APPD. BY
AB	7/99	CONTRACTOR'S AS-BUILT CONDITIONS		DJM	DJM RAH
MASSACHUSETTS PORT AUTHORITY BOSTON, MASSACHUSETTS					
BOSTON LOGAN INTERNATIONAL AIRPORT EAST BOSTON, MASSACHUSETTS					
AIRCRAFT FUELING SYSTEMS SCHEDULE B - FUEL STORAGE FACILITY GENERAL UNDERGROUND TANK INSTALLATION DETAIL					
CONSULTANT AND SUBCONSULTANT:					
GREINER INC. TAMPA, FLORIDA EDWARDS AND KELCEY INC. BOSTON, MASSACHUSETTS					
DRAWN BY: CGH		CHKD. BY: RAH		DWG. NO. M12.10	
SCALE: NONE		APPROVED: RAH		DATE: 2/97	
MPA CONTRACT NO.: MPA 1.646C (R) SHEET NO. 52 OF 52					

AS BUILT

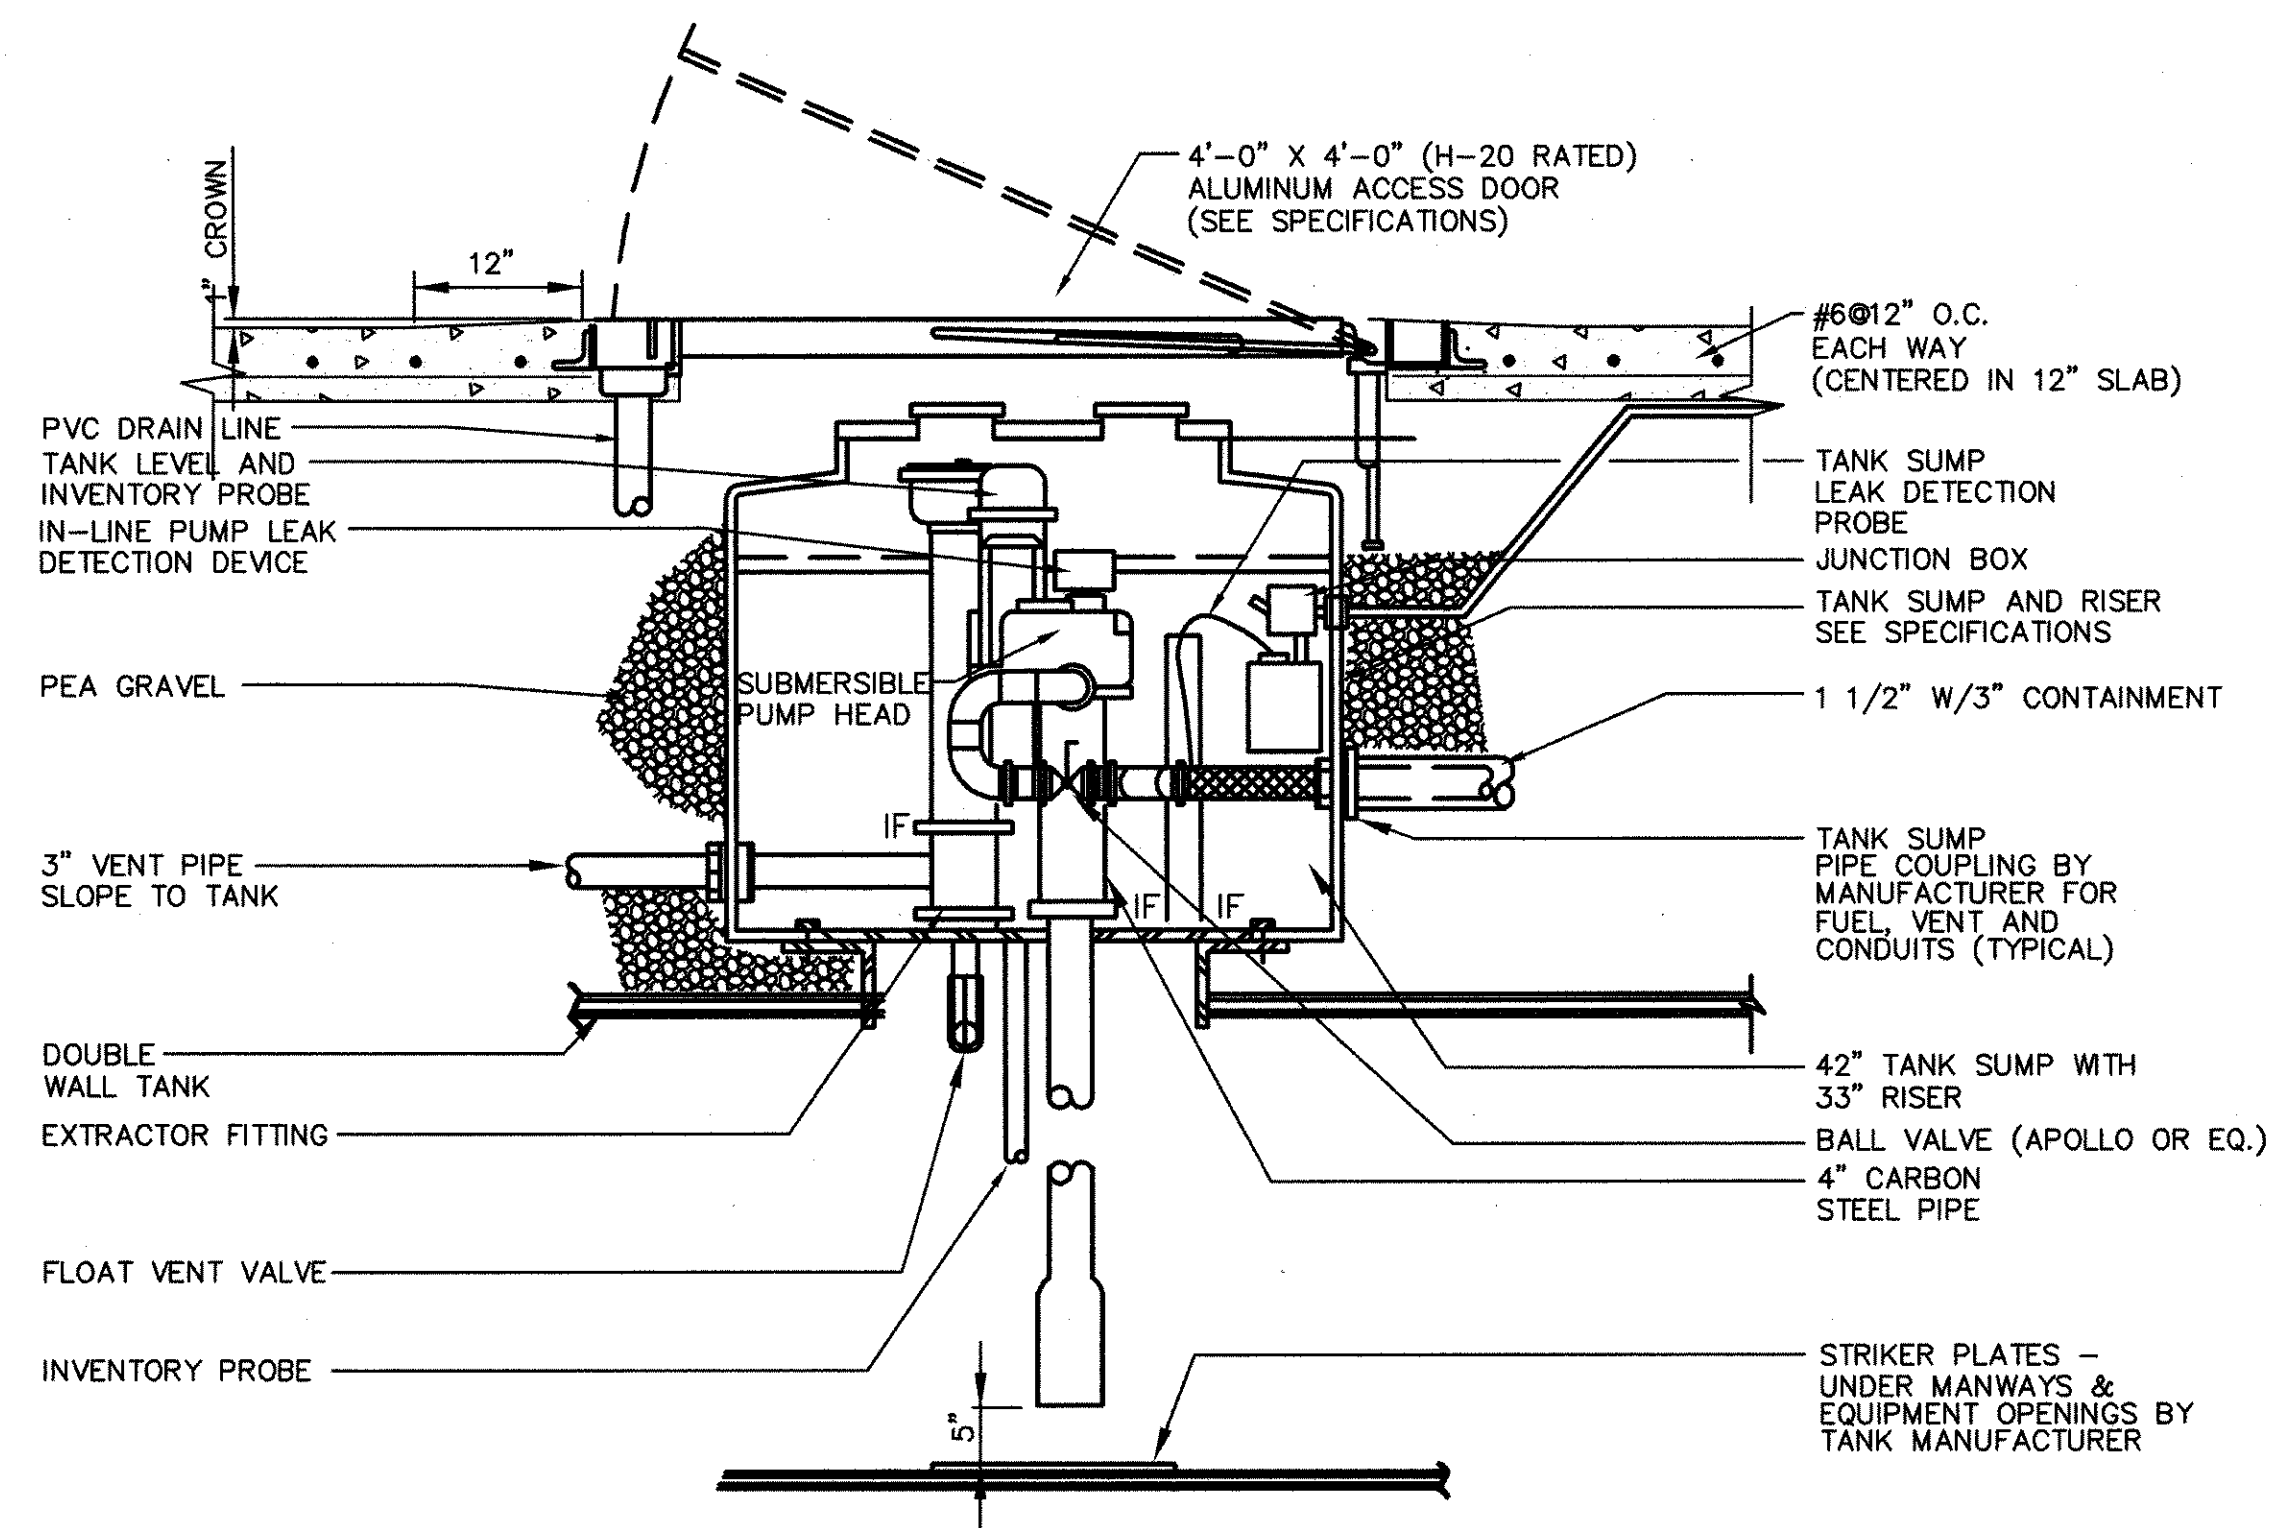


NOTE: MOGAS AND DIESEL SIMILAR. DIESEL DOES NOT REQUIRE VAPOR RECOVERY SYSTEM. SEE M12.02 FOR ADDITIONAL PIPING NOT SHOWN IN THIS DETAIL.

TANK SUMP AND RISER DETAIL 1
N.T.S. TYP.

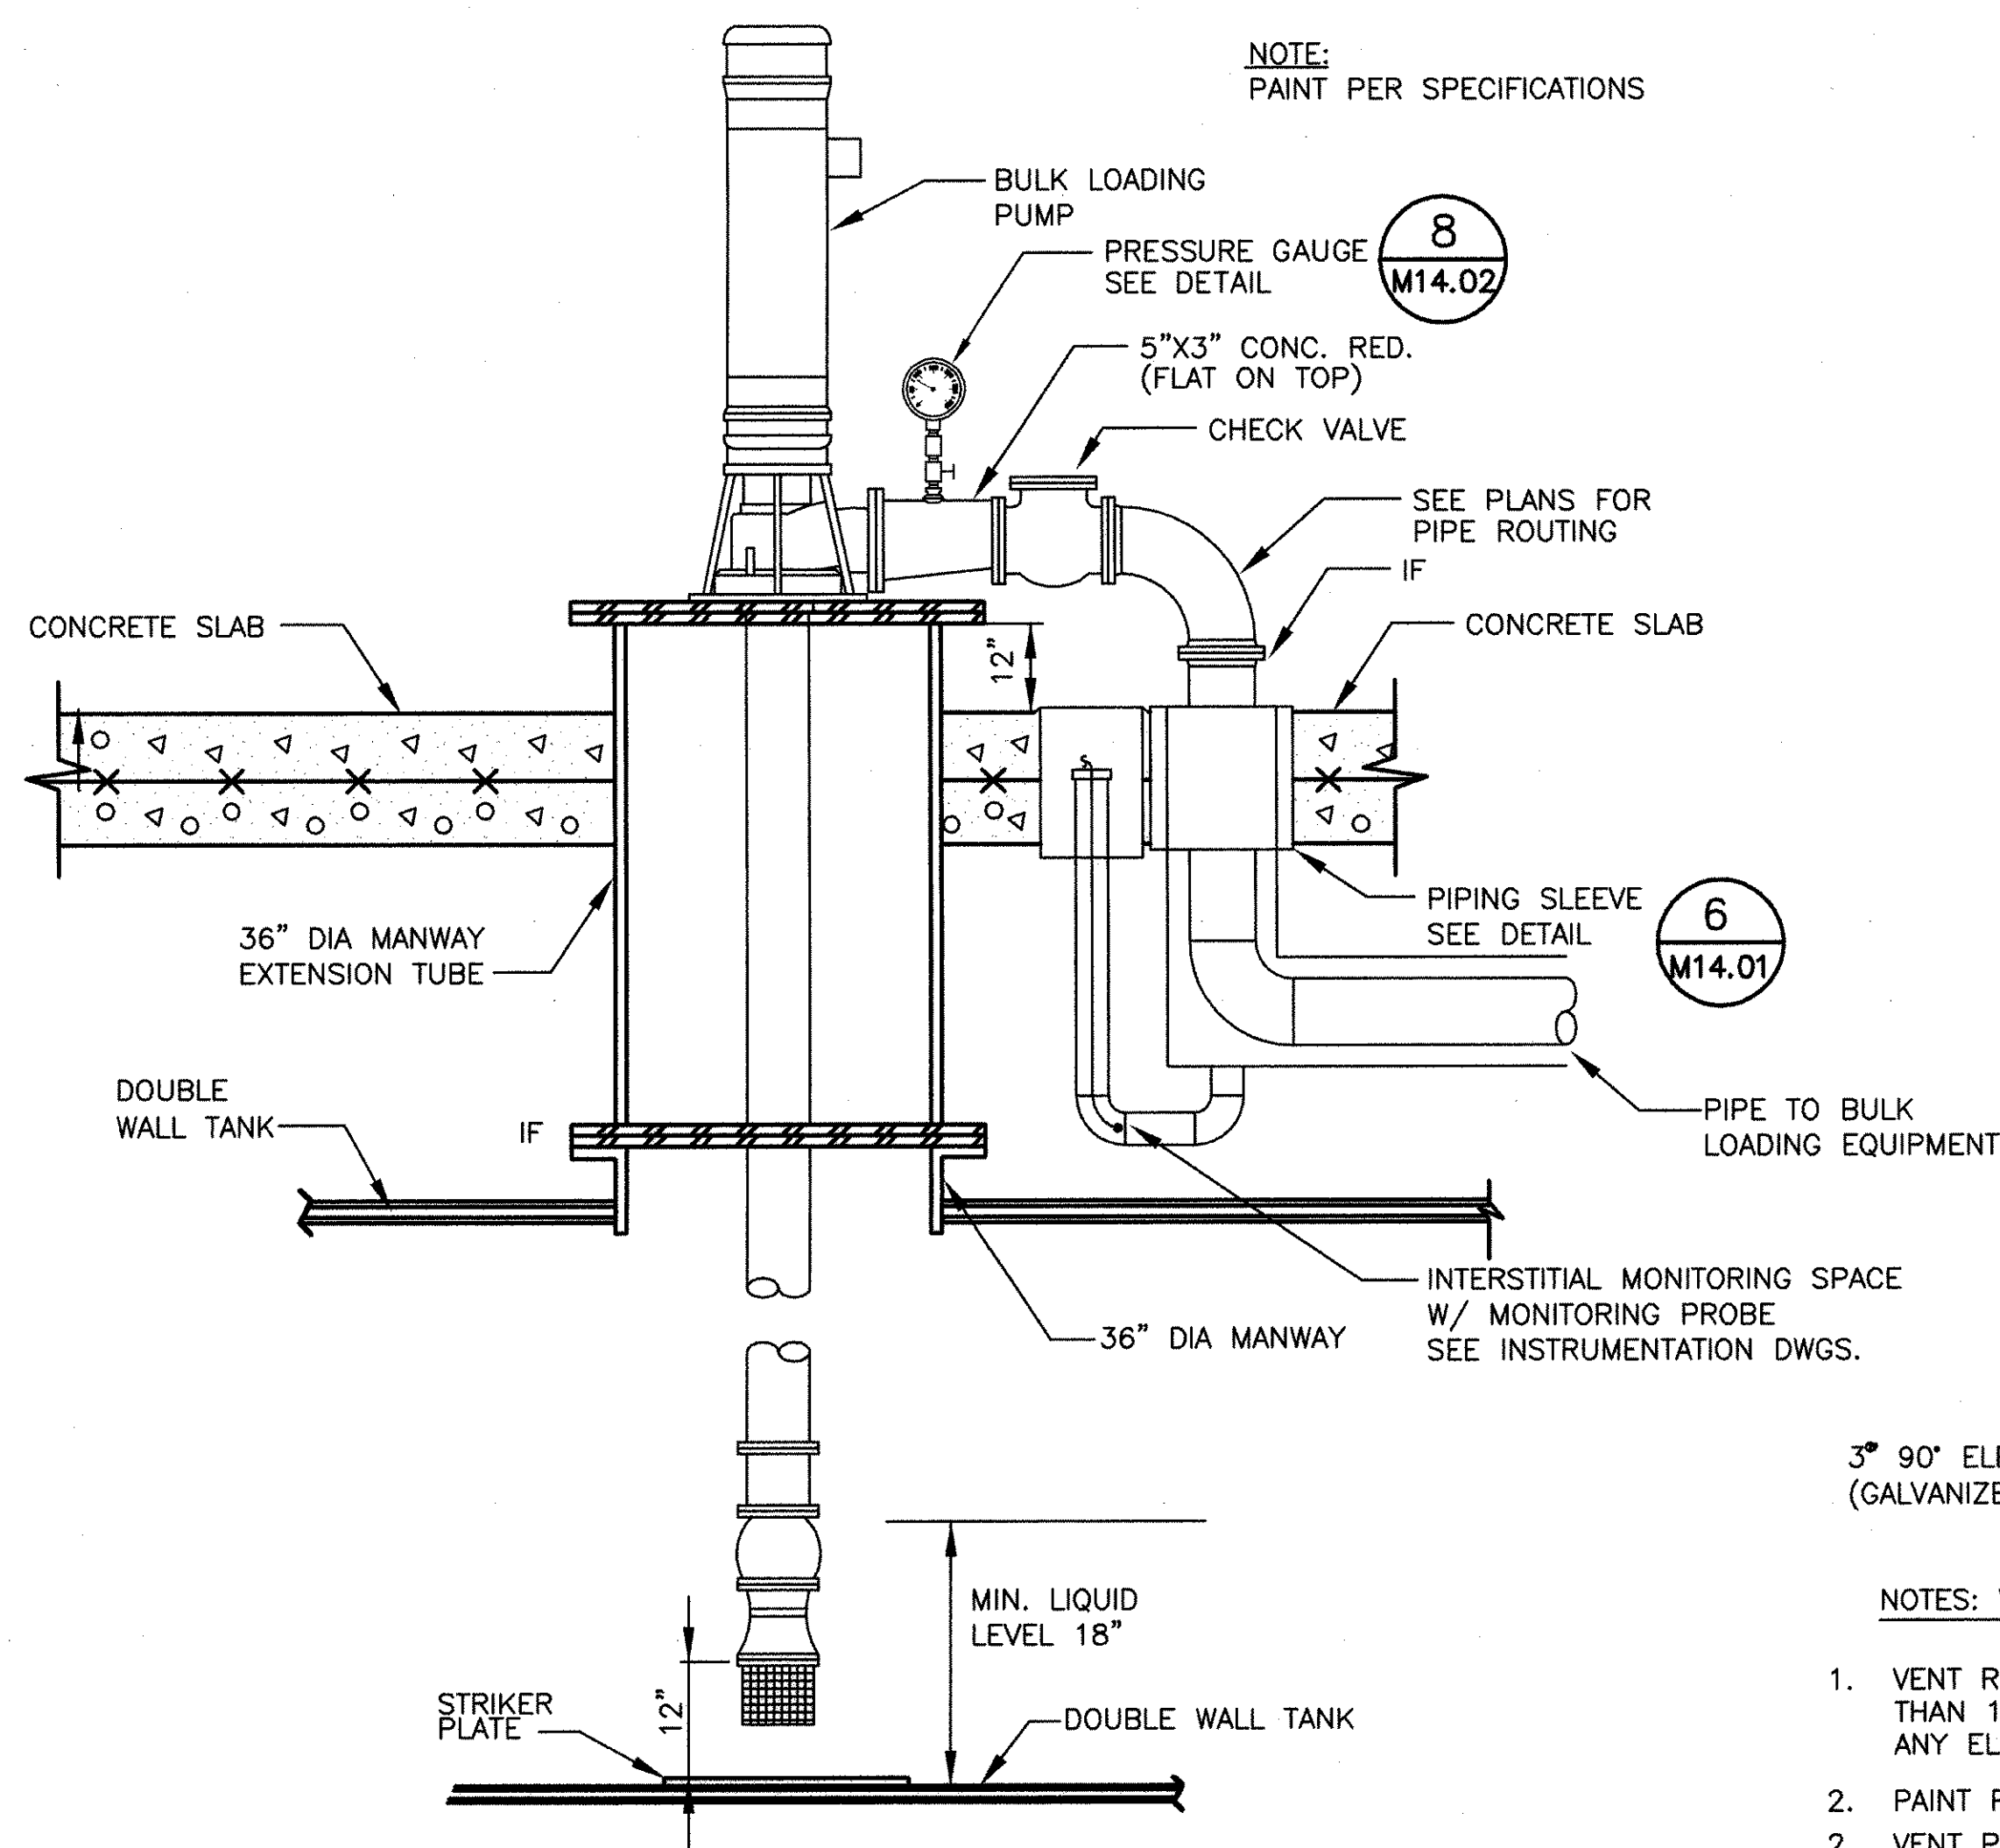

NOTE: PAINT PER SPECIFICATIONS

BULK PUMP DETAIL 2
N.T.S. TYP.

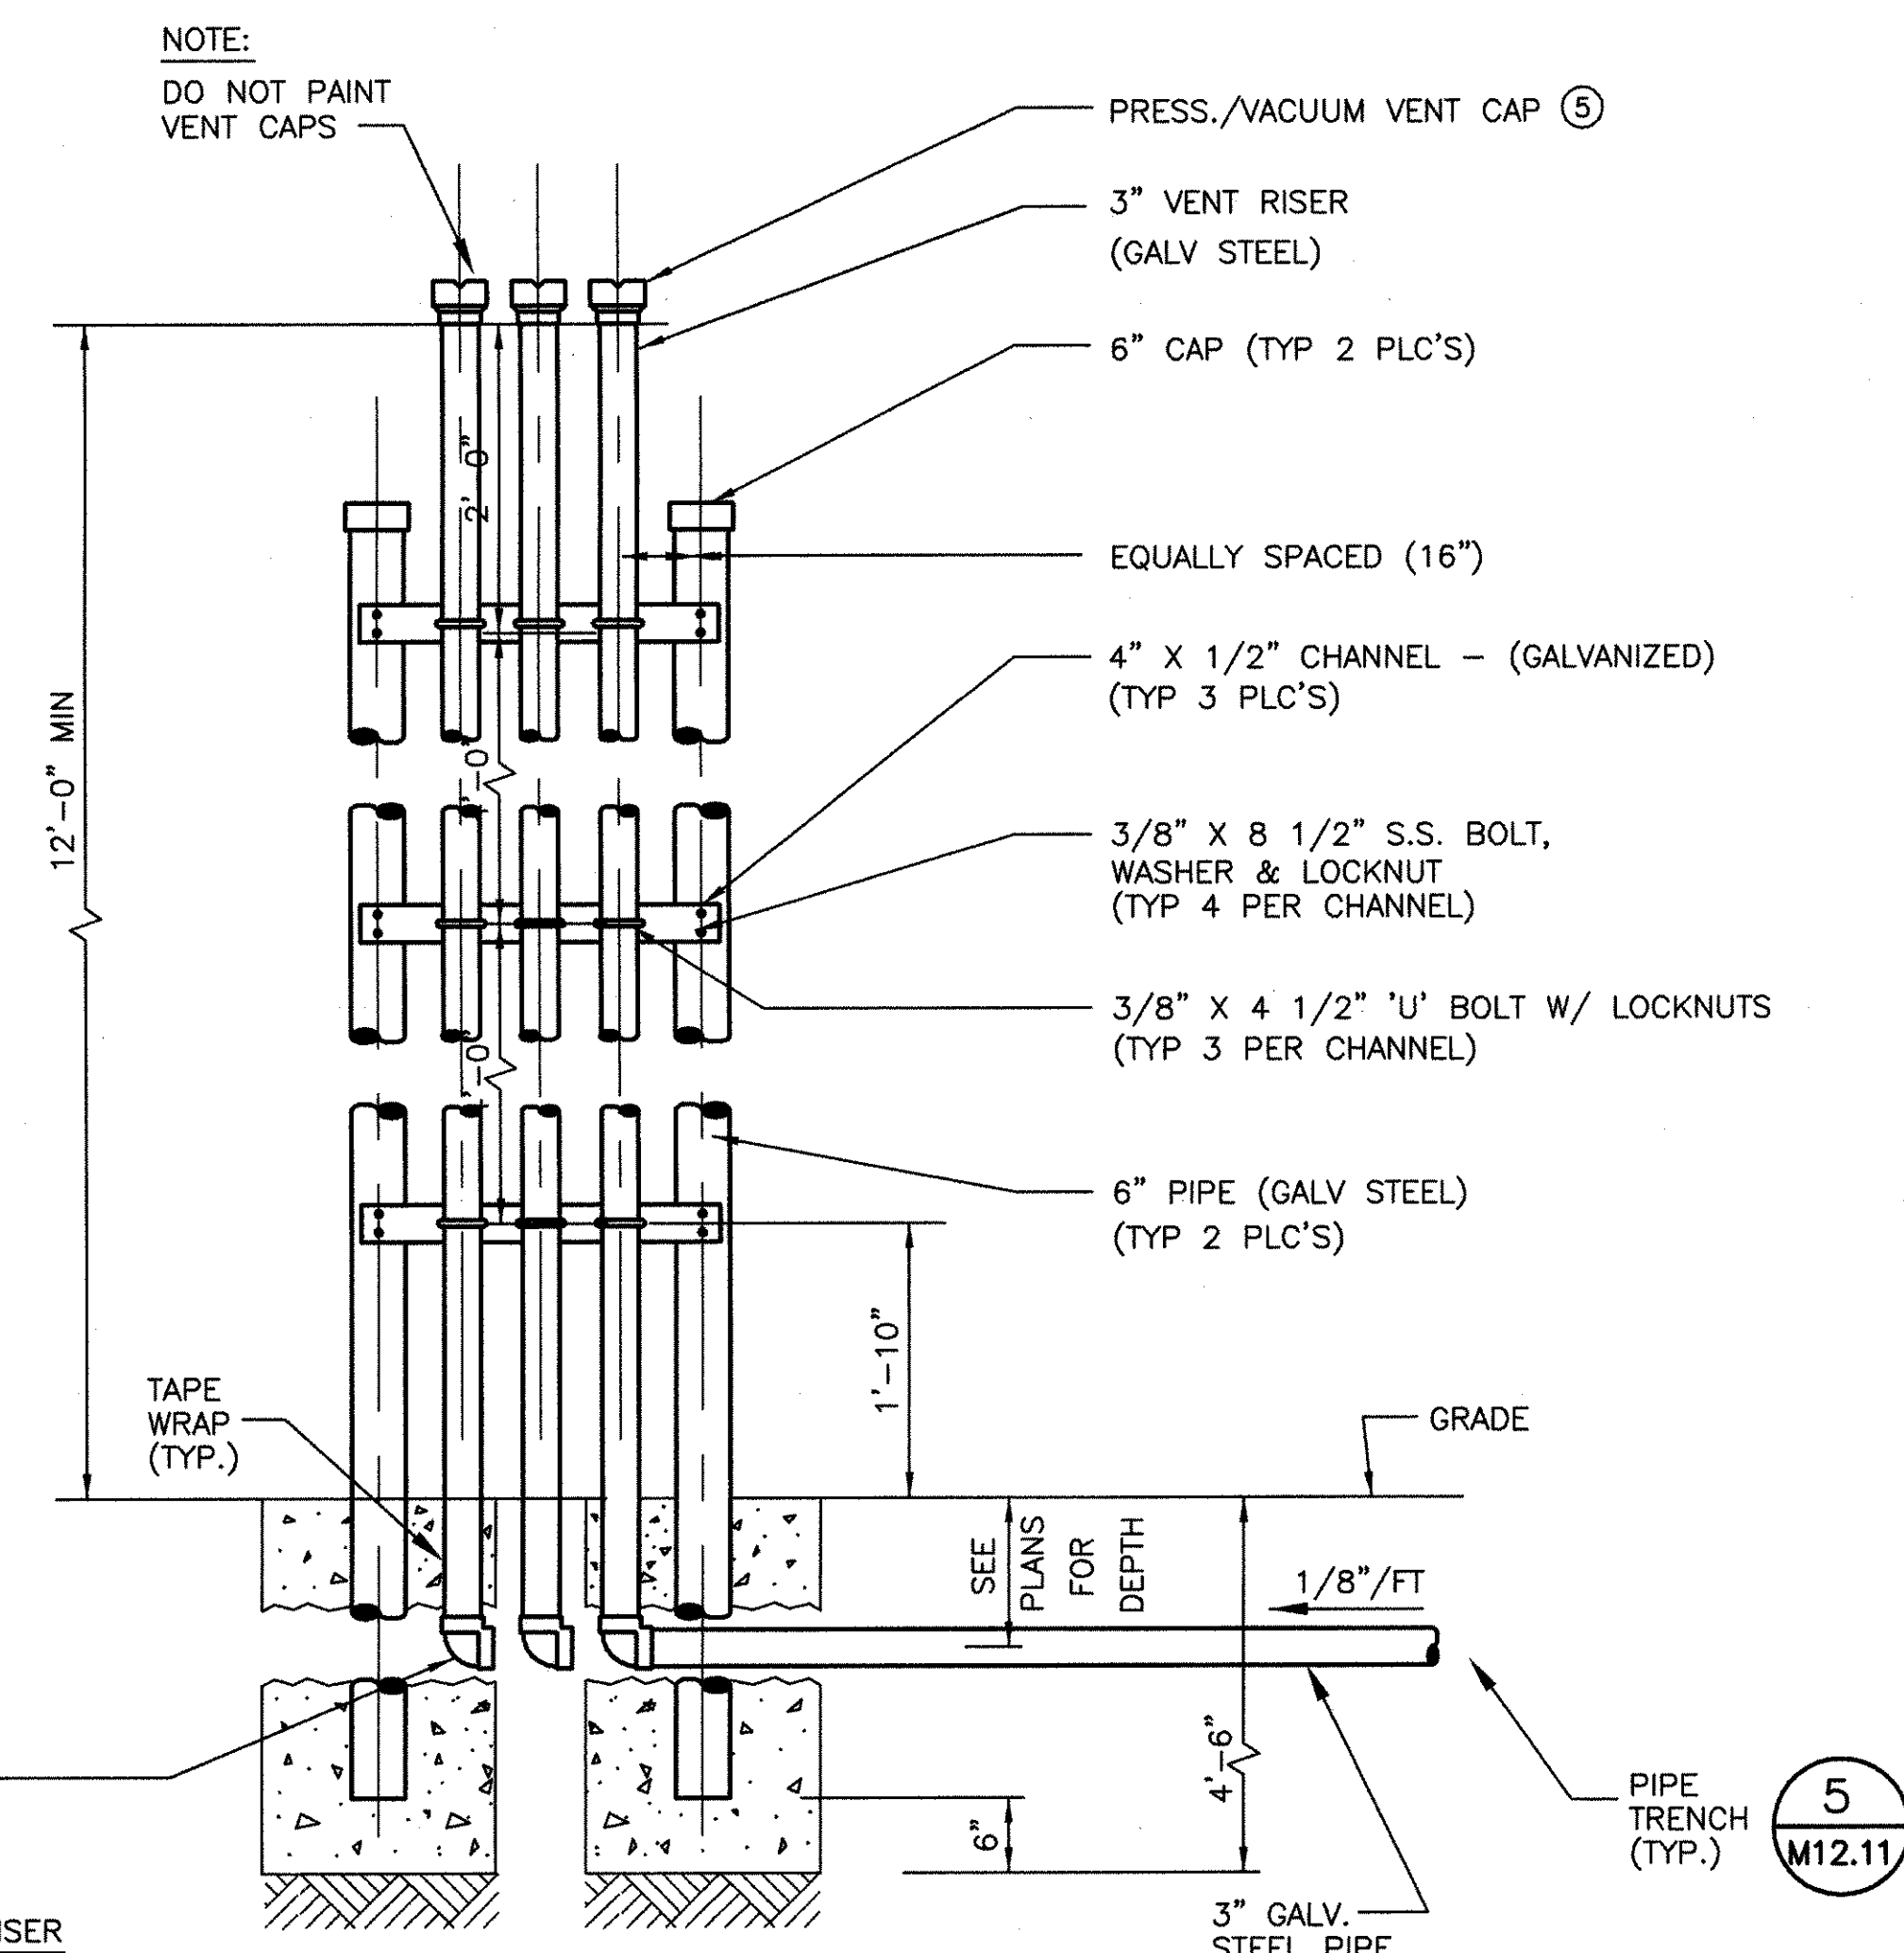


NOTES: VENT RISER


1. VENT RISERS SHALL TERMINATE NOT LESS THAN 10'-0" MEASURED HORIZONTALLY FROM ANY ELECTRICAL CONNECTION.
2. PAINT PER SPECIFICATIONS.
3. VENT PIPING FOR OIL/WATER SEPARATOR INSTALLED ABOVEGROUND.

VENT RISER DETAIL 3
N.T.S.

M12.01
M12.09

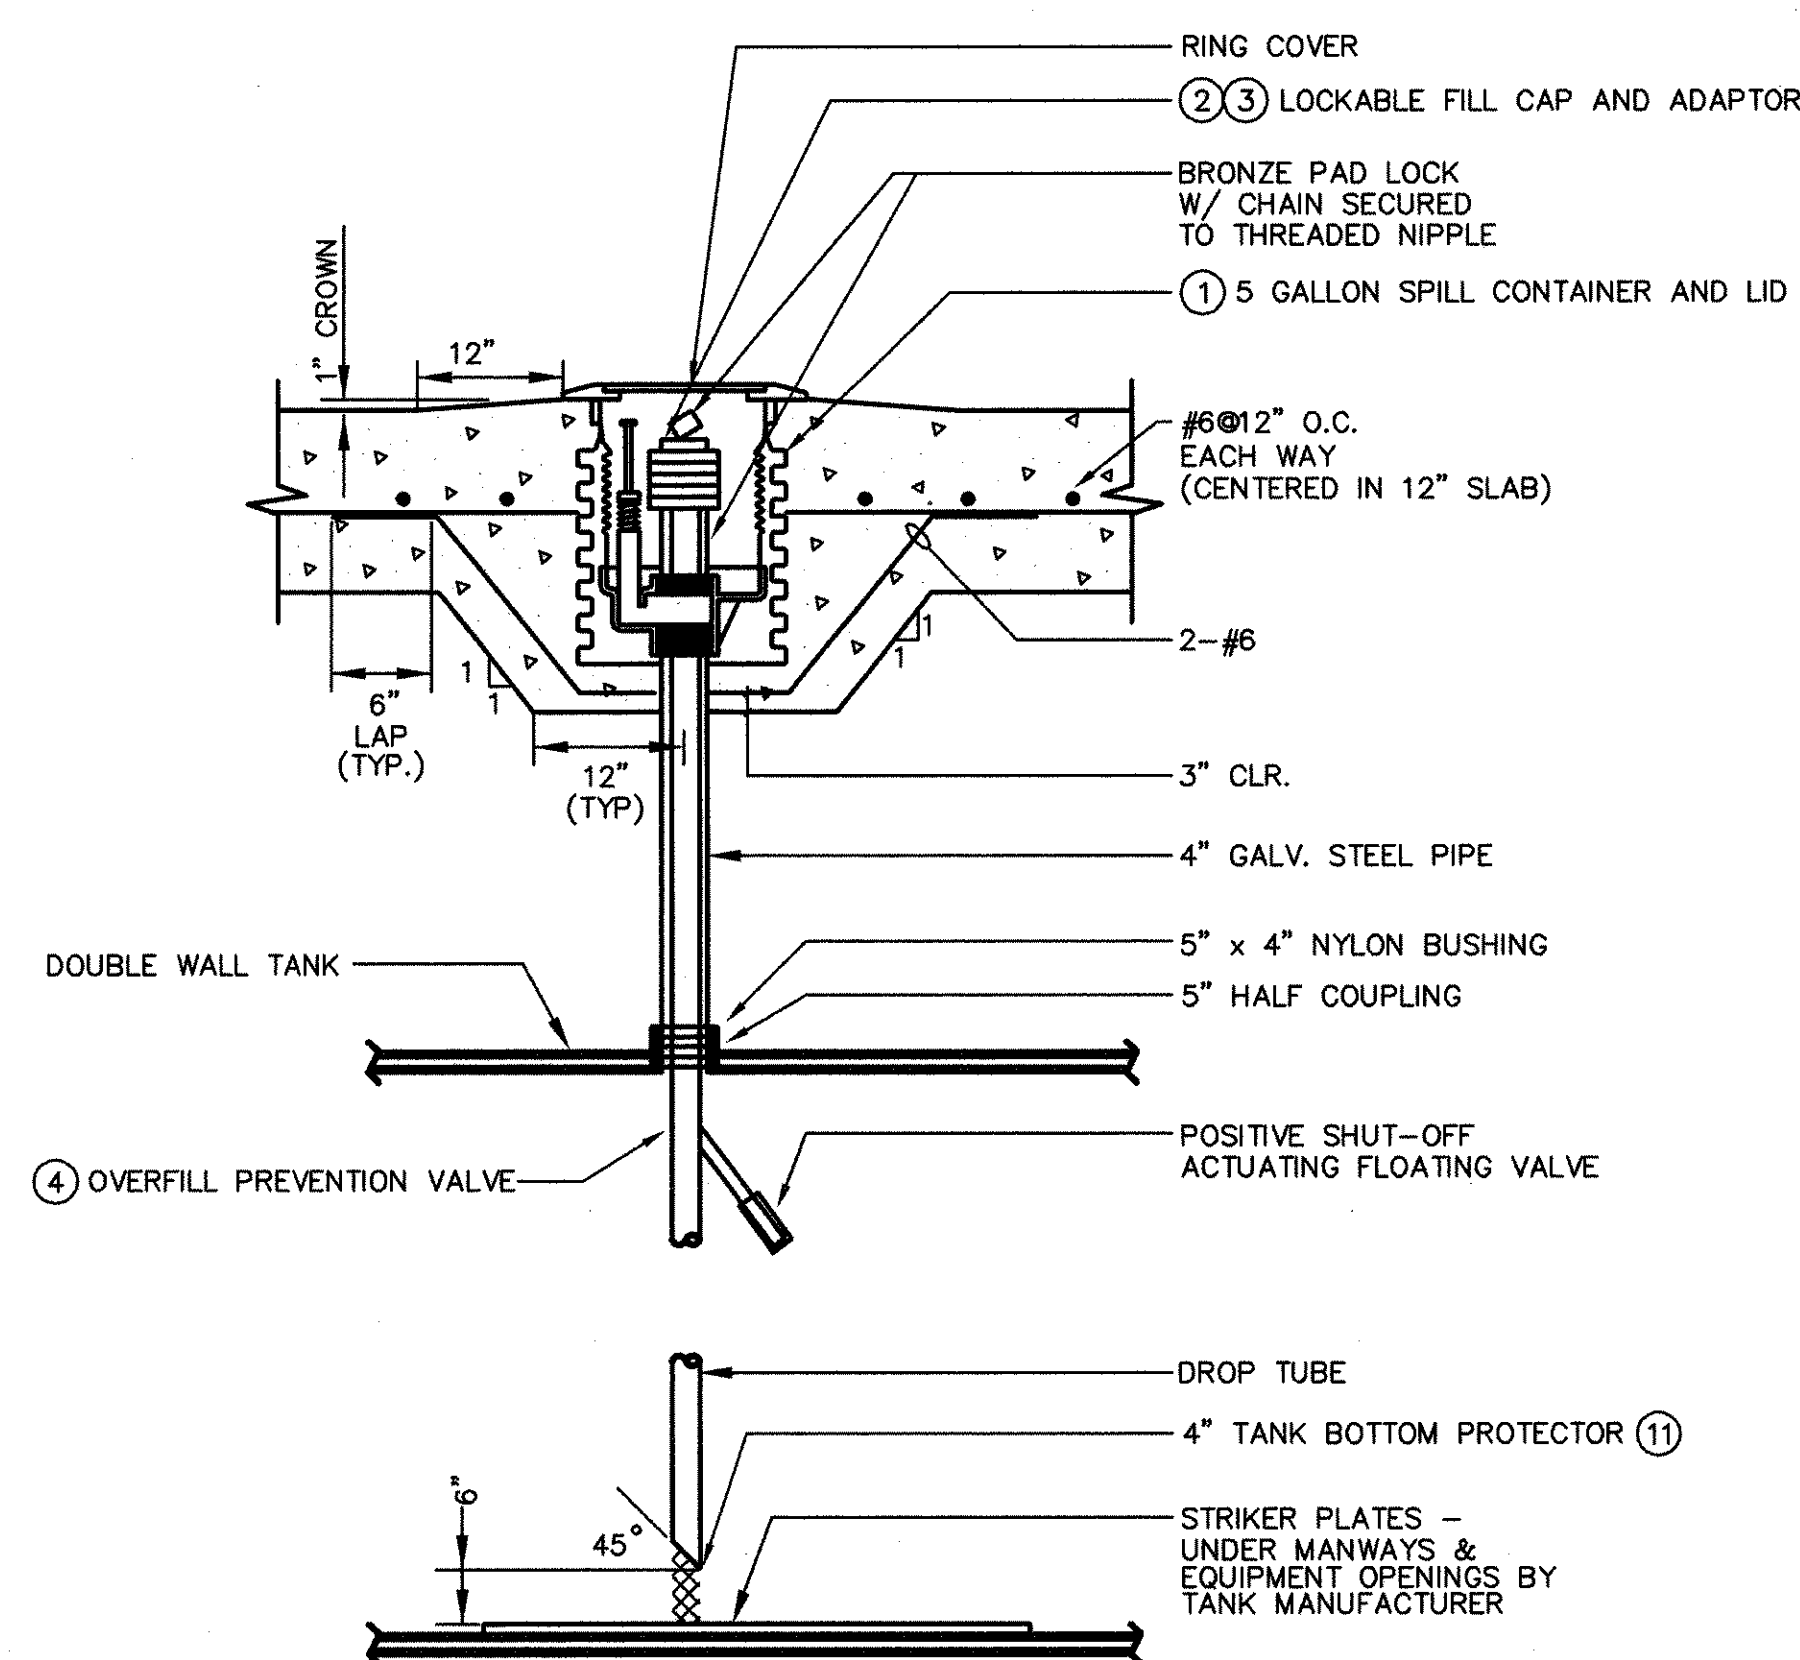

TANK FILL DETAIL 4
N.T.S. TYP.

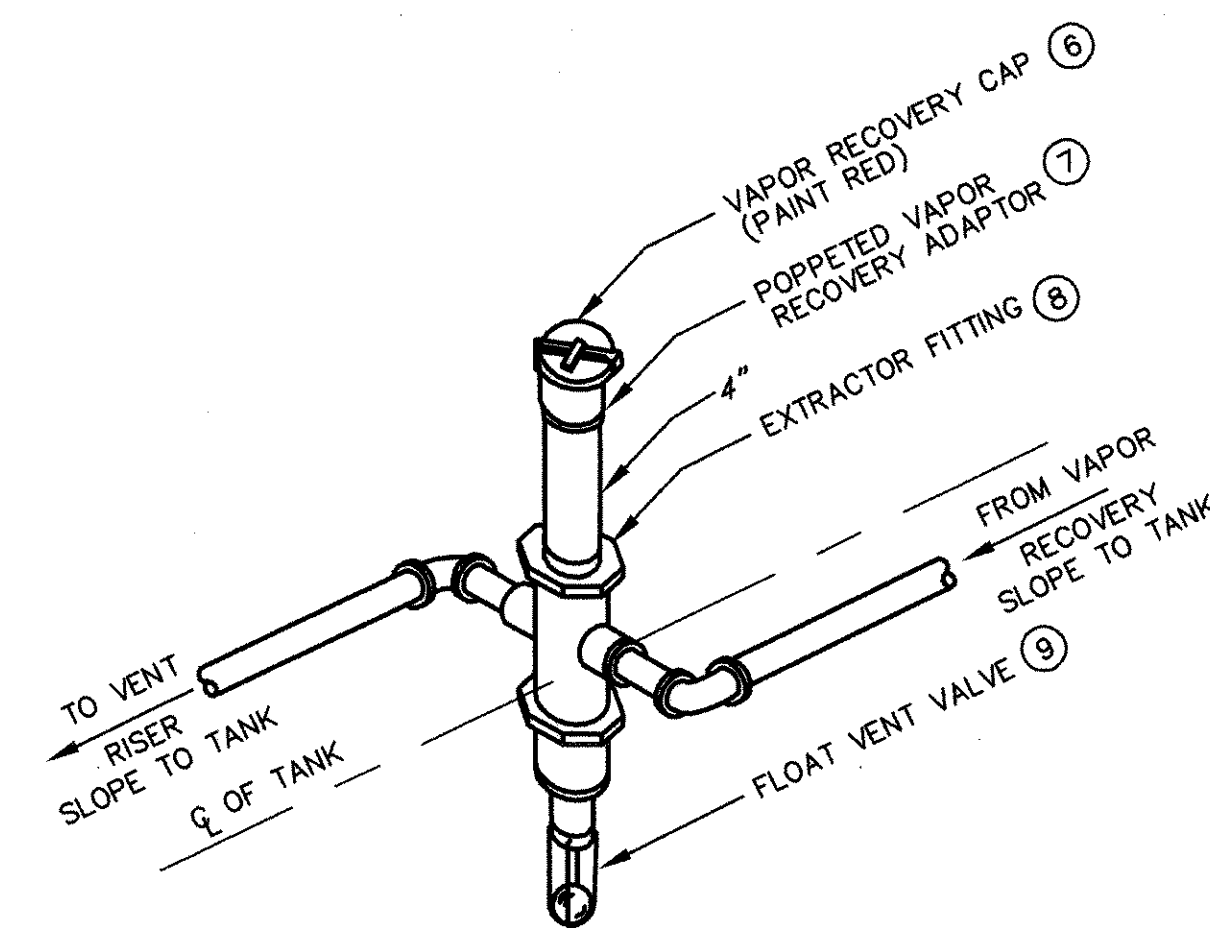

VENT AND VAPOR PIPING DETAIL 5
N.T.S. M12.12

EQUIPMENT LIST

DESCRIPTION	PART NUMBER
1 SPILL CONTAINER AND LID	OPW-1
2 4" FILL CAP (PADLOCKED)	OPW-634-TT-7085
3 TOP SEAL ADAPTOR	OPW-633-T
4 OVERFILL PREVENTION VALVE	OPW-61-50
5 2" PRESSURE/VACUUM VAPOR VENT	OPW-523
6 4" VAPOR RECOVERY CAP	OPW-1711-T
7 4" VAPOR RECOVERY ADAPTOR	OPW-1611-AV
8 4" X 2" EXTRACTOR FITTING	OPW-233-V
9 SERIES FLOAT VENT	OPW-53-V
10 4" DROP TUBE	OPW-61-T-7368
11 4" TANK BOTTOM PROTECTOR	OPW-61-TP
12 9" ROUND MANHOLE WITH LOCKABLE OPW 126-B CAP AND OPW MANHOLE WRENCH	OPW-126-007
13 18" DIAMETER MANHOLE	OPW-104-MW-001B
14 SERIES EMERGENCY SHUT-OFF VALVE WITH OPW-10-S STABILIZER	OPW-10-R

NOTE: CONTRACTOR SHALL PROVIDE EQUIPMENT LISTED ABOVE OR APPROVED EQUAL.

FOR REFERENCE ONLY

AS CONSTRUCTED PLANS
I hereby certify that all construction required by this sheet has been accomplished as indicated

URS Greiner Woodward Clyde, Inc.
BY: [Signature] DATE: 1/6/02

REV. NO.	DATE	DESCRIPTION	MADE BY	CHK. BY	APPD. BY
AB	7/99	CONTRACTOR'S AS-BUILT CONDITIONS	DJM	DJM	RAH

MASSACHUSETTS PORT AUTHORITY
BOSTON, MASSACHUSETTS

BOSTON LOGAN INTERNATIONAL AIRPORT
EAST BOSTON, MASSACHUSETTS


AIRCRAFT FUELING SYSTEMS
SCHEDULE B - FUEL STORAGE FACILITY
REFUELER LOADING STATIONS - DETAILS

CONSULTANT AND SUBCONSULTANT:
GREINER INC. TAMPA, FLORIDA
EDWARDS AND KELCEY INC. BOSTON, MASSACHUSETTS


DRAWN BY: CGH CHKD. BY: RAH DWG. NO.: M12.12
SCALE: NONE APPROVED: RAH DATE: 2/97

MPA CONTRACT NO.: MPA 1.646C (R) SHEET NO. 59 OF 100


AS BUILT

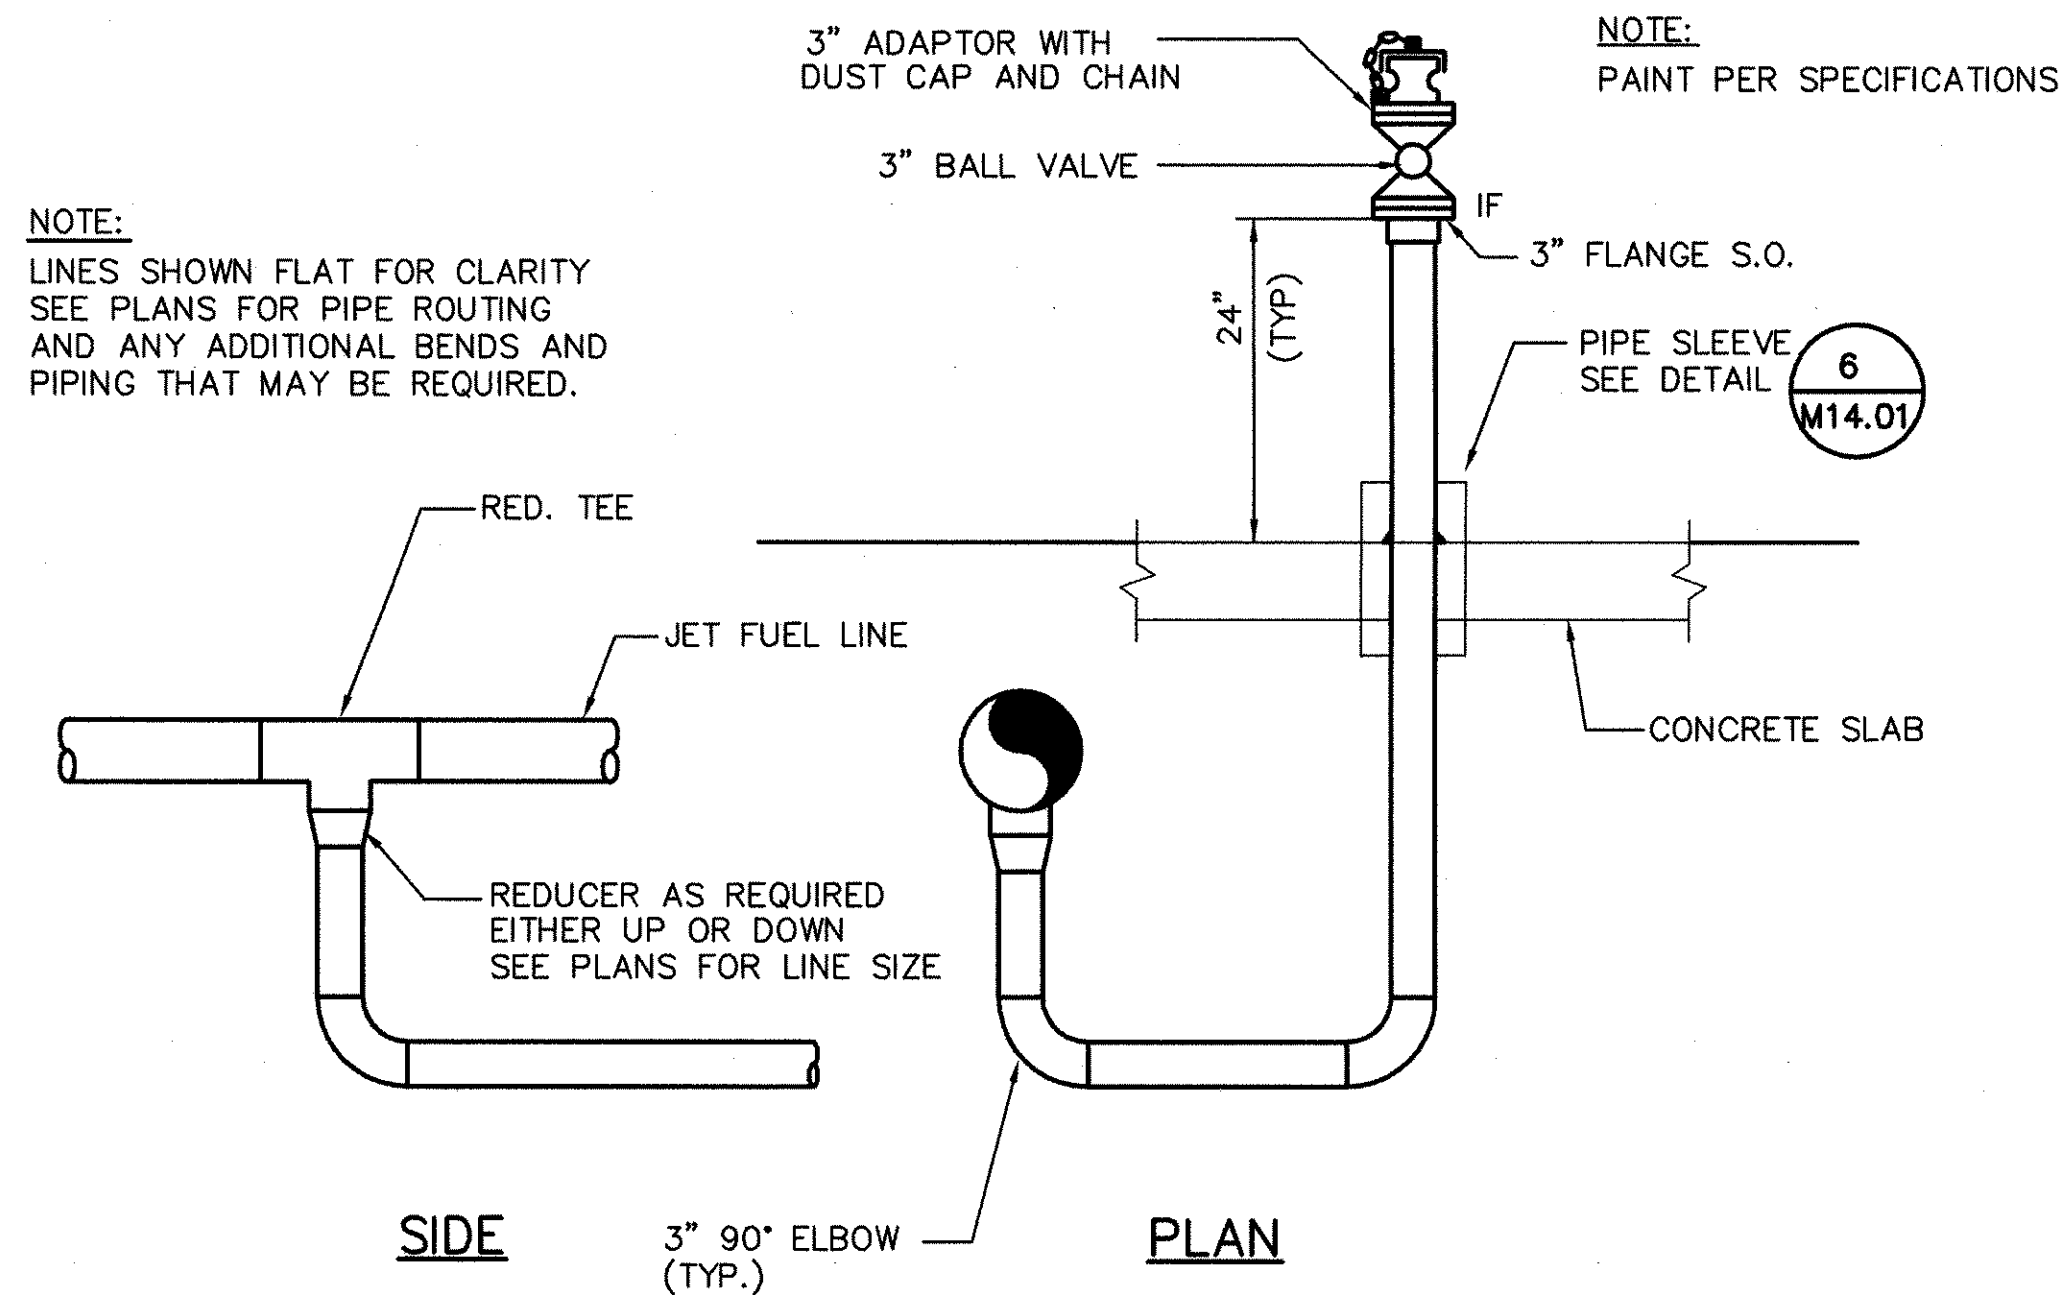


LINE SUMP DETAIL 1
N.T.S.
M10.01
M12.05
M12.06

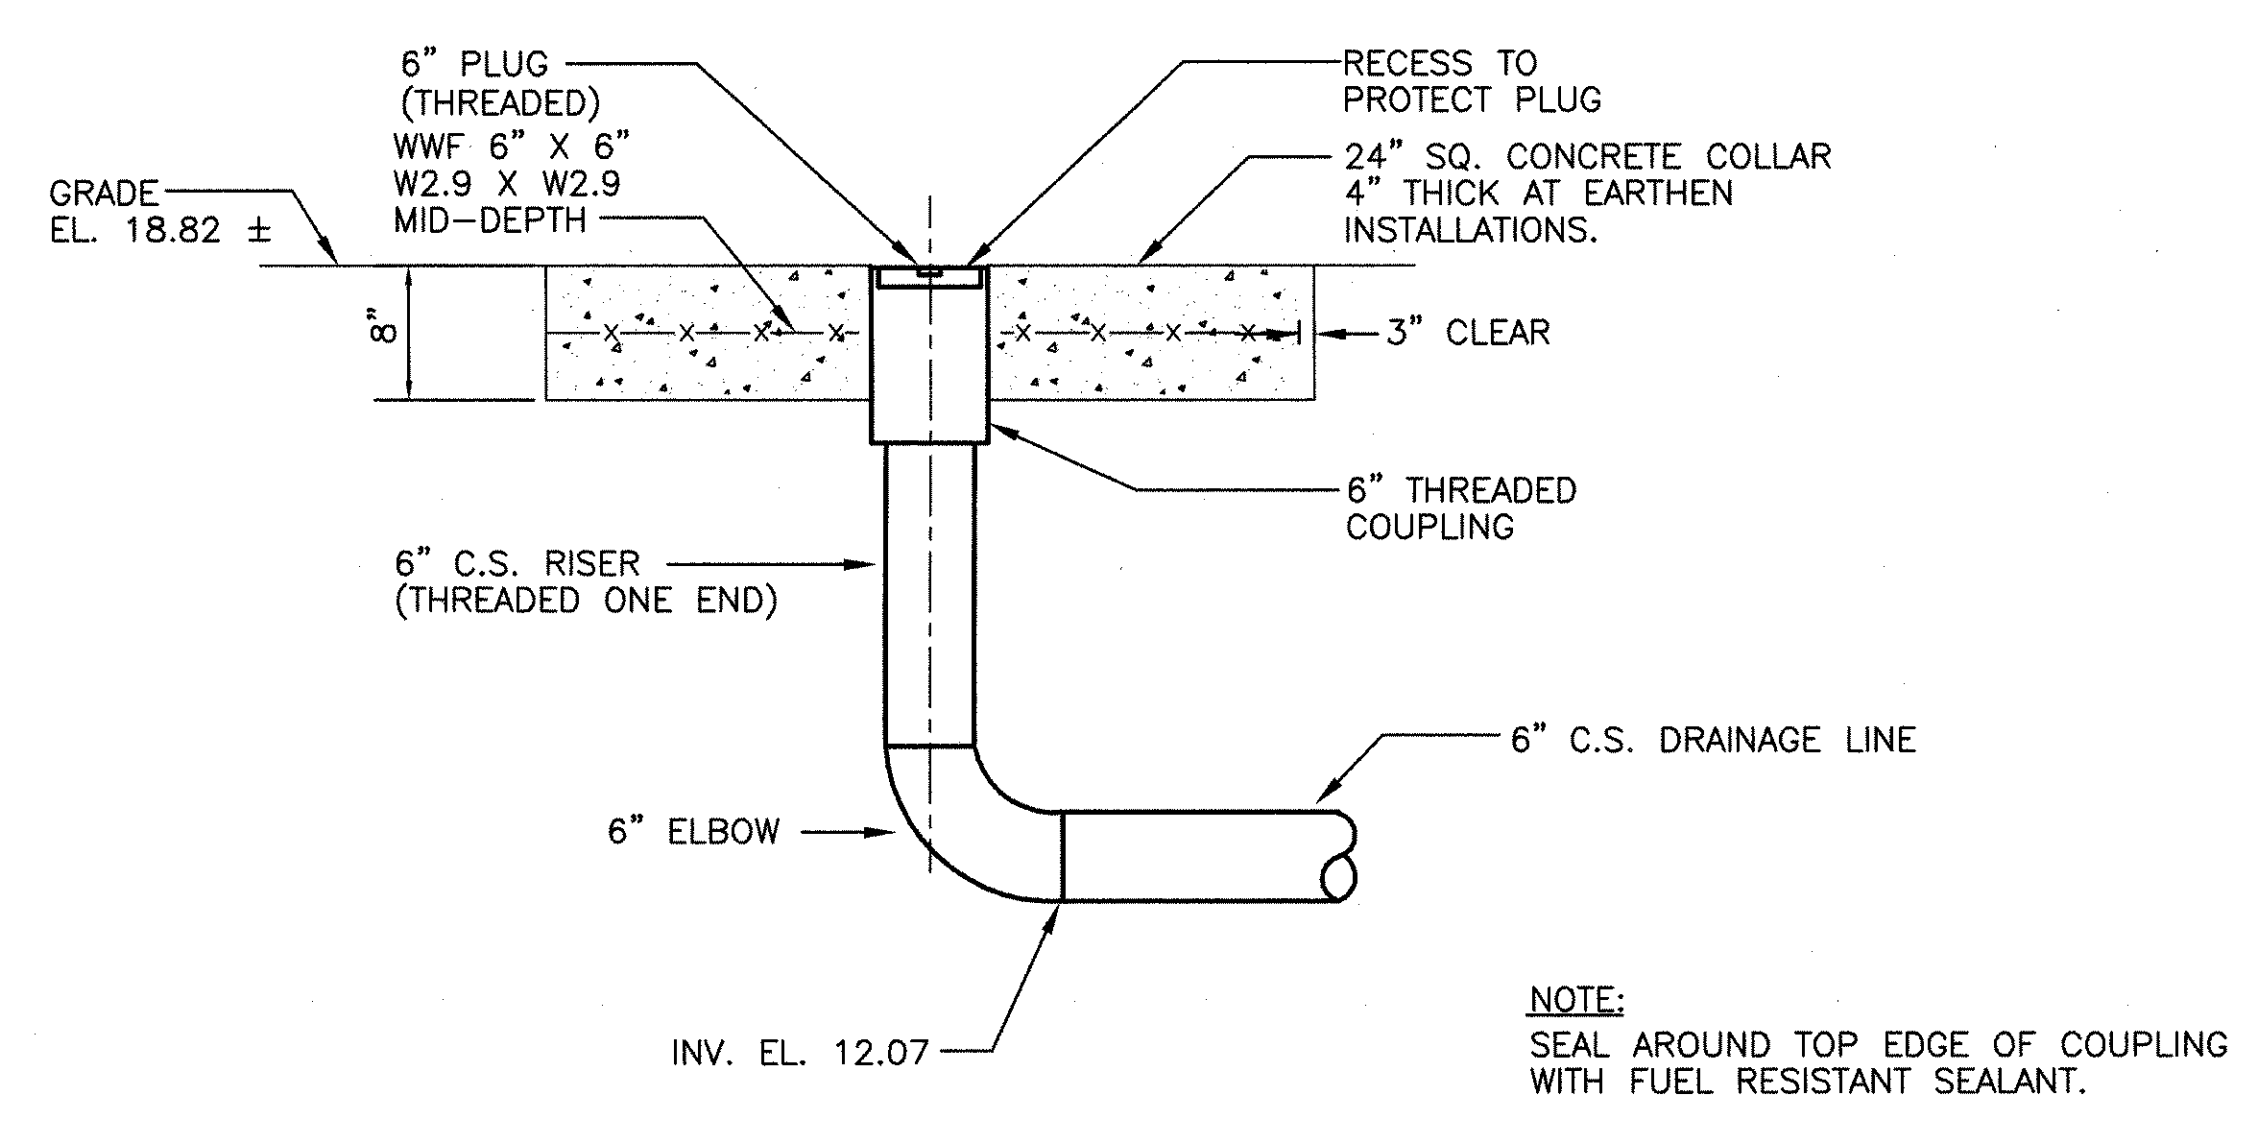


CLEAN OUT DETAIL 2
N.T.S.
TYP.

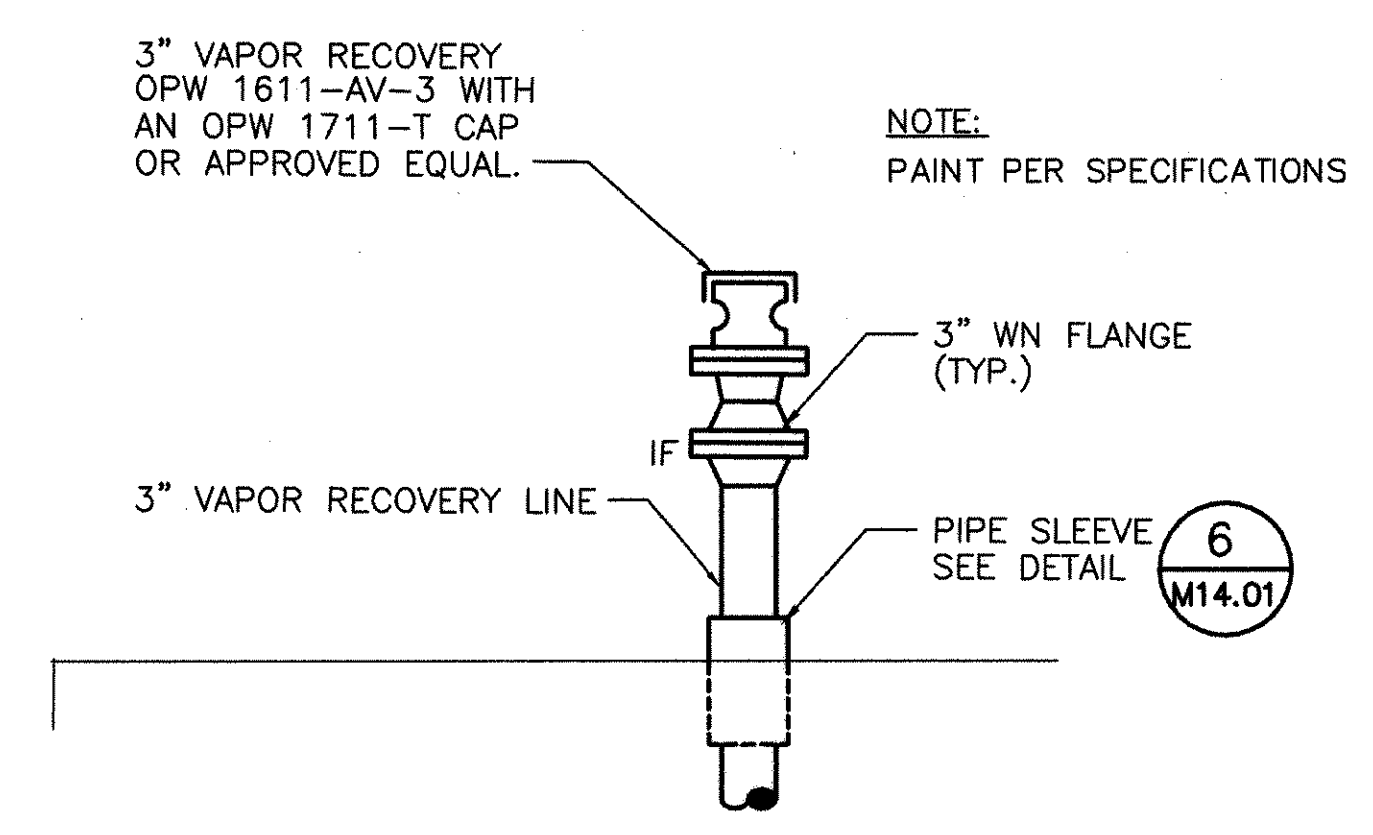


BULK VAPOR RECOVERY DETAIL 3
N.T.S.
M14.01

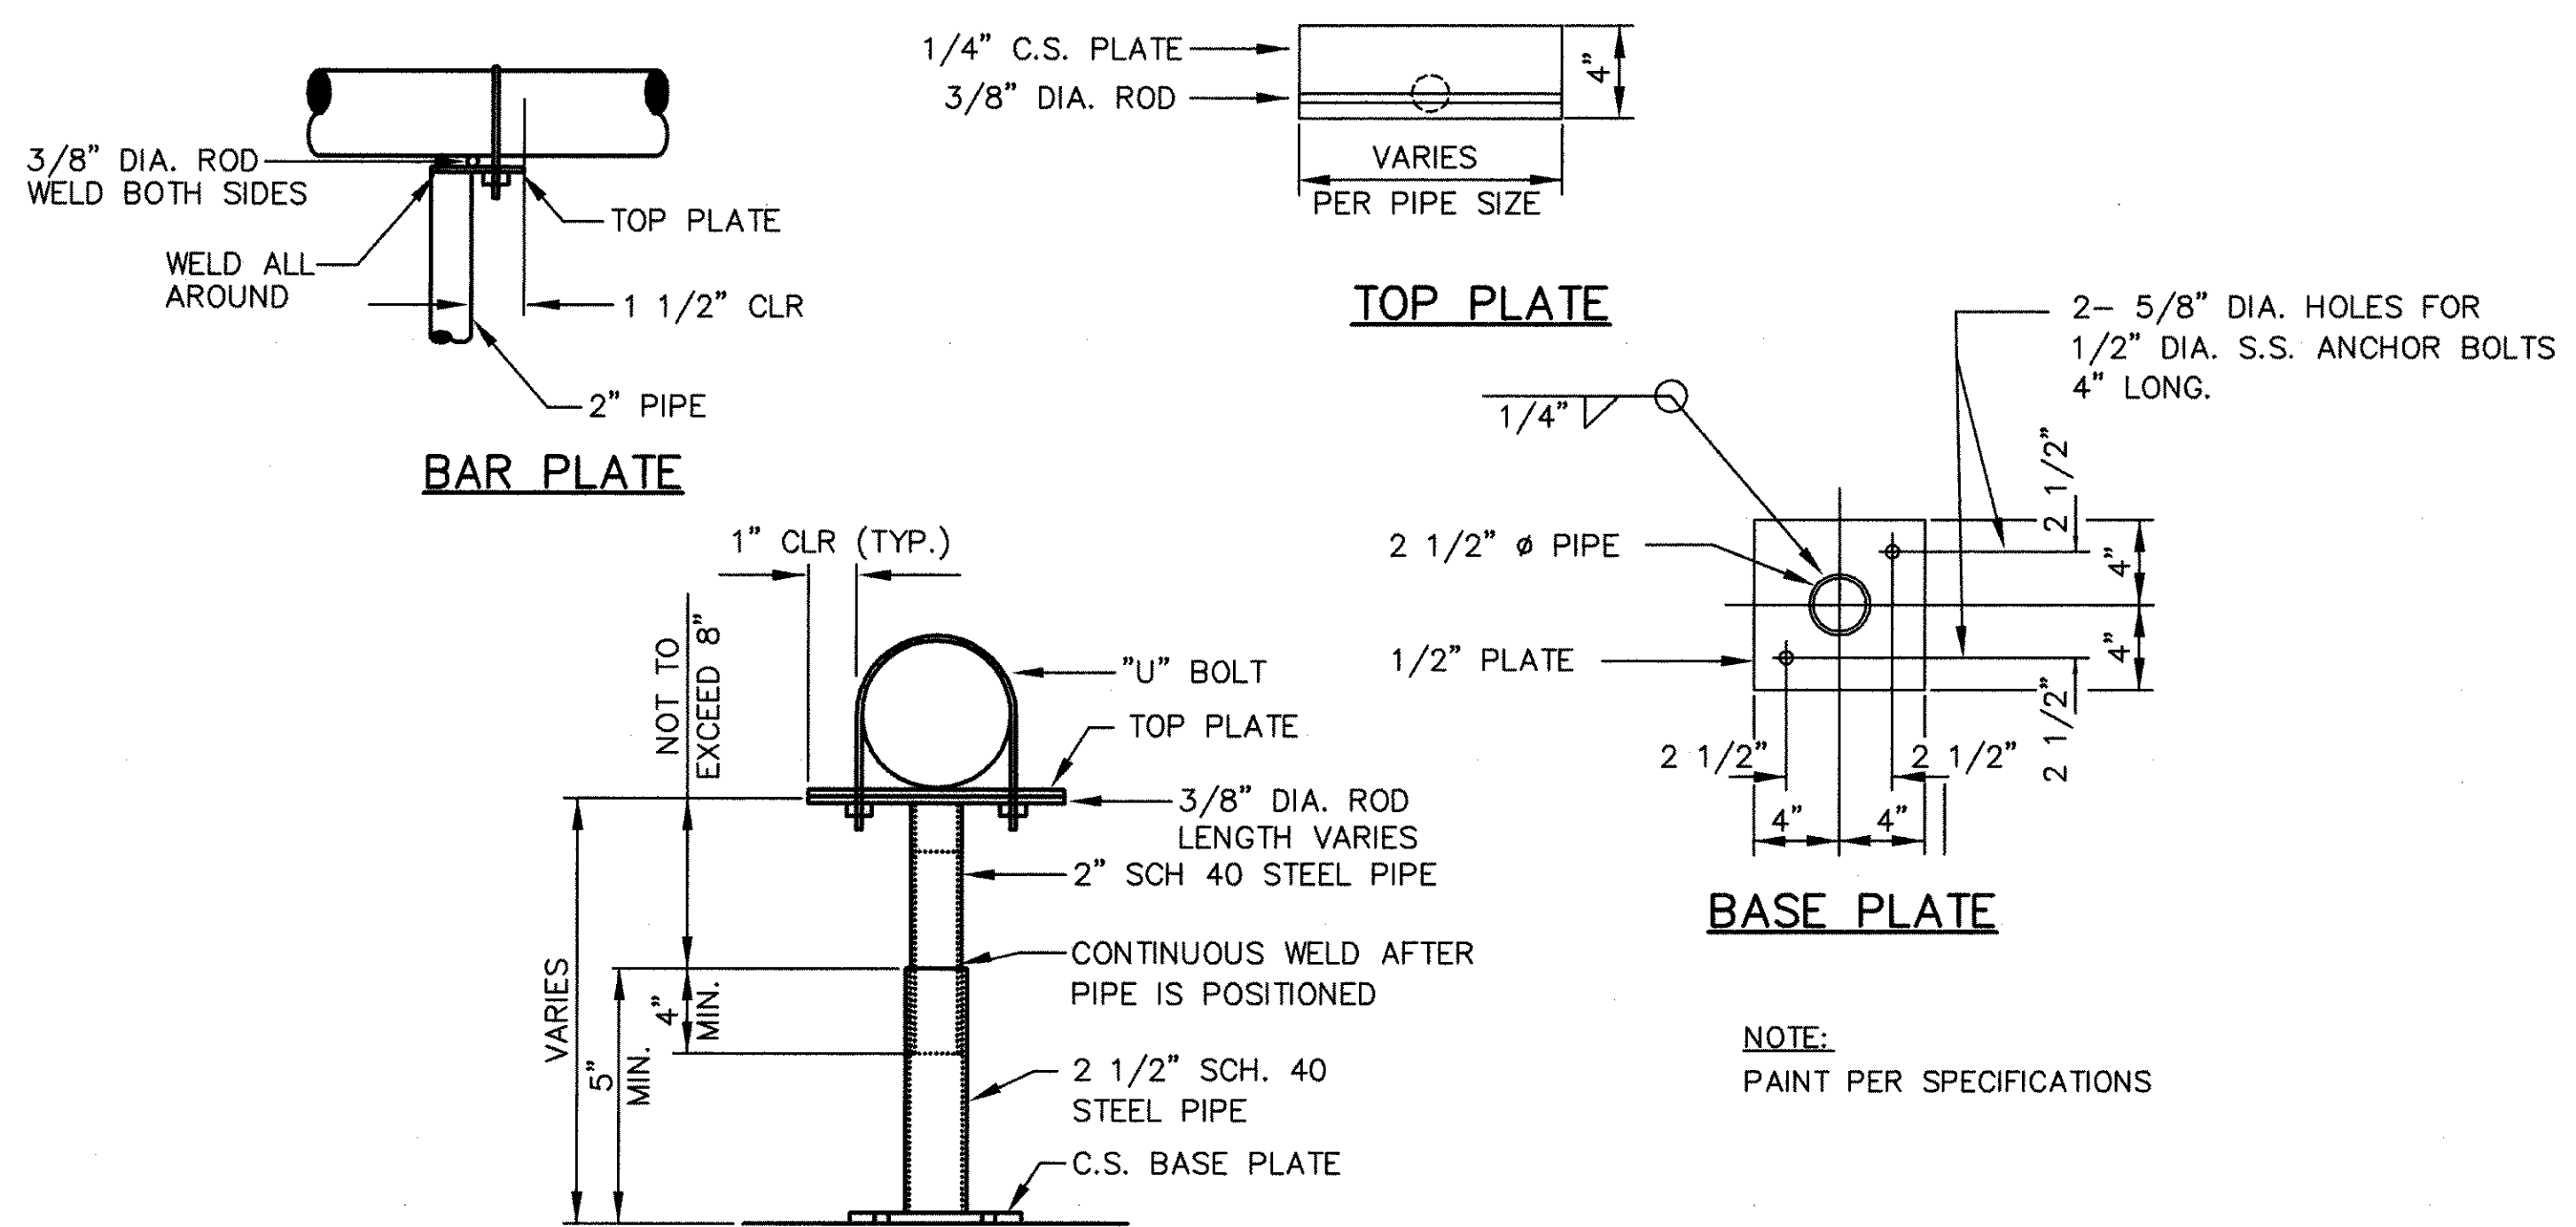


"U" BOLT PIPE SUPPORT DETAIL 4
N.T.S.
M12.13

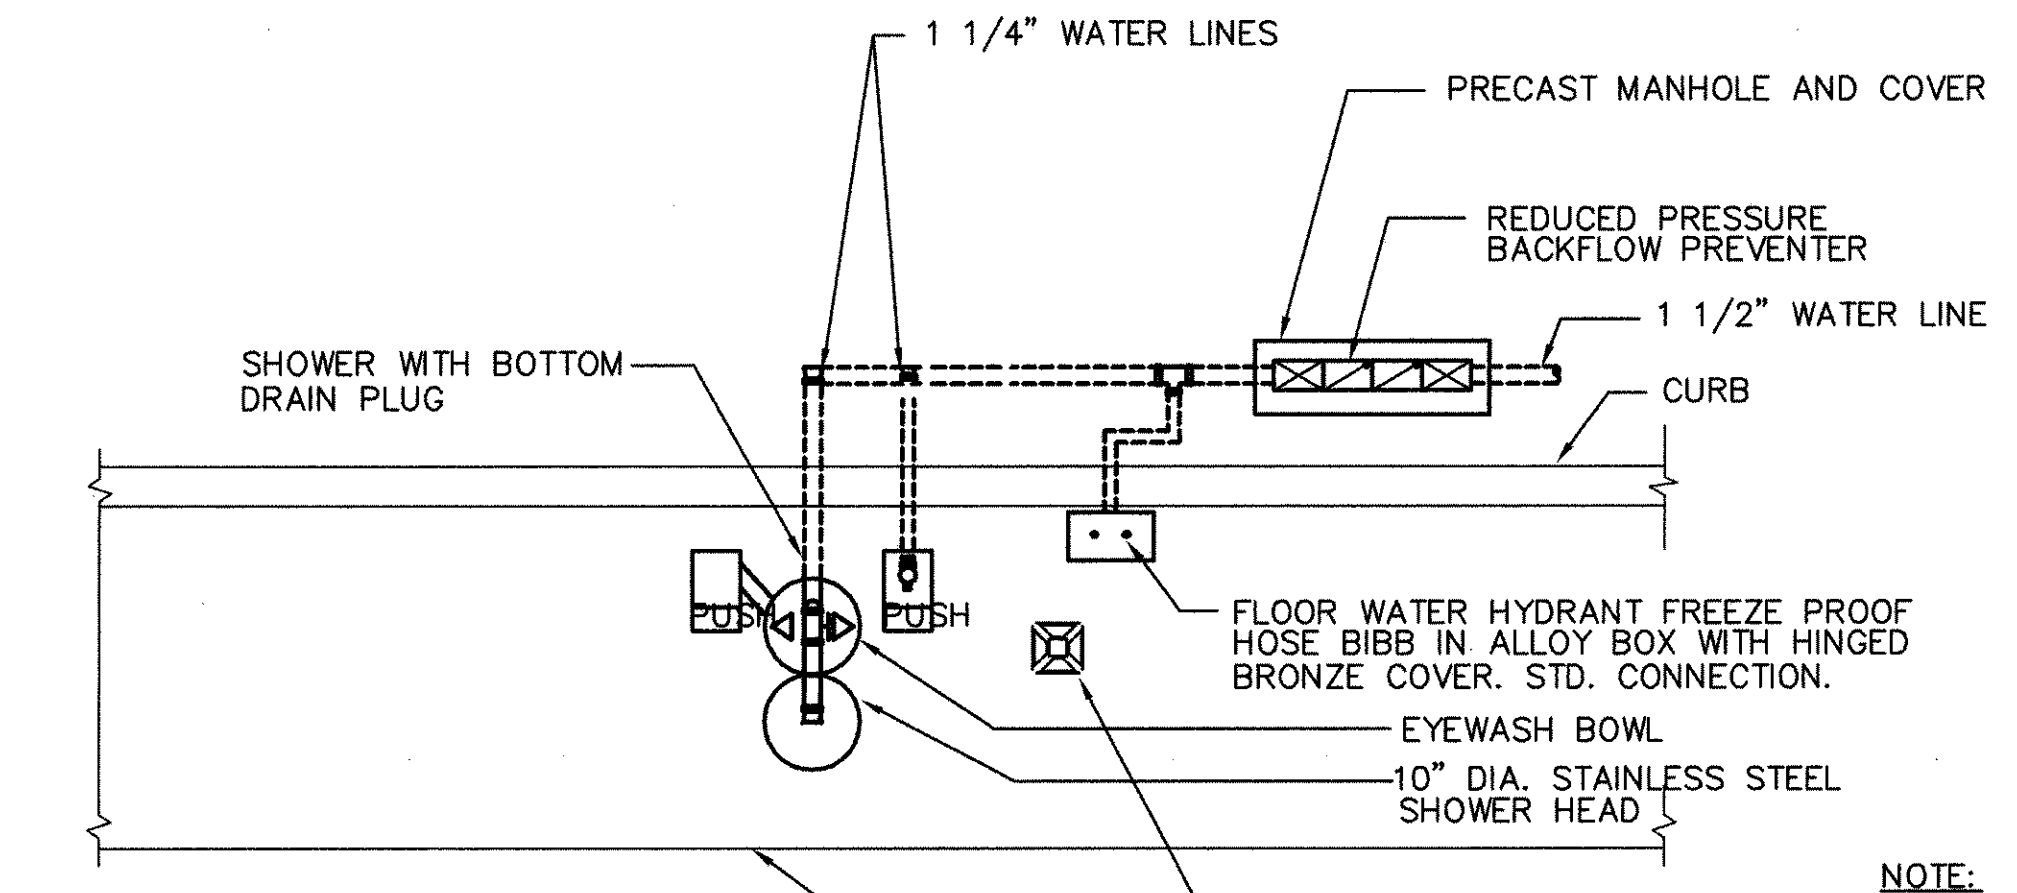

PLAN

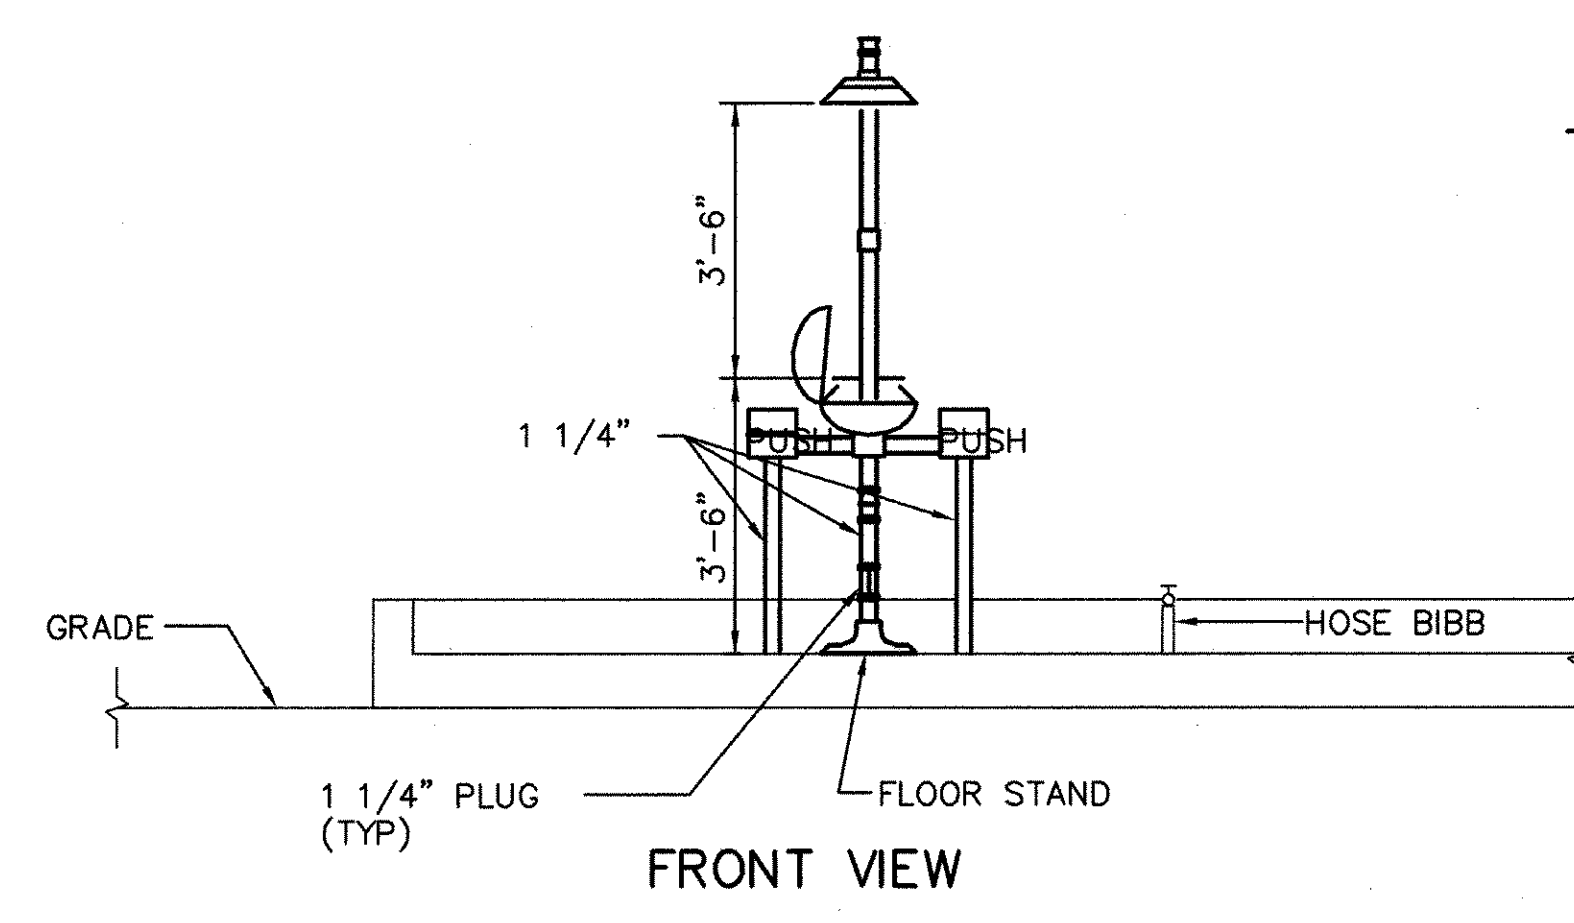


FRONT VIEW

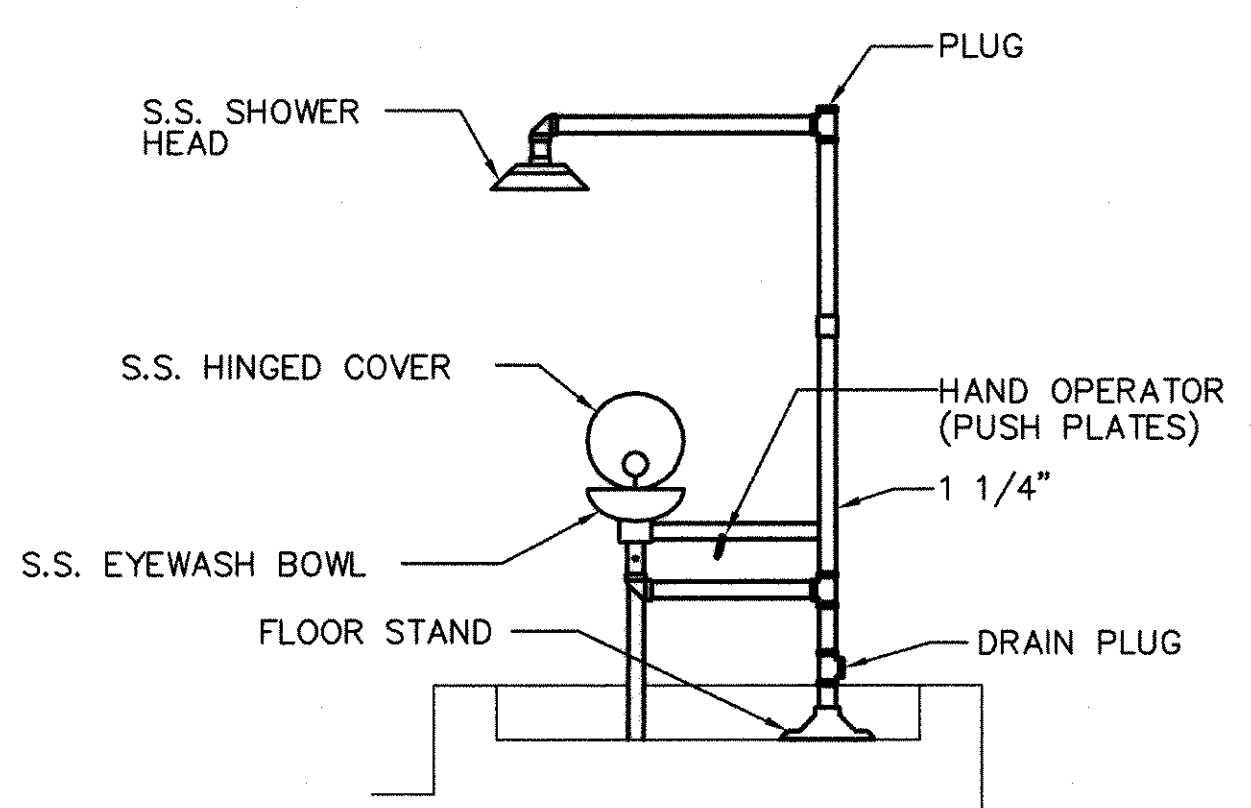


SIDE VIEW

EMERGENCY EYEWASH/SHOWER DETAIL (FREEZE PROOF)
N.T.S.
M12.02

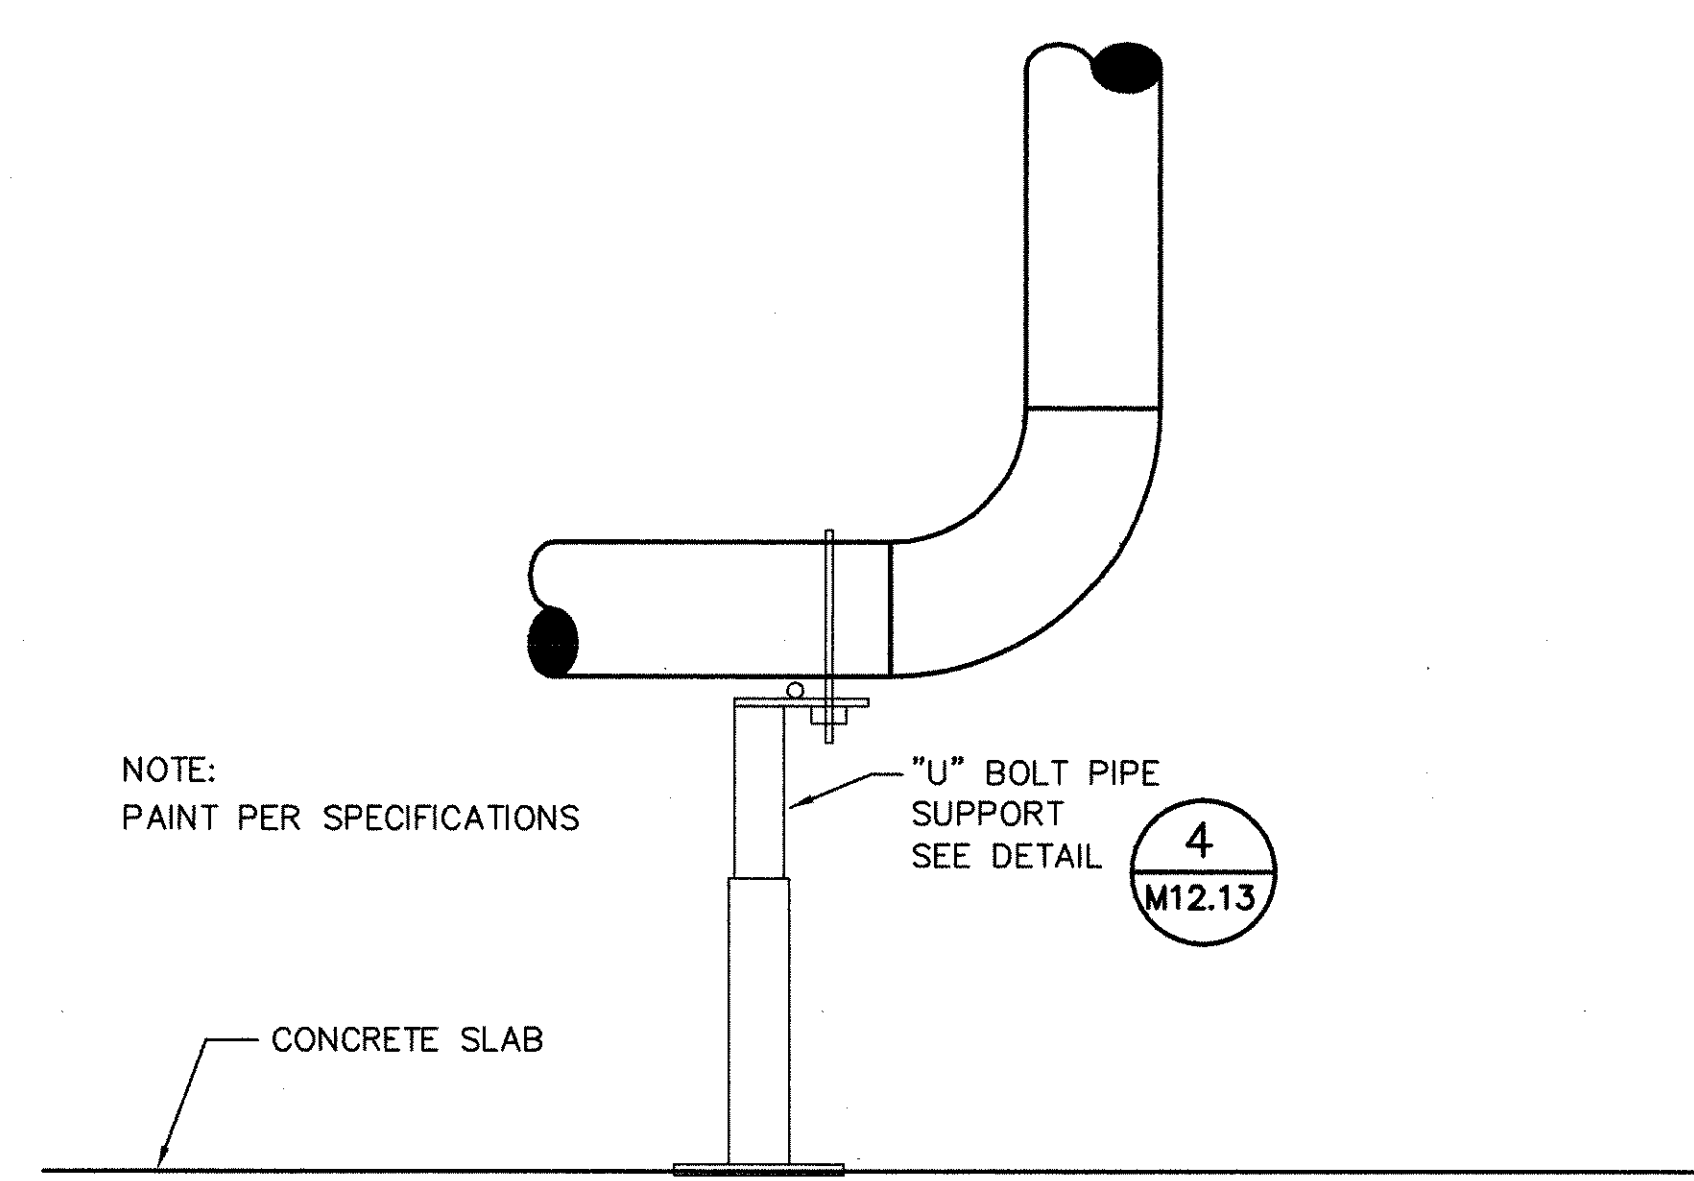

LOADING ARM BASE DETAIL 6
N.T.S.
TYP.

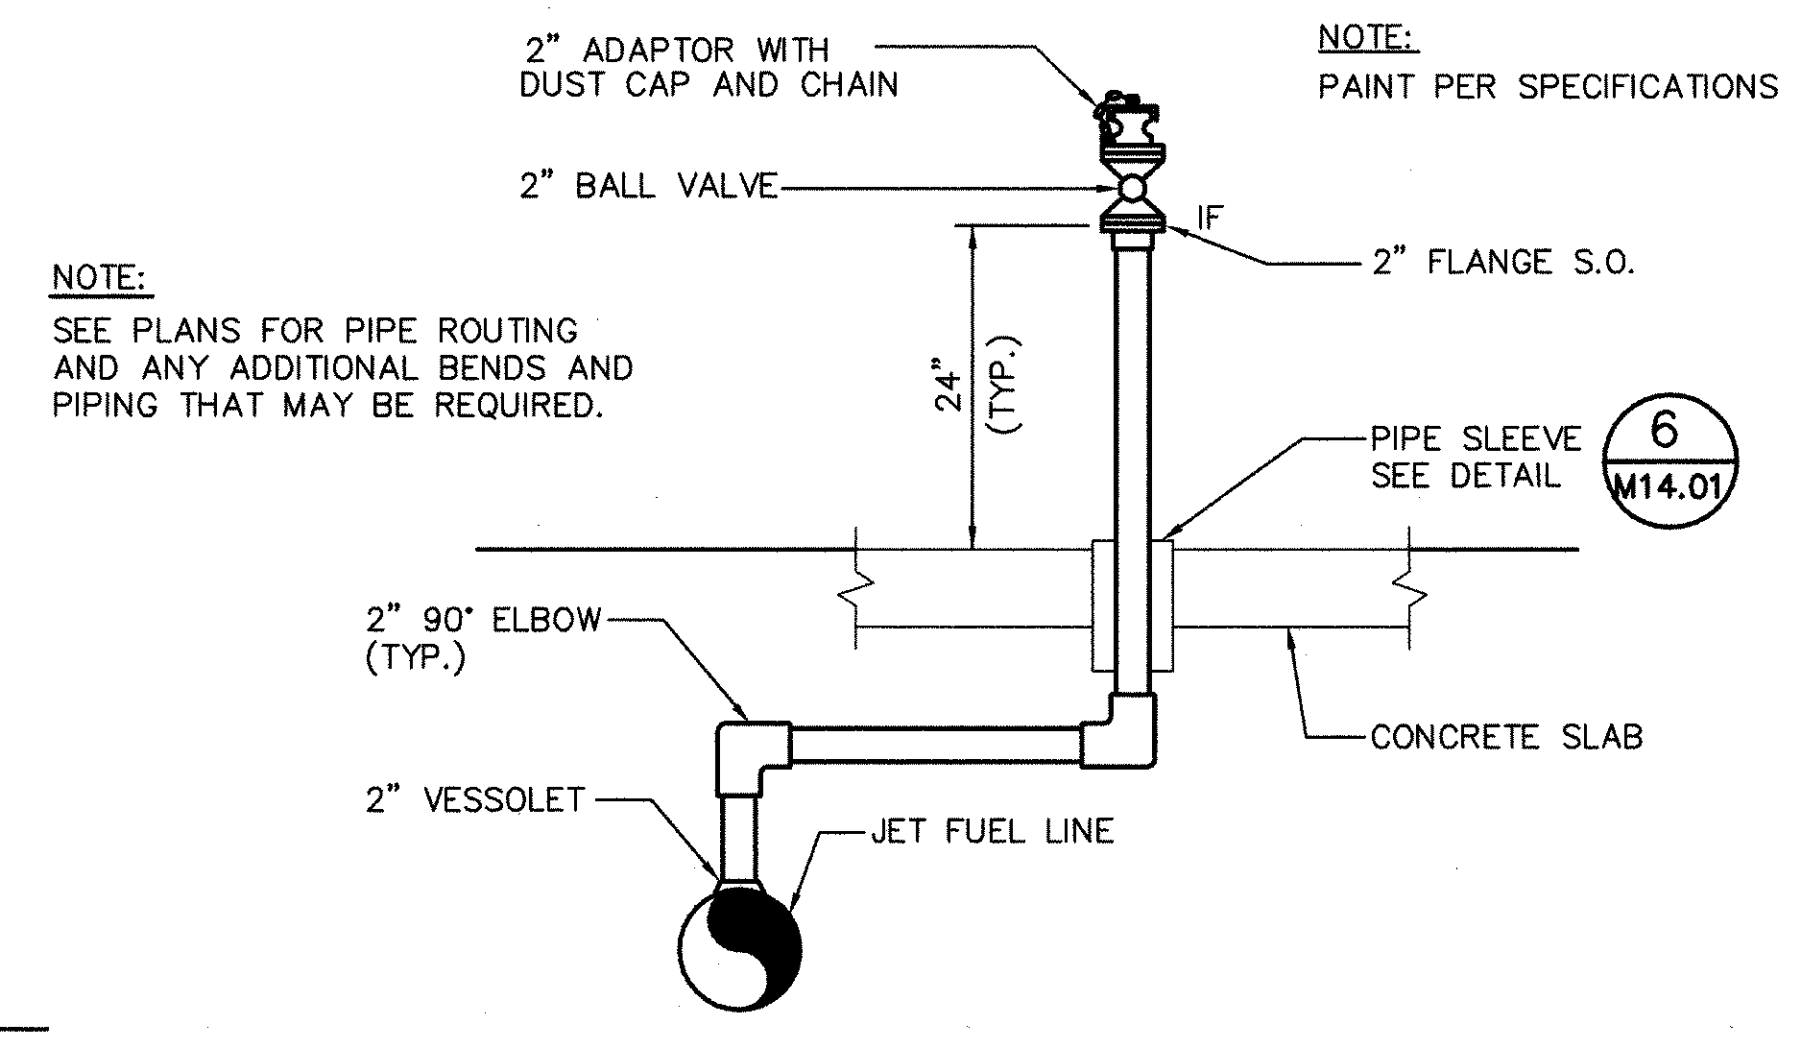

HIGH POINT VENT DETAIL 7
N.T.S.
M10.01



FOR REFERENCE ONLY

AS CONSTRUCTED PLANS
I hereby certify that all construction required
by this sheet has been accomplished as indicated

URS Greiner Woodward Clyde, Inc.
BY: *[Signature]* DATE: 1/9/02

REV. NO.	DATE	DESCRIPTION	MADE BY	CHK. BY	APPD. BY
AB	7/99	CONTRACTOR'S AS-BUILT CONDITIONS	DJM	DJM	RAH
MASSACHUSETTS PORT AUTHORITY BOSTON, MASSACHUSETTS					
BOSTON LOGAN INTERNATIONAL AIRPORT EAST BOSTON, MASSACHUSETTS					
AIRCRAFT FUELING SYSTEMS SCHEDULE B - FUEL STORAGE FACILITY REFUELER LOADING STATIONS - DETAILS					
CONSULTANT AND SUBCONSULTANT:					
GREINER INC. TAMPA, FLORIDA EDWARDS AND KELCEY INC. BOSTON, MASSACHUSETTS					
DRAWN BY: CGH		CHKD. BY: RAH		DWG. NO:	
SCALE: NONE		APPROVED: RAH		DATE: 2/97	
MPA CONTRACT NO.: MPA 1.646C (R)				SHEET NO. 62 OF 209	

C:\BOS\FUEL\STOR\MECH-AB\M1303ABC 09/22/99 08:25

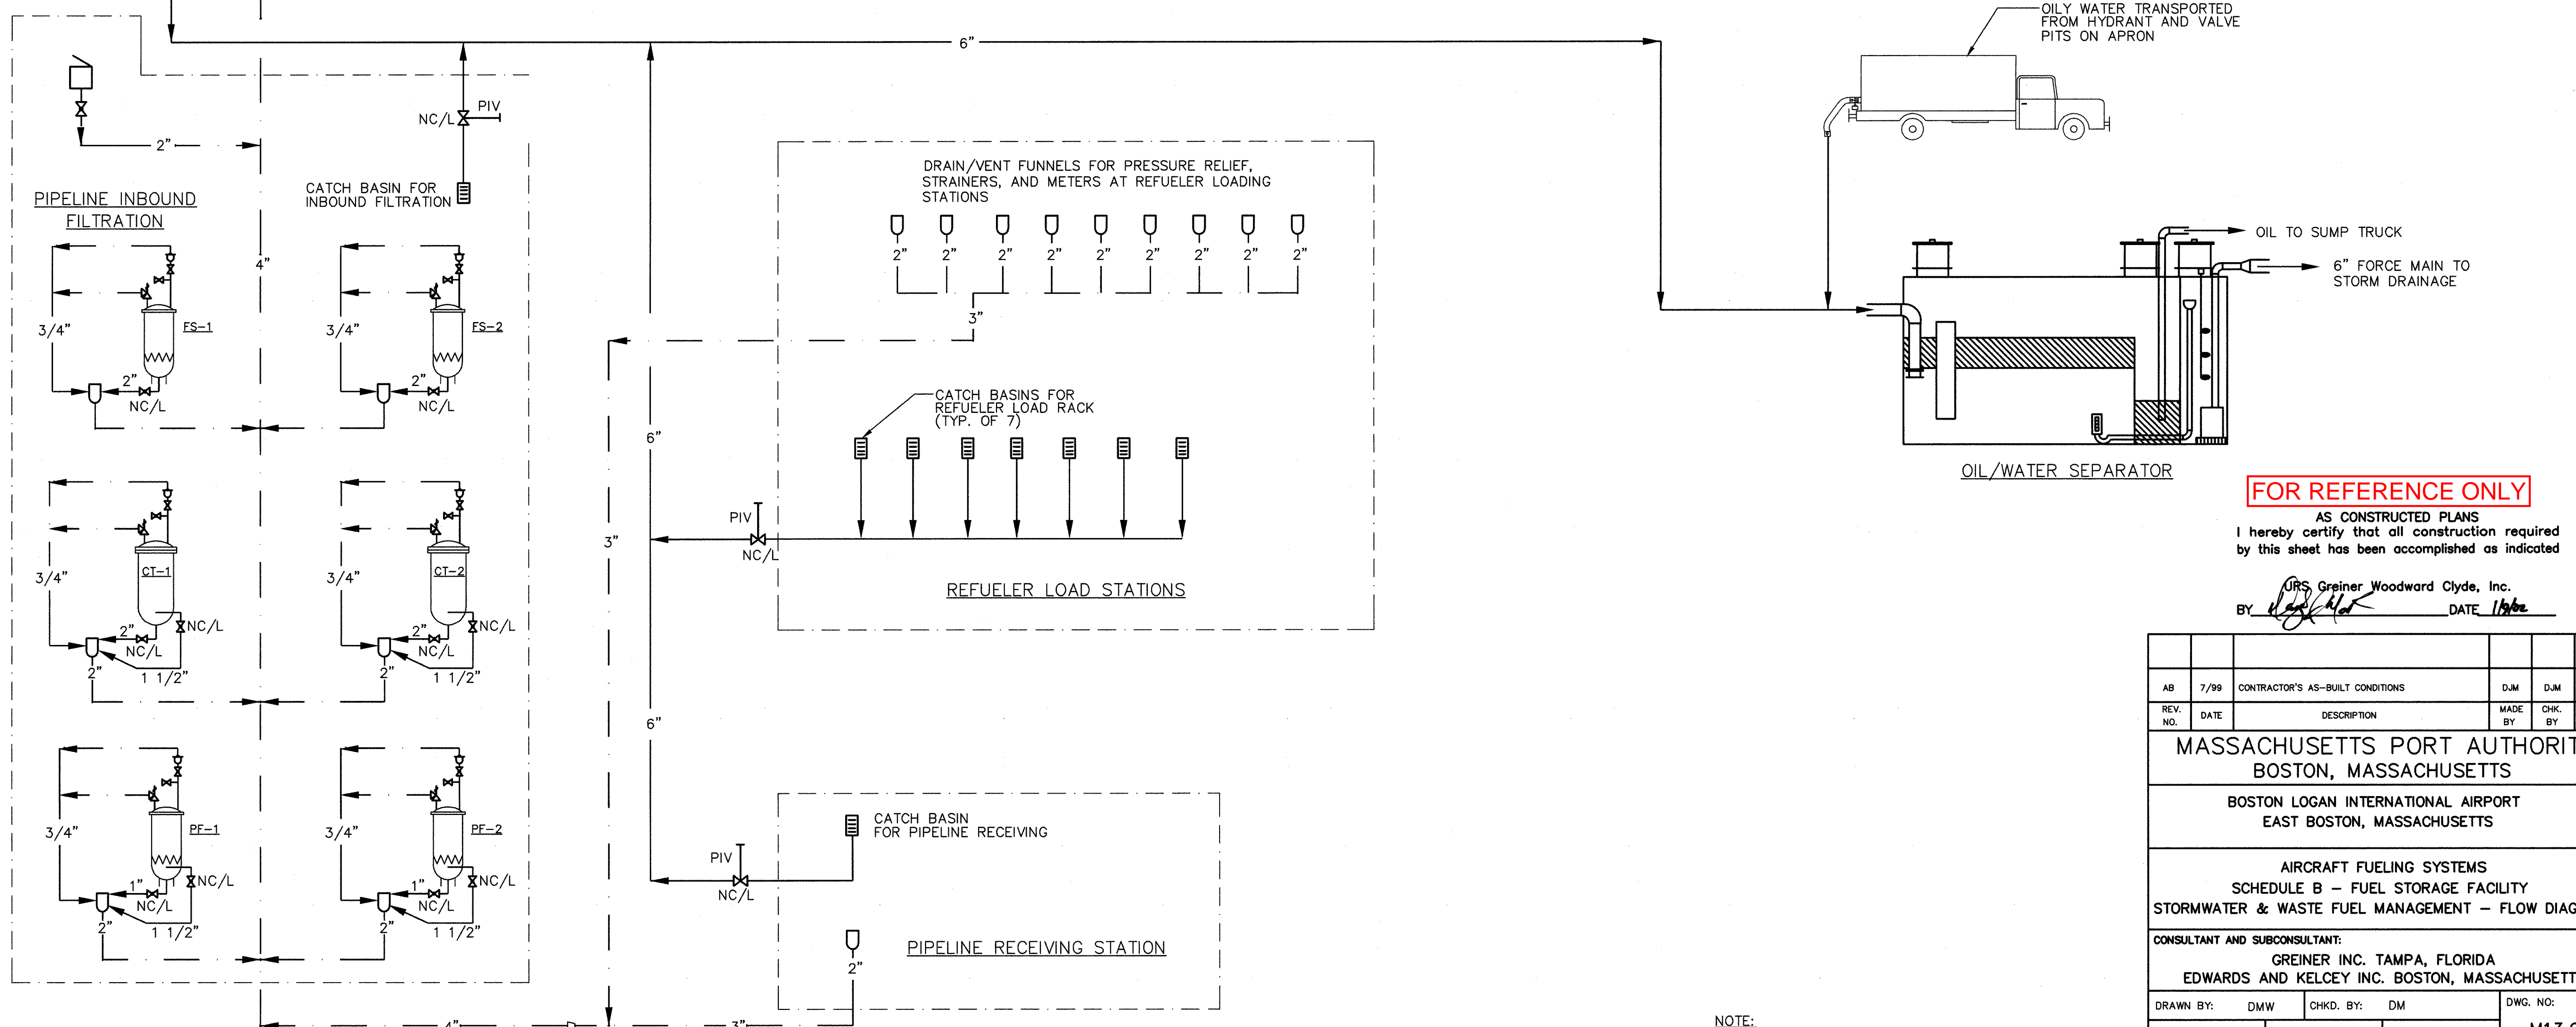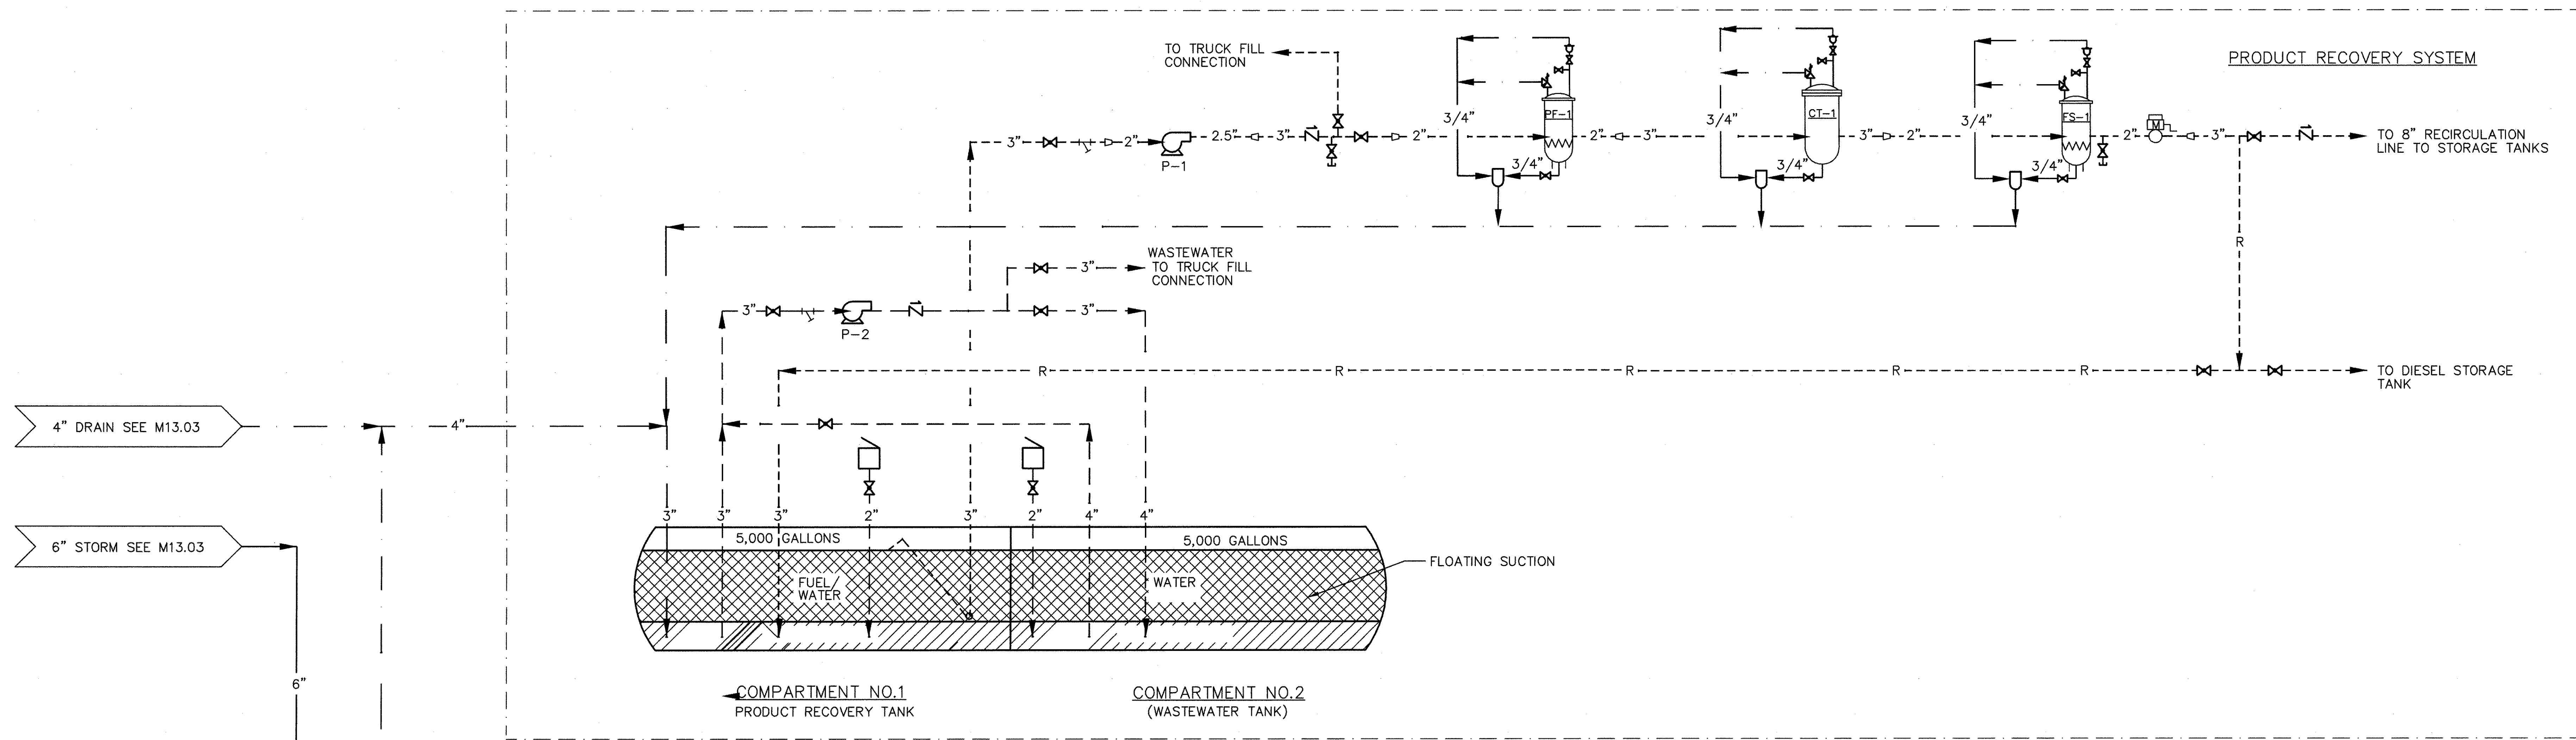

FOR REFERENCE ONLY


AS CONSTRUCTED PLANS
I hereby certify that all construction required
by this sheet has been accomplished as indicated

BY: *[Signature]* DATE: 1/9/00
ORS Greiner Woodward Clyde, Inc.

REV. NO.	DATE	DESCRIPTION	MADE BY	CHK. BY	APPD. BY
AB	7/99	CONTRACTOR'S AS-BUILT CONDITIONS	DJM	DJM	RAH
MASSACHUSETTS PORT AUTHORITY BOSTON, MASSACHUSETTS					
BOSTON LOGAN INTERNATIONAL AIRPORT EAST BOSTON, MASSACHUSETTS					
AIRCRAFT FUELING SYSTEMS SCHEDULE B - FUEL STORAGE FACILITY STORMWATER & WASTE FUEL MANAGEMENT - FLOW DIAGRAM					
CONSULTANT AND SUBCONSULTANT: GREINER INC. TAMPA, FLORIDA EDWARDS AND KELCEY INC. BOSTON, MASSACHUSETTS					
DRAWN BY: DMW		CHKD. BY: DM		DWG. NO:	
SCALE: N.T.S.		APPROVED: RAH		DATE: 2/97	
MPA CONTRACT NO.: MPA 1.646C (R)				SHEET NO. 64 OF 200	


NOTE:
REFER TO M13.02 FOR LEGEND AND NOTES.

AS BUILT

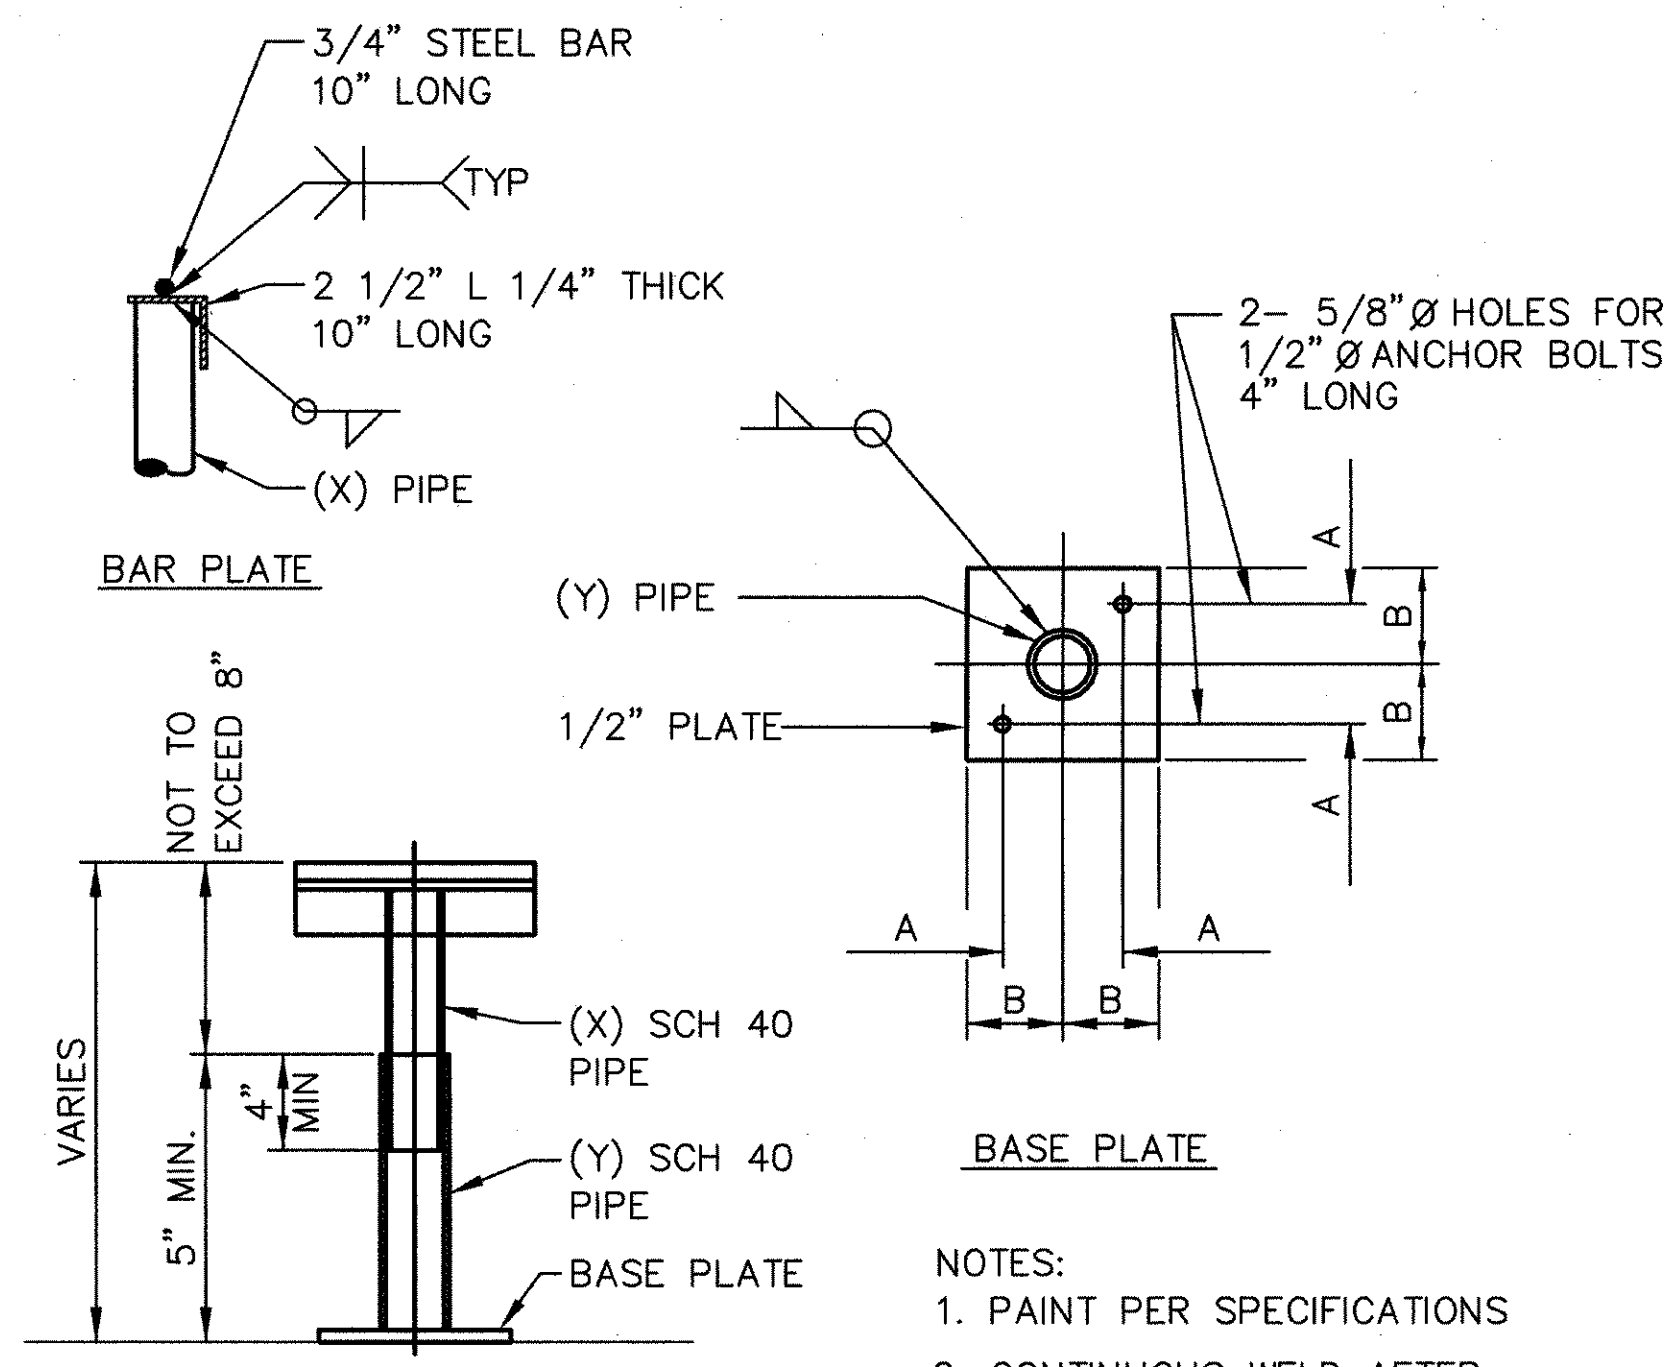


PIPE Ø	A DIM.	B DIM.	X PIPE Ø	Y PIPE Ø
3"	2 1/2"	4"	1 1/2"	2 1/2"
4"	2 1/2"	4"	2 1/2"	3"
6"	2 1/2"	4"	2 1/2"	3"
8"	2 1/2"	4"	2 1/2"	3"
18"	4 1/2"	6"	4"	6"


PEDESTAL PIPE SUPPORT DETAIL 1
N.T.S. TYP.

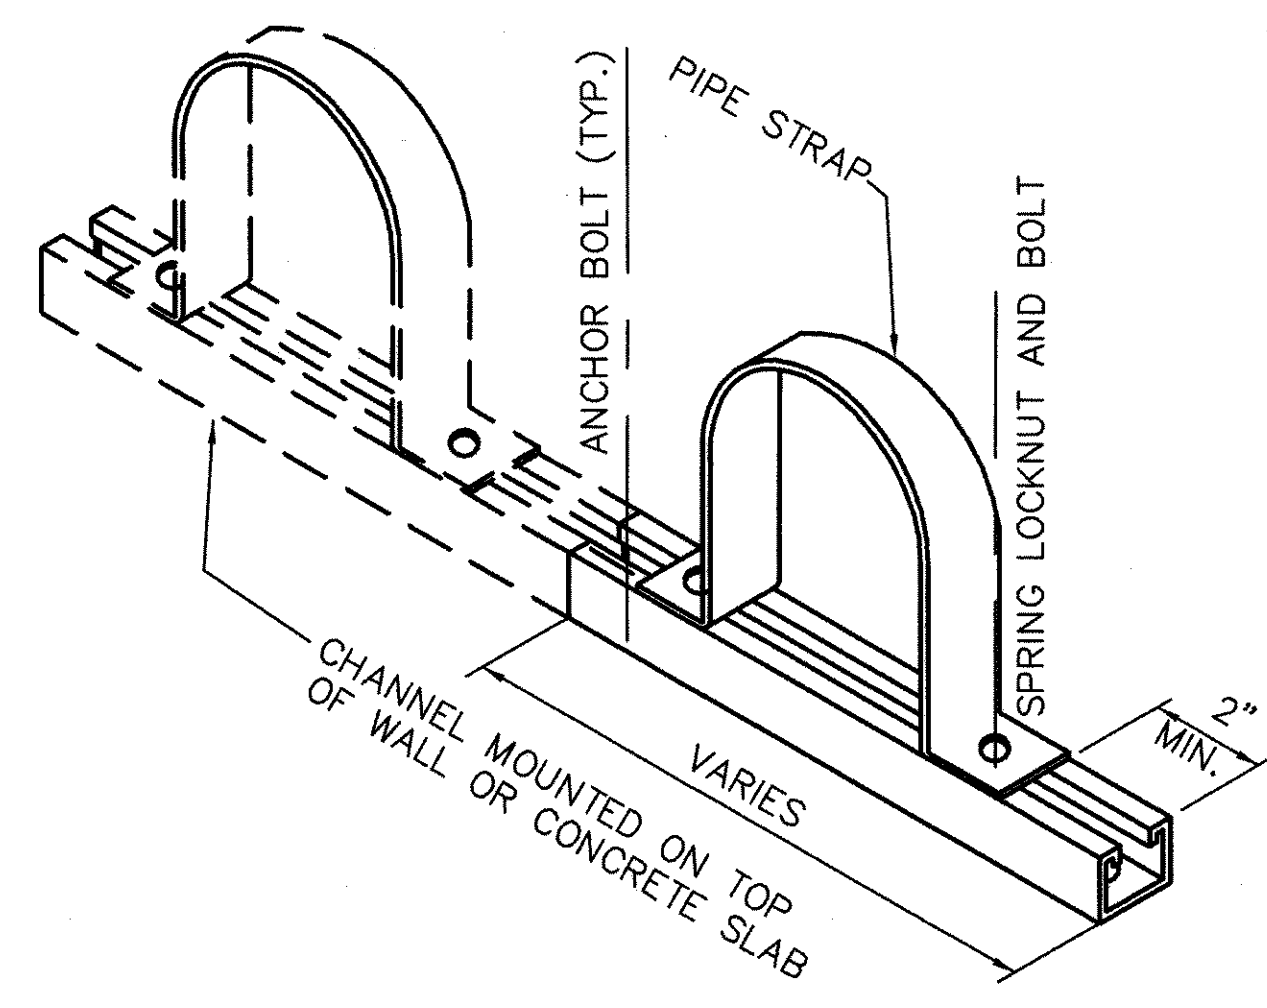


CHANNEL PIPE SUPPORT DETAIL 2
N.T.S. M12.05

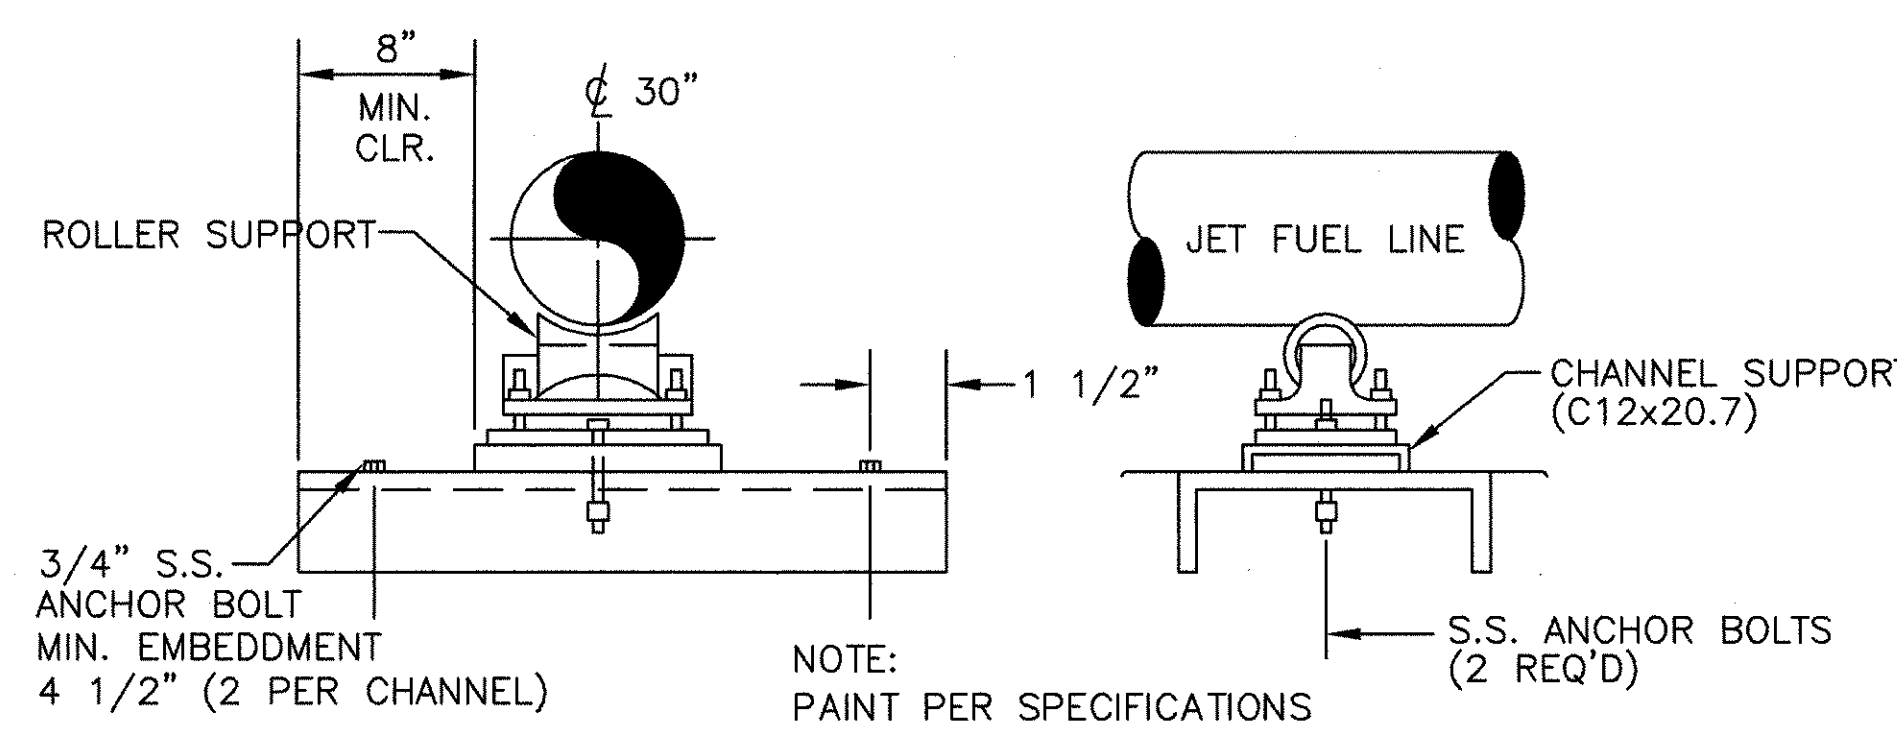


ROLLER PIPE SUPPORT DETAIL 3
N.T.S. M9.03

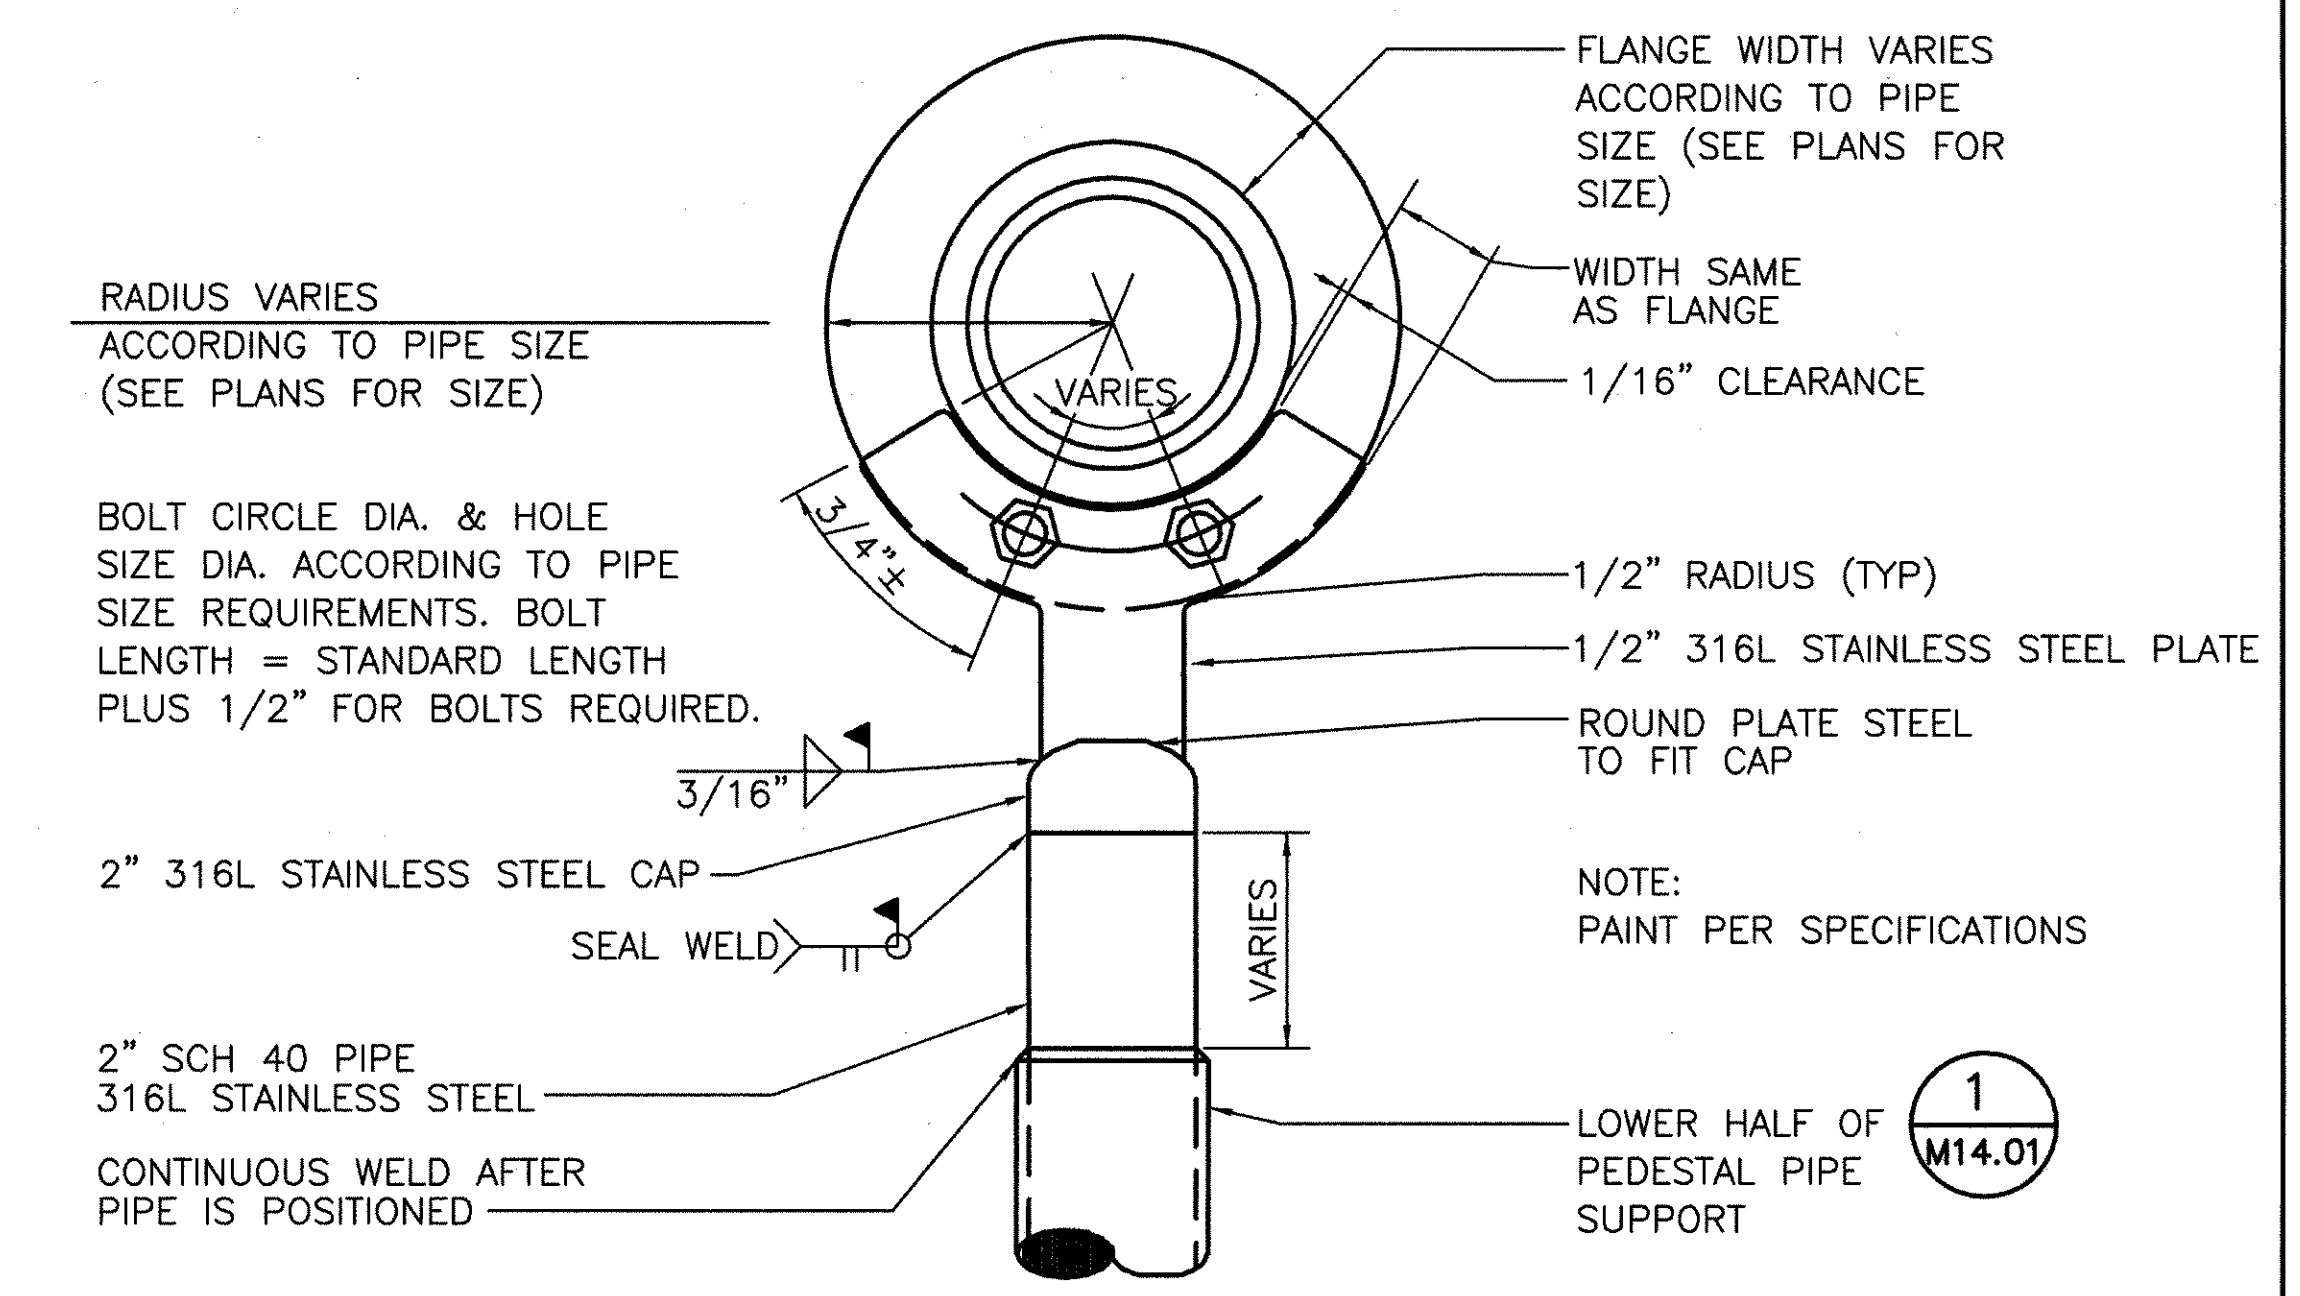


FLANGE PIPE SUPPORT DETAIL 4
N.T.S. TYP.

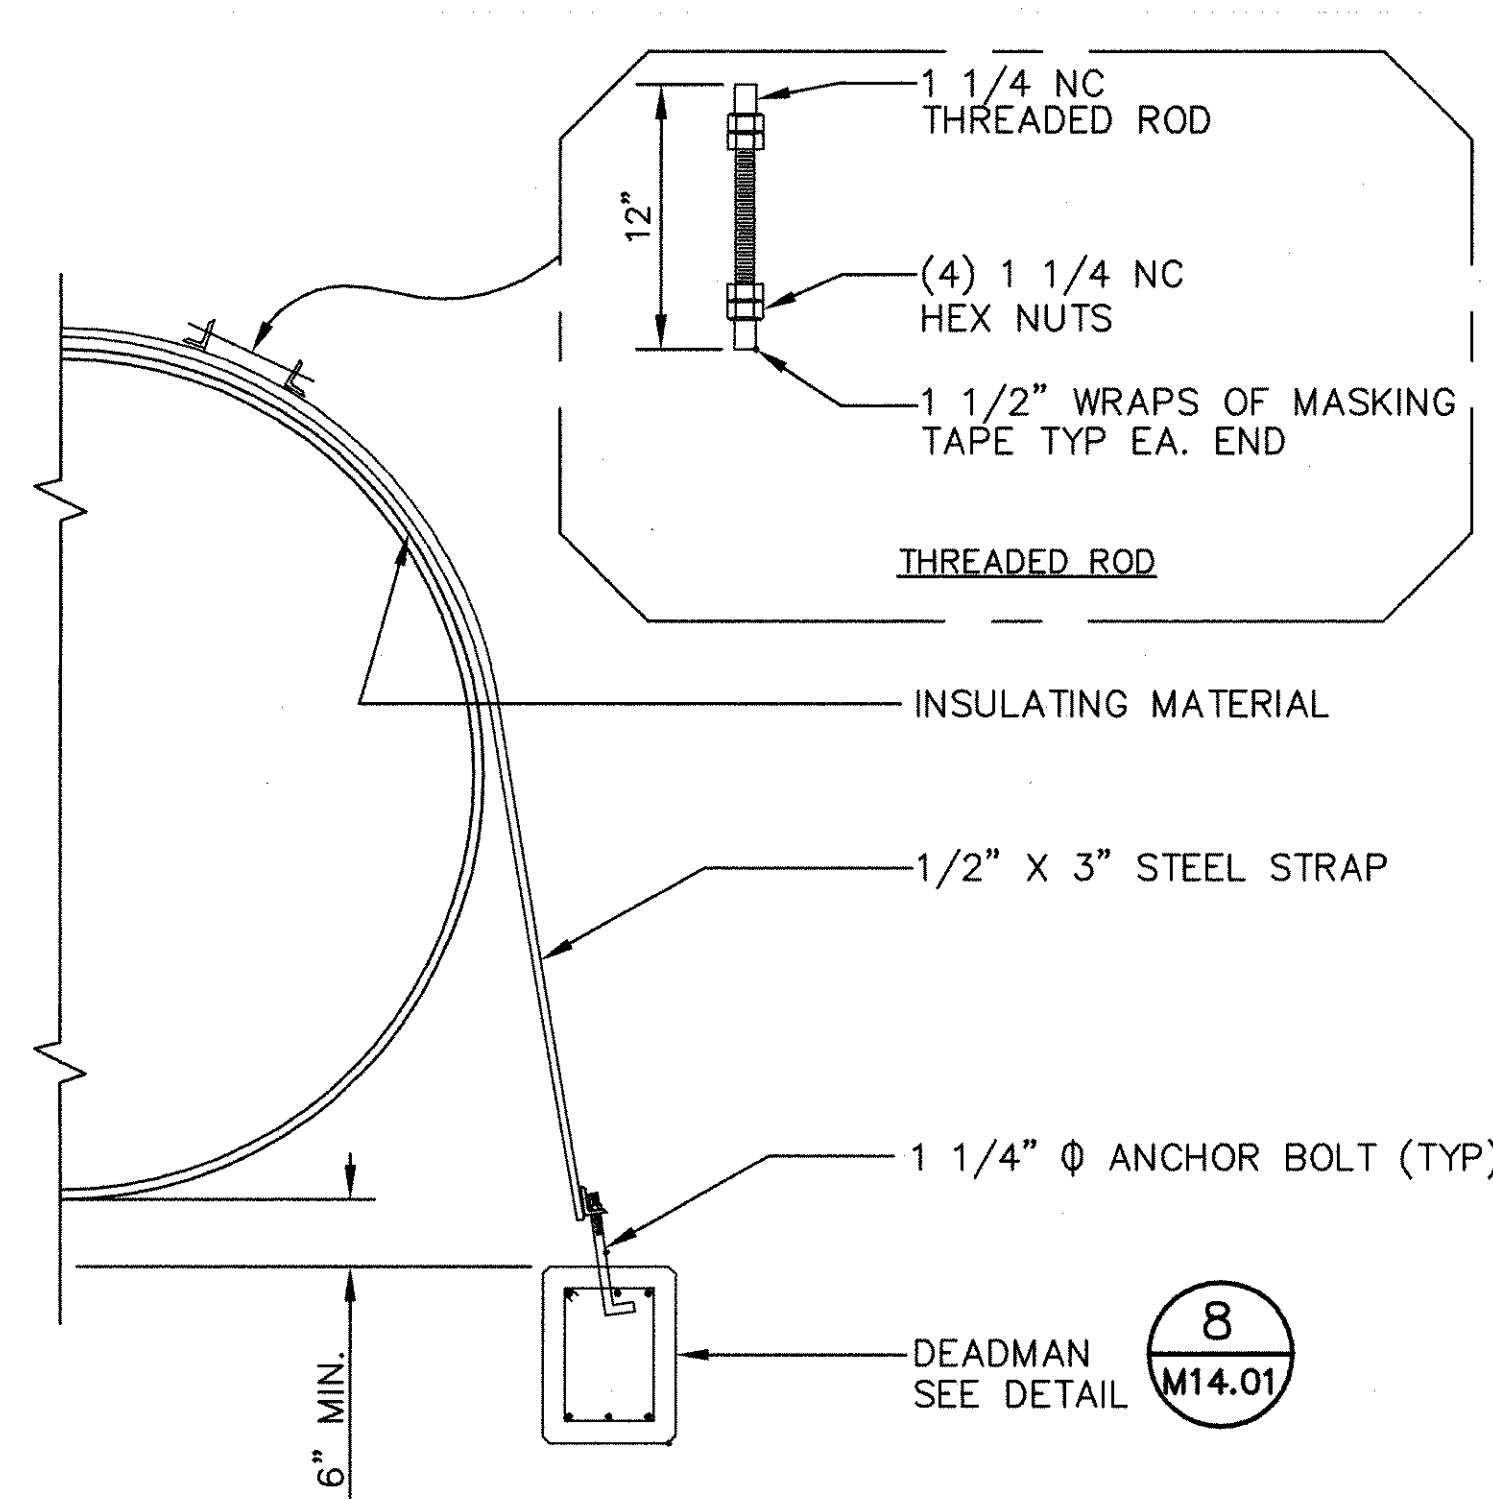


TANK STRAP DETAIL 5
N.T.S. TYP.

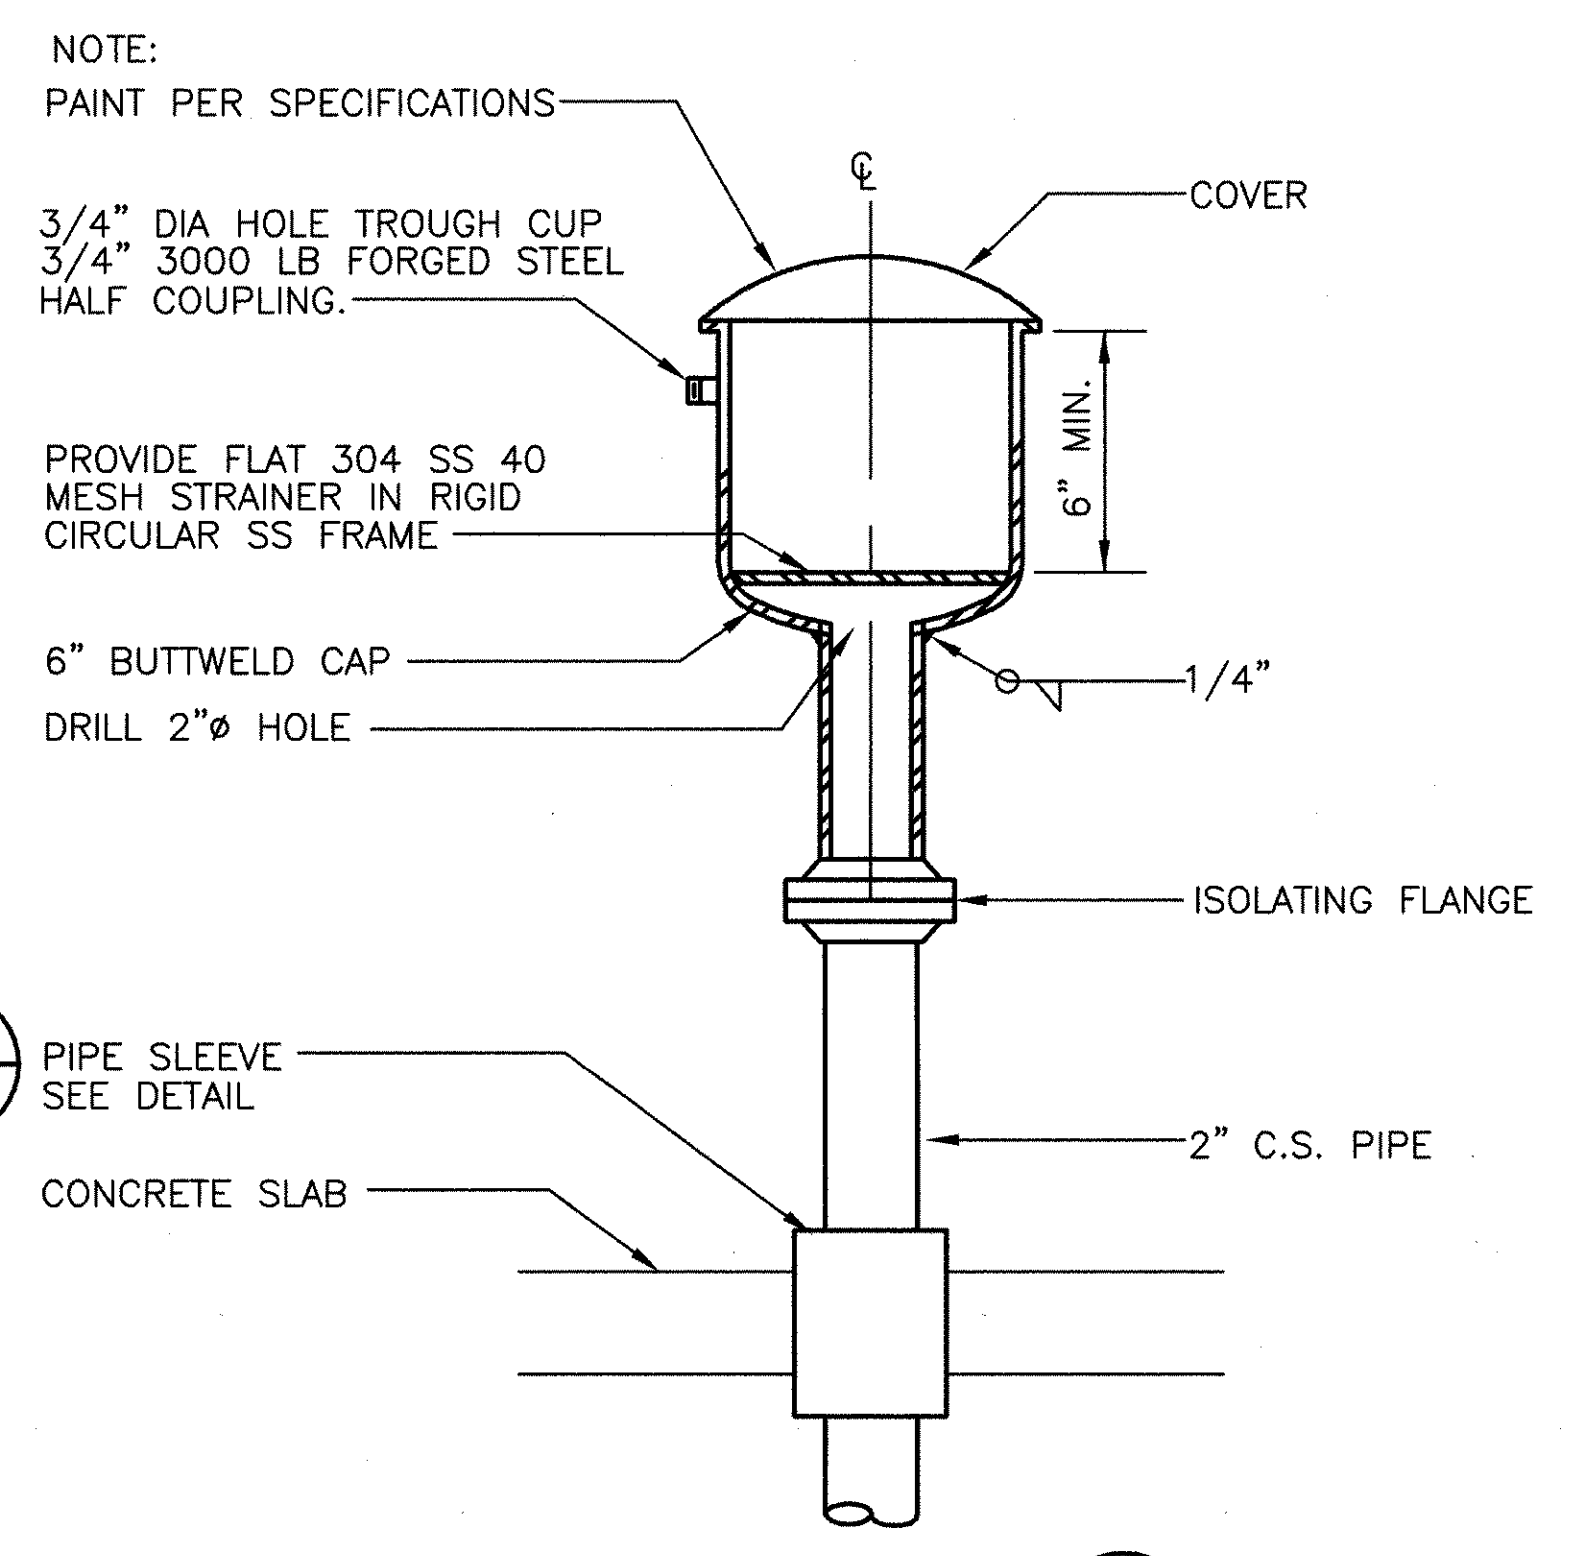


DRAIN FUNNEL DETAIL 9
N.T.S. M14.01

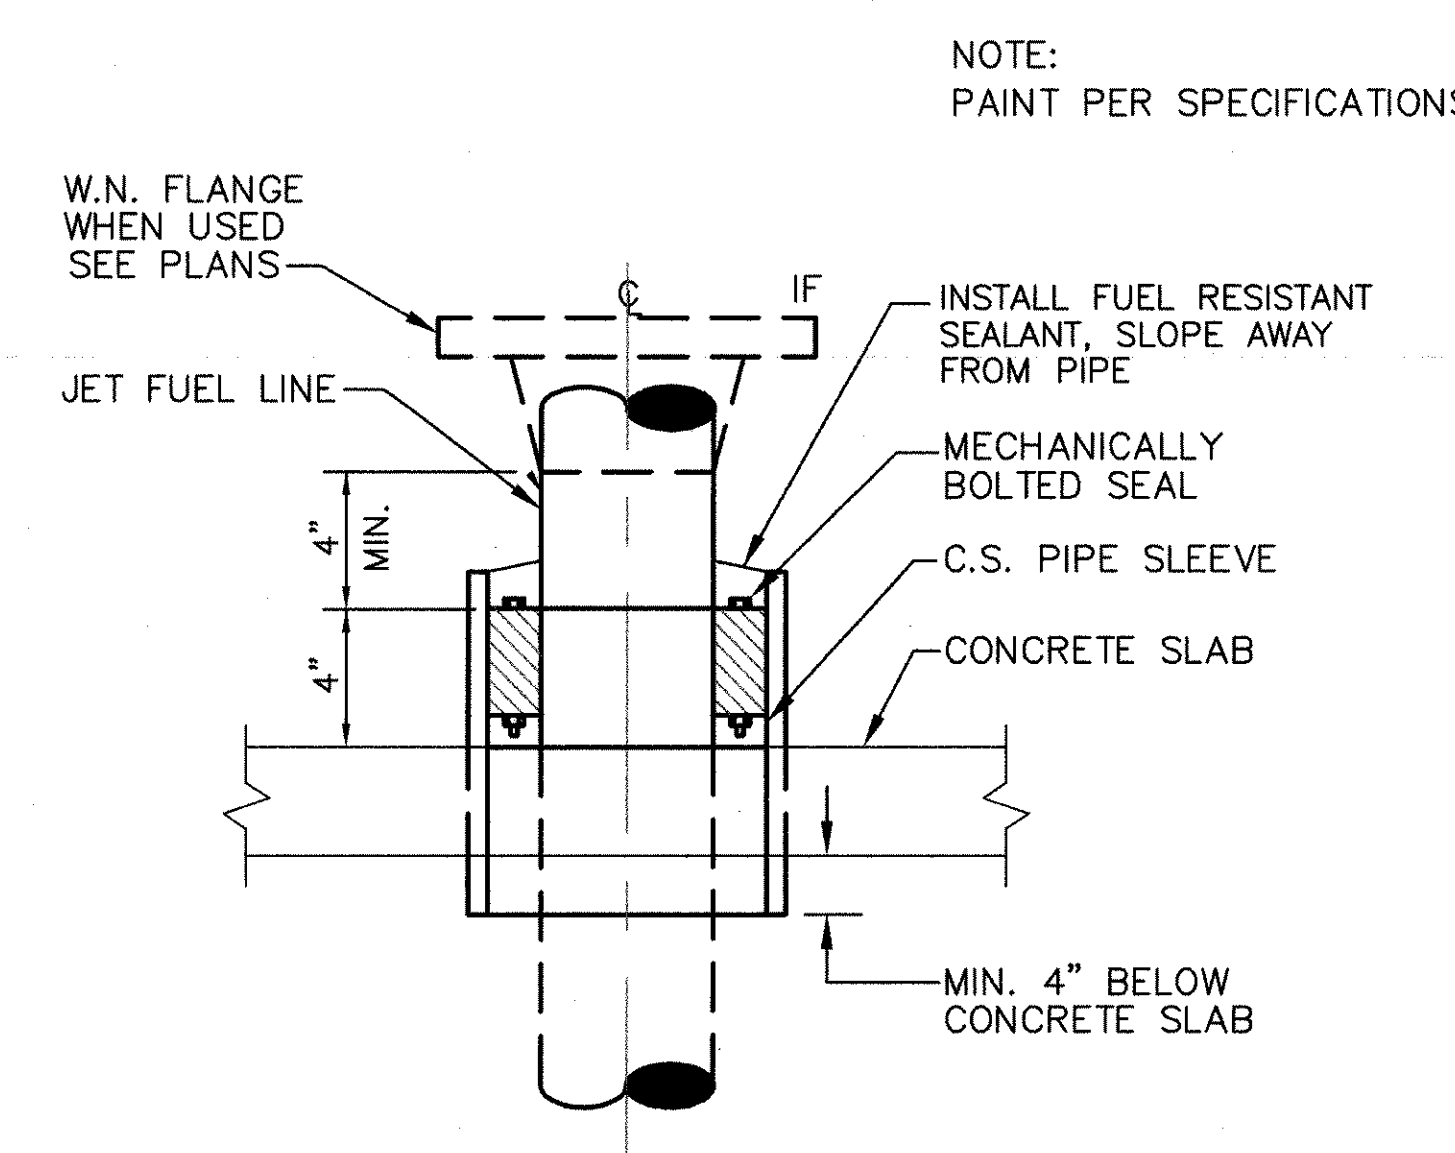


CONCRETE SLAB PIPE SLEEVE DETAIL 6
N.T.S. TYP.

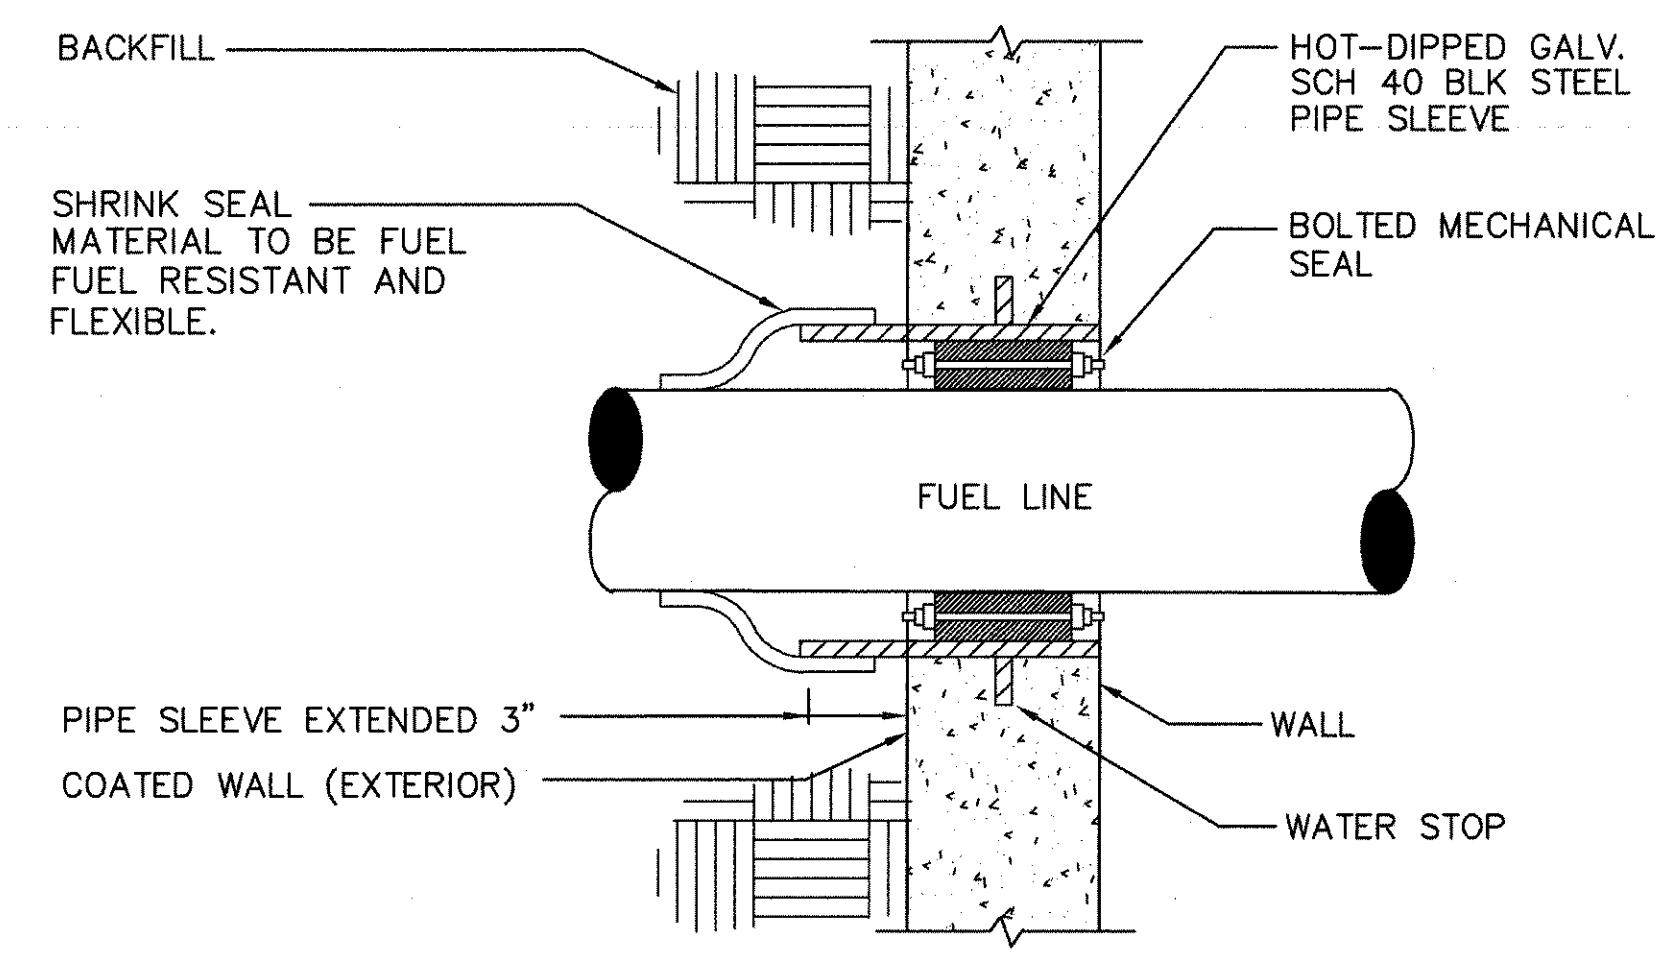

MECHANICALLY BOLTED SEAL DETAIL 7
N.T.S. TYP.

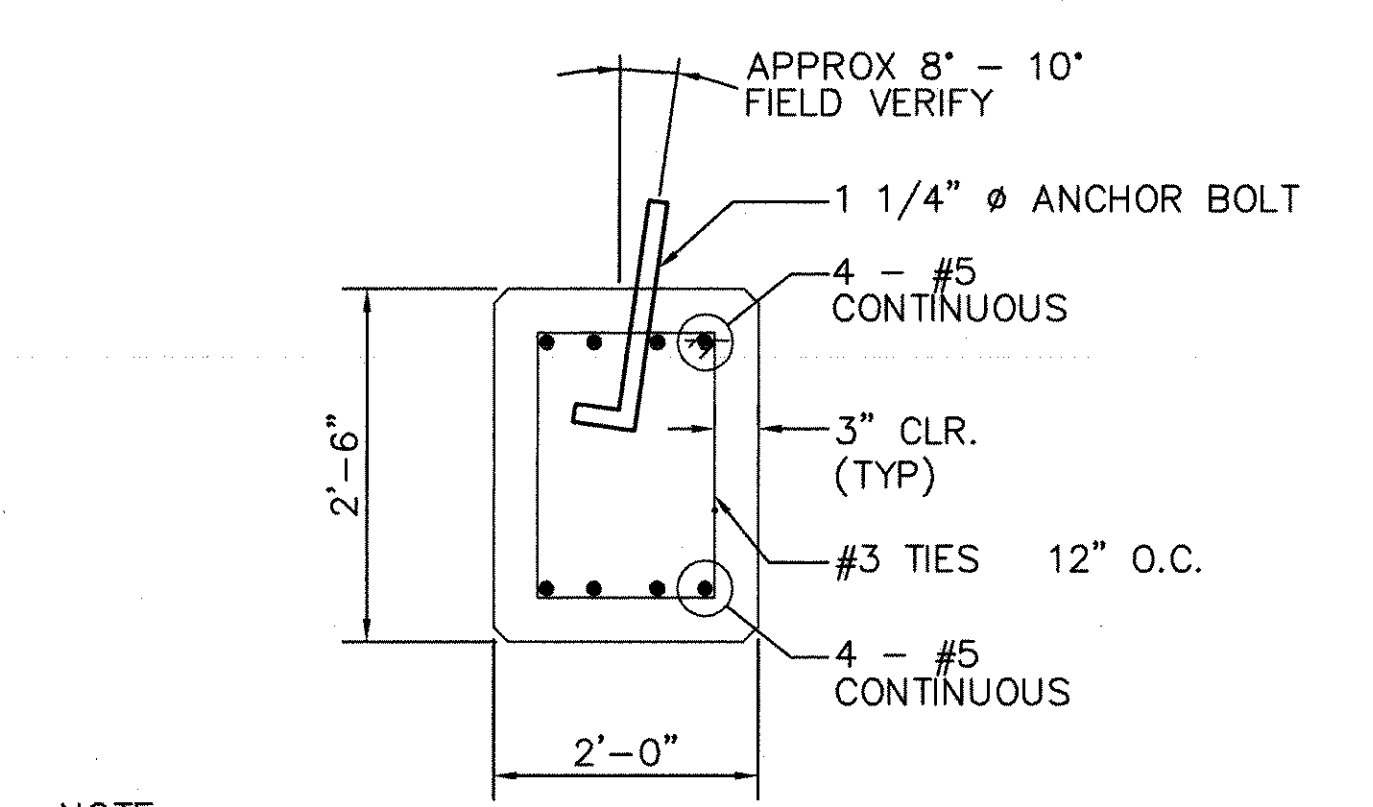

CONCRETE DEADMAN DETAIL 8
N.T.S. TYP.

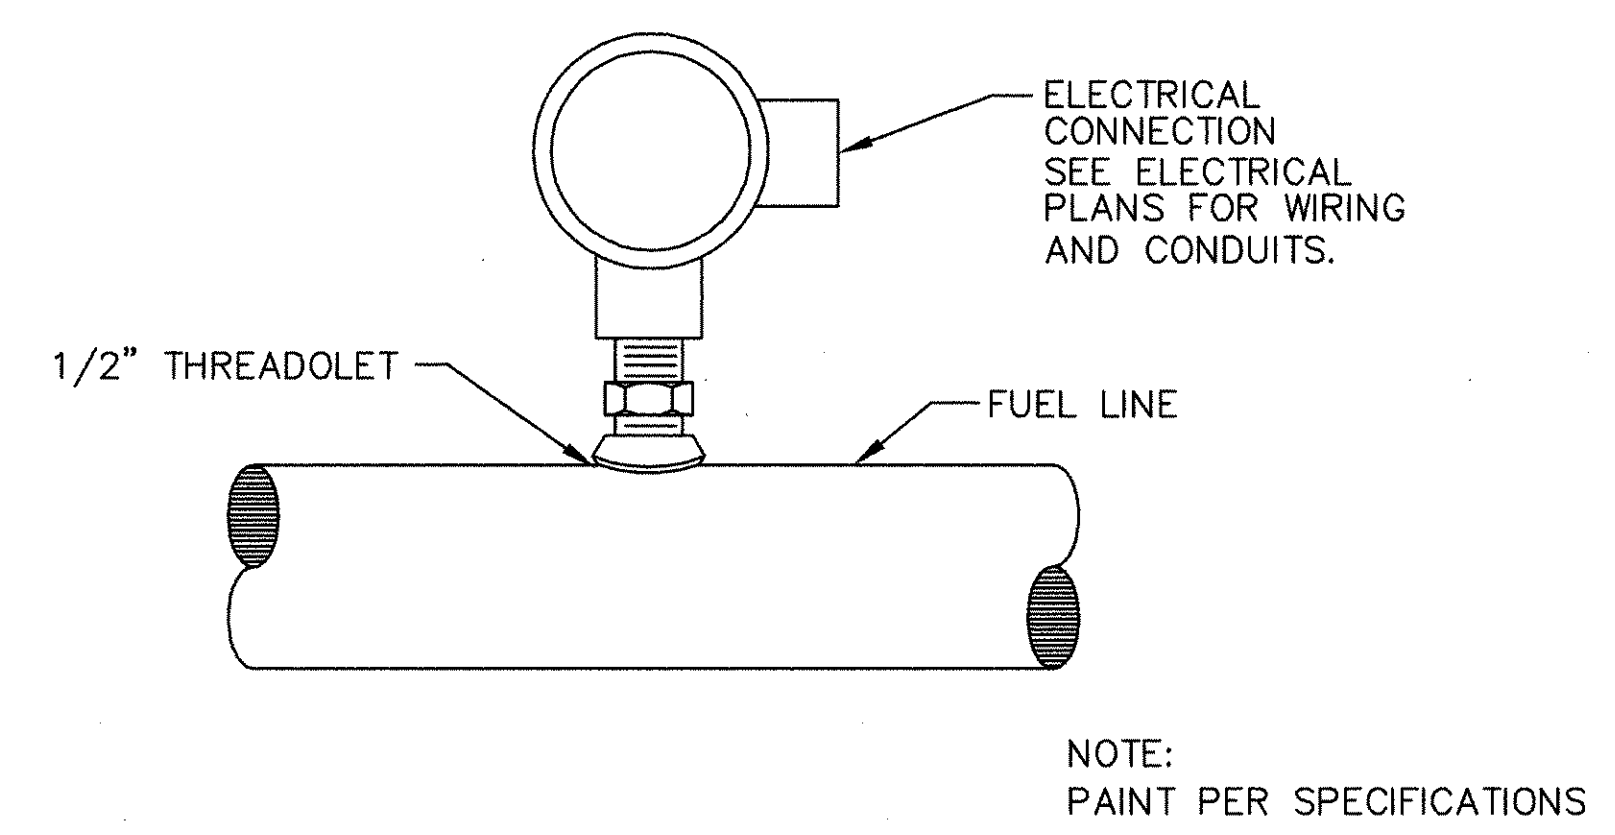

THERMAL FLOW SWITCH DETAIL 10
N.T.S. TYP.

FOR REFERENCE ONLY

AS CONSTRUCTED PLANS
I hereby certify that all construction required
by this sheet has been accomplished as indicated

JRS Greiner Woodward Clyde, Inc.
BY: *[Signature]* DATE: 1/96z

REV. NO.	DATE	DESCRIPTION	MADE BY	CHK. BY	APPD. BY
AB	7/99	CONTRACTOR'S AS-BUILT CONDITIONS	DJM	DJM	RAH
MASSACHUSETTS PORT AUTHORITY BOSTON, MASSACHUSETTS					
BOSTON LOGAN INTERNATIONAL AIRPORT EAST BOSTON, MASSACHUSETTS					
AIRCRAFT FUELING SYSTEMS SCHEDULE B - FUEL STORAGE FACILITY DETAILS					
CONSULTANT AND SUBCONSULTANT:					
GREINER INC. TAMPA, FLORIDA EDWARDS AND KELCEY INC. BOSTON, MASSACHUSETTS					
DRAWN BY:	CGH	CHKD. BY:	RAH	DWG. NO.:	M14.01
SCALE:	NONE	APPROVED:	RAH	DATE:	2/97
MPA CONTRACT NO.: MPA 1.646C (R)				SHEET NO. 42 OF 242	

AS BUILT

FILTER VESSEL SCHEDULE

DRAWING IDENTIFICATION	SERVICE	GPM	DESCRIPTION	ASME PRESSURE RATING (PSI)	CONNECTIONS (IN.)	NOTES
F/S-1	HYDRANT SYSTEM	1200	FILTER SEPARATOR	275	8"	--
F/S-2	HYDRANT SYSTEM	1200	FILTER SEPARATOR	275	8"	--
F/S-3	HYDRANT SYSTEM	1200	FILTER SEPARATOR	275	8"	--
F/S-4	HYDRANT SYSTEM	1200	FILTER SEPARATOR	275	8"	--
F/S-5	HYDRANT SYSTEM	1200	FILTER SEPARATOR	275	8"	--
F/S-6	HYDRANT SYSTEM	1200	FILTER SEPARATOR	275	8"	--
F/S-7	HYDRANT SYSTEM	1200	FILTER SEPARATOR	275	8"	--
F/S-8	HYDRANT SYSTEM	1200	FILTER SEPARATOR	275	8"	--
F/S-9	HYDRANT SYSTEM	1200	FILTER SEPARATOR	275	8"	--
F/S-10	HYDRANT SYSTEM	1200	FILTER SEPARATOR	275	8"	--
F/S-11	HYDRANT SYSTEM	1200	FILTER SEPARATOR	275	8"	--
F/S-12	HYDRANT SYSTEM	1200	FILTER SEPARATOR	275	8"	--
F/S-13	--	--	--	--	--	1
F/S-14	--	--	--	--	--	1
F/S-1	TRUCK OFFLOADING STATION	475	FILTER SEPARATOR	275	6"	--
F/S-2	TRUCK OFFLOADING STATION	475	FILTER SEPARATOR	275	6"	--
F/S-1	INBOUND FILTRATION	1200	FILTER SEPARATOR	275	8"	--
F/S-2	INBOUND FILTRATION	1200	FILTER SEPARATOR	275	8"	--
F/S-1	PRODUCT RECOVERY SYSTEM	100	FILTER SEPARATOR	250	2"	--
PF-1	INBOUND FILTRATION	1200	PREFILTER	275	8"	--
PF-2	INBOUND FILTRATION	1200	PREFILTER	275	8"	--
PF-1	PRODUCT RECOVERY SYSTEM	100	PREFILTER	250	2"	--
CT-1	INBOUND FILTRATION	1200	CLAY TREATMENT VESSEL	275	8"	--
CT-2	INBOUND FILTRATION	1200	CLAY TREATMENT VESSEL	275	8"	--
CT-1	PRODUCT RECOVERY SYSTEM	100	CLAY TREATMENT VESSEL	150	2"	--

NOTES:
1. FILTER SEPARATORS WILL BE INSTALLED IN THE FUTURE. (N.I.C.)

PUMP SCHEDULE

UNIT NO. (MARK)	GPM	HEAD FT.	RPM	HP	BHP	MIN. % EFF.	ELECTRICAL DATA (V/PH/HZ)	MIN. NPSH	SIZE	MODEL	TYPE	SERVICE	NOTES
P-1	1000	600	3550	200	183	73	460/3/60	13.4	4X6X14	HHS	BYRON JACKSON	HYDRANT PUMPING	--
P-2	1000	600	3550	200	183	73	460/3/60	13.4	4X6X14	HHS	BYRON JACKSON	HYDRANT PUMPING	--
P-3	1000	600	3550	200	183	73	460/3/60	13.4	4X6X14	HHS	BYRON JACKSON	HYDRANT PUMPING	--
P-4	1000	600	3550	200	183	73	460/3/60	13.4	4X6X14	HHS	BYRON JACKSON	HYDRANT PUMPING	--
P-5	1000	600	3550	200	183	73	460/3/60	13.4	4X6X14	HHS	BYRON JACKSON	HYDRANT PUMPING	--
P-6	1000	600	3550	200	183	73	460/3/60	13.4	4X6X14	HHS	BYRON JACKSON	HYDRANT PUMPING	--
P-7	1000	600	3550	200	183	73	460/3/60	13.4	4X6X14	HHS	BYRON JACKSON	HYDRANT PUMPING	--
P-8	1000	600	3550	200	183	73	460/3/60	13.4	4X6X14	HHS	BYRON JACKSON	HYDRANT PUMPING	--
P-9	1000	600	3550	200	183	73	460/3/60	13.4	4X6X14	HHS	BYRON JACKSON	HYDRANT PUMPING	--
P-10	1000	600	3550	200	183	73	460/3/60	13.4	4X6X14	HHS	BYRON JACKSON	HYDRANT PUMPING	--
P-11	1000	600	3550	200	183	73	460/3/60	13.4	4X6X14	HHS	BYRON JACKSON	HYDRANT PUMPING	--
P-12	1000	600	3550	200	183	73	460/3/60	13.4	4X6X14	HHS	BYRON JACKSON	HYDRANT PUMPING	--
P-13	--	--	--	--	--	--	--	--	--	--	--	--	1
P-14	--	--	--	--	--	--	--	--	--	--	--	--	1
P-1	400	126	3450	30	23	53	460/3/60	4	4X3	RD3A-B	GORMAN-RUPP	TRUCK OFFLOADING STATION	--
P-2	400	126	3450	30	23	53	460/3/60	4	4X3	RD3A-B	GORMAN-RUPP	TRUCK OFFLOADING STATION	--
P-1	75	30	1750	3	--	63	460/3/60	5	2X1.5X7L	--	CORKEN	PRODUCT RECOVERY SYSTEM	--
P-2	75	133	1750	5	3	N/A	460/3/60	N/A	2 1/2 A	--	CORKEN	PRODUCT RECOVERY SYSTEM	--
P-1	300	115	1770	15	10	78	460/3/60	8	4X12	VTP 10L-30	INGERSOLL-DRESSER OR EQUAL	DIESEL PUMP - BULK	--
P-2	300	95	1770	10	7	83	460/3/60	8	4X12	VTP 10L-30	INGERSOLL-DRESSER OR EQUAL	MO-GAS PUMP - BULK	--
P-3	30	45	N/A	1/3	N/A	N/A	208/1/60	N/A	4"	CP75S1	RED JACKET	DIESEL PUMP	--
P-4	60	60	N/A	3/4	N/A	N/A	208/1/60	N/A	4"	CP75S1	RED JACKET	MO-GAS PUMP	--
P-5	60	60	N/A	3/4	N/A	N/A	208/1/60	N/A	4"	CP75S1	RED JACKET	MO-GAS PUMP	--
P-1	400	30	1750	5	N/A	N/A	460/3/60	N/A	8"	CP-3127	FLYGT	O/W SEPARATOR - WATER	--
P-2	30	16	N/A	3/4	N/A	N/A	208/1/60	N/A	2"	CP75S1	RED JACKET	O/W SEPARATOR - OIL	--

NOTES:
1. HYDRANT PUMPS WILL BE INSTALLED IN THE FUTURE (N.I.C.)

UNDERGROUND STORAGE TANKS

DRAWING IDENTIFICATION	SERVICE	TOTAL CAPACITY (GAL.)	DIMENSIONS	DESCRIPTION	NOTES
DT-1	DIESEL TANK	12,000	8' DIA. x 32'	DBL. WALL STEEL	--
MT-1	MO-GAS TANK	12,000	8' DIA. x 32'	DBL. WALL STEEL	--
MT-2	MO-GAS TANK	12,000	8' DIA. x 32'	DBL. WALL STEEL	--
PRT-1	PRODUCT RECOVERY TANK	10,000	8' DIA. x 26'-8"	DBL. WALL STEEL	--
WT-1	WASTE TANK	5,000	8' DIA. x 13'-4"	DBL. WALL STEEL	--
GT-1	GENERATOR FUEL STORAGE TANK	1,000	4' DIA. x 10'-8"	DBL. WALL STEEL	--

ABOVE GROUND TANK SCHEDULE

DRAWING IDENTIFICATION	SERVICE	CAPACITY	DIMENSIONS	CONSTRUCTION	REMARKS
TANK 1	JET-A STORAGE	42,970 BBL	80' DIA. x 48' HT.	API 650	--
TANK 2	JET-A STORAGE	42,970 BBL	80' DIA. x 48' HT.	API 650	--
TANK 3	JET-A STORAGE	42,970 BBL	80' DIA. x 48' HT.	API 650	--
TANK 4	JET-A STORAGE	42,970 BBL	80' DIA. x 48' HT.	API 650	--

OIL/WATER SEPARATOR SCHEDULE

DRAWING IDENTIFICATION	WATER FLOW RATE (GPM)	INLET/OUTLET CONNECTIONS (IN.)	TOTAL CAPACITY (GAL.)	OIL STORAGE CAPACITY (GAL.)	DIMENSIONS	CONSTRUCTION	NOTES
O/W-1	400	8"	10,000	8,000	8' DIA. x 27'	DOUBLE WALL STEEL	--


FOR REFERENCE ONLY

AS CONSTRUCTED PLANS
I hereby certify that all construction required
by this sheet has been accomplished as indicated

BY: *[Signature]* DATE: 1/18/97


REV. NO.	DATE	DESCRIPTION	MADE BY	CHK. BY	APPD. BY
AB	7/99	CONTRACTOR'S AS-BUILT CONDITIONS		DJM	RAH
MASSACHUSETTS PORT AUTHORITY BOSTON, MASSACHUSETTS					
BOSTON LOGAN INTERNATIONAL AIRPORT EAST BOSTON, MASSACHUSETTS					
AIRCRAFT FUELING SYSTEMS SCHEDULE B - FUEL STORAGE FACILITY EQUIPMENT SCHEDULES					
CONSULTANT AND SUBCONSULTANT:					
GREINER INC. TAMPA, FLORIDA EDWARDS AND KELCEY INC. BOSTON, MASSACHUSETTS					
DRAWN BY: DM		CHKD. BY: RAH		DWG. NO:	
SCALE: NONE		APPROVED: RAH		DATE: 2/97	
MPA CONTRACT NO.: MPA 1.646C (R)				SHEET NO. 24 OF 26	

AS BUILT

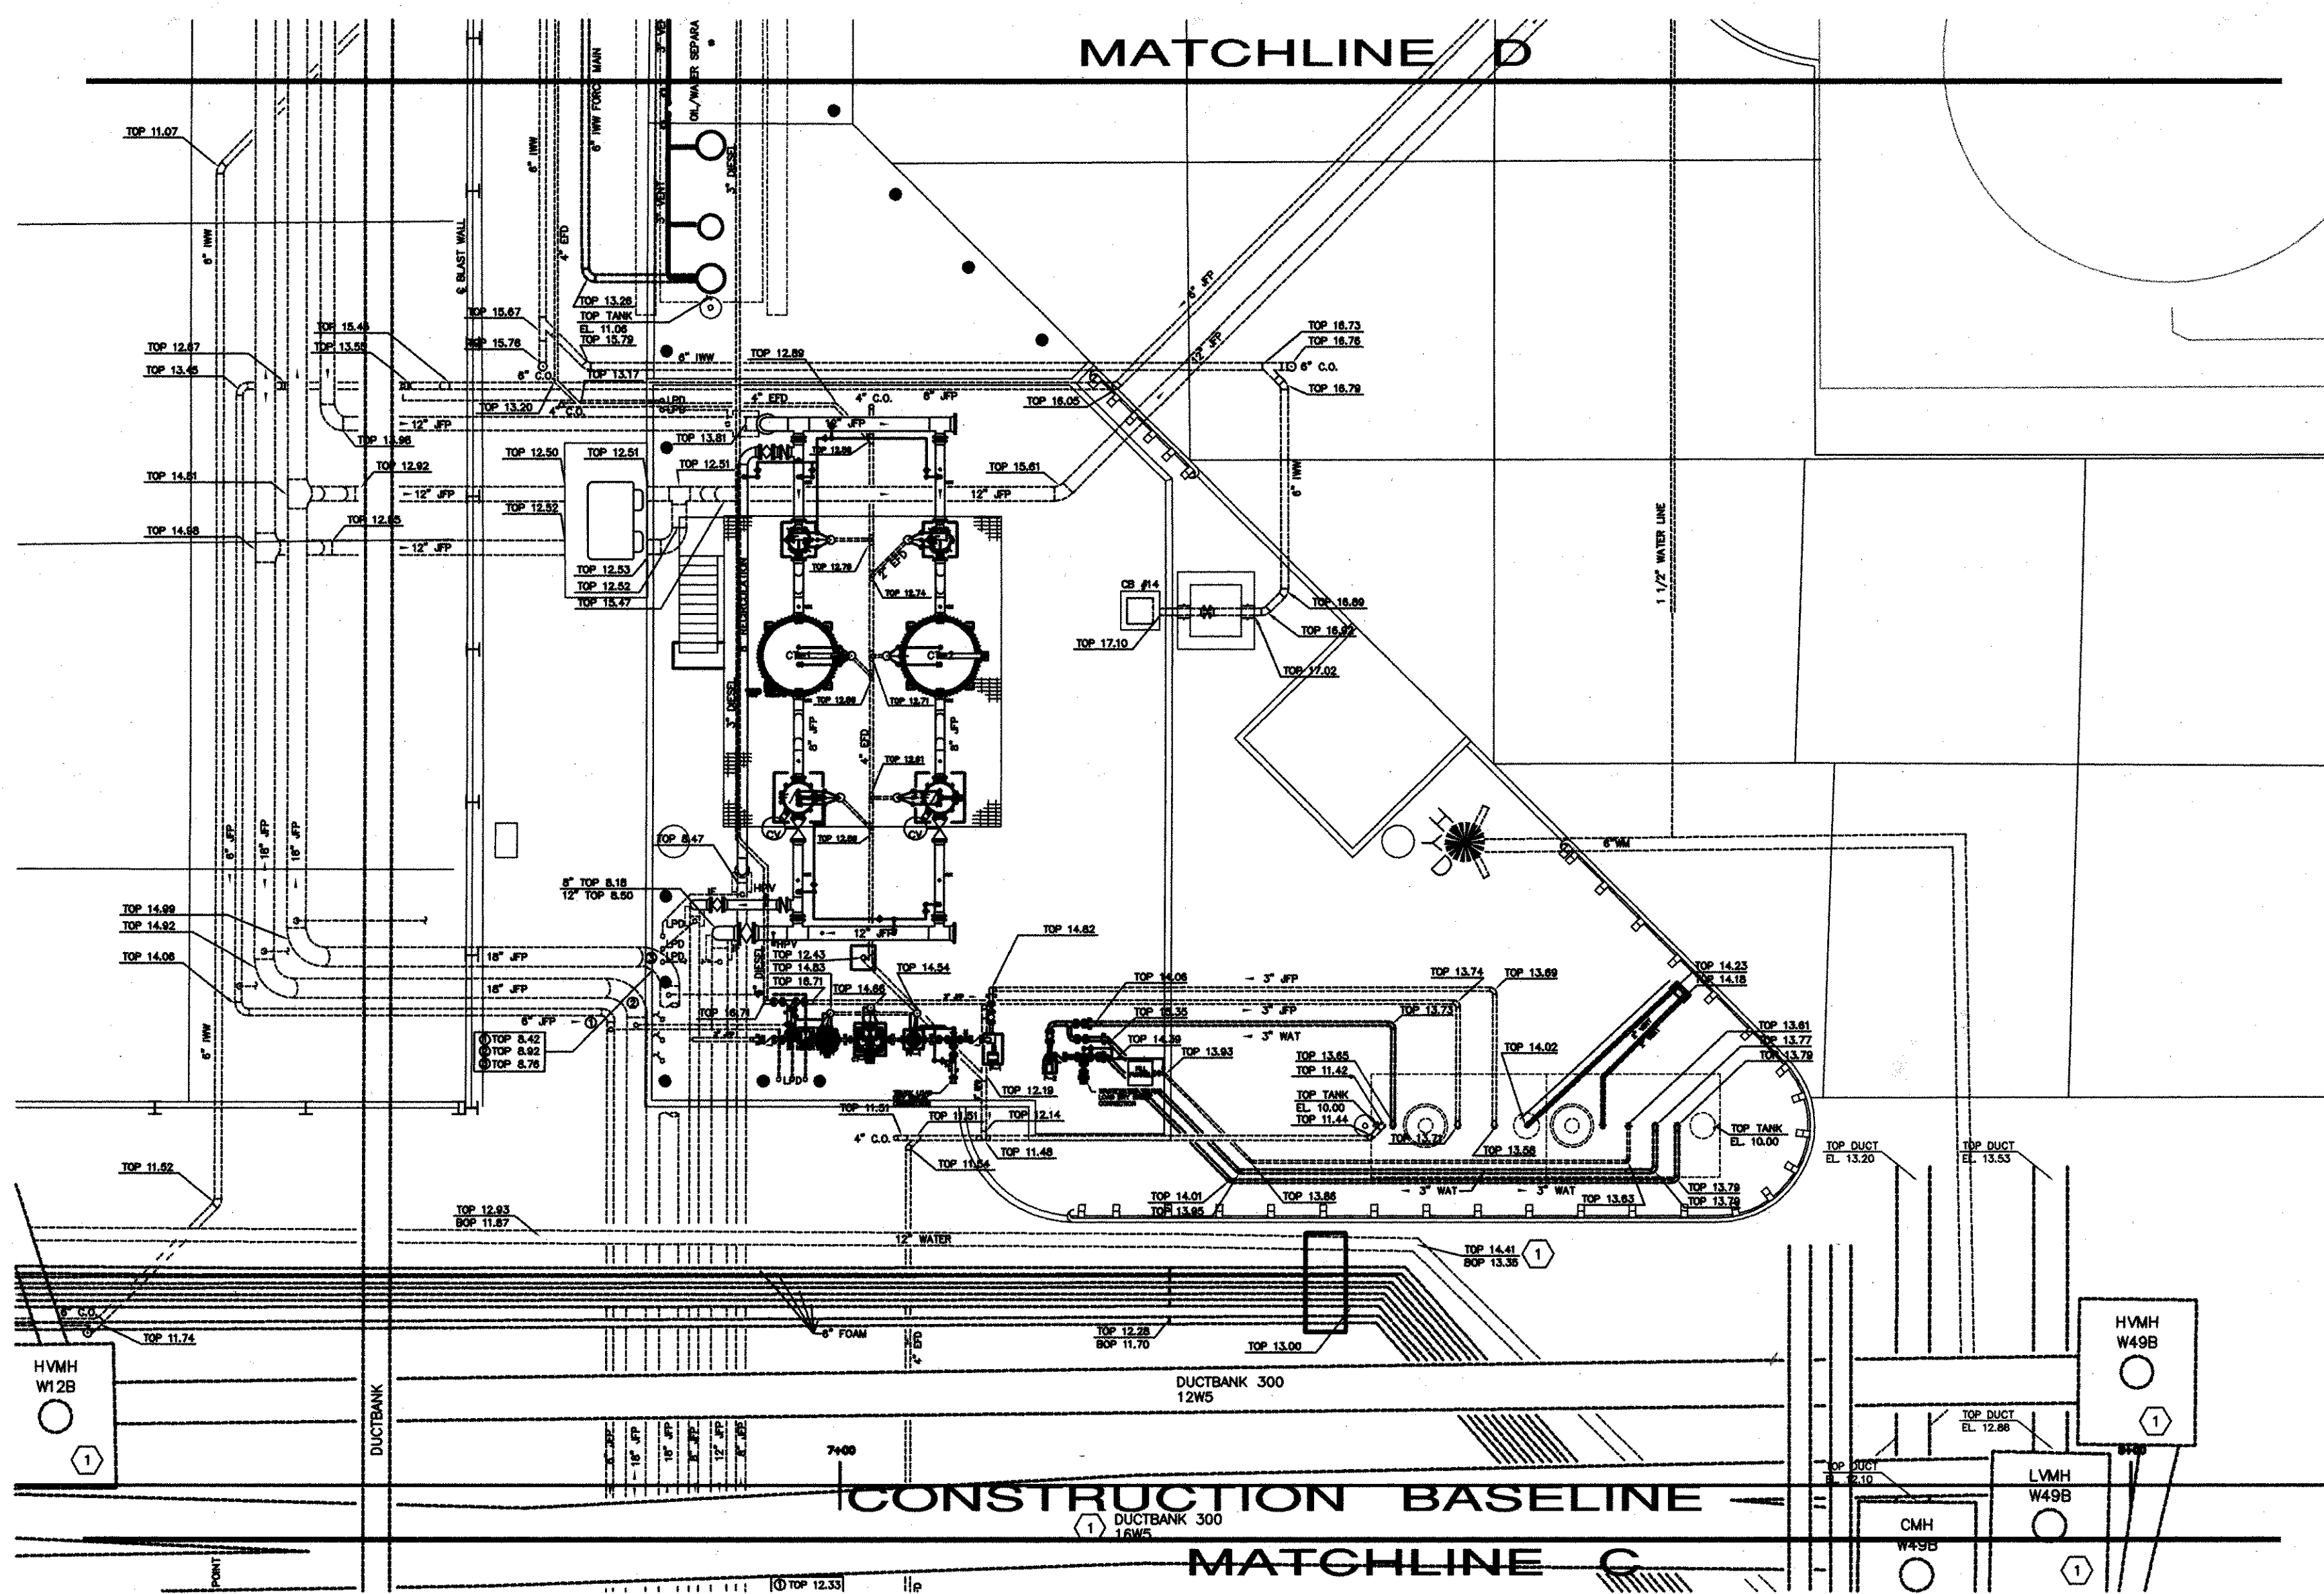

CONSTRUCTION NOTES:

- DRAWINGS U1.01 TO U1.05 WERE PREPARED TO COORDINATE THE EXISTING AND NEW UTILITIES DURING CONSTRUCTION OF THE FUEL STORAGE FACILITY. THESE DRAWINGS INCLUDE A GENERAL LAYOUT OF THESE UTILITIES WITH ELEVATIONS. REFER TO OTHER DISCIPLINES FOR ADDITIONAL DETAIL.

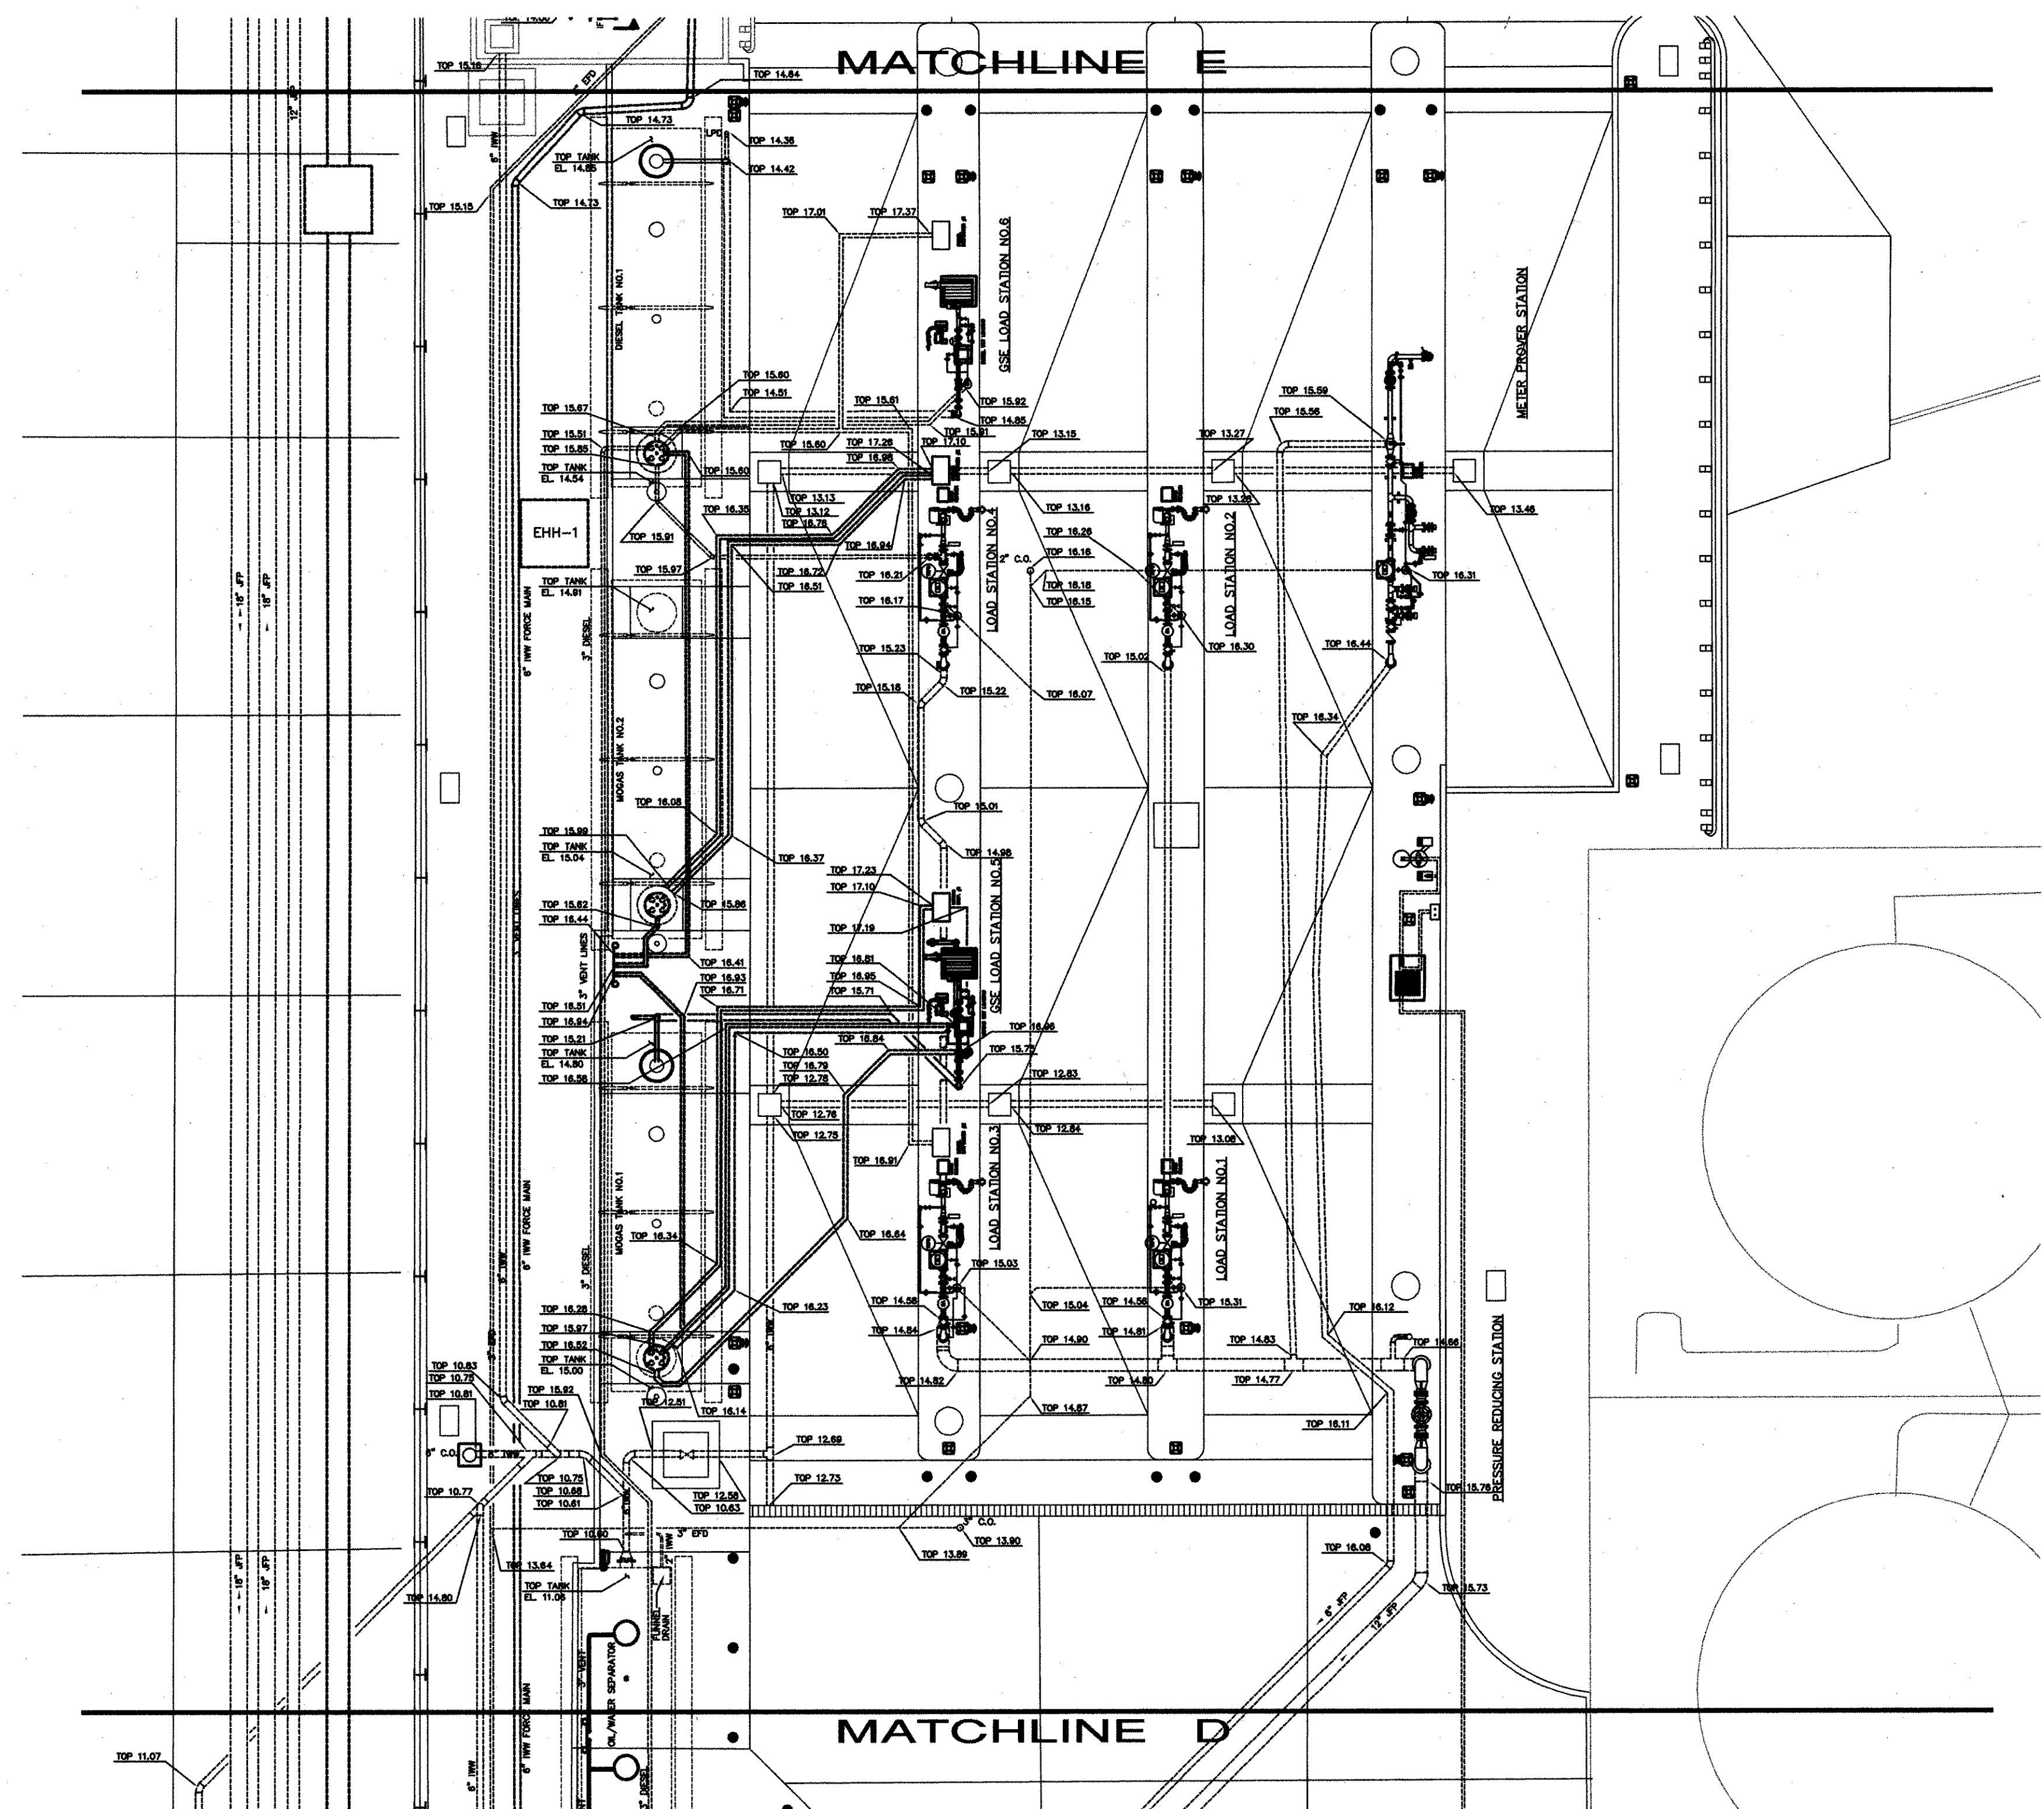


GENERAL NOTES:


- UTILITY COORDINATION DRAWINGS U1.01 THRU U1.04 HAVE BEEN DEVELOPED TO AID CONSTRUCTION AND ARE SUPPLIED TO THE CONTRACTOR AS A CONVENIENCE. DRAWINGS WERE COMPILED BY COMBINING VARIOUS UTILITY DRAWINGS FROM MPA 1.646C (R)- SCHEDULE B, M. DeMATTEO CONSTRUCTION CO. AS-BUILT DRAWINGS DATED 1/23/98 AND ACTUAL FIELD VERIFICATION OF EXISTING UTILITIES BY MASSPORT AND M. DeMATTEO SURVEY UNITS.
- DRAWINGS U1.01 THRU U1.05 ARE PROVIDED AS A CONVIENCE TO THE CONTRACTOR AND SHALL BE USED IN CONJUNCTION WITH MPA 1.646C (R) SCHEDULE B CONTRACT DRAWINGS AND SPECIFICATIONS. THE CONTRACTOR SHALL REPORT ANY APPARENT DISCREPANCY, ERROR OR OMISSIONS IN THESE DRAWINGS TO THE ENGINEER, PRIOR TO COMMENCING THE ASSOCIATED WORK FOR A WRITTEN INTERPRETATION.
- MODIFICATIONS TO UTILITY LOCATIONS AS A RESULT OF AS-BUILT CONDITIONS AND EXISTING UTILITY VERIFICATIONS ARE INDICATED BY REVISION NO. Δ . REFER TO REVISION NOTES FOR ADDITIONAL INFORMATION.
- UTILITY DRAWINGS WERE USED TO ILLUSTRATE UNDERGROUND UTILITY LOCATIONS AND ELEVATIONS ONLY. REFER TO CIVIL, ELECTRICAL, MECHANICAL, INSTRUMENTATION DRAWINGS, ETC. FOR ACTUAL DETAILS OF PIPING AND EQUIPMENT USED.

KEY NOTES

- HORIZONTAL AND VERTICAL LOCATIONS OF UTILITIES AS INDICATED BY M. DeMATTEO CONSTRUCTION CO., AS-BUILT DRAWINGS DATED 1/23/98.
- LOCATION OF FOAM LINES INSTALLED BY M. DeMATTEO PER AS-BUILT DRAWINGS DATED 1/23/98. CONTRACTOR TO MAKE NECESSARY CORRECTIONS TO CONNECT TO AS-DESIGNED LOCATION.

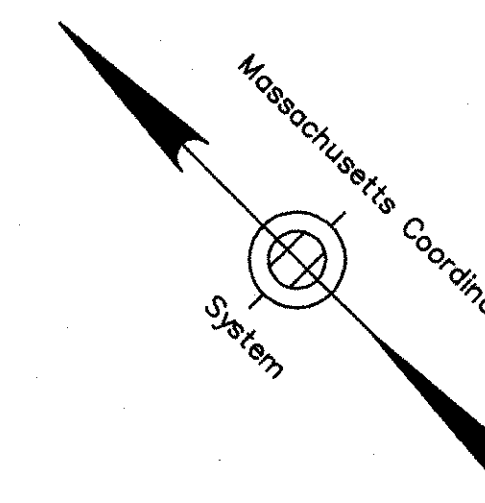

GRAPHIC SCALE

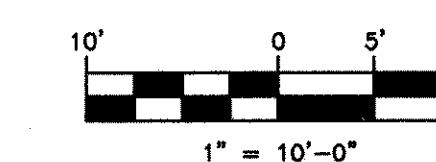

FOR REFERENCE ONLY

AS CONSTRUCTED PLANS
I hereby certify that all construction required by this sheet has been accomplished as indicated

URS Greiner Woodward Clyde, Inc.
BY: *[Signature]* DATE: 1/9/02

REV. NO.	DATE	DESCRIPTION	MADE BY	CHK. BY	APPD. BY
AB	7/99	CONTRACTOR'S AS-BUILT CONDITIONS	DJM	DJM	RAH
MASSACHUSETTS PORT AUTHORITY BOSTON, MASSACHUSETTS					
BOSTON LOGAN INTERNATIONAL AIRPORT EAST BOSTON, MASSACHUSETTS					
AIRCRAFT FUELING SYSTEMS SCHEDULE B - FUEL STORAGE FACILITY FUEL FARM - UTILITY COORDINATION PLANS					
CONSULTANT AND SUBCONSULTANT:					
GREINER INC. TAMPA, FLORIDA EDWARDS AND KELCEY INC. BOSTON, MASSACHUSETTS					
DRAWN BY: CGH		CHKD. BY: CGH/RAH		DWG. NO:	
SCALE: AS SHOWN		APPROVED: RAH		DATE: 3/98	
MPA CONTRACT NO.: MPA 1.646C (R)				SHEET NO. 129 OF 299	


AS BUILT

GENERAL NOTES:

- UTILITY COORDINATION DRAWINGS U1.01 THRU U1.05 HAVE BEEN DEVELOPED TO AID CONSTRUCTION AND ARE SUPPLIED TO THE CONTRACTOR AS A CONVENIENCE. DRAWINGS WERE COMPILED BY COMBINING VARIOUS UTILITY DRAWINGS FROM MPA 1.646C (R) - SCHEDULE B, M. DeMATTEO CONSTRUCTION CO. AS-BUILT DRAWINGS DATED 1/23/98 AND ACTUAL FIELD VERIFICATION OF EXISTING UTILITIES BY MASSPORT AND M. DeMATTEO SURVEY UNITS.
- DRAWINGS U1.01 THRU U1.05 ARE PROVIDED AS A CONVENIENCE TO THE CONTRACTOR AND SHALL BE USED IN CONJUNCTION WITH MPA 1.646C (R) SCHEDULE B CONTRACT DRAWINGS AND SPECIFICATIONS. THE CONTRACTOR SHALL REPORT ANY APPARENT DISCREPANCY, ERROR OR OMISSIONS IN THESE DRAWINGS TO THE ENGINEER PRIOR TO COMMENCING THE ASSOCIATED WORK FOR A WRITTEN INTERPRETATION.
- MODIFICATIONS TO UTILITY LOCATIONS AS A RESULT OF AS-BUILT CONDITIONS AND EXISTING UTILITY VERIFICATIONS ARE INDICATED BY REVISION NO. Δ . REFER TO REVISION NOTES FOR ADDITIONAL INFORMATION.
- UTILITY DRAWINGS WERE USED TO ILLUSTRATE UNDERGROUND UTILITY LOCATIONS AND ELEVATIONS ONLY. REFER TO CIVIL, ELECTRICAL, MECHANICAL, INSTRUMENTATION DRAWINGS, ETC. FOR ACTUAL DETAILS OF PIPING AND EQUIPMENT USED.
- MOBIL PIPELINE & RECEIVING STATION WERE NOT INCLUDED IN THIS CONTRACT. MOBIL PIPELINE & RECEIVING STATION IS SHOWN FOR REFERENCE ONLY. CONTACT MOBIL FOR AS-BUILT DRAWINGS.

KEY NOTES

- HORIZONTAL AND VERTICAL LOCATIONS OF UTILITIES AS INDICATED BY M. DeMATTEO CONSTRUCTION CO., AS-BUILT DRAWINGS DATED 1/23/98.


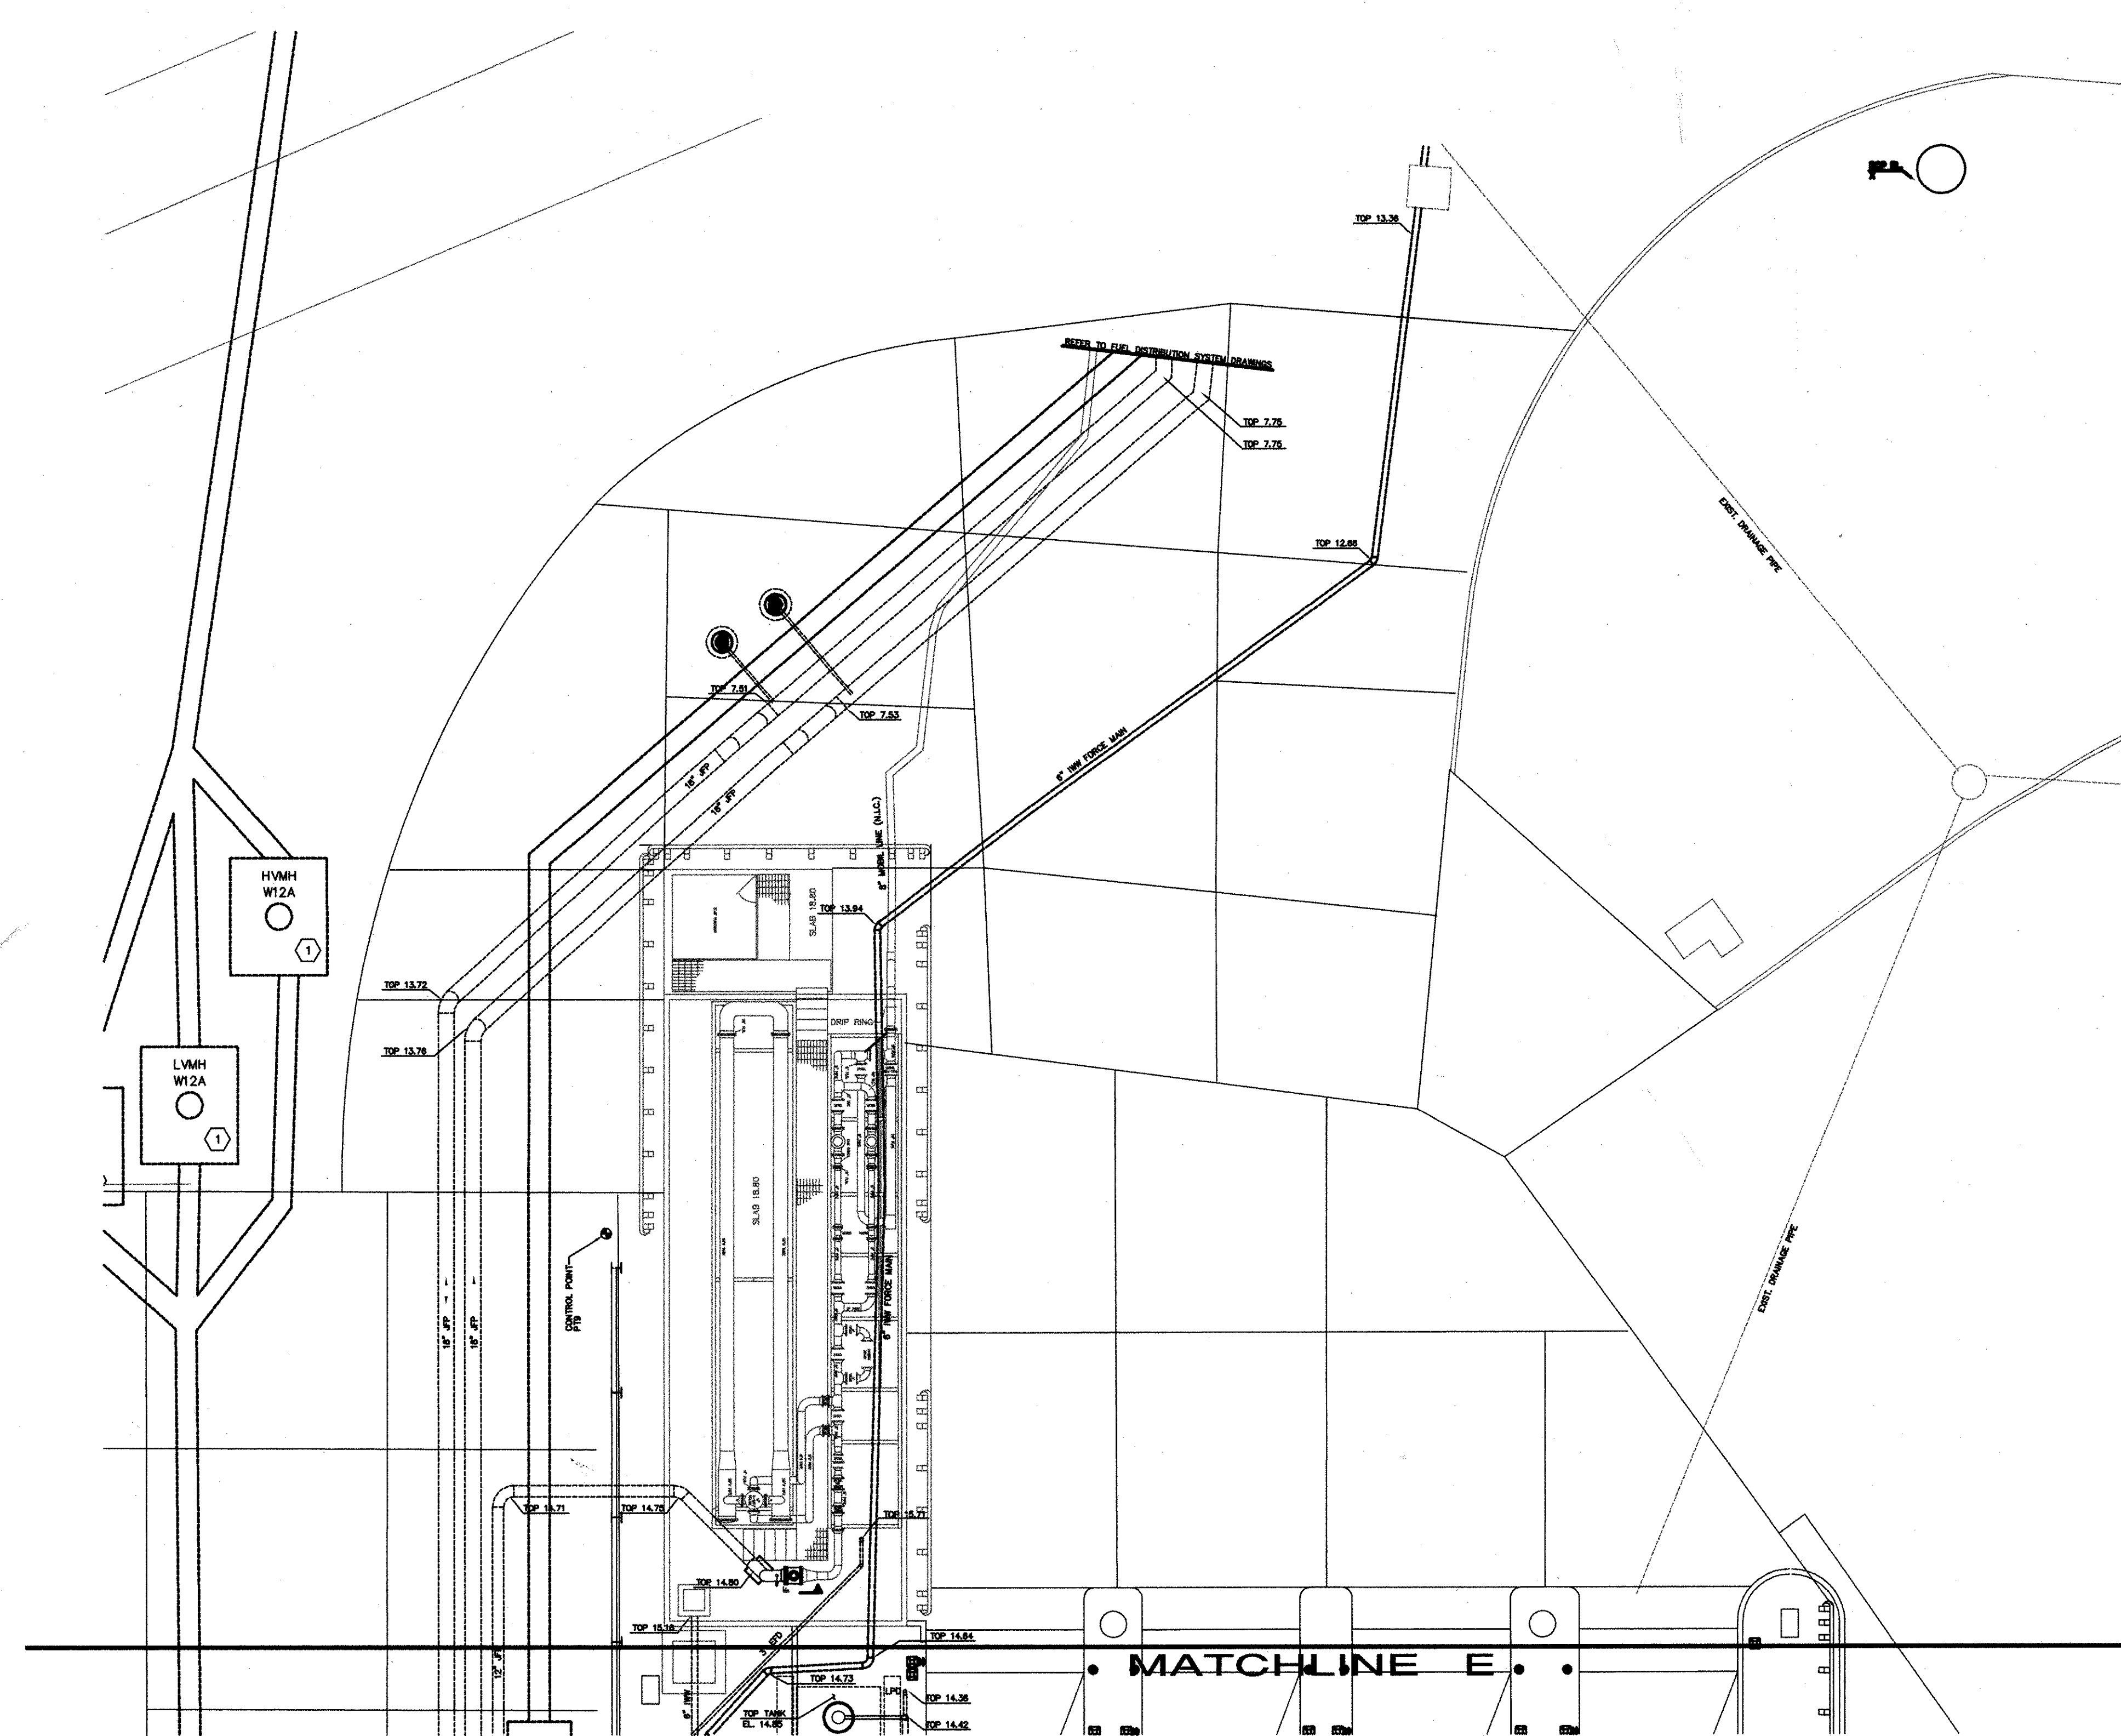


FOR REFERENCE ONLY

AS CONSTRUCTED PLANS
I hereby certify that all construction required
by this sheet has been accomplished as indicated

URS Greiner Woodward Clyde, Inc.
BY: *[Signature]* DATE: *1/28/99*

CONSTRUCTION NOTES:
1. DRAWINGS U1.01 TO U1.05 WERE PREPARED TO COORDINATE THE EXISTING AND NEW UTILITIES DURING CONSTRUCTION OF THE FUEL STORAGE FACILITY. THESE DRAWINGS INCLUDE A GENERAL LAYOUT OF THESE UTILITIES WITH ELEVATIONS. REFER TO OTHER DISCIPLINES FOR ADDITIONAL DETAIL.

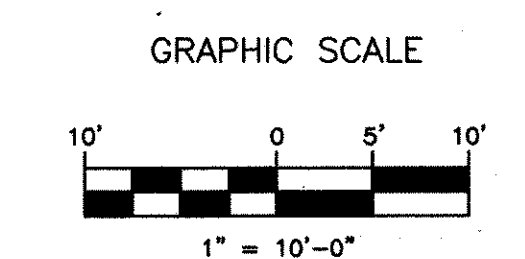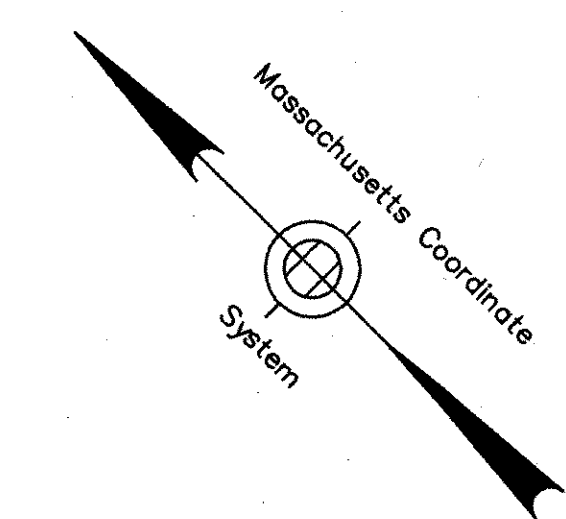

REV. NO.	DATE	DESCRIPTION	MADE BY	CHK. BY	APPD. BY
AB	7/99	CONTRACTOR'S AS-BUILT CONDITIONS		DJM	RAH

MASSACHUSETTS PORT AUTHORITY
BOSTON, MASSACHUSETTS

BOSTON LOGAN INTERNATIONAL AIRPORT
EAST BOSTON, MASSACHUSETTS

AIRCRAFT FUELING SYSTEMS
SCHEDULE B - FUEL STORAGE FACILITY
FUEL FARM - UTILITY COORDINATION PLANS


CONSULTANT AND SUBCONSULTANT:
GREINER INC. TAMPA, FLORIDA
EDWARDS AND KELCEY INC. BOSTON, MASSACHUSETTS

DRAWN BY: CGH	CHKD. BY: CGH/RAH	DWG. NO: U1.05
SCALE: AS SHOWN	APPROVED: RAH	DATE: 3/98

MPA CONTRACT NO.: MPA 1.646C (R) SHEET NO. *100* OF *102*

NOTES

- FOR AREA LIGHTING SEE DWG. NO. E 5.01.
- FOR DUCT BANK SECTIONS AND CABLE DETAILS SEE DWGS. NO. E 2.01 - E 2.03.
- FOR DEMOLITION PLAN SEE DWG. NO. C 2.06.
- FOR SPlicing DETAILS SEE DWG. NO. E 2.04.
- FOR MOV WIRING DIAGRAM SEE DWG. NO. E 5.05.
- FOR ADDITIONAL CONTROL WIRING IN NEW DUCT BANKS SEE DWGS. NO. E 2.01 - E 2.03.
- FOR PUMP CONTROL WIRING SEE DWG. NO. E 3.07.
- CONTRACTOR VERIFIED ALL EXISTING CIRCUITS BEFORE DIGGING. ALL UTILITY LINES WERE DETECTED AND MARKED. ANY DAMAGED UTILITY LINE OR UTILITY SERVICE INTERRUPTION (DUE TO CONSTRUCTION) RESULTED IN LIQUIDATED DAMAGES FOR THE CONTRACTOR.
- DURING INSTALLATION OF NEW DUCT BANK, VEHICULAR TRAFFIC HAD ACCESS TO THE NORTH GATE AT ALL TIMES. CONTRACTOR COORDINATED THIS WORK AT WEEKLY OPERATIONS MEETINGS AND SUBMITTED TRAFFIC/CONSTRUCTION OPERATIONS PLAN FOR APPROVAL.
- CONTRACTOR PULLED EXISTING POWER CABLES BACK TOWARD SOURCE, INSTALLED NEW HANDHOLE WHERE EXISTING CONDUITS TERMINATED AND PULLED EXISTING CABLES TO HANDHOLE. SPliced NEW CABLES TO EXISTING CABLES.
- EXISTING FEED FOR RELOCATED BUS SHELTER ORIGINATED IN THIS BUILDING.
- ELECTRICAL SERVICE FOR MAINTENANCE BUILDING ORIGINATES IN USAIR HANGAR. CONTRACTOR DISCONNECTED SERVICE BEFORE ANY DEMOLITION BEGAN. FOR DETAIL SEE DWG. NO. E 4.04.
- FOR CABLE REMOVAL SEE DWGS. NO. E 6.01 AND E 6.02.
- CONTRACTOR INSTALLED 8 CCTV CAMERAS AT LOCATIONS TO BE DETERMINED DURING CONSTRUCTION. FOR A DESCRIPTION OF CAMERA SEE CONTRACT SPECIFICATIONS. EACH CAMERA RECEIVED SEPERATE POWER AND CONROL FEEDS. WIRING DETAILS FOR CCTV CAMERAS ARE AS FOLLOWS:
 - POWER FEED - 3#12 AWG (USE INSULATION 600V)
 - CONTROL FEED - 1 PAIR (TWISTED SHIELDED INSTRUMENTATION CABLE) 18 AWG (USE INSULATION 600V)
 - CAC6 CABLE
 - RG59 COILCORD
- CONTRACTOR LEFT 20' OF SLACK FIBER OPTIC CABLE IN EACH MANHOLE.
- EXISTING MANHOLE WAS REMOVED. FOR DETAILS OF DEMOLITION SEE DWG. NO. C 2.07. FOR CABLE REMOVAL FROM THESE MANHOLES SEE DWGS. NO. E 6.01 AND E 6.02.

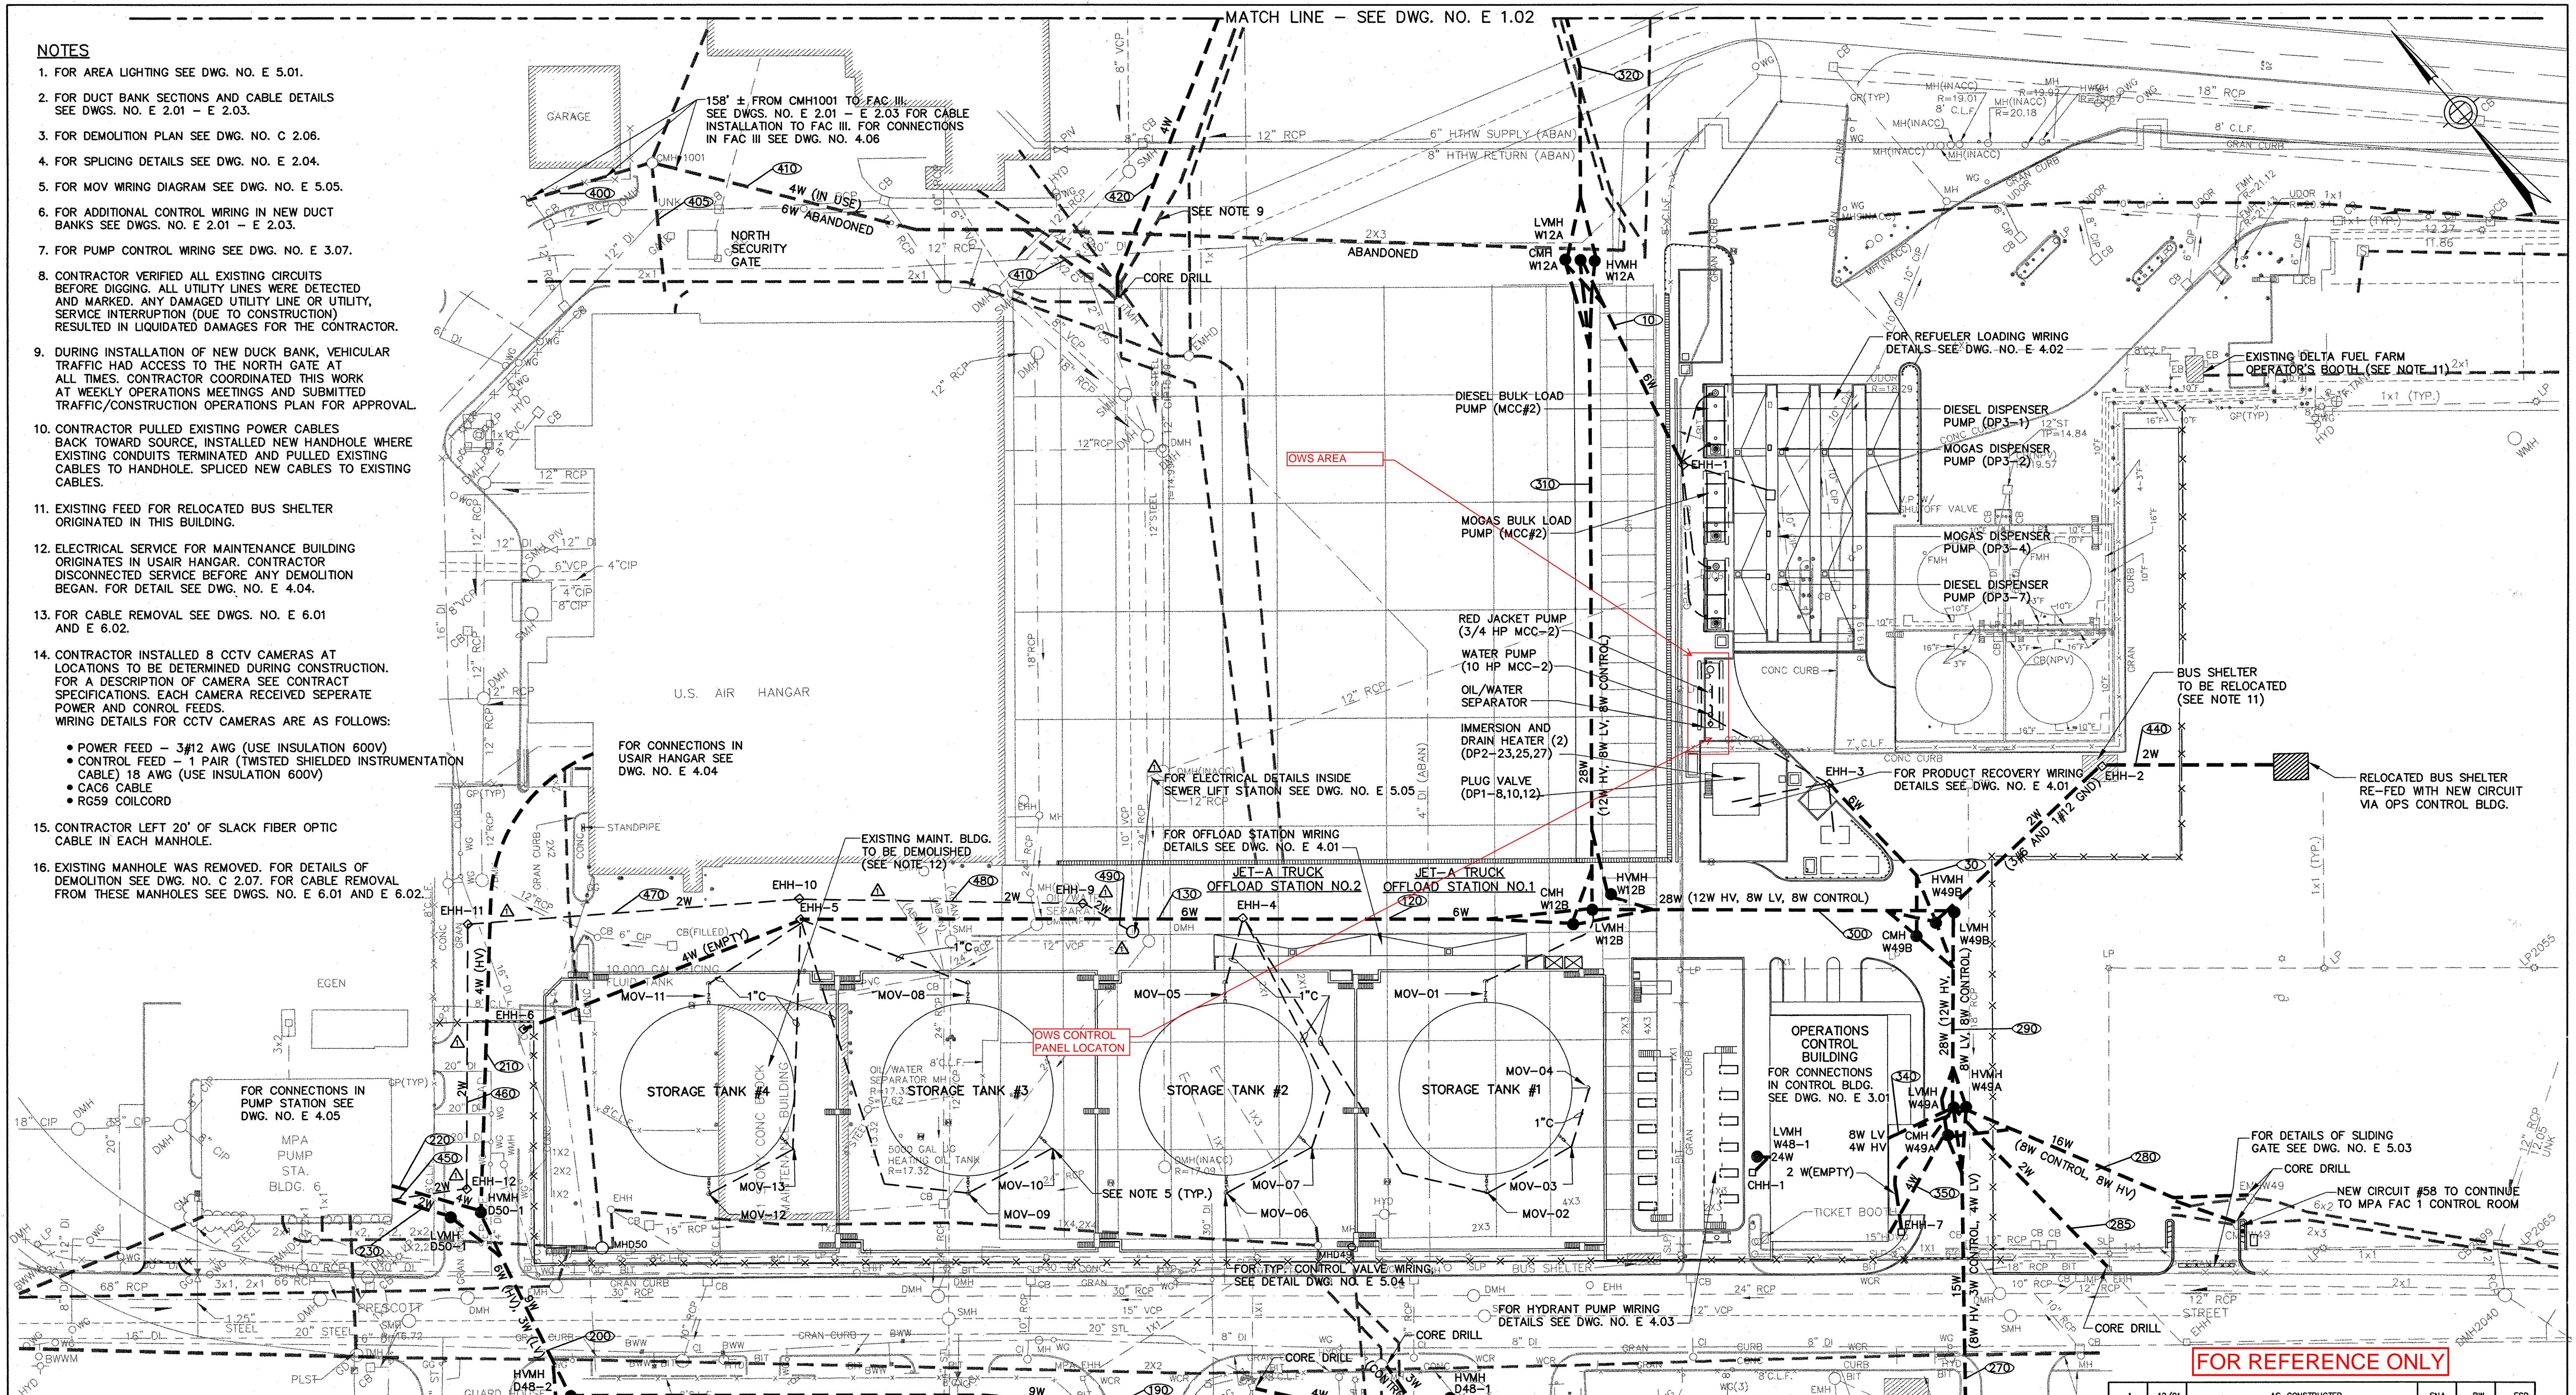

LEGEND					
PROPOSED	EXISTING	ITEM	PROPOSED	EXISTING	ITEM
■ CB	□ C.B.	CATCH BASIN	---	---	SEWERAGE LINE
● SMH	○ SMH	SEWER MANHOLE	---	---	DRAINAGE LINE
● DMH	○ DMH	DRAIN MANHOLE	---	---	WATER LINE
● EMH	○ EMH	ELECTRIC MANHOLE	---	---	GAS LINE
□ EHH	□ EHH	ELECTRIC HANDHOLE (TYPE II)	---	---	FUEL LINE
○ WMH	○ WMH	WATER MANHOLE	---	---	DUCT BANK
● CMH	○ CMH	CONTROL MANHOLE	---	---	DIRECT BURIED 1" RSC UNLESS OTHERWISE NOTED
○ TMH	○ TMH	TELEPHONE MANHOLE	---	---	MONITORING WELL
○ WG	○ WG	WATER GATE	---	---	DOUBLE FIXTURE LIGHT POLE WITH HANHOLE (TYPE I)
○ HYD	○ HYD	FIRE HYDRANT	---	---	SINGLE FIXTURE LIGHT POLE WITH HANHOLE (TYPE I)
○ GG	○ GG	GAS GATE	---	---	DUCT BANK I.D.
---	---	CURB INLET	---	---	BLAST WALL
---	---	CHAIN LINK FENCE	---	---	MANHOLE TO BE REMOVED SEE NOTE 16

FOR REFERENCE ONLY

1	12/01	AS-COMPLETED	SNA	RW	ESD
2	7/1/97	UTILITY RELOCATION/SEWER LIFT STATION	CHK	RW	APPD.
REV. NO.	DATE	DESCRIPTION	MADE BY	CHK BY	APPD. BY

MASSACHUSETTS PORT AUTHORITY
BOSTON, MASSACHUSETTS

BOSTON LOGAN INTERNATIONAL AIRPORT
EAST BOSTON, MASSACHUSETTS

AIRCRAFT FUELING SYSTEMS
SCHEDULE B - FUEL STORAGE FACILITY
ELECTRICAL PLAN 1

CONSULTANT AND SUBCONSULTANT:
GREINER INC. TAMPA, FLORIDA
EDWARDS AND KELCEY INC. BOSTON, MASSACHUSETTS

DRAWN BY: SDR	CHKD. BY: RW	DWG. NO: E 1.01
SCALE: AS SHOWN	APPROVED: JM	DATE: 11/96

MPA CONTRACT NO.: MPA 1.646C (R) SHEET NO. 75 OF 200

AS BUILT



*** CONDUIT AND CABLE FEEDER SIZES**

- Ⓐ 3#500MCM AND 1#1 GND.-4°C
- Ⓑ 3#10 AND 1#10 GND.-1°C
- Ⓒ 3#6 AND 1#10 GND.-1°C
- Ⓓ 3#12 AND 1#12 GND.-1°C
- Ⓔ 3#4/0 AND 1#6 GND.-2°C
- Ⓕ 2(3#350 MCM AND 1#2 GND.-4°C)SETS
- Ⓖ 3#1/0 AND 1#6 GND.-2°C
- Ⓗ 4#1 AND 1#8 GND.-1 1/2°C
- Ⓘ 3#6 AND 1#10 GND.-1°C
- Ⓚ 3#350MCM AND 1#1 GND.-4°C

*** LEGEND**

SYMBOL	FUNCTION
ATC	AUTOMATIC TRANSFER CONTROL
K	KIRK KEY INTERLOCK
IQ	IQ ANALYZER
27/47	UNDER/OVER VOLTAGE RELAY
M	METER (KW)
MFS	MAIN FEED SWITCH (15KV)

EXISTING WOOD ISLAND SUBSTATION

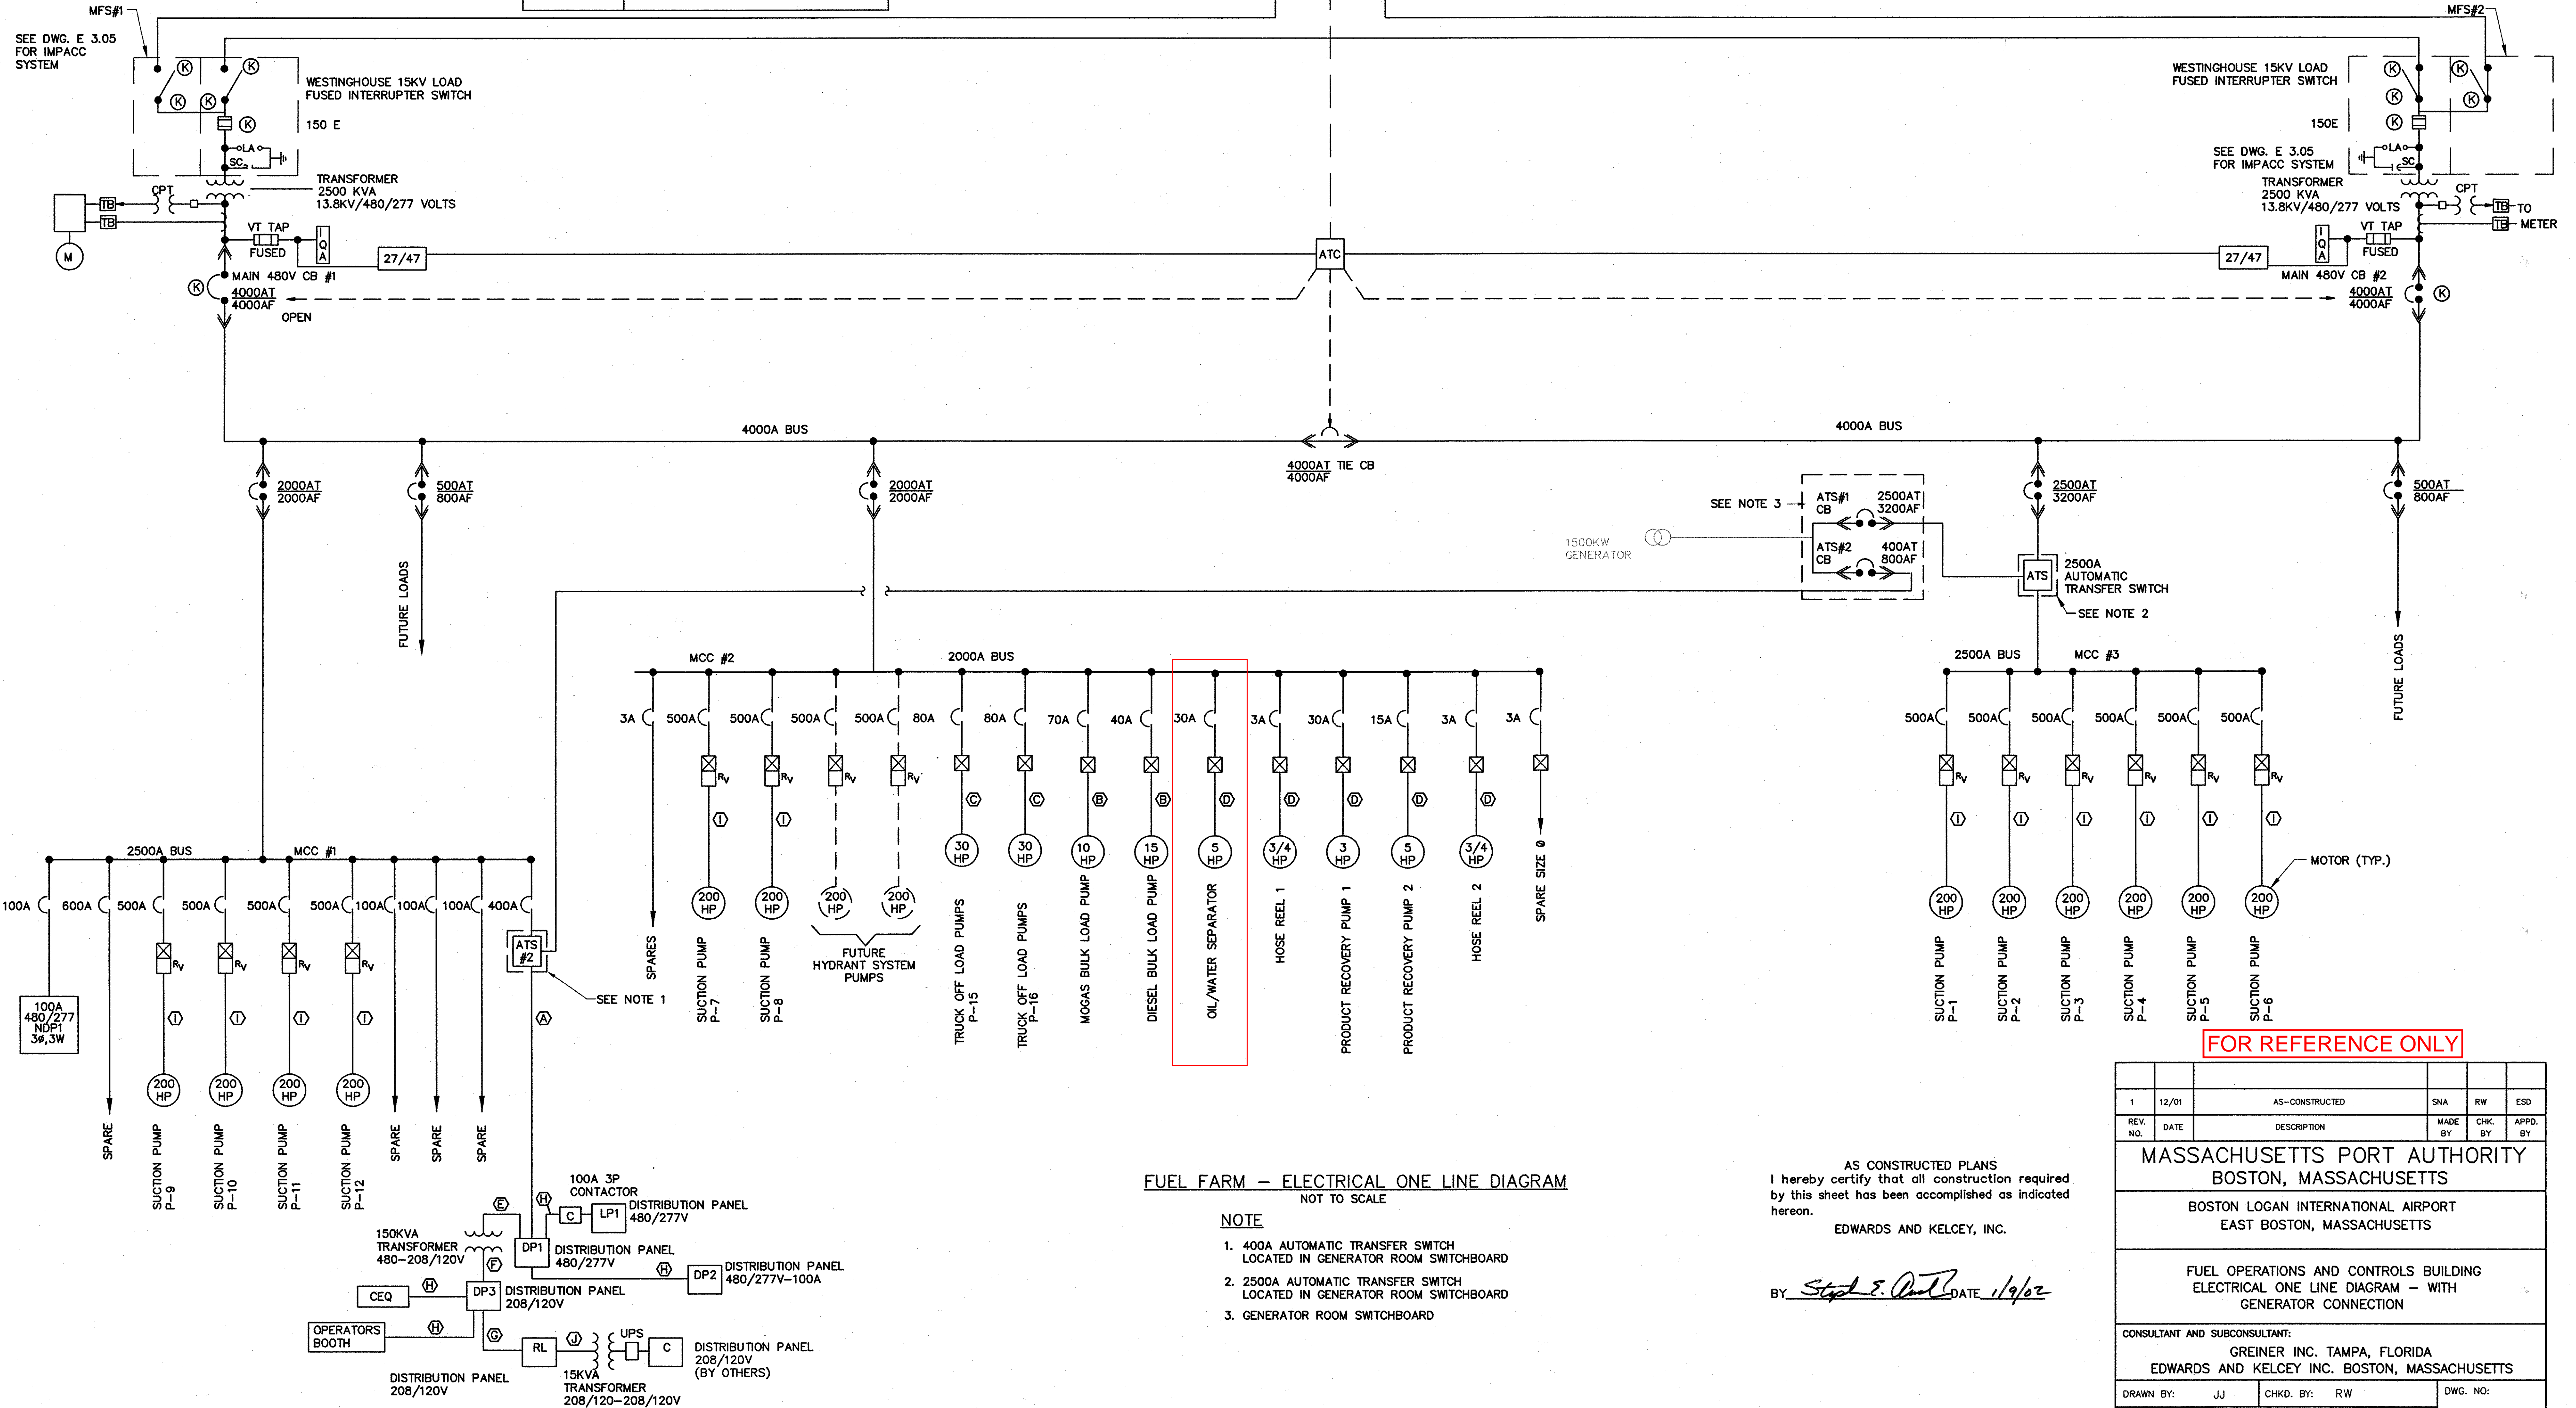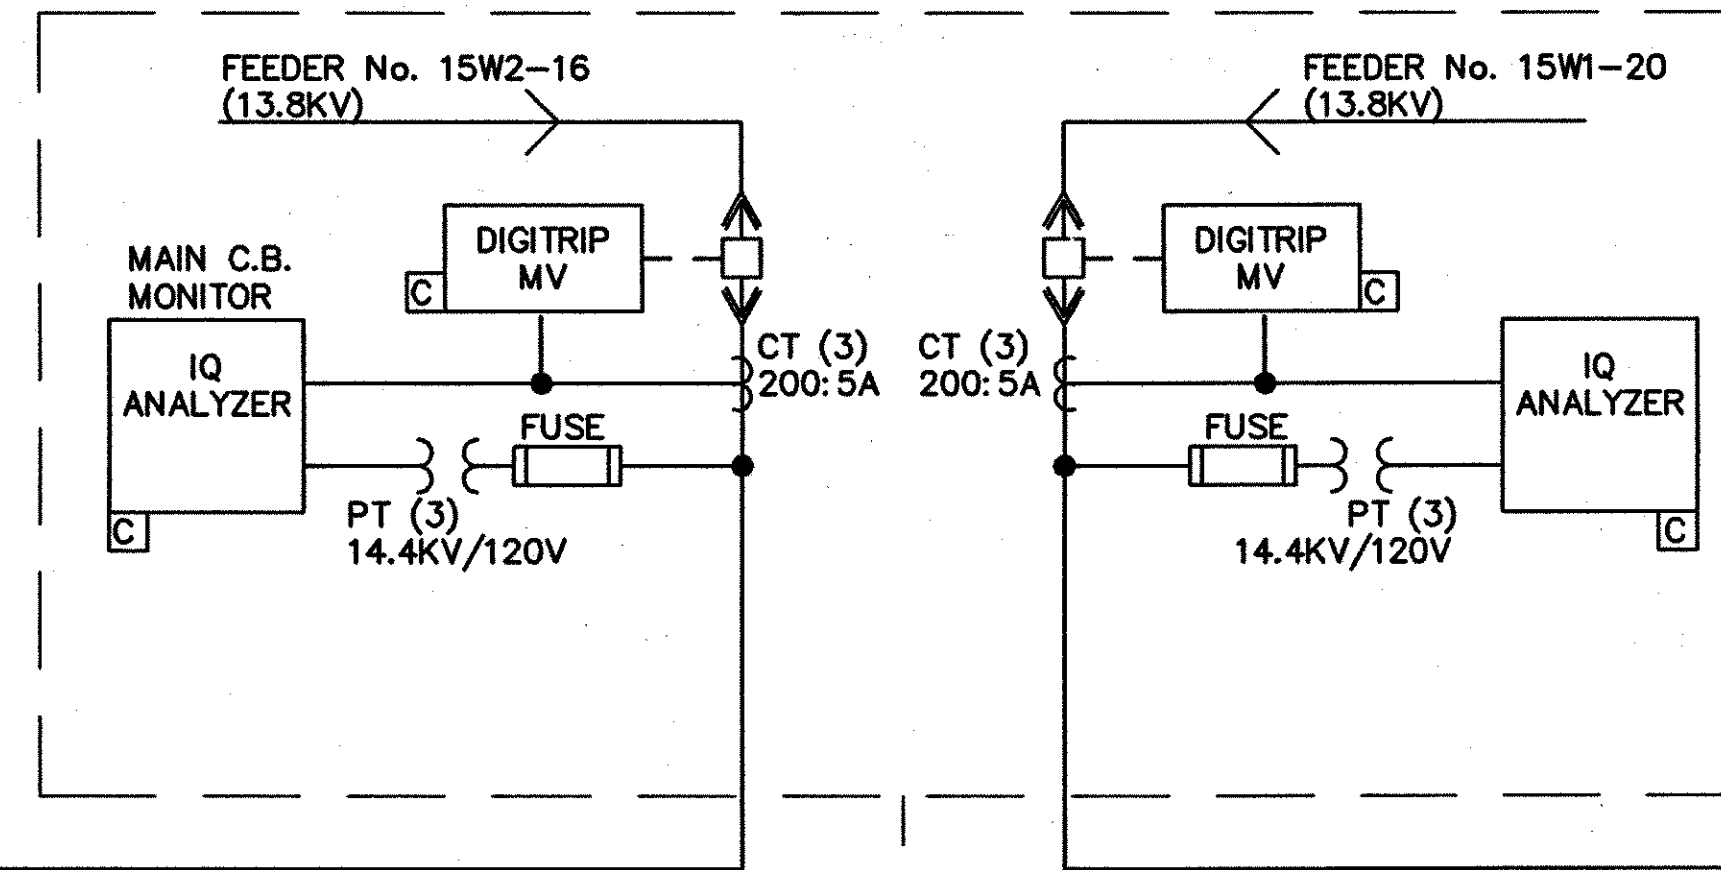

FUEL FARM - ELECTRICAL ONE LINE DIAGRAM
NOT TO SCALE

- NOTE**
- 400A AUTOMATIC TRANSFER SWITCH LOCATED IN GENERATOR ROOM SWITCHBOARD
 - 2500A AUTOMATIC TRANSFER SWITCH LOCATED IN GENERATOR ROOM SWITCHBOARD
 - GENERATOR ROOM SWITCHBOARD

AS CONSTRUCTED PLANS
I hereby certify that all construction required by this sheet has been accomplished as indicated hereon.
EDWARDS AND KELCEY, INC.

BY *Steph E. Quill* DATE *1/9/02*

FOR REFERENCE ONLY

REV. NO.	DATE	DESCRIPTION	MADE BY	CHK. BY	APPD. BY
1	12/01	AS-CONSTRUCTED	SNA	RW	ESD

MASSACHUSETTS PORT AUTHORITY
BOSTON, MASSACHUSETTS

BOSTON LOGAN INTERNATIONAL AIRPORT
EAST BOSTON, MASSACHUSETTS

FUEL OPERATIONS AND CONTROLS BUILDING
ELECTRICAL ONE LINE DIAGRAM - WITH
GENERATOR CONNECTION

CONSULTANT AND SUBCONSULTANT:
GREINER INC. TAMPA, FLORIDA
EDWARDS AND KELCEY INC. BOSTON, MASSACHUSETTS

DRAWN BY: JJ CHKD. BY: RW DWG. NO.:
SCALE: NONE APPROVED: PRH DATE: 7/97 E 3.03

MPA CONTRACT NO.: MPA 1.646C(R) SHEET NO. 07 OF 200

AS BUILT

MCC SCHEDULE								
MCC No.	SECTION	BUS	DESCRIPTION	STARTER SIZE/TYPE	CIRCUIT BREAKER RATING (IN AMPS)	FEEDER	REMARKS	
1	INCOMING	2500A					12 X IC 500 MCM 600V INSC 2 X IC - (4/0) G	
	PUMP P-9		200 HP	SIZE 5 AUTO-TRANS	500	4"C-3#350MCM AND 1#1 GROUND	IC RATING 65,000A	
	PUMP P-10		200 HP	SIZE 5 AUTO-TRANS	500	4"C-3#350MCM AND 1#1 GROUND	IC RATING 65,000A	
	PUMP P-11		200 HP	SIZE 5 AUTO-TRANS	500	4"C-3#350MCM AND 1#1 GROUND	IC RATING 65,000A	
	PUMP P-12		200 HP	SIZE 5 AUTO-TRANS	500	4"C-3#350MCM AND 1#1 GROUND	IC RATING 65,000A	
	ATS #2		400A-NORMAL SIDE FEED		400	4"C-4#500 MCM AND 1#2 GROUND	IC RATING 65,000A	
			SPACE					
			SPACE					
	CIRCUIT BREAKER		SPARE			600		IC RATING 65,000A
			SPACE					IC RATING 65,000A
			SPACE					IC RATING 65,000A
			SPACE					IC RATING 65,000A
	CIRCUIT BREAKER		SPARE			100		IC RATING 65,000A
	PANEL/NDPI		12 CKT PANEL	480 VOLT		100A MCB	W (2) 3P 50A SPACE FOR 2 ADDITIONAL	IC RATING 65,000A
2	INCOMING	2000A					12 X IC 500 MCM 600V INSC 2 X IC - (4/0) G	
	PUMP P-7		200 HP	SIZE 5 AUTO-TRANS	500	4"C-3#350MCM AND 1#1 GROUND	IC RATING 65,000A	
	PUMP P-8		200 HP	SIZE 5 AUTO-TRANS	500	4"C-3#350MCM AND 1#1 GROUND	IC RATING 65,000A	
	(FUTURE PUMP)			SIZE 5 AUTO-TRANS	500		IC RATING 65,000A	
	(FUTURE PUMP)			SIZE 5 AUTO-TRANS	500		IC RATING 65,000A	
	TRUCK-OFF LOAD PUMP		30 HP	SIZE 3	80	1"C-3#6 AND 1#10 GROUND	IC RATING 65,000A	
	TRUCK-OFF LOAD PUMP		30 HP	SIZE 3	80	1"C-3#6 AND 1#10 GROUND	IC RATING 65,000A	
	MOGAS BULK LOAD PUMP		10 HP	SIZE 1	30	1"C-3#10 AND 1#10 GROUND	IC RATING 65,000A	
	DIESEL BULK LOAD PUMP		15 HP	SIZE 2	40	1"C-3#10 AND 1#10 GROUND	IC RATING 65,000A	
	OIL/WATER SEPARATOR		5 HP	SIZE 1	30	1"C-3#12 AND 1#12 GROUND	IC RATING 65,000	
	PRODUCT REC-PUMP 1		3 HP	SIZE 1	30	1"C-3#12	IC RATING 65,000A	
	PRODUCT REC-PUMP 2		5 HP	SIZE 1	15	1"C-3#12	IC RATING 65,000A	
	HOSE REEL #1		3/4 HP	SIZE 1	3	1"C-3#12	IC RATING 65,000A	
	HOSE REEL #2		3/4 HP	SIZE 1	3	1"C-3#12	IC RATING 65,000A	
			SPACE					
			SPACE					
			SPACE					
			SPACE					
	3	INCOMING	2500A					6 x 3C- (500MCM) 600V, 600V, MC JACKET
		SPARE						IC RATING 65,000A
		SPARE						IC RATING 65,000A
SPARE				SIZE 1	15		IC RATING 65,000A	
PUMP P-1			200 HP	SIZE 5 AUTO-TRANS	500	4"C-3#350MCM AND 1#1 GROUND	IC RATING 65,000A	
PUMP P-2			200 HP	SIZE 5 AUTO-TRANS	500	4"C-3#350MCM AND 1#1 GROUND	IC RATING 65,000A	
PUMP P-3			200 HP	SIZE 5 AUTO-TRANS	500	4"C-3#350MCM AND 1#1 GROUND	IC RATING 65,000A	
PUMP P-4			200 HP	SIZE 5 AUTO-TRANS	500	4"C-3#350MCM AND 1#1 GROUND	IC RATING 65,000A	
PUMP P-5			200 HP	SIZE 5 AUTO-TRANS	500	4"C-3#350MCM AND 1#1 GROUND	IC RATING 65,000A	
PUMP P-6			200 HP	SIZE 5 AUTO-TRANS	500	4"C-3#350MCM AND 1#1 GROUND	IC RATING 65,000A	

AS CONSTRUCTED PLANS
I hereby certify that all construction required
by this sheet has been accomplished as indicated
hereon.

EDWARDS AND KELCEY, INC.
BY Steph S. Ortiz DATE 1/9/02

FOR REFERENCE ONLY

NOTE
FOR LOCATION OF MCC'S, SEE DWG. NO E 3.02.

REV. NO.	DATE	DESCRIPTION	MADE BY	CHK. BY	APPD. BY
1	12/01	AS-CONSTRUCTED	SNA	RW	ESD

MASSACHUSETTS PORT AUTHORITY
BOSTON, MASSACHUSETTS

BOSTON LOGAN INTERNATIONAL AIRPORT
EAST BOSTON, MASSACHUSETTS

AIRCRAFT FUELING SYSTEMS
SCHEDULE B - FUEL STORAGE FACILITY
MCC SCHEDULE


CONSULTANT AND SUBCONSULTANT:
GREINER INC. TAMPA, FLORIDA
EDWARDS AND KELCEY INC. BOSTON, MASSACHUSETTS

DRAWN BY: TED CHKD. BY: RW DWG. NO:
SCALE: NONE APPROVED: JM DATE: 11/96 E 3.09


MPA CONTRACT NO.: MPA 1.646C (R) SHEET NO. 93 OF 200

AS BUILT

TO EHH 5
SEE DWG. NO. E 1.01

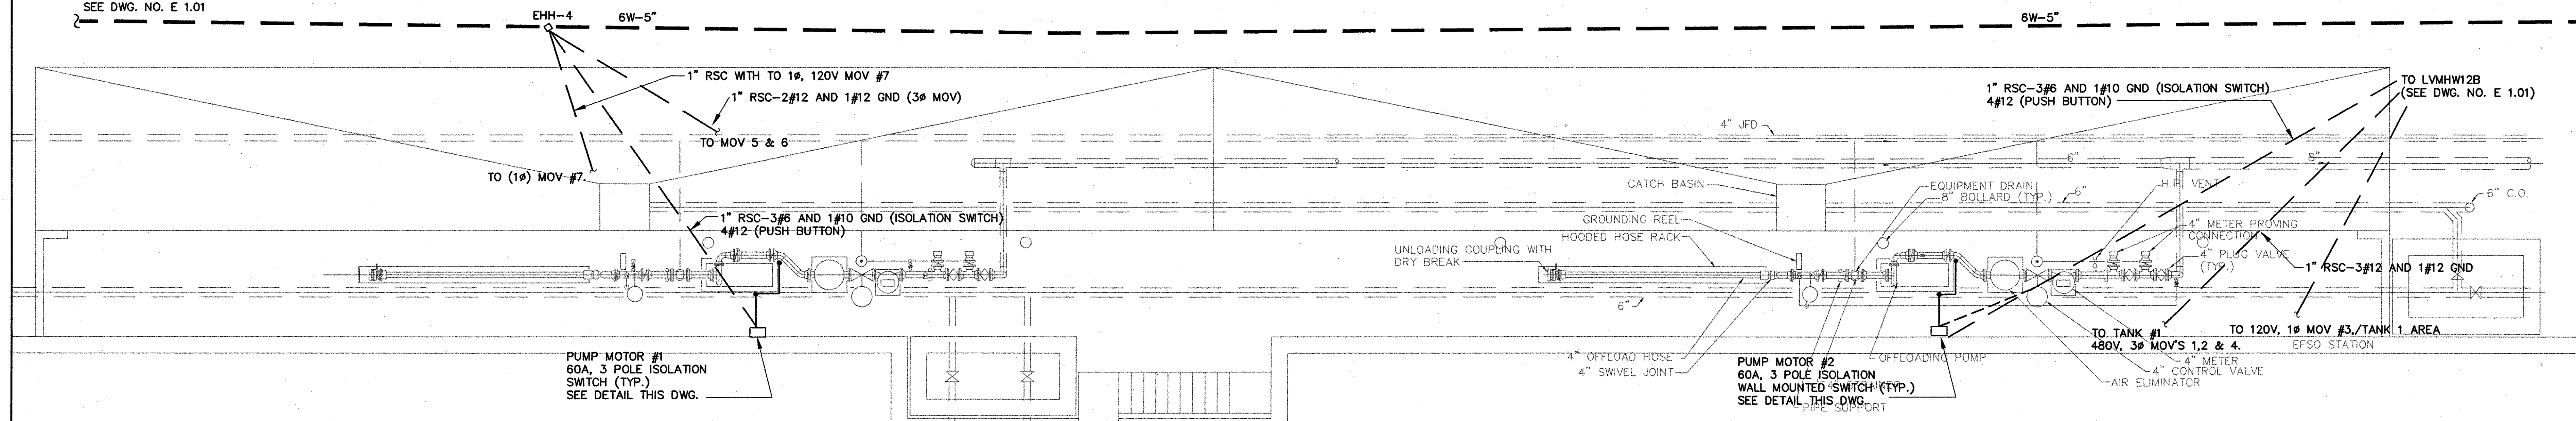


TRUCK OFFLOAD STATIONS AREA PLAN
SCALE: 1"=4'

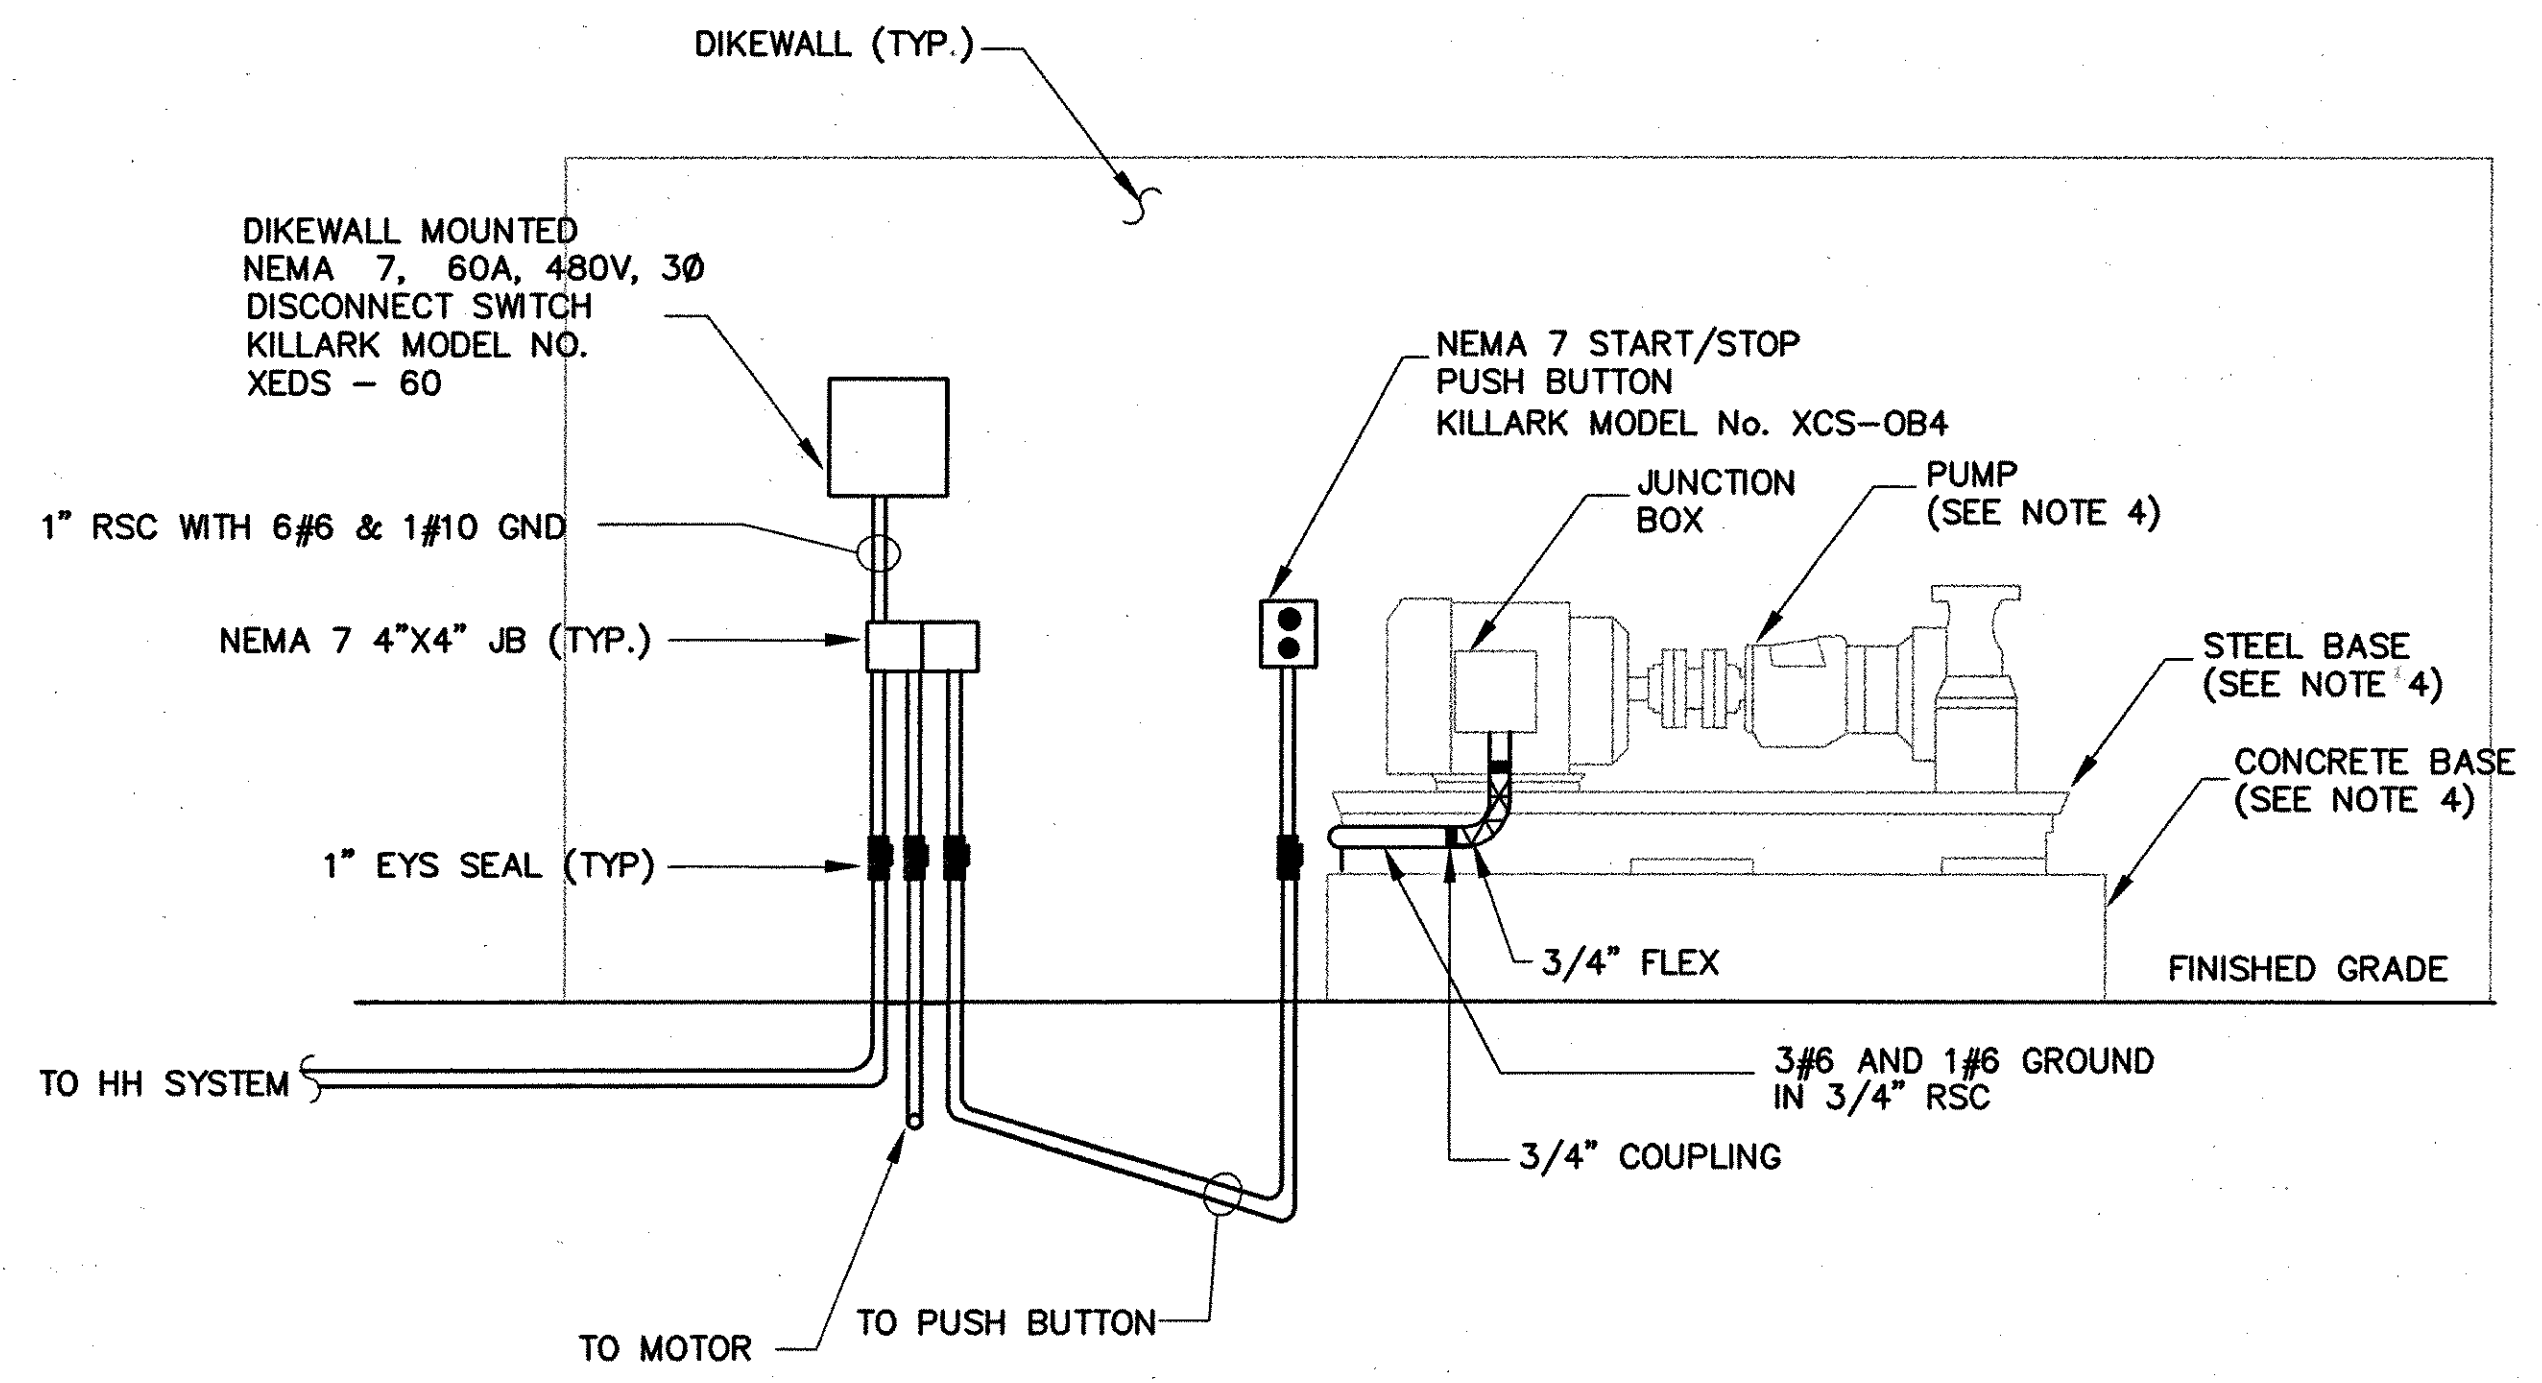


TRUCK OFF LOAD PUMP CONNECTION
NOT TO SCALE


FOR REFERENCE ONLY

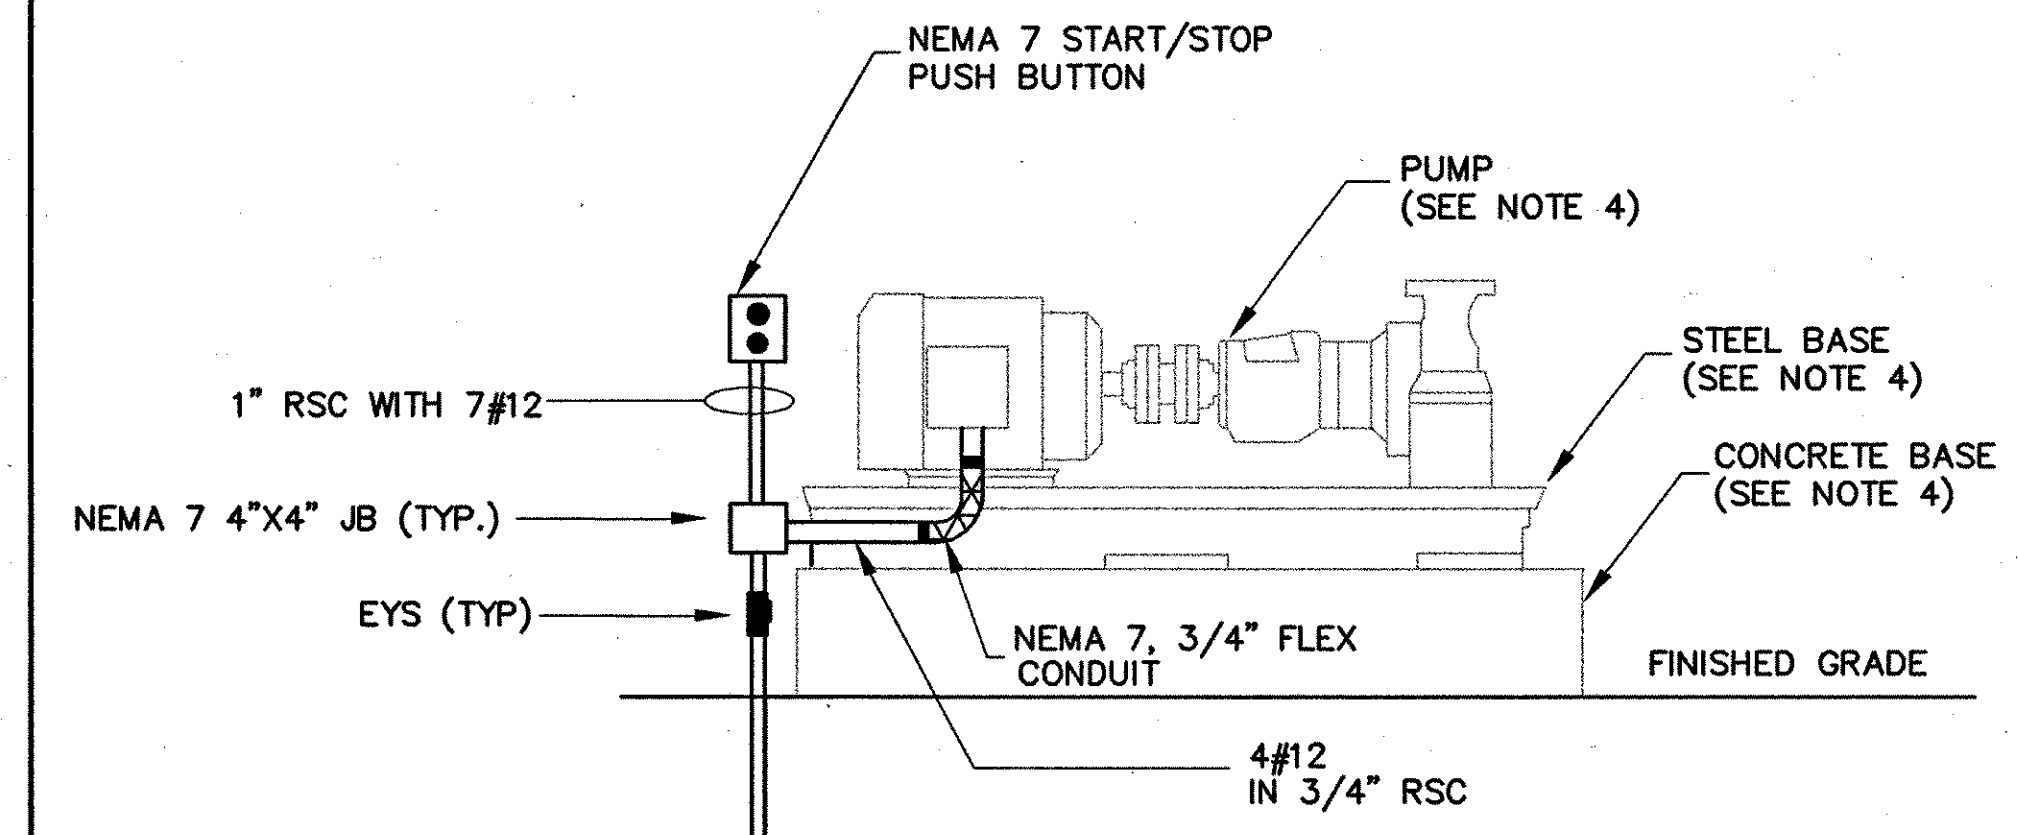

PRODUCT RECOVERY PUMP DETAIL
NOT TO SCALE

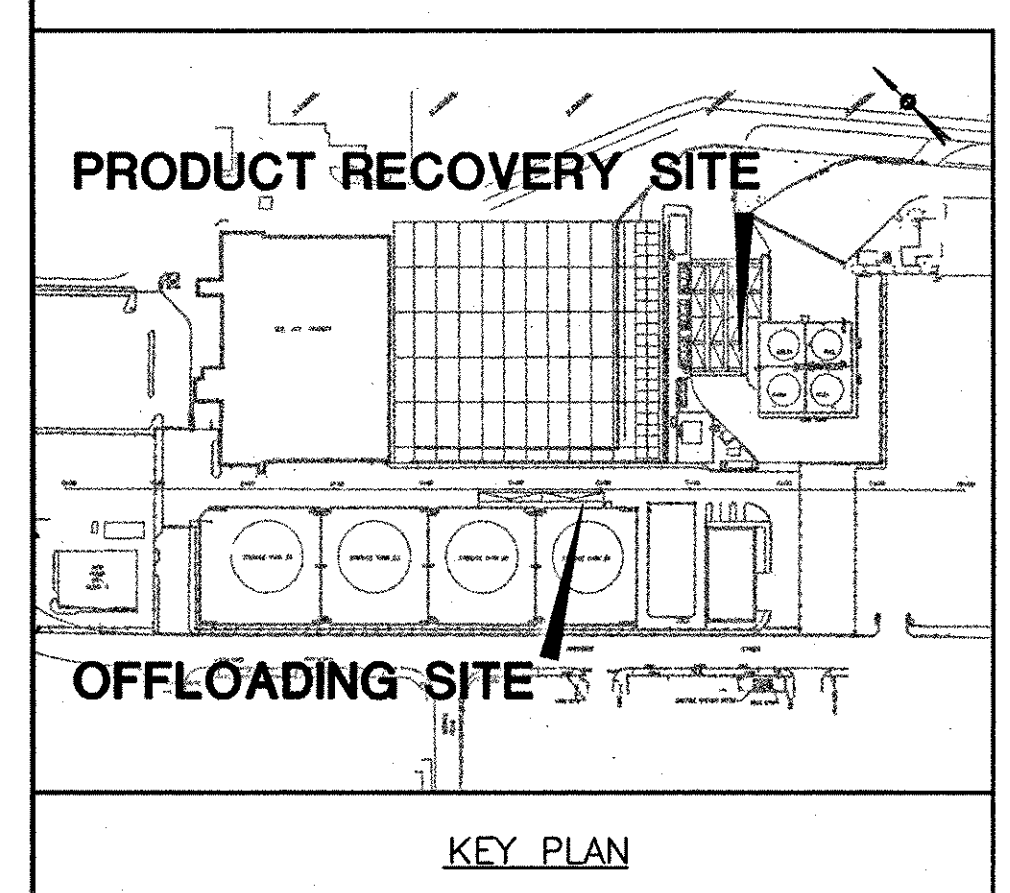


KEY PLAN

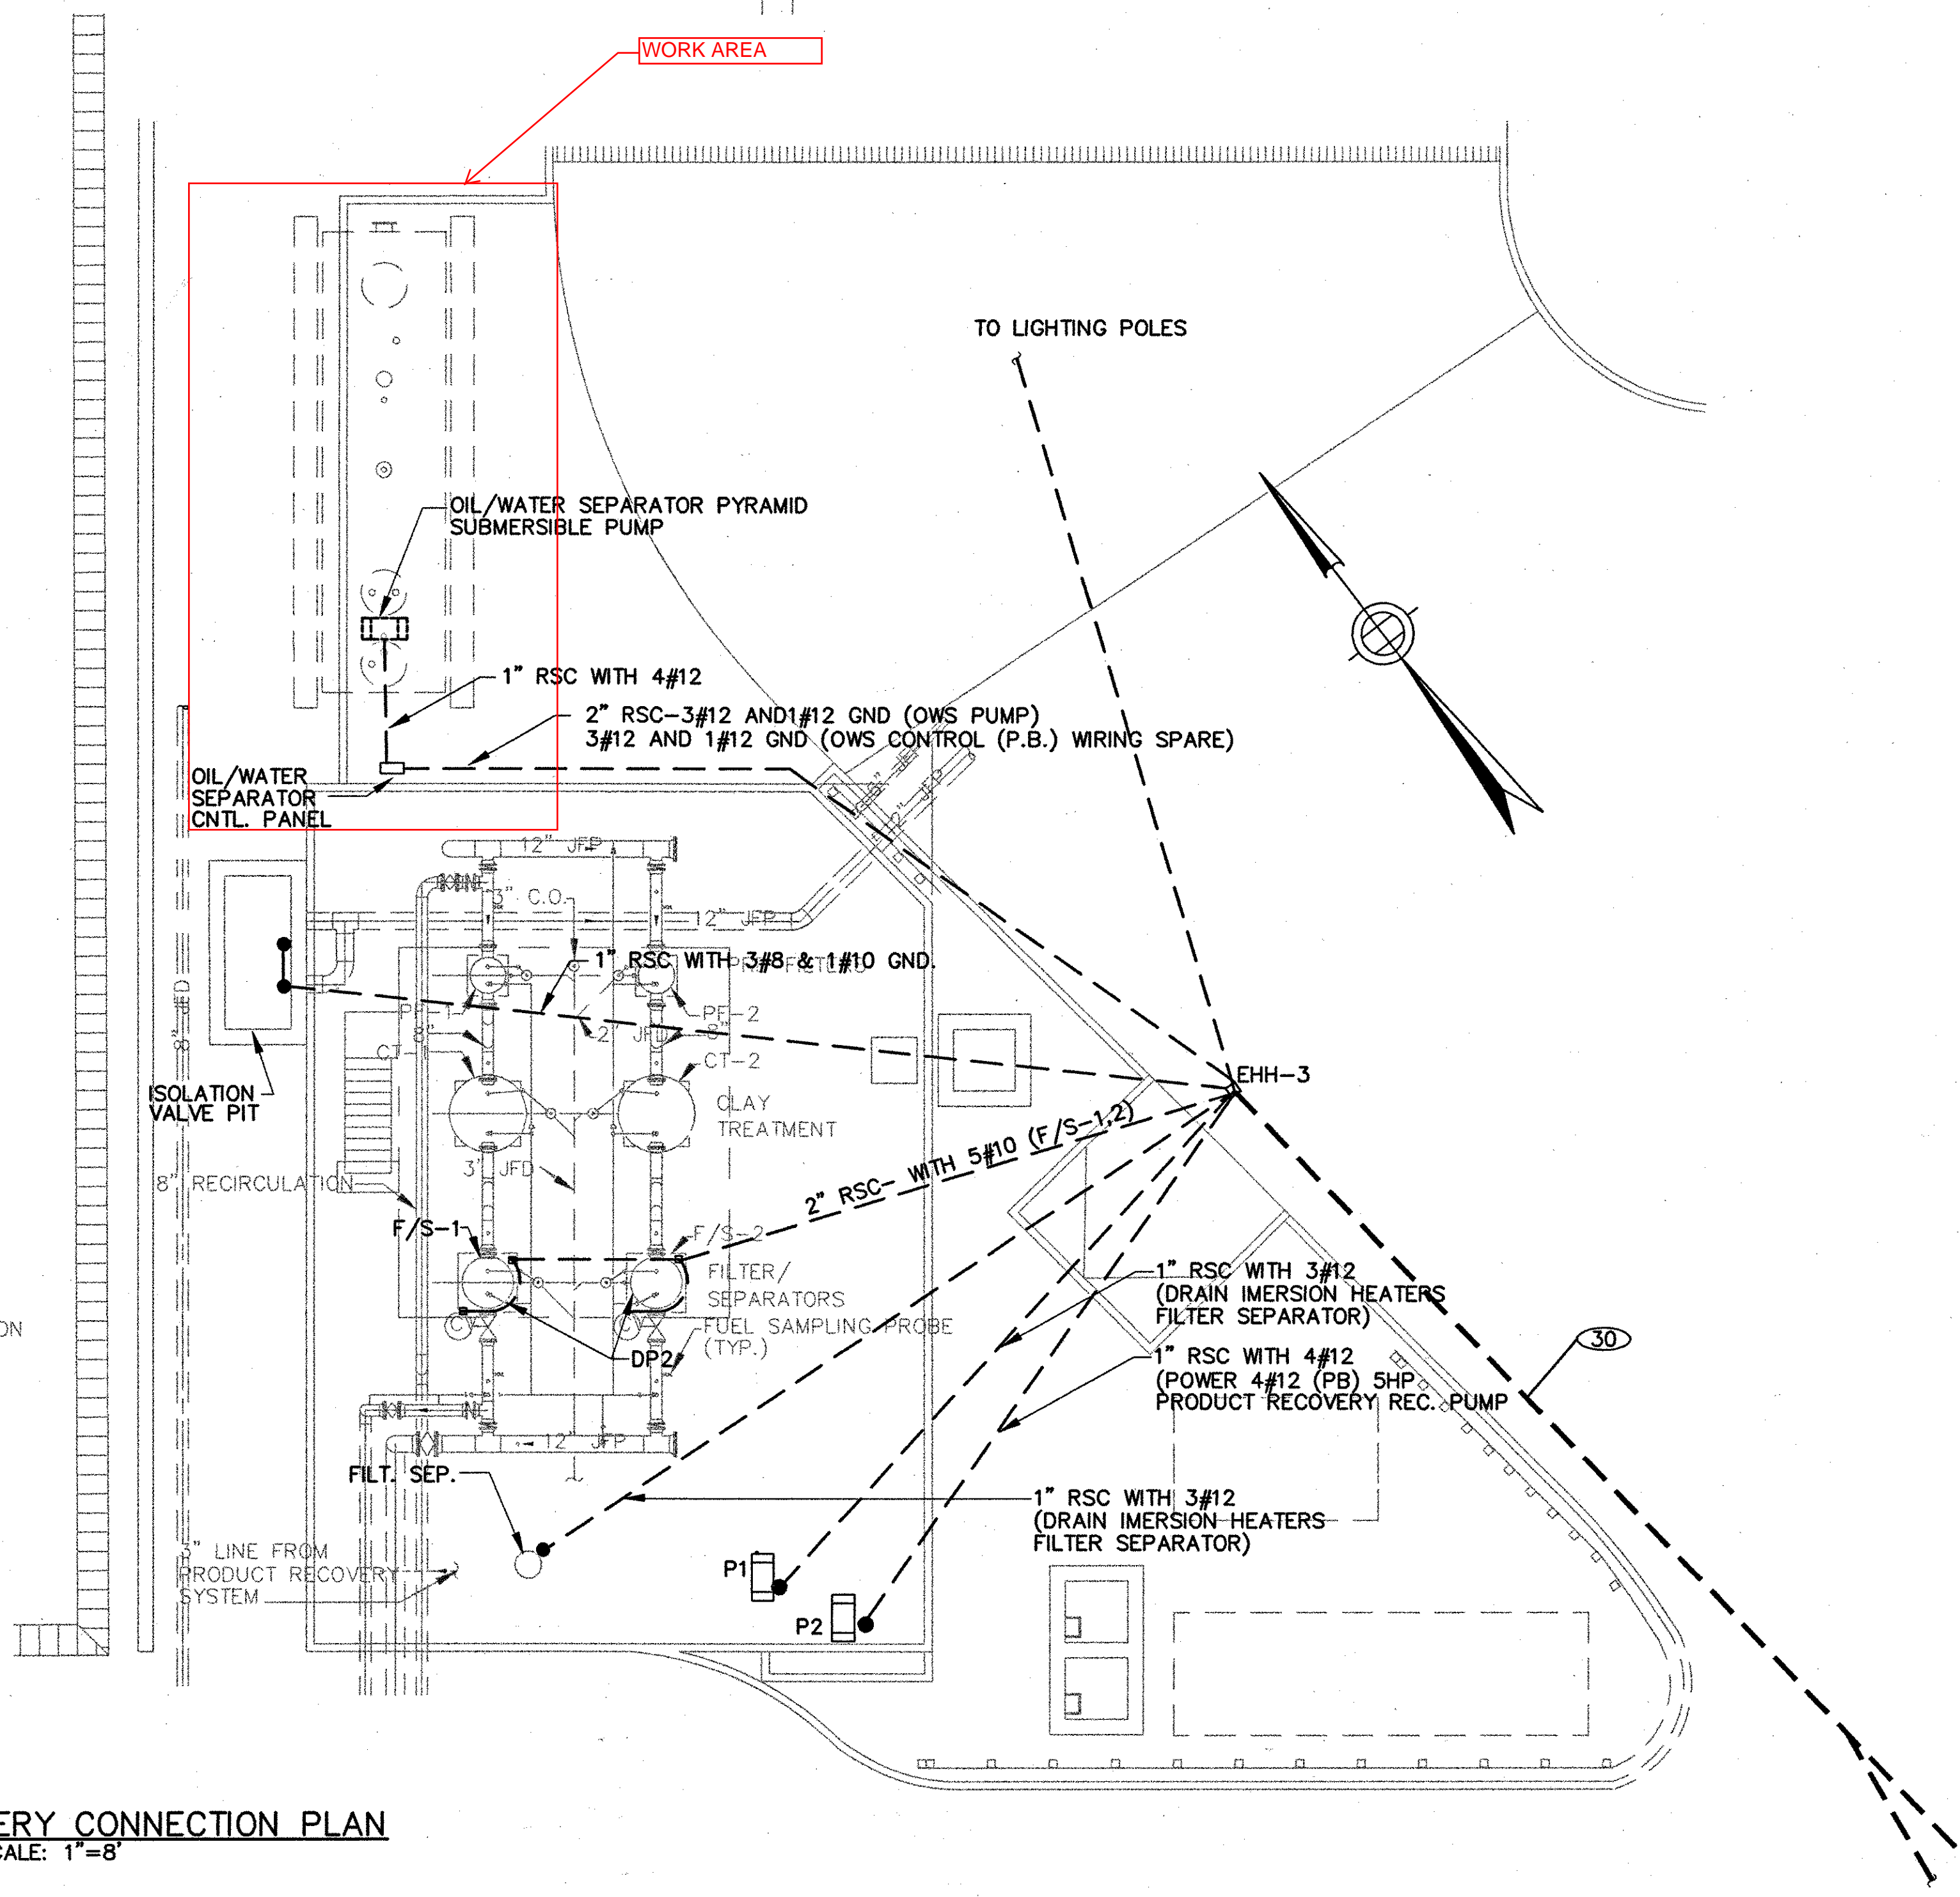

PRODUCT RECOVERY CONNECTION PLAN
SCALE: 1"=8'

- NOTES**
1. FOR OVERALL SITE PLAN SEE DWG. NO. E 1.01.
 2. FOR DUCT BANK SECTIONS SEE DWGS. NO. 2.01 - E 2.03.
 3. ALL FITTINGS INSTALLED ARE EXPLOSION PROOF.
 4. SEE DWG. NO M 13.04 FOR EQUIPMENT INSTALLATION.

AS CONSTRUCTED
I hereby certify that all construction required by this sheet has been accomplished as indicated herein.
EDWARDS AND KELCEY, INC.
BY *Stef E. Am...* DATE 1/5/02

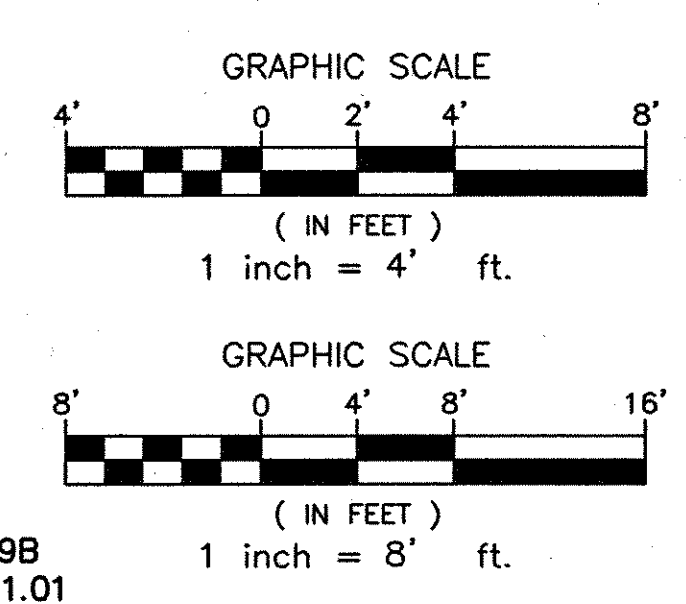

TO LVHM W49B
SEE DWG. E 1.01

REV. NO.	DATE	DESCRIPTION	MADE BY	CHK. BY	APPD. BY
1	12/01	AS-CONSTRUCTED	SNA	RW	ESD

MASSACHUSETTS PORT AUTHORITY
BOSTON, MASSACHUSETTS

BOSTON LOGAN INTERNATIONAL AIRPORT
EAST BOSTON, MASSACHUSETTS

AIRCRAFT FUELING SYSTEMS
SCHEDULE B - FUEL STORAGE FACILITY
OFFLOADING AND PRODUCT RECOVERY SITES
ELECTRICAL DETAILS

CONSULTANT AND SUBCONSULTANT:
GREINER INC. TAMPA, FLORIDA
EDWARDS AND KELCEY INC. BOSTON, MASSACHUSETTS

DRAWN BY: TED	CHKD. BY: RW	DWG. NO: E 4.01
SCALE: AS SHOWN	APPROVED: JM	DATE: 11/96


MPA CONTRACT NO.: MPA 1.646C (R) SHEET NO. 95 OF 280

AS BUILT

LEGEND					
PROPOSED	EXISTING	ITEM	PROPOSED	EXISTING	ITEM
■ CB	□ C.B.	CATCH BASIN	---	---	SEWERAGE LINE
● SMH	○ SMH	SEWER MANHOLE	---	---	DRAINAGE LINE
● DMH	○ DMH	DRAIN MANHOLE	---	---	WATER LINE
● EMH	○ EMH	ELECTRIC MANHOLE	---	---	GAS LINE
□ EHH	○ EHH	ELECTRIC HANDHOLE TYPE II	---	---	FUEL LINE
○ WMH	○ WMH	WATER MANHOLE	---	---	DUCT BANK
● CMH	○ CMH	CONTROL MANHOLE	---	---	DIRECT BURIED 1" RSC UNLESS OTHERWISE NOTED
○ TMH	○ TMH	TELEPHONE MANHOLE	---	---	MONITORING WELL
○ WG	○ WG	WATER GATE	---	---	DOUBLE FIXTURE LIGHT POLE WITH HANDHOLE (TYPE I)
○ HYD	○ HYD	FIRE HYDRANT	---	---	SINGLE FIXTURE LIGHT POLE WITH HANDHOLE (TYPE I)
△ GG	△ GG	GAS GATE	---	---	OBSTRUCTION LIGHT
---	---	CURB INLET	---	---	BLAST WALL
---	---	CHAIN LINK FENCE	---	---	LIGHTING HANDHOLE

NOTES

- FOR ELECTRICAL LIGHTING DETAILS SEE DWG. NO. E 5.02.
- ALL LIGHTING CIRCUITS EXCEPT PRESCOTT ST. ARE FED FROM PANEL LP-1 IN THE OPERATIONS BUILDING. FOR PANEL DETAILS SEE DWG. NO. 3.06. PRESCOTT ST. LIGHTS ARE FED FROM PUMPING STA. FOR DETAILS SEE DWG. NO. E 4.05.
- REFER TO LIGHTING FIXTURE SCHEDULE FOR TYPES AND MANUFACTURER. SEE DWG. NO. 3.08.
- FOR DUCT BANK AND MANHOLE INSTALLATION AND DETAILS SEE DWGS. NO. E 1.01-E 1.03 AND E 2.01-E 2.03. FOR COMPLETE CIRCUIT CONDUCTOR INFO SEE DWG'S E 2.01 - 2.03.
- THE CONTRACTOR CONTACTED AND COORDINATED WITH THE MPA ELECTRICAL DEPARTMENT 48 HOURS PRIOR TO WORKING WITH ANY EXISTING ELECTRICAL LINES AND OBTAINED WRITTEN APPROVAL OF THE ENGINEER.
- EXISTING (480V, 250 WATT) STREET LIGHT WAS DISCONNECTED, REMOVED AND STORED AT THE DIRECTION OF THE ENGINEER.
- EXISTING CIRCUITS (PS13, PS11) WERE SPLICED WITH NEW CABLES IN THIS HANDHOLE.
- EXISTING CIRCUITS (PS7, PS9, PS10) WERE SPLICED WITH NEW CABLES IN THE HANDHOLE.
- EXISTING CIRCUITS PS4 AND PS5 WERE SPLICED WITH NEW CABLES IN THIS HANDHOLE.
- FOR DETAILS OF TANK LIGHTING SEE DWG. NO. E 5.02.

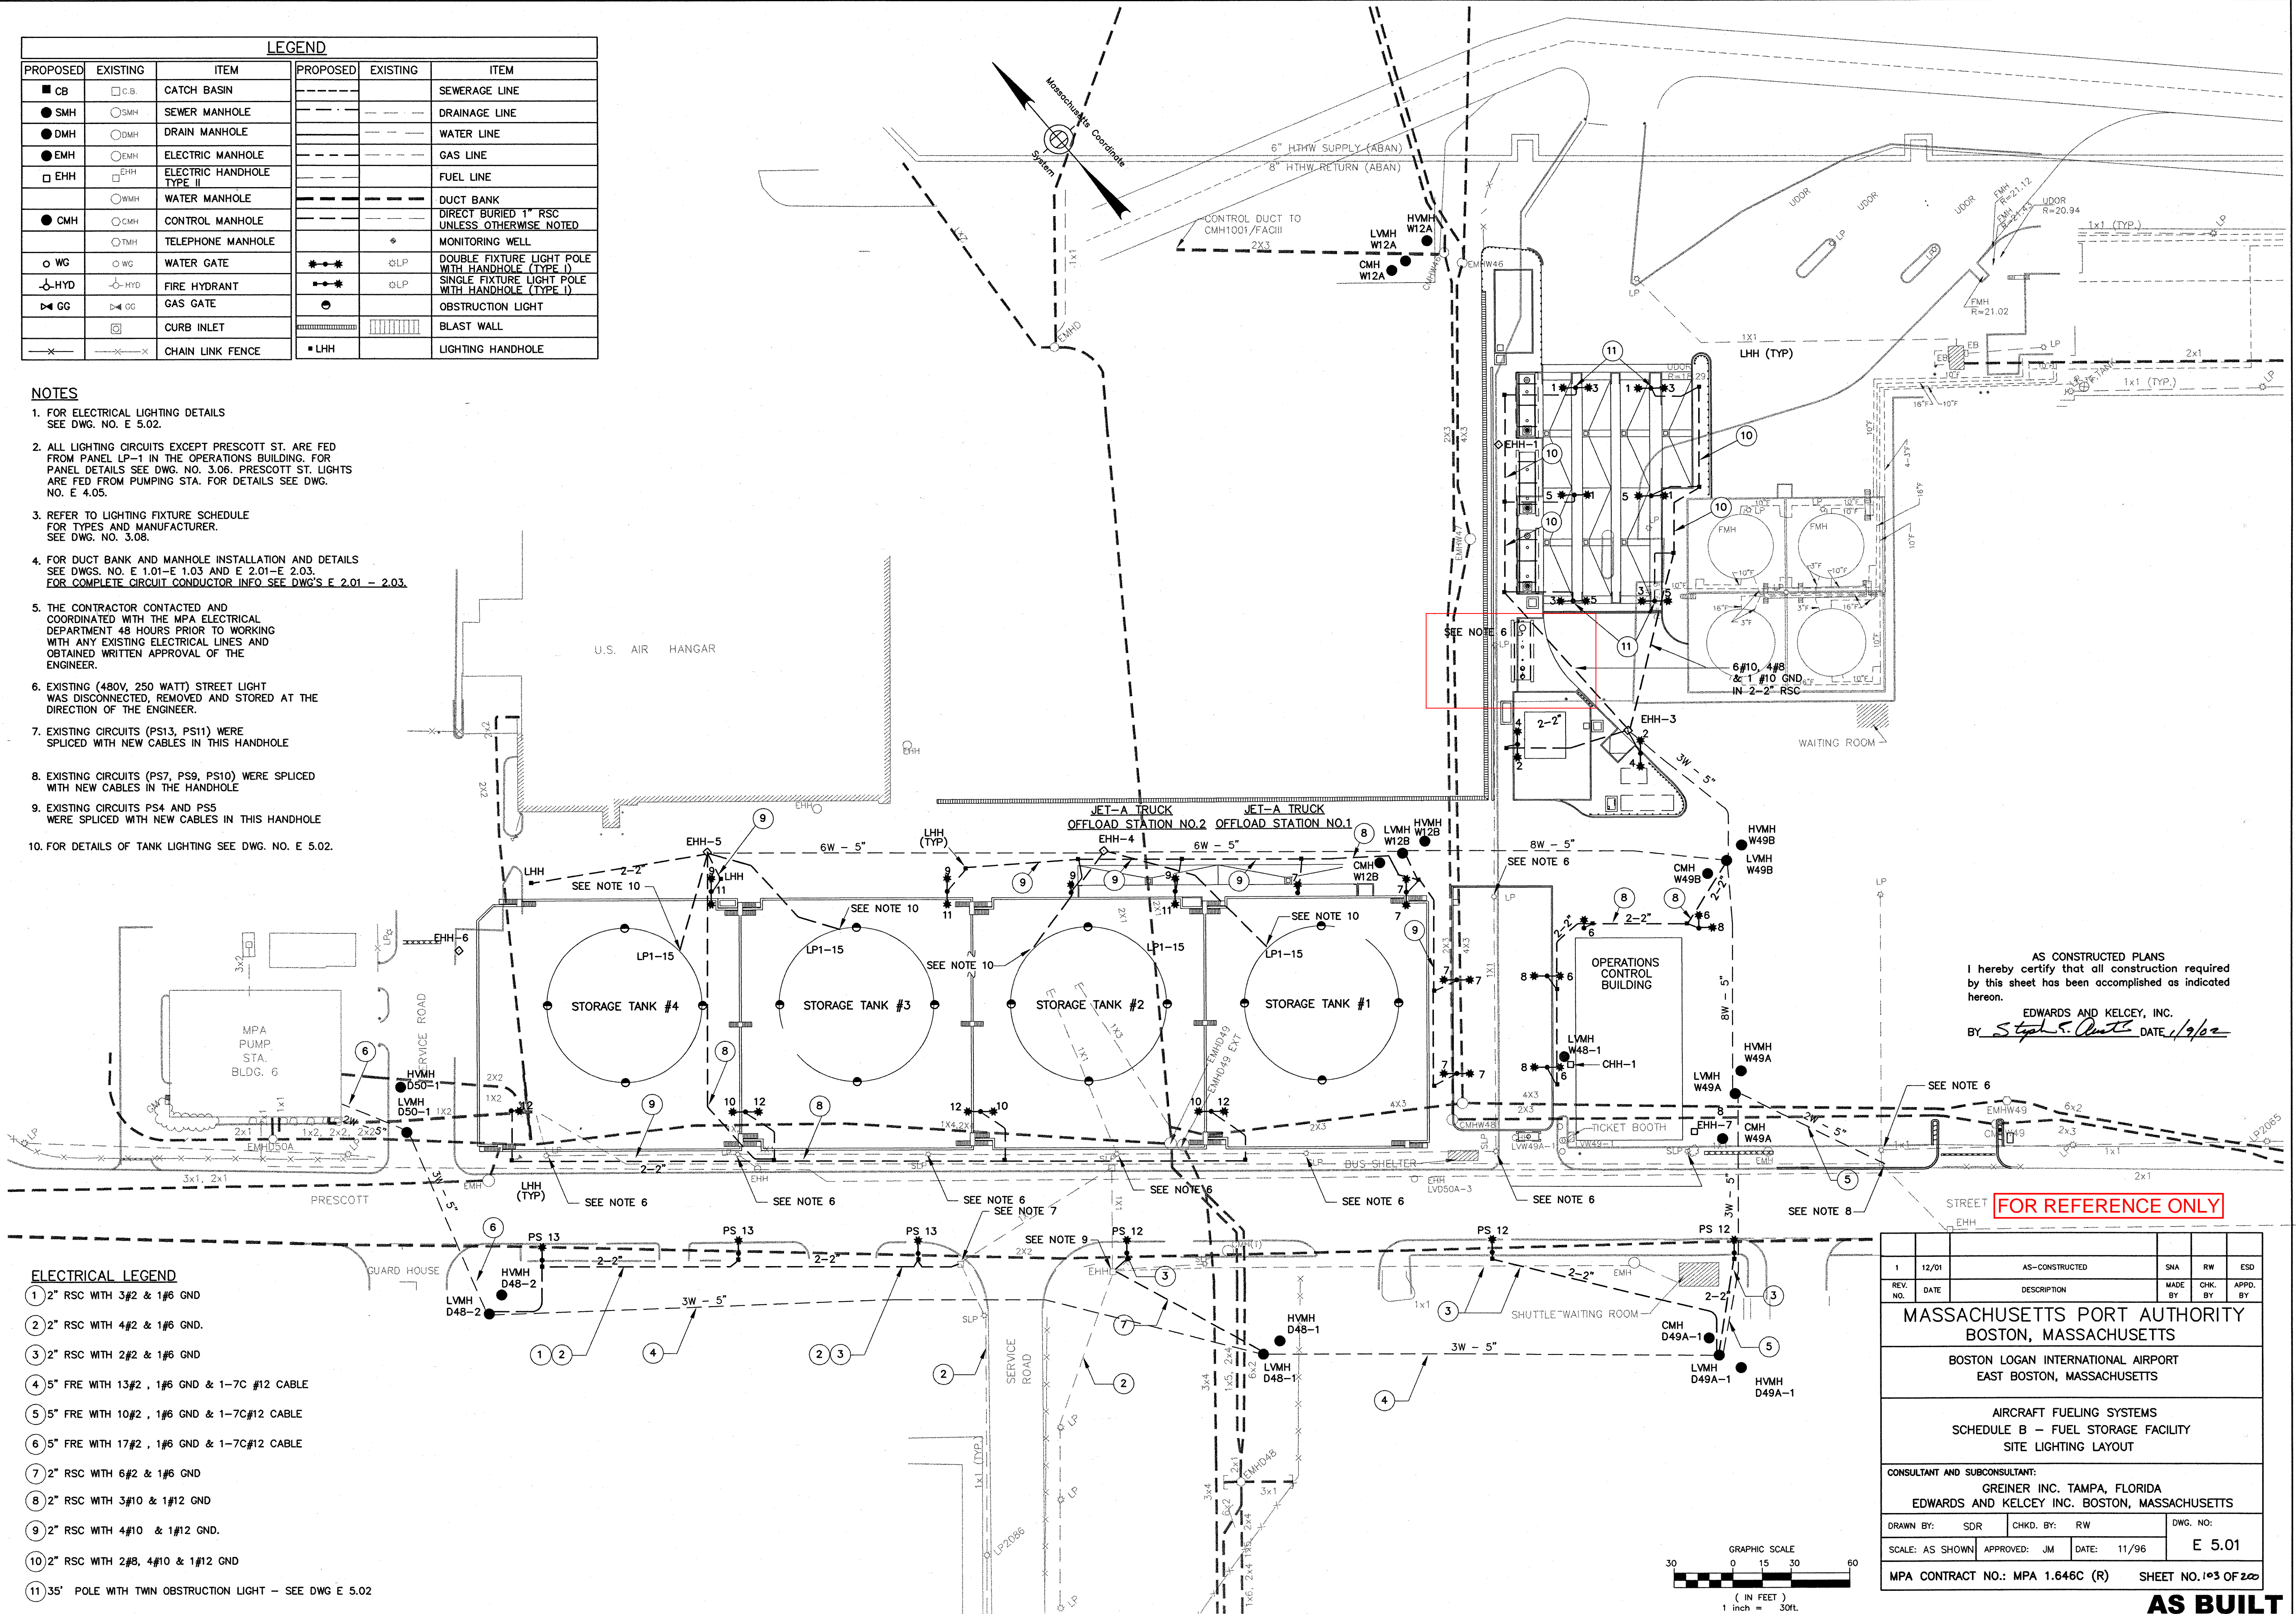

AS CONSTRUCTED PLANS
I hereby certify that all construction required by this sheet has been accomplished as indicated hereon.
EDWARDS AND KELCEY, INC.
BY *Stephen S. Quill* DATE 11/9/96

FOR REFERENCE ONLY

ELECTRICAL LEGEND

- 2" RSC WITH 3#2 & 1#6 GND
- 2" RSC WITH 4#2 & 1#6 GND.
- 2" RSC WITH 2#2 & 1#6 GND
- 5" FRE WITH 13#2, 1#6 GND & 1-7C#12 CABLE
- 5" FRE WITH 10#2, 1#6 GND & 1-7C#12 CABLE
- 5" FRE WITH 17#2, 1#6 GND & 1-7C#12 CABLE
- 2" RSC WITH 6#2 & 1#6 GND
- 2" RSC WITH 3#10 & 1#12 GND
- 2" RSC WITH 4#10 & 1#12 GND.
- 2" RSC WITH 2#8, 4#10 & 1#12 GND
- 35' POLE WITH TWIN OBSTRUCTION LIGHT - SEE DWG E 5.02

REV. NO.	DATE	DESCRIPTION	MADE BY	CHK BY	APPD. BY
1	12/01	AS-CONSTRUCTED	SNA	RW	ESD

MASSACHUSETTS PORT AUTHORITY
BOSTON, MASSACHUSETTS

BOSTON LOGAN INTERNATIONAL AIRPORT
EAST BOSTON, MASSACHUSETTS


AIRCRAFT FUELING SYSTEMS
SCHEDULE B - FUEL STORAGE FACILITY
SITE LIGHTING LAYOUT


CONSULTANT AND SUBCONSULTANT:
GREINER INC. TAMPA, FLORIDA
EDWARDS AND KELCEY INC. BOSTON, MASSACHUSETTS

DRAWN BY: SDR CHKD. BY: RW DWG. NO: E 5.01

SCALE: AS SHOWN APPROVED: JM DATE: 11/96

MPA CONTRACT NO.: MPA 1.646C (R) SHEET NO. 103 OF 200

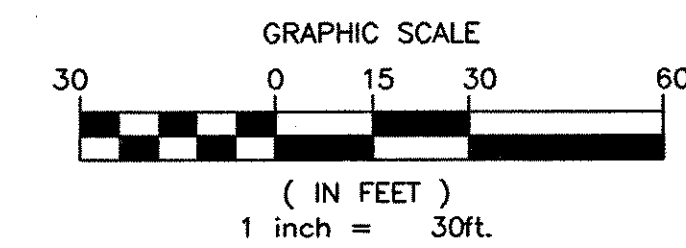

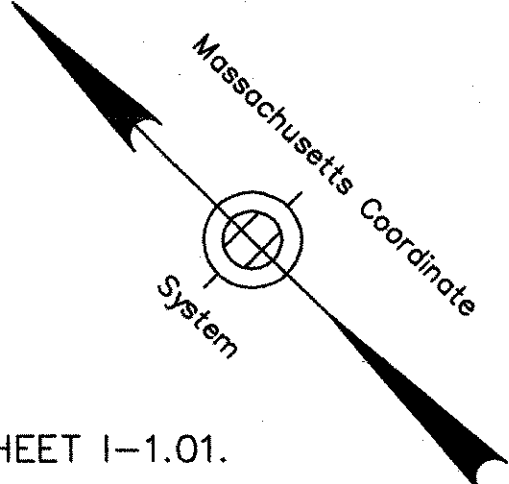

REFERENCE NOTES CONTINUED:

- (25) EXISTING 1" R.G.S.C. WITH 27-#14 FOR LEAK DETECTION PROBES AND SENSORS.
- (26) PROVIDE 1" R.G.S.C. WITH 12-#14 FOR LEAK DETECTION PROBES AND SENSORS.
- (27) PROVIDE 1" R.G.S.C. WITH 14-#14 FOR LEAK DETECTION PROBES AND SENSORS.
- (28) PROVIDE 1" R.G.S.C. WITH 16-#14 FOR LEAK DETECTION PROBES AND SENSORS.

WORK AREA:
1. SEE DRAWING E4.01 FOR DESCRIPTION OF THE ELECTRICAL WORK.

GENERAL NOTES:

- 1. REFER TO GENERAL NOTES ON SHEET I-1.01.

REFERENCE NOTES:


- (1) EXISTING OIL/WATER SEPARATOR TANK CONTROL PANEL.
- (2) EXISTING CONDUIT & WIRES PER MANUFACTURER'S REQUIREMENTS FOR LEVEL SWITCHES AND LEAK DETECTION PROBES.
- (3) PROVIDE 1" R.G.S.C. WITH 3-#12 POWER, 10-#12 SIGNALS (LSH-W1, LSH-W1, LSL-W1, LSH-W2 & LSHH-W2) FROM 'FORM C' RELAY CONTACTS IN O/W SEPARATOR CONTROL PANEL.
- (4) PROVIDE 1" R.G.S.C. WITH 3-#12 POWER AND 1-#12 FOR F/S WATER PROBE SIGNAL.
- (5) PROVIDE 1" R.G.S.C. WITH 3-#12 POWER AND 2-#12 SIGNALS (FS-17 & LSW-17).
- (6) PROVIDE 1" R.G.S.C. WITH 3-#12 POWER AND 4-#12 SIGNALS (FS-17, FS-18, LSW-17 & LSW-18).
- (7) PROVIDE 1" R.G.S.C. WITH (2) #8760 BELDEN CABLES ONE FROM MASTER STATION TO MOV-16 AND VIA JB AT MOV-17 AND ONE FROM MOV-4 TO MOV-17 VIA JB AT MOV-15.
- (8) PROVIDE 1" R.G.S.C. WITH (2) #8760 BELDEN CABLES ONE FROM MOV-17 TO MOV-16 AND ONE FROM MOV-17 TO MOV-4 VIA JB AT MOV-15.
- (9) WASTE WATER TANK CONTROL PANEL PROVIDED BY TANK MANUFACTURER.
- (10) PROVIDE 1" R.G.S.C. WITH 3-#12 POWER, 6-#12 SIGNALS (LSH-WW, LSHH-WW & LSL-WW) FROM FORM 'C' RELAY CONTACTS IN WASTE WATER TANK PANEL.
- (11) PRODUCT RECOVERY TANK CONTROL PANEL PROVIDED BY TANK MANUFACTURER.
- (12) PROVIDE 1" R.G.S.C. WITH 3-#12 POWER, 12-#12 SIGNALS (LSH-P1, LSH-P2, LSHH-P1, LSHH-P2, LSL-P1 & LSL-P2) FROM FORM 'C' RELAY CONTACTS IN PRODUCT RECOVERY TANK PANEL.
- (13) PROVIDE 2" R.G.S.C. WITH 39-#12 FOR POWER & SIGNALS, AND ONE 2" R.G.S.C. WITH PULL-CORD (SPARE).
- (14) PROVIDE 1" R.G.S.C. WITH ONE SHIELDED 6-#18 CABLE FOR PD METER POWER & COMMUNICATIONS.
- (15) PROVIDE 1" R.G.S.C. WITH ONE 4-WIRE TWISTED PAIR CABLE FOR FIRE RESCUE EMERGENCY PHONE.
- (16) PROVIDE (1) 2" R.G.S.C. WITH ONE SHIELDED 6-CONDUCTOR CABLE FOR PD METER AND ONE 4-WIRE TWISTED PAIR CABLE FOR FIRE RESCUE EMERGENCY PHONE, ONE BELDEN CABLE No. 8719 AND (1) 2" R.G.S.C. WITH PULL-CORD (SPARE).
- (17) FOR CONTINUATION SEE SHEET I-2.03.
- (18) FOR CONTINUATION SEE SHEET I-2.04.
- (19) FOR CONTINUATION SEE SHEET I-2.06.
- (20) FOR CONTINUATION SEE SHEET I-2.07.
- (21) PROVIDE 1" R.G.S.C. WITH 3-#12 FOR TANK GAUGE POWER.
- (22) PROVIDE 1" R.G.S.C. WITH ONE BELDEN No. 8719 CABLE FOR TANK GAUGE COMMUNICATIONS.
- (23) PROVIDE 3/4" R.G.S.C. WITH 2-#14 TO PRODUCT RECOVERY TANK INTERSTITIAL LEAK DETECTOR PROBE.
- (24) PROVIDE 3/4" R.G.S.C. WITH 2-#14 TO O/W SEPARATOR TANK INTERSTITIAL LEAK DETECTOR PROBE.

AS CONSTRUCTED PLANS
I hereby certify that all construction required
by this sheet has been accomplished as indicated

UPS Greiner Woodward Clyde, Inc.
BY: *[Signature]* DATE: 1/9/02

FOR REFERENCE ONLY


AB	7/99	CONTRACTOR'S AS-BUILT CONDITIONS	JTV/GSH	JV	RAH
REV. NO.	DATE	DESCRIPTION	MADE BY	CHK. BY	APPD. BY
MASSACHUSETTS PORT AUTHORITY BOSTON, MASSACHUSETTS					
BOSTON LOGAN INTERNATIONAL AIRPORT EAST BOSTON, MASSACHUSETTS					
AIRCRAFT FUELING SYSTEMS SCHEDULE B - FUEL STORAGE FACILITY PRODUCT RECOVERY AREA INSTRUMENTATION PLAN					
CONSULTANT AND SUBCONSULTANT:					
GREINER INC. TAMPA, FLORIDA EDWARDS AND KELCEY INC. BOSTON, MASSACHUSETTS					
DRAWN BY:	SJD	CHKD. BY:	CUL/DEV	DWG. NO.:	I-2.05
SCALE:	AS SHOWN	APPROVED:	TDT	DATE:	2/97
MPA CONTRACT NO.: MPA 1.646C (R)					SHEET NO. 159 OF 202

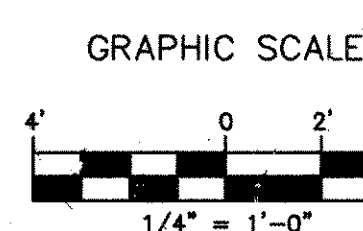

PRODUCT RECOVERY AREA INSTRUMENTATION PLAN
SCALE: 1/4"=1'-0"


T:\BOSTON_ABA\FUELSTOR\INST\AB\I-205ABC.DWG 10/08/01 10:27

AS BUILT

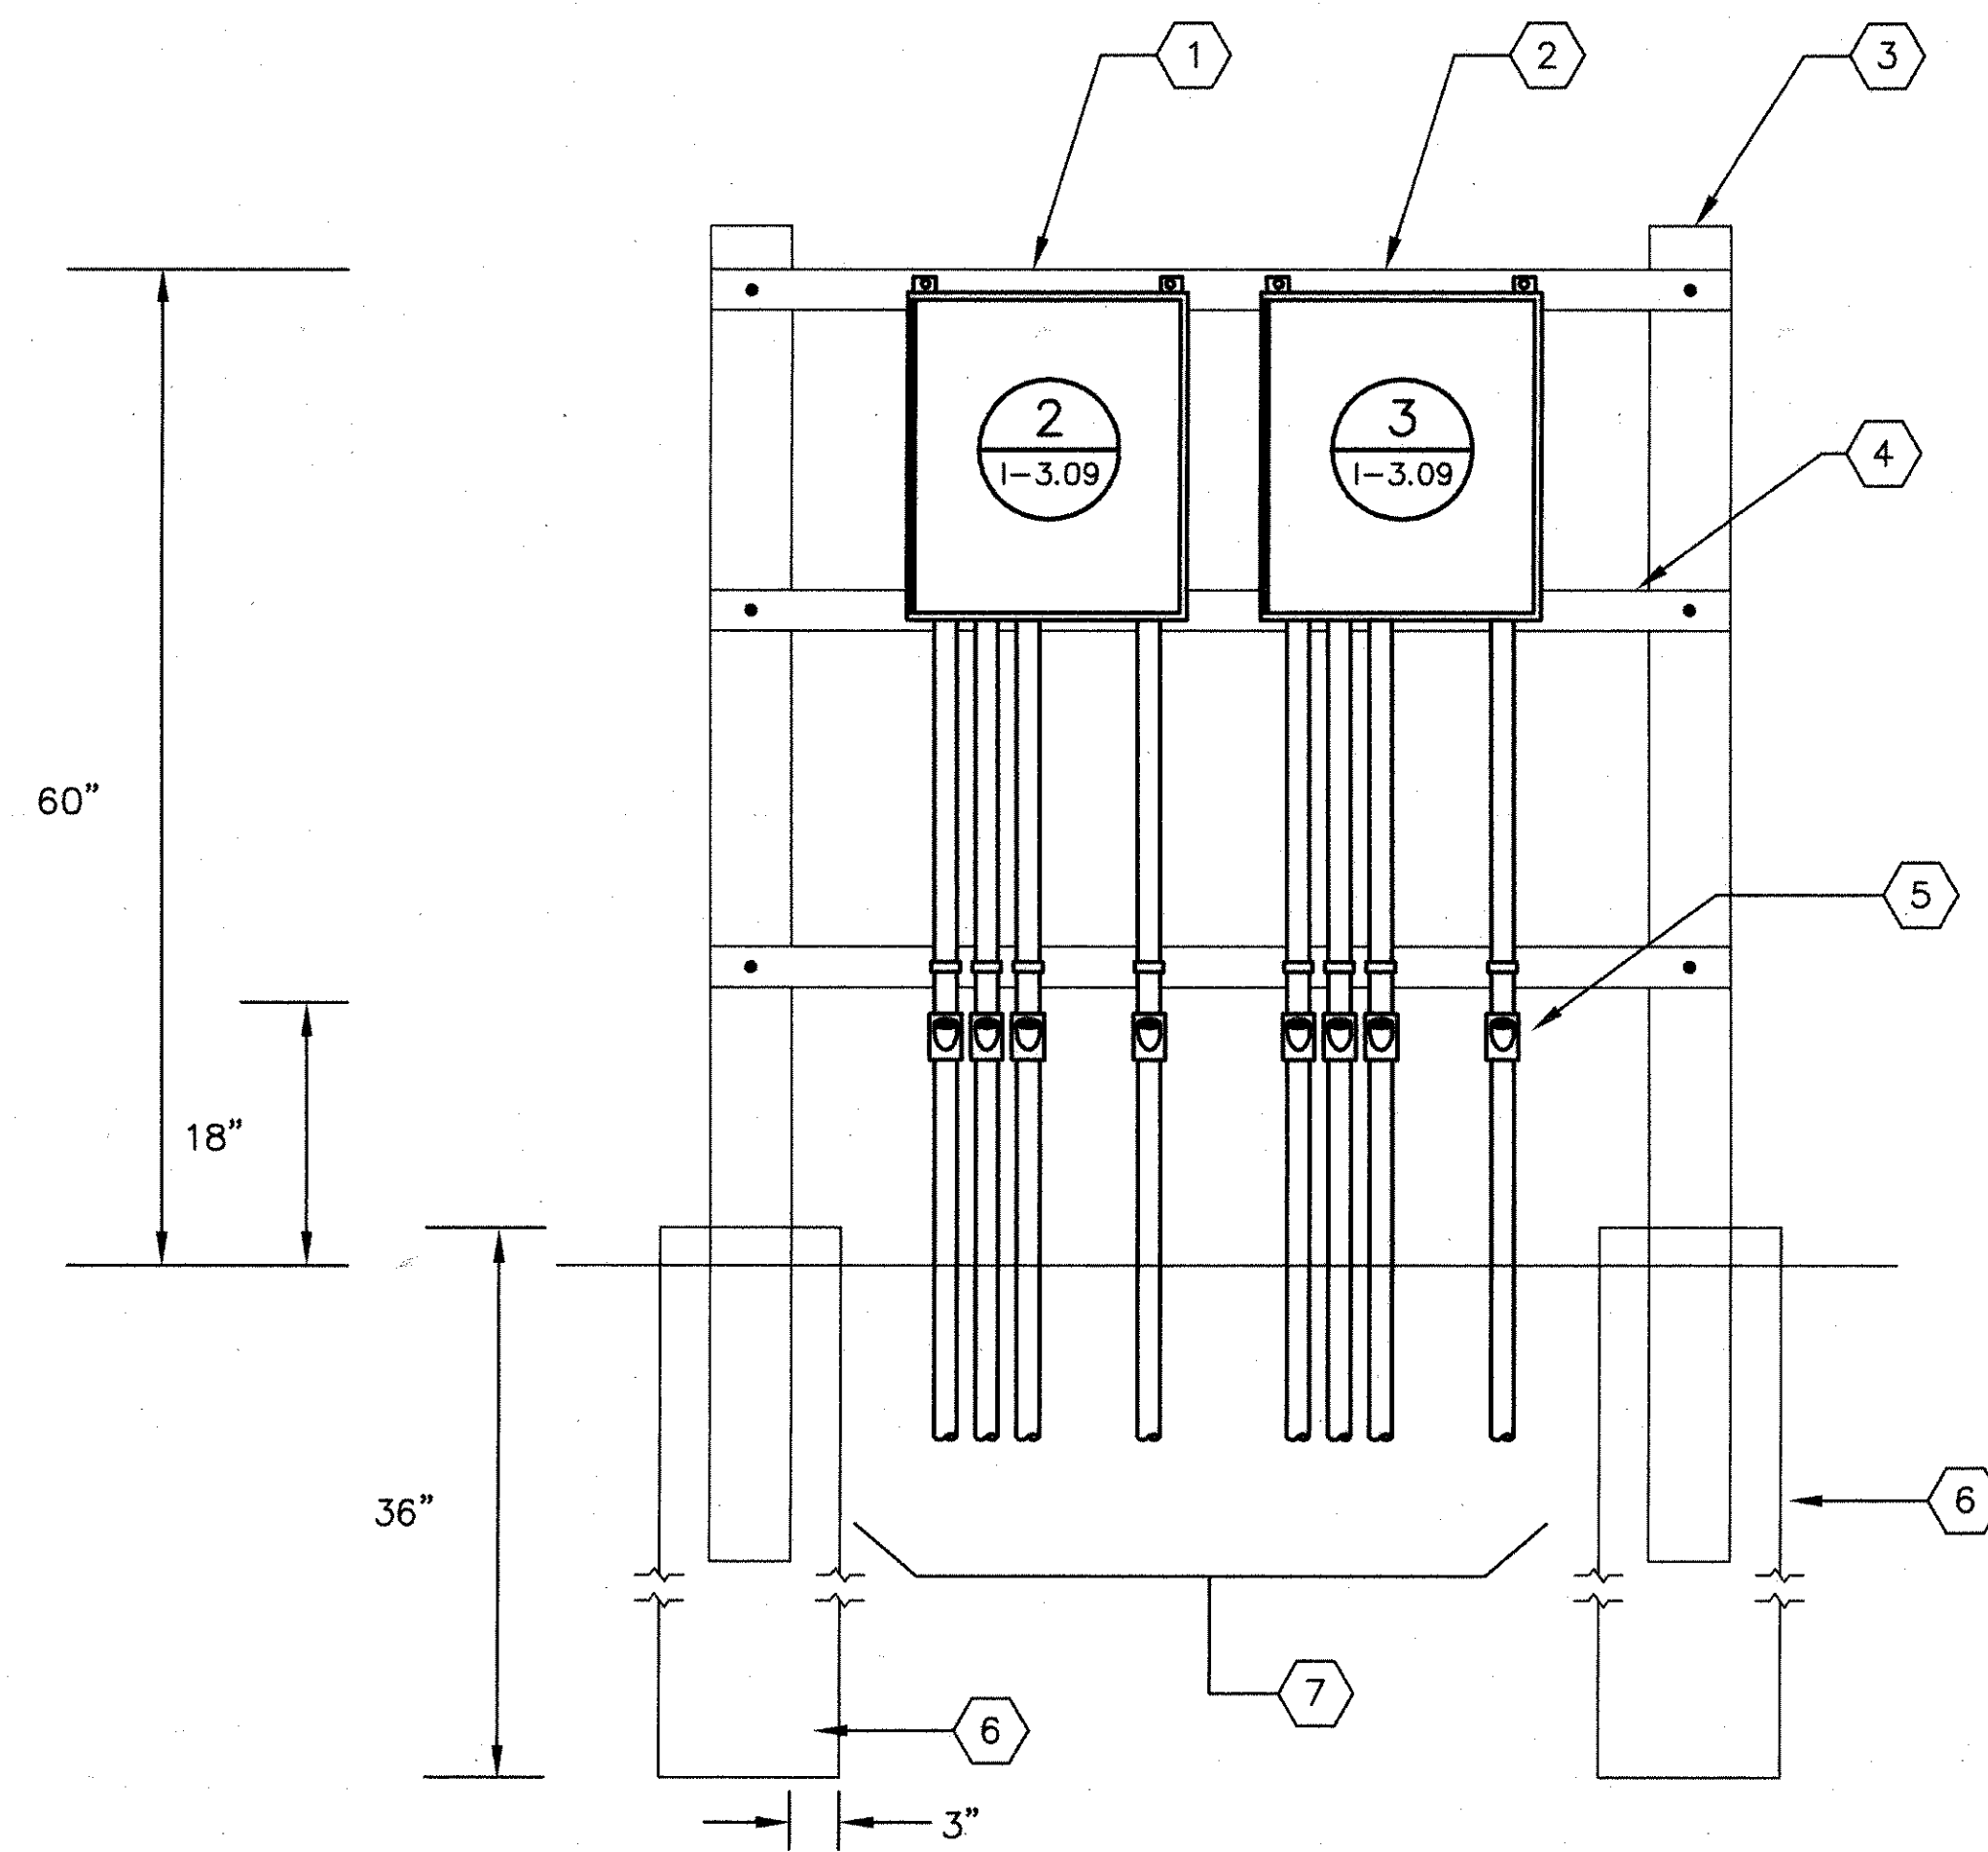


PRODUCT RECOVERY TERMINAL CABINETS RACK DETAIL
N.T.S. 1
I-2.05


- NOTES:**
- ① PRODUCT RECOVERY COMMUNICATIONS TERMINAL CABINET. PROVIDED 20" X 20" X 6" STAINLESS STEEL CONTINUOUS HINGE TYPE 4X CABINET WITH INTERIOR STEEL PANEL, FOR MOUNTING OF TERMINAL BLOCKS. PROVIDED ONE (1) 50 POINT TERMINAL BLOCK. PROVIDED PLASTIC LAMINATED LABEL BLACK BACKGROUND WITH ETCHED WHITE LETTERS, 3/8" HIGH TO READ "PRODUCT RECOVERY COMMUNICATIONS TERMINAL CABINET". REFER TO TERMINAL BLOCK #10 DIAGRAM.
 - ② PRODUCT RECOVERY 120V POWER & SIGNALS TERMINAL CABINET. PROVIDED 20" X 20" X 6" STAINLESS STEEL CONTINUOUS HINGE TYPE 4X CABINET WITH INTERIOR STEEL PANEL, FOR MOUNTING OF TERMINAL BLOCKS. PROVIDE TWO (2) 50 POINT TERMINAL BLOCKS. PROVIDED PLASTIC LAMINATED LABEL BLACK BACKGROUND WITH ETCHED WHITE LETTERS, 3/8" HIGH TO READ "PRODUCT RECOVERY 120V POWER & SIGNALS TERMINAL CABINET". REFER TO TERMINAL BLOCK #11 DIAGRAM.
 - ③ CA X 5.4 GALVANIZED STEEL CHANNEL (TYPICAL).
 - ④ 1 1/2" X 1 1/2" UNISTRUT GALVANIZED STEEL CHANNEL (TYPICAL).
 - ⑤ PROVIDED EYS FITTING TOP 18" AFF (TYPICAL).
 - ⑥ PROVIDED CONCRETE FOUNDATION, 3000 PSI.
 - ⑦ REFER TO DRAWING I-2.05 FOR CONDUIT/CONDUCTOR REQUIREMENTS.

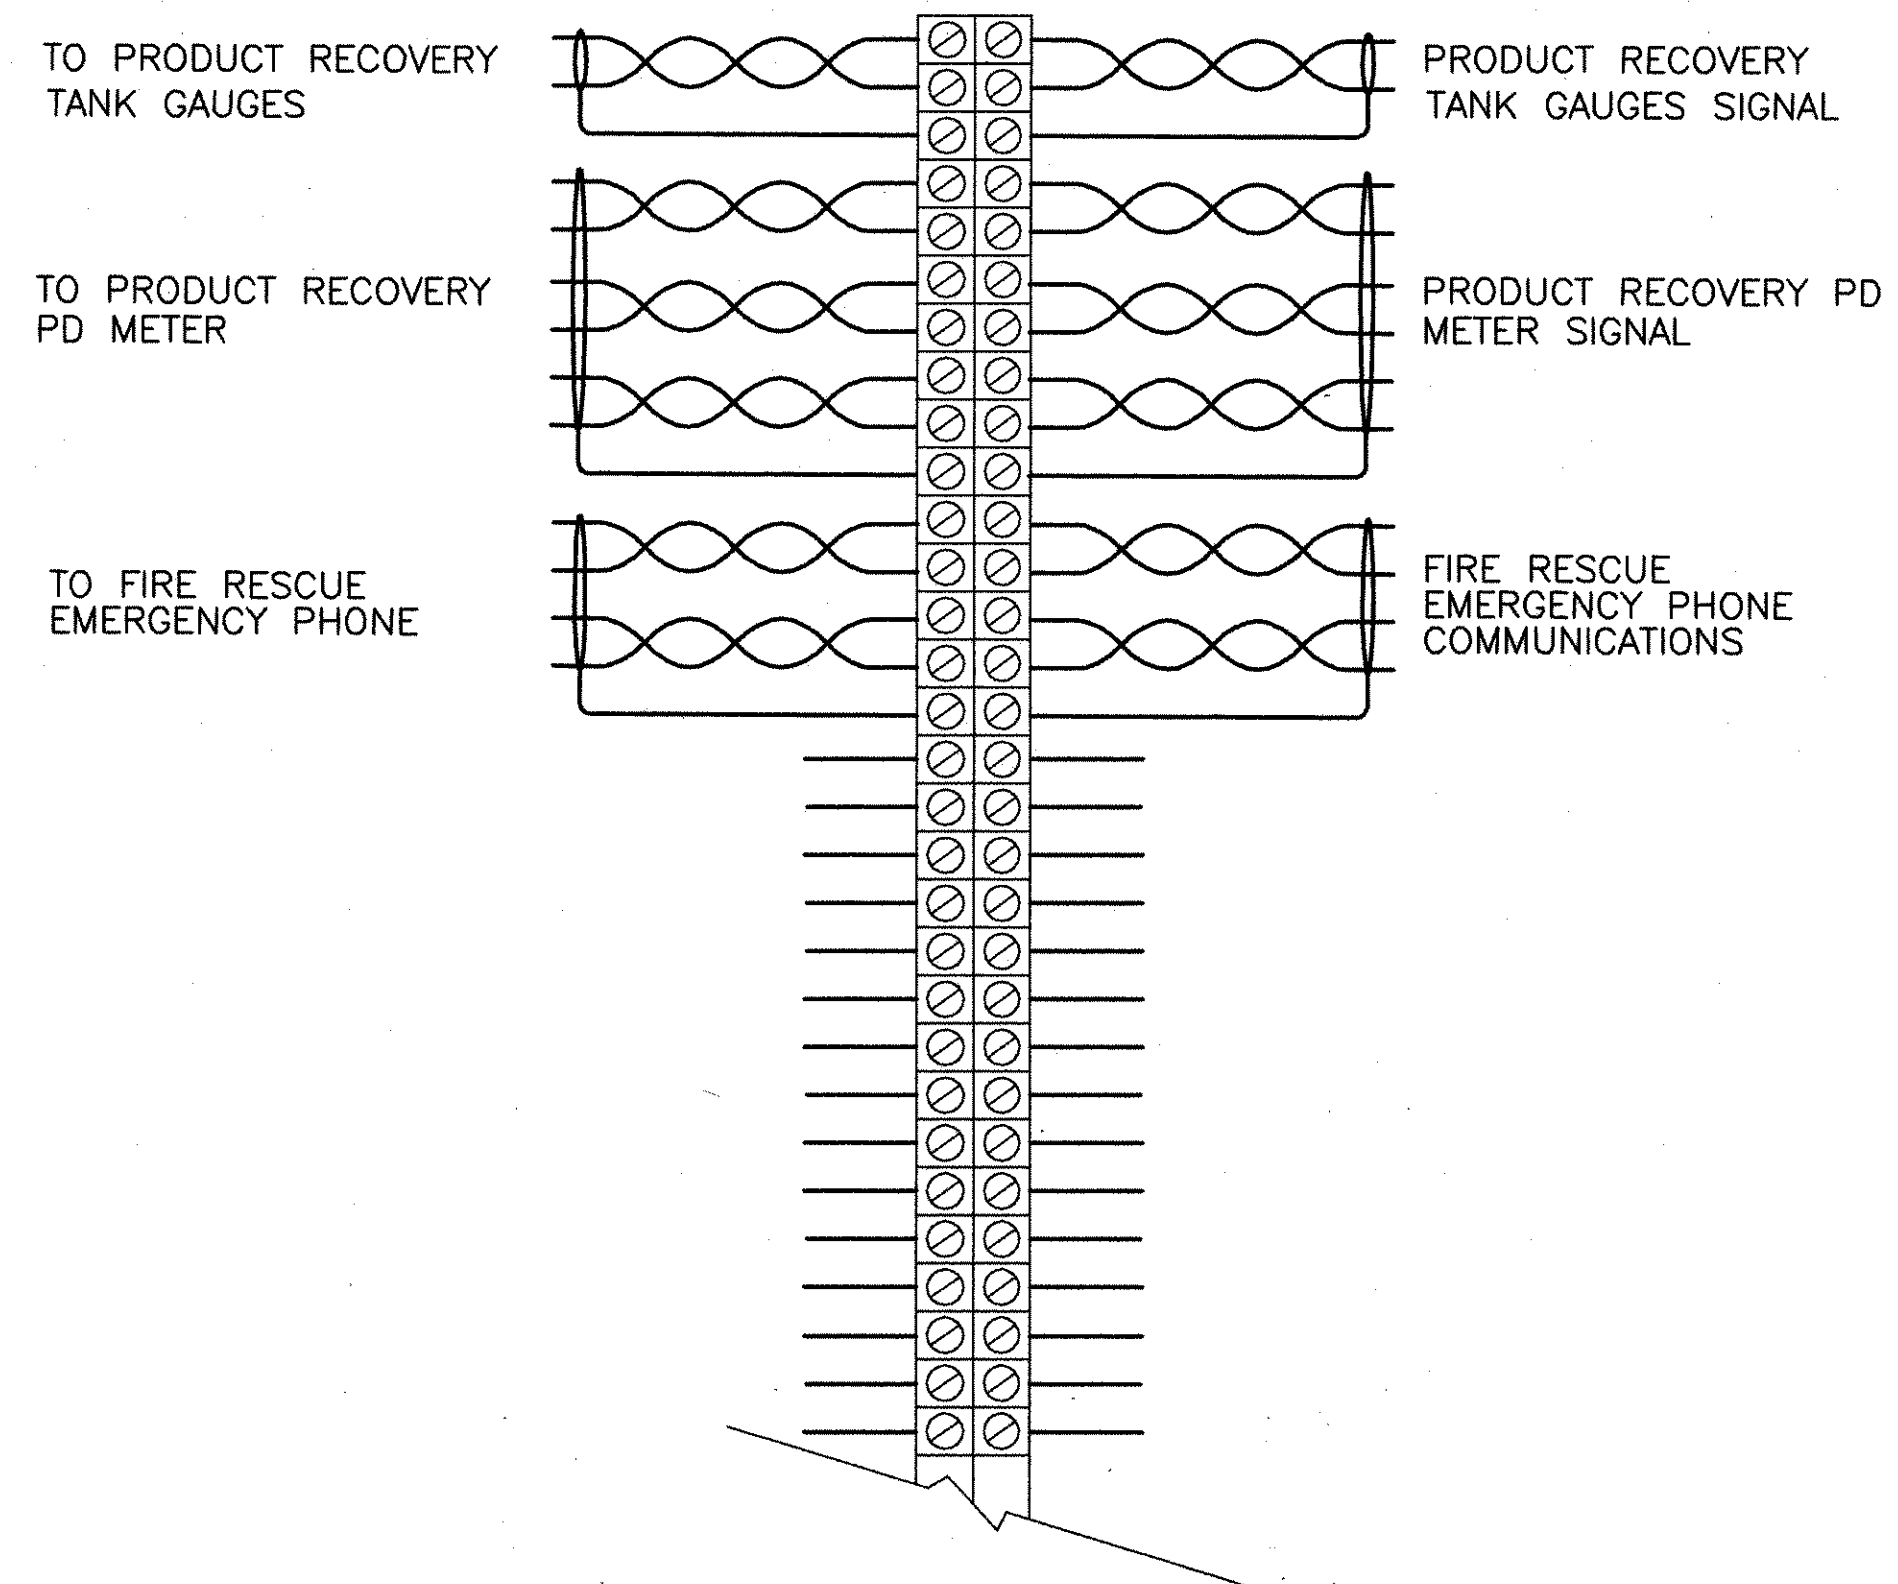

TERMINAL BLOCK #10 DIAGRAM
N.T.S. 2
I-3.09

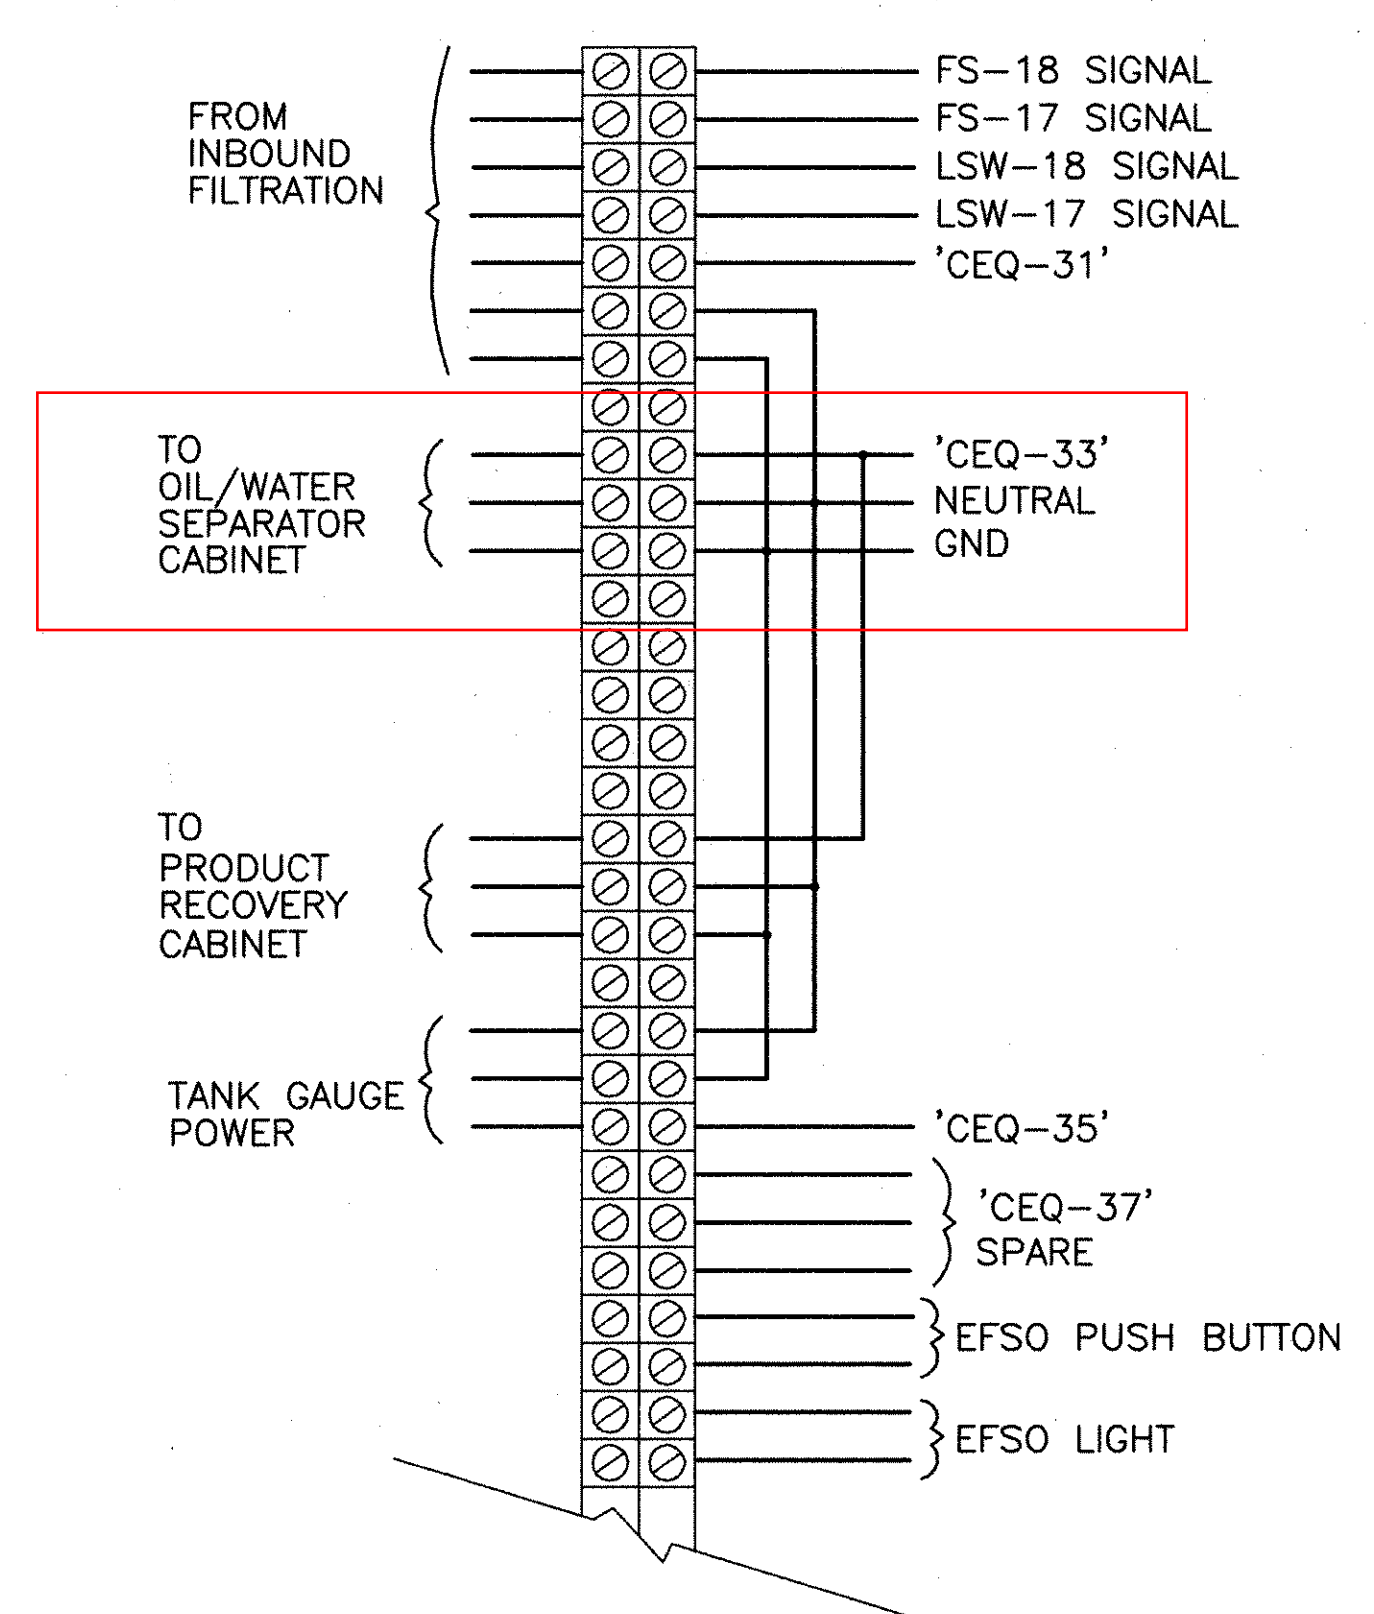


TERMINAL BLOCK #11 DIAGRAM
N.T.S. 3
I-3.09

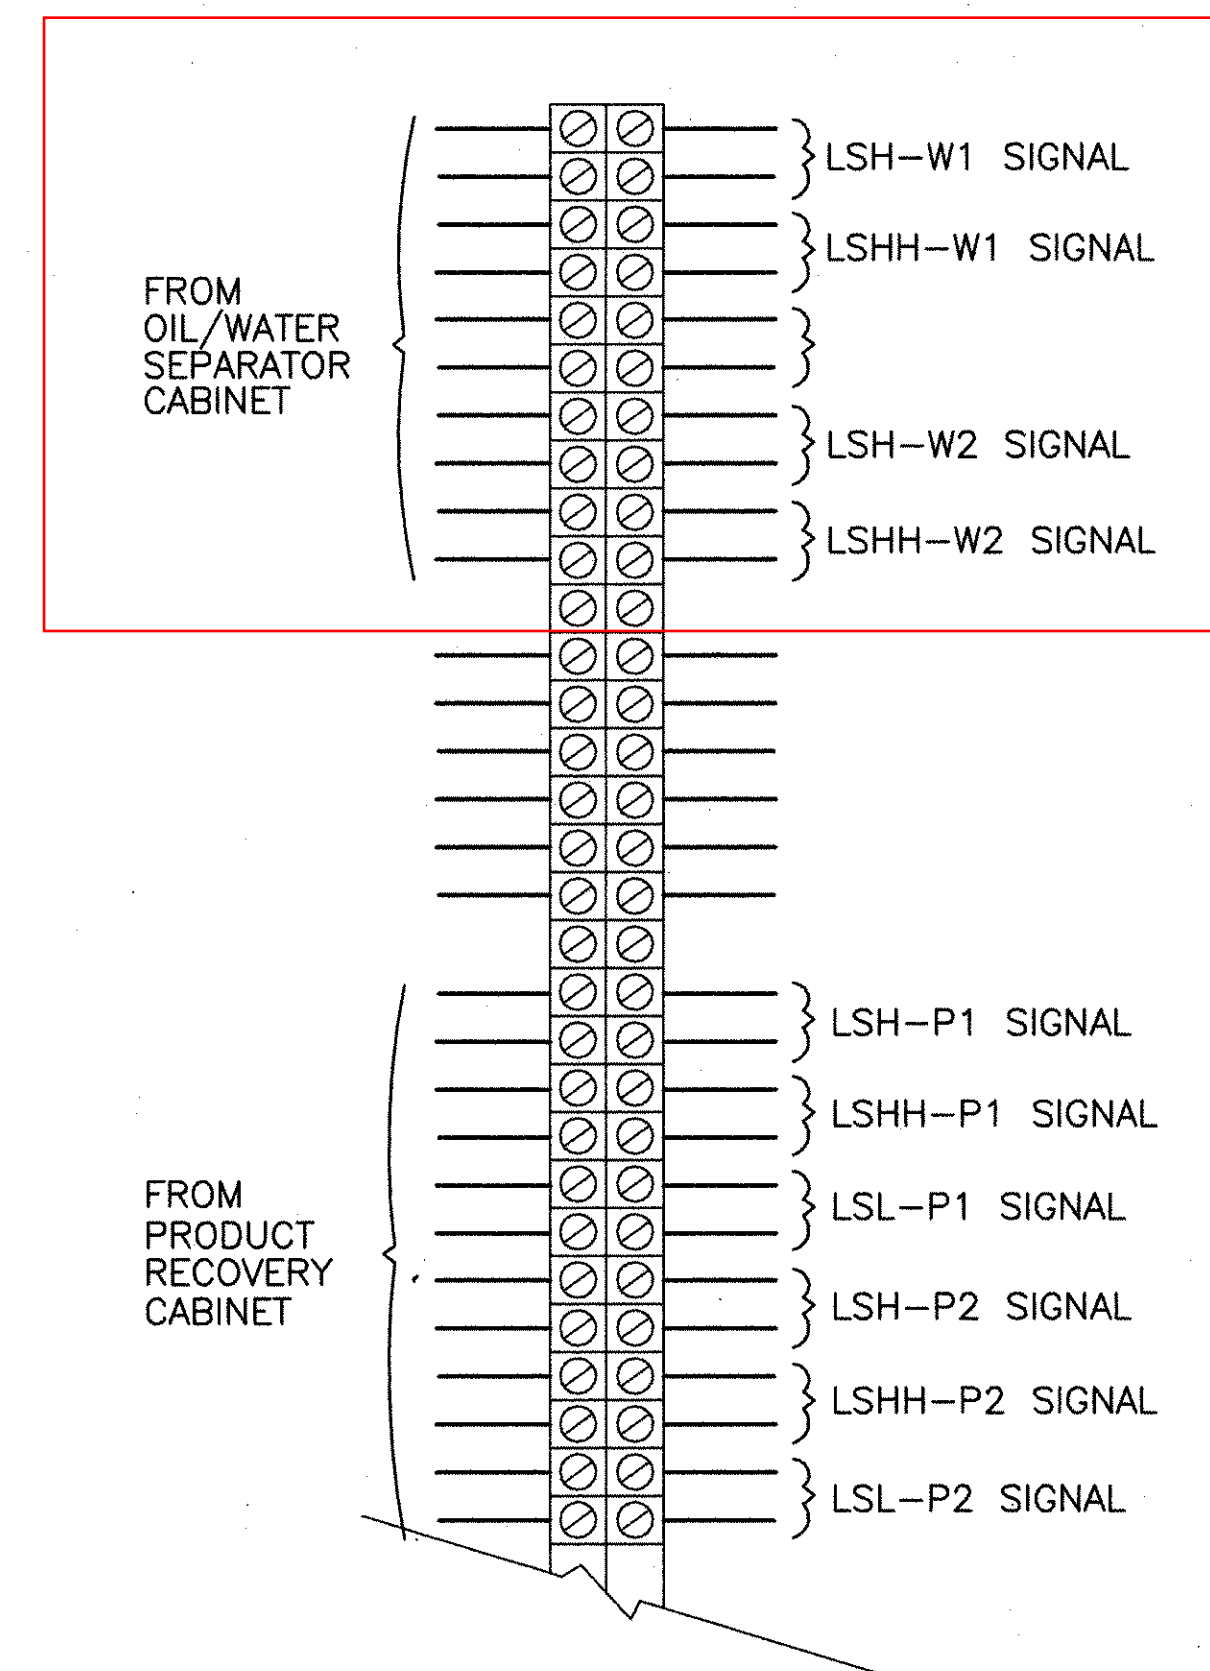

FOR REFERENCE ONLY
AS CONSTRUCTED PLANS
I hereby certify that all construction required
by this sheet has been accomplished as indicated
URS Greiner Woodward Clyde, Inc.
By: *[Signature]* DATE: 1/16/02




REV. NO.	DATE	DESCRIPTION	MADE BY	CHK. BY	APPR. BY
AB	7/99	CONTRACTOR'S AS-BUILT CONDITIONS	JV	JV	RAH
MASSACHUSETTS PORT AUTHORITY BOSTON, MASSACHUSETTS					
BOSTON LOGAN INTERNATIONAL AIRPORT EAST BOSTON, MASSACHUSETTS					
AIRCRAFT FUELING SYSTEMS SCHEDULE B - FUEL STORAGE FACILITY PRODUCT RECOVERY TERMINAL CABINETS DETAILS					
CONSULTANT AND SUBCONSULTANT:					
GREINER INC. TAMPA, FLORIDA EDWARDS AND KELCEY INC. BOSTON, MASSACHUSETTS					
DRAWN BY: SJD		CHKD. BY: CJL/DEV		DWG. NO:	
SCALE: NONE		APPROVED: TDT		DATE: 2/97	
MPA CONTRACT NO.: MPA 1.646C (R)				SHEET NO. 71 OF 730	

AS BUILT

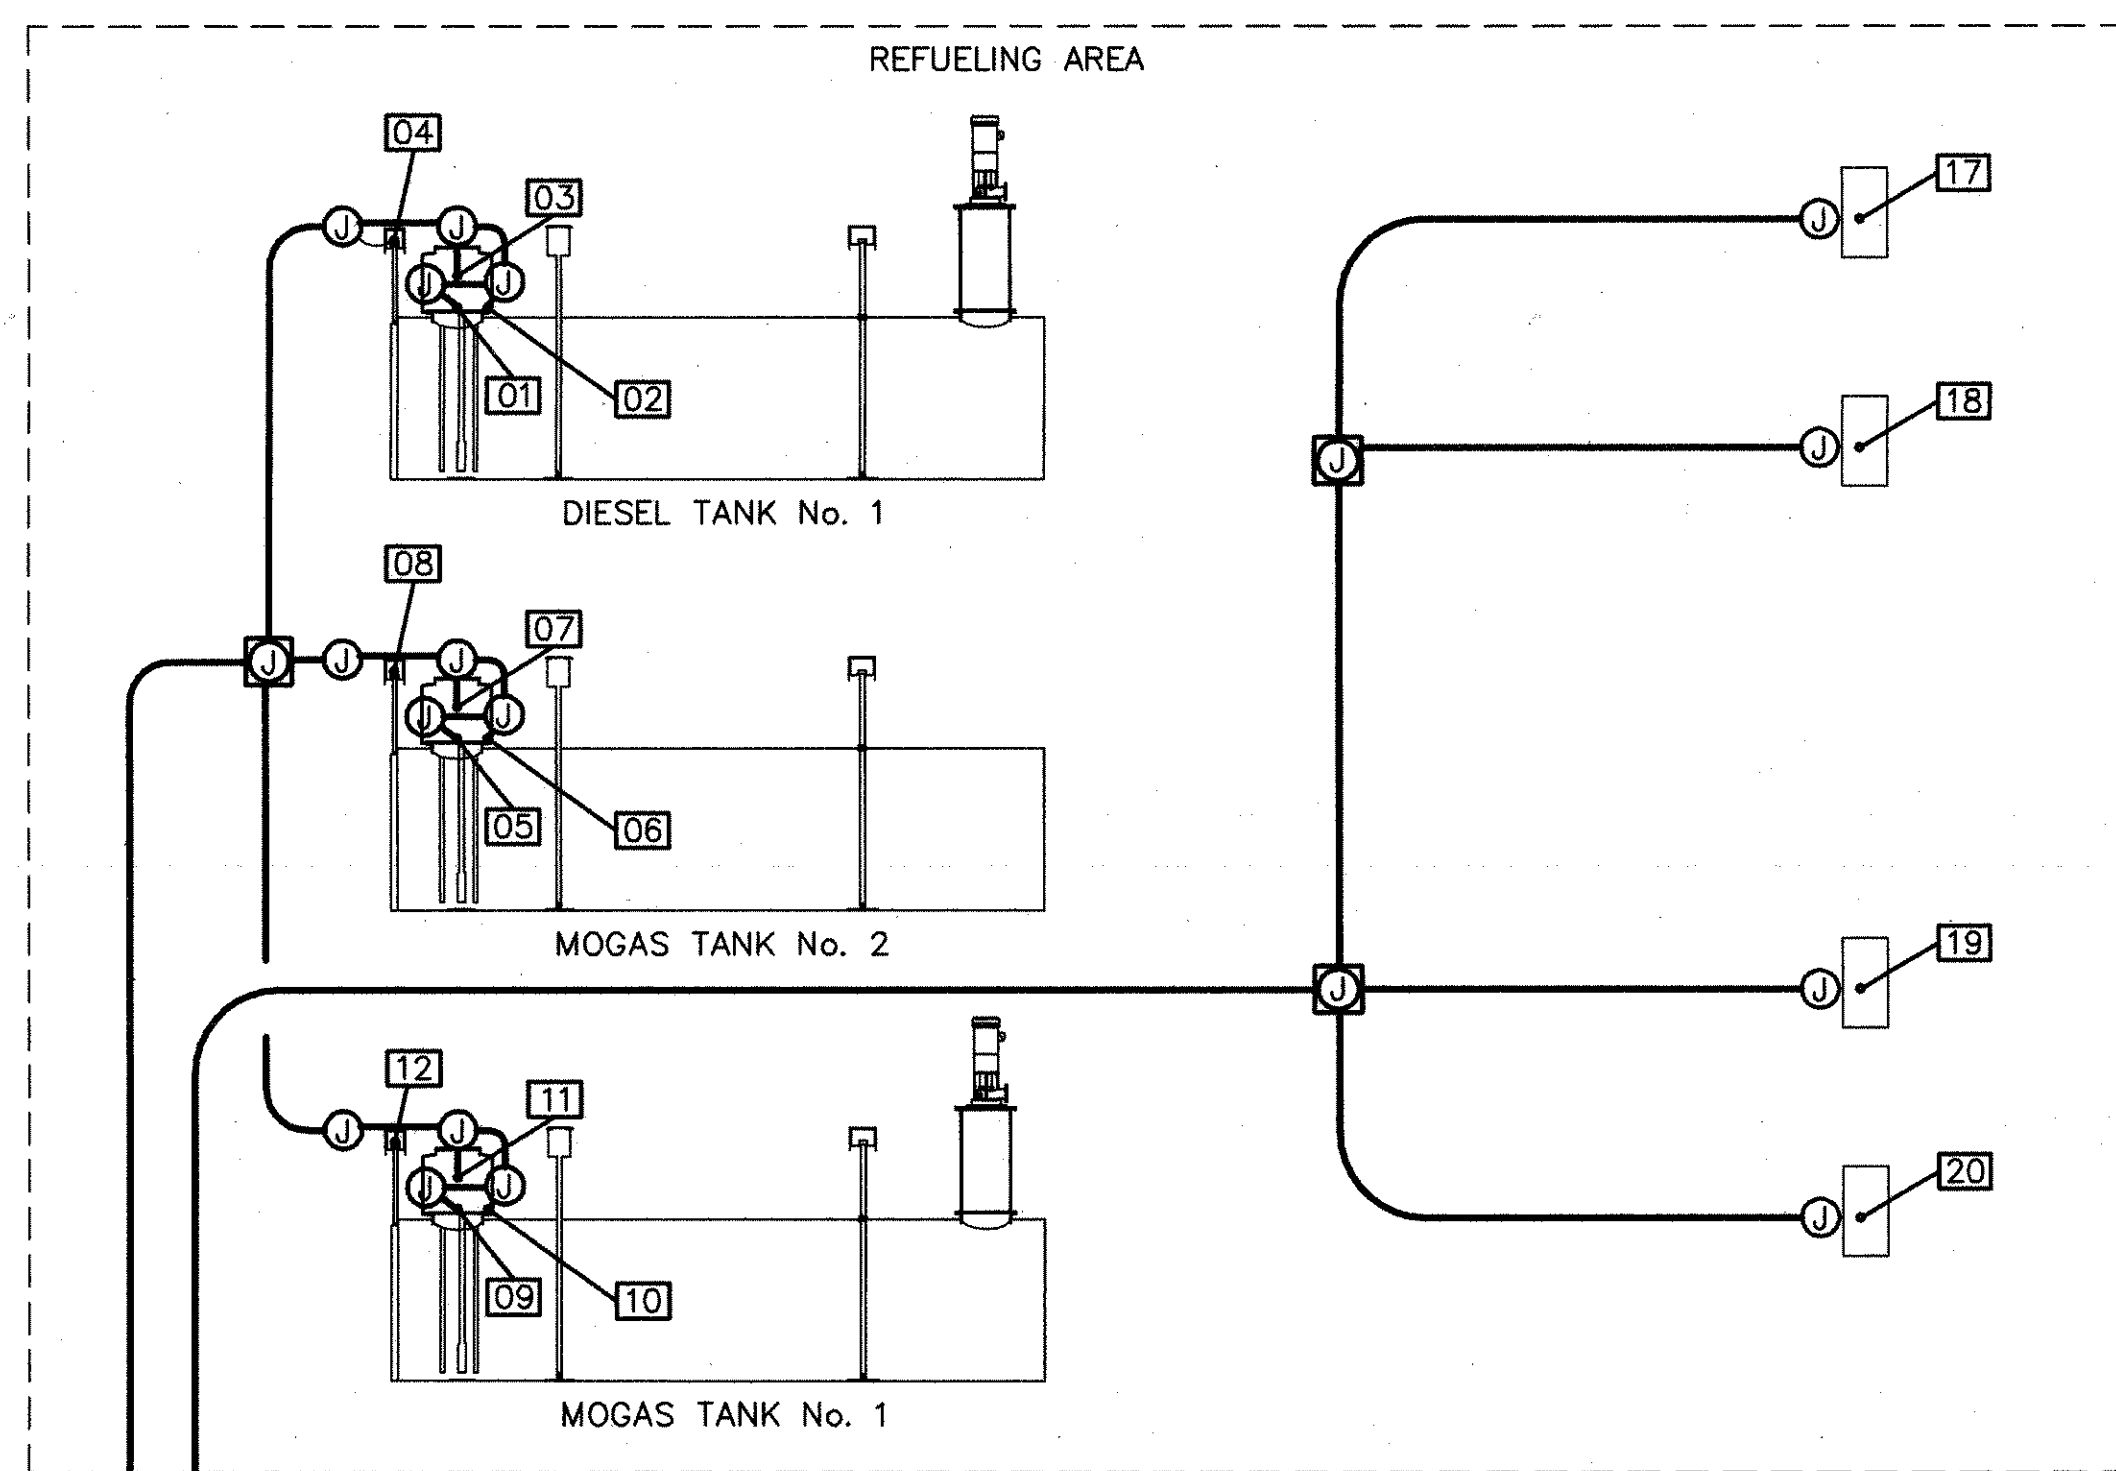


MONITORING POINTS:


- 01 (LD-01) TANK INVENTORY & LEVEL PROBE
- 02 (LD-02) CONTAINMENT SUMP LEAK SENSOR
- 03 (LD-03) PRESSURIZED LINE LEAK PROBE
- 04 (LD-04) INTERSTITIAL SPACE LEAK PROBE
- 05 (LD-05) TANK INVENTORY & LEVEL PROBE
- 06 (LD-06) CONTAINMENT SUMP LEAK SENSOR
- 07 (LD-07) PRESSURIZED LINE LEAK PROBE
- 08 (LD-08) INTERSTITIAL SPACE LEAK PROBE
- 09 (LD-09) TANK INVENTORY & LEVEL PROBE
- 10 (LD-10) CONTAINMENT SUMP LEAK SENSOR
- 11 (LD-11) PRESSURIZED LINE LEAK PROBE
- 12 (LD-12) INTERSTITIAL SPACE LEAK PROBE
- 13 (LD-13) INTERSTITIAL SPACE LEAK PROBE
- 14 (LD-14) INTERSTITIAL SPACE LEAK PROBE
- 15 (LD-15) INTERSTITIAL SPACE LEAK PROBE
- 16 (LD-16) INTERSTITIAL SPACE LEAK PROBE
- 17 (LD-17) DISPENSER PAN LEAK SENSOR
- 18 (LD-18) DISPENSER PAN LEAK SENSOR
- 19 (LD-19) DISPENSER PAN LEAK SENSOR
- 20 (LD-20) DISPENSER PAN LEAK SENSOR

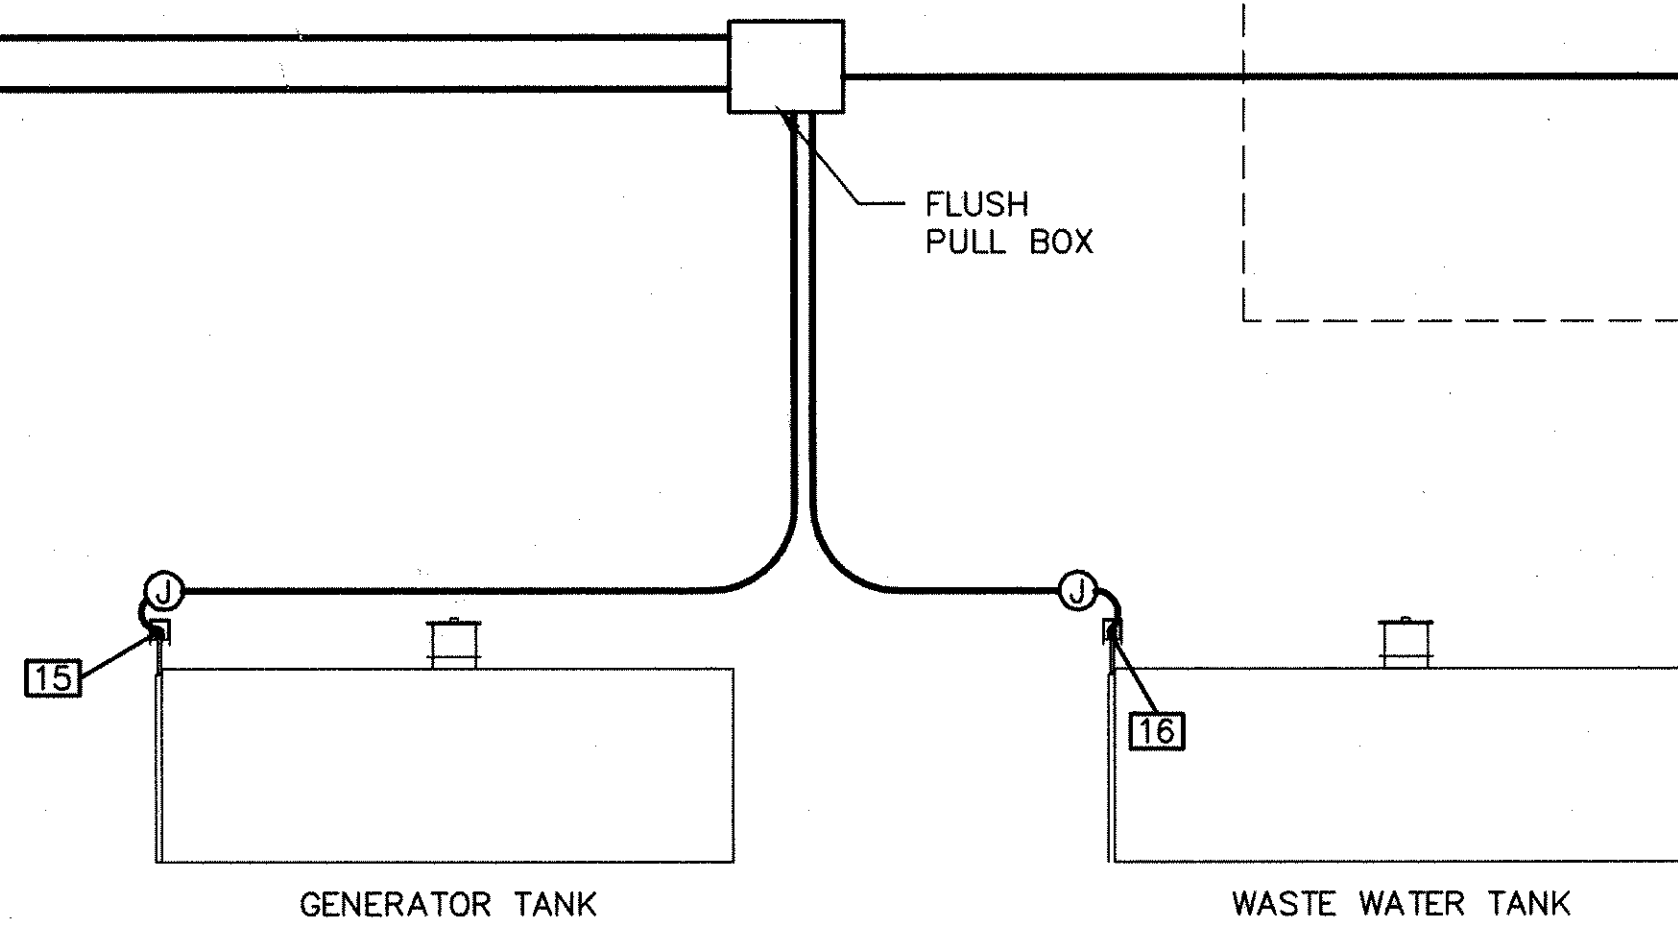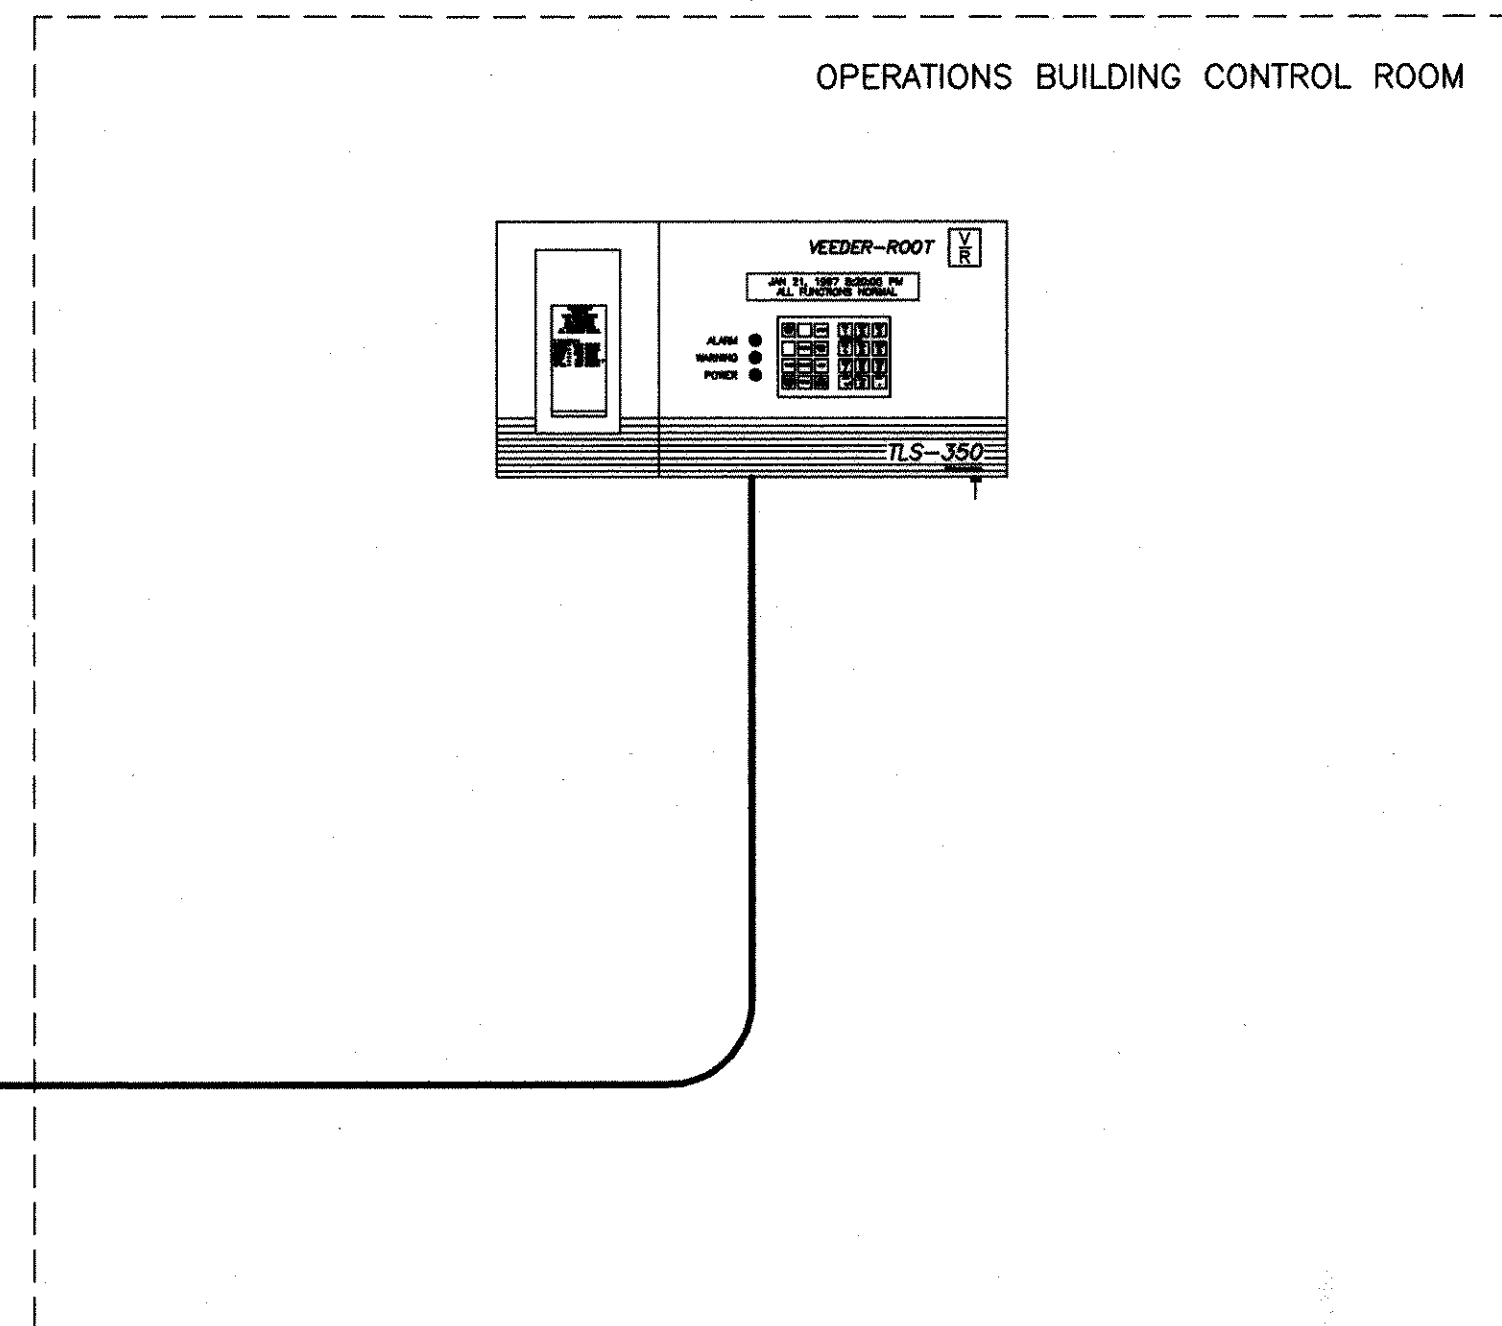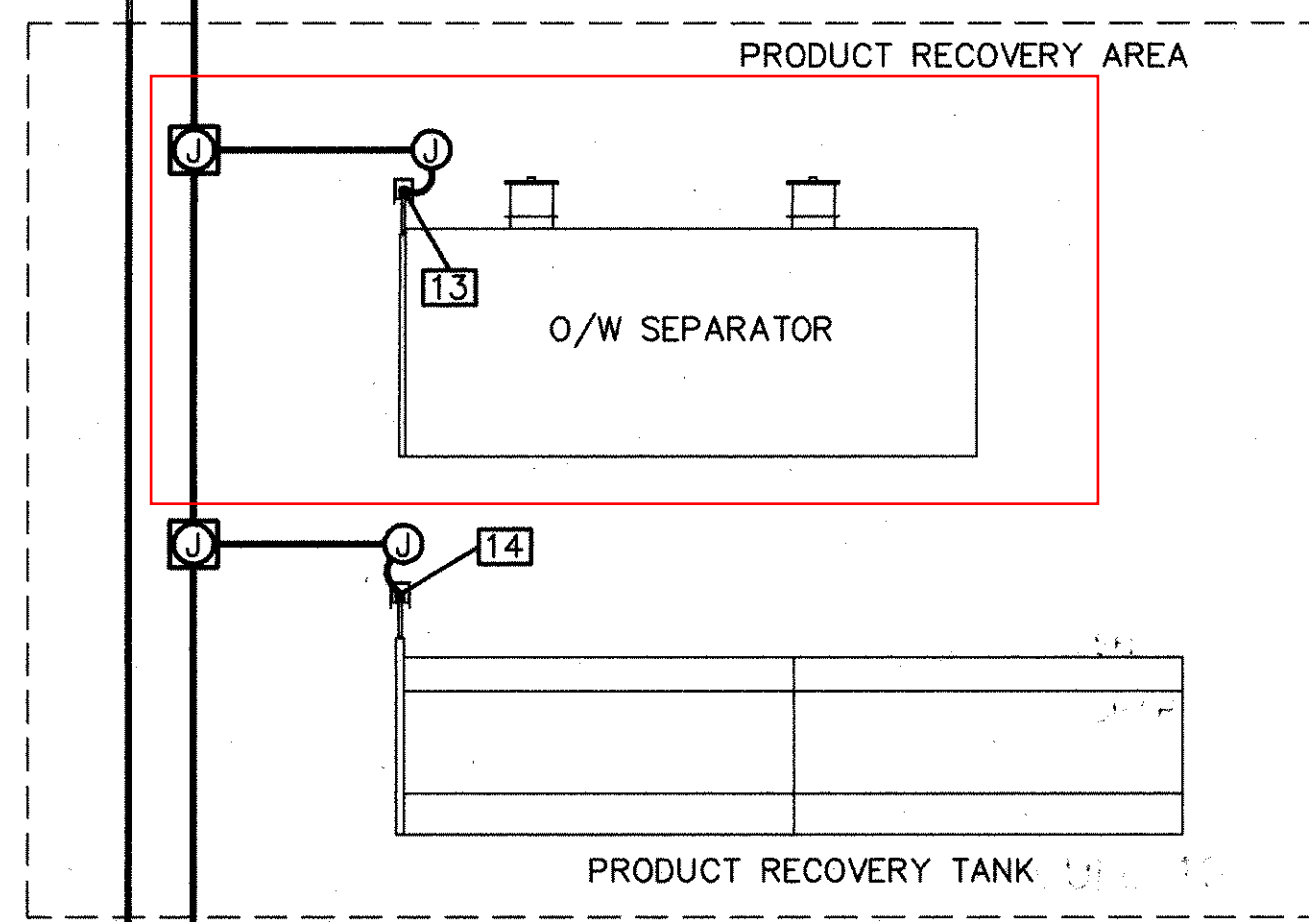

LEAK DETECTION SYSTEM COMMUNICATIONS WIRING DIAGRAM
N.T.S.

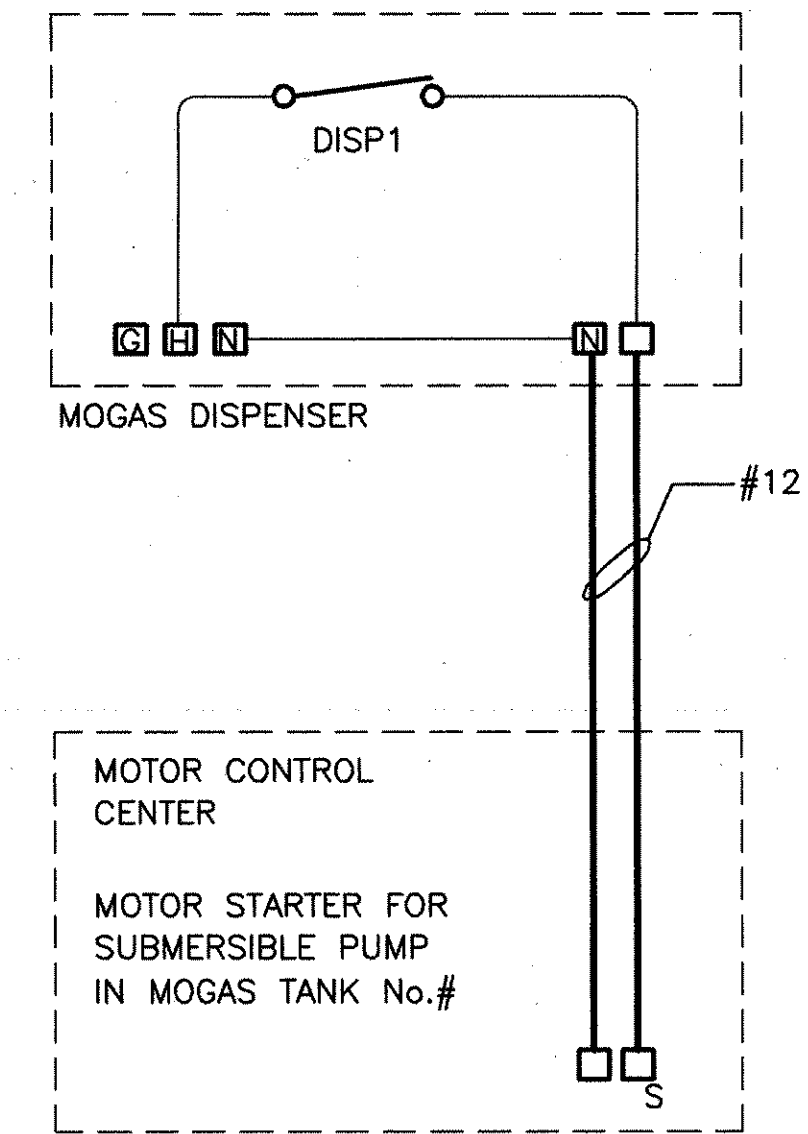

MOGAS SUBMERSIBLE PUMP START WIRING DIAGRAM
N.T.S.

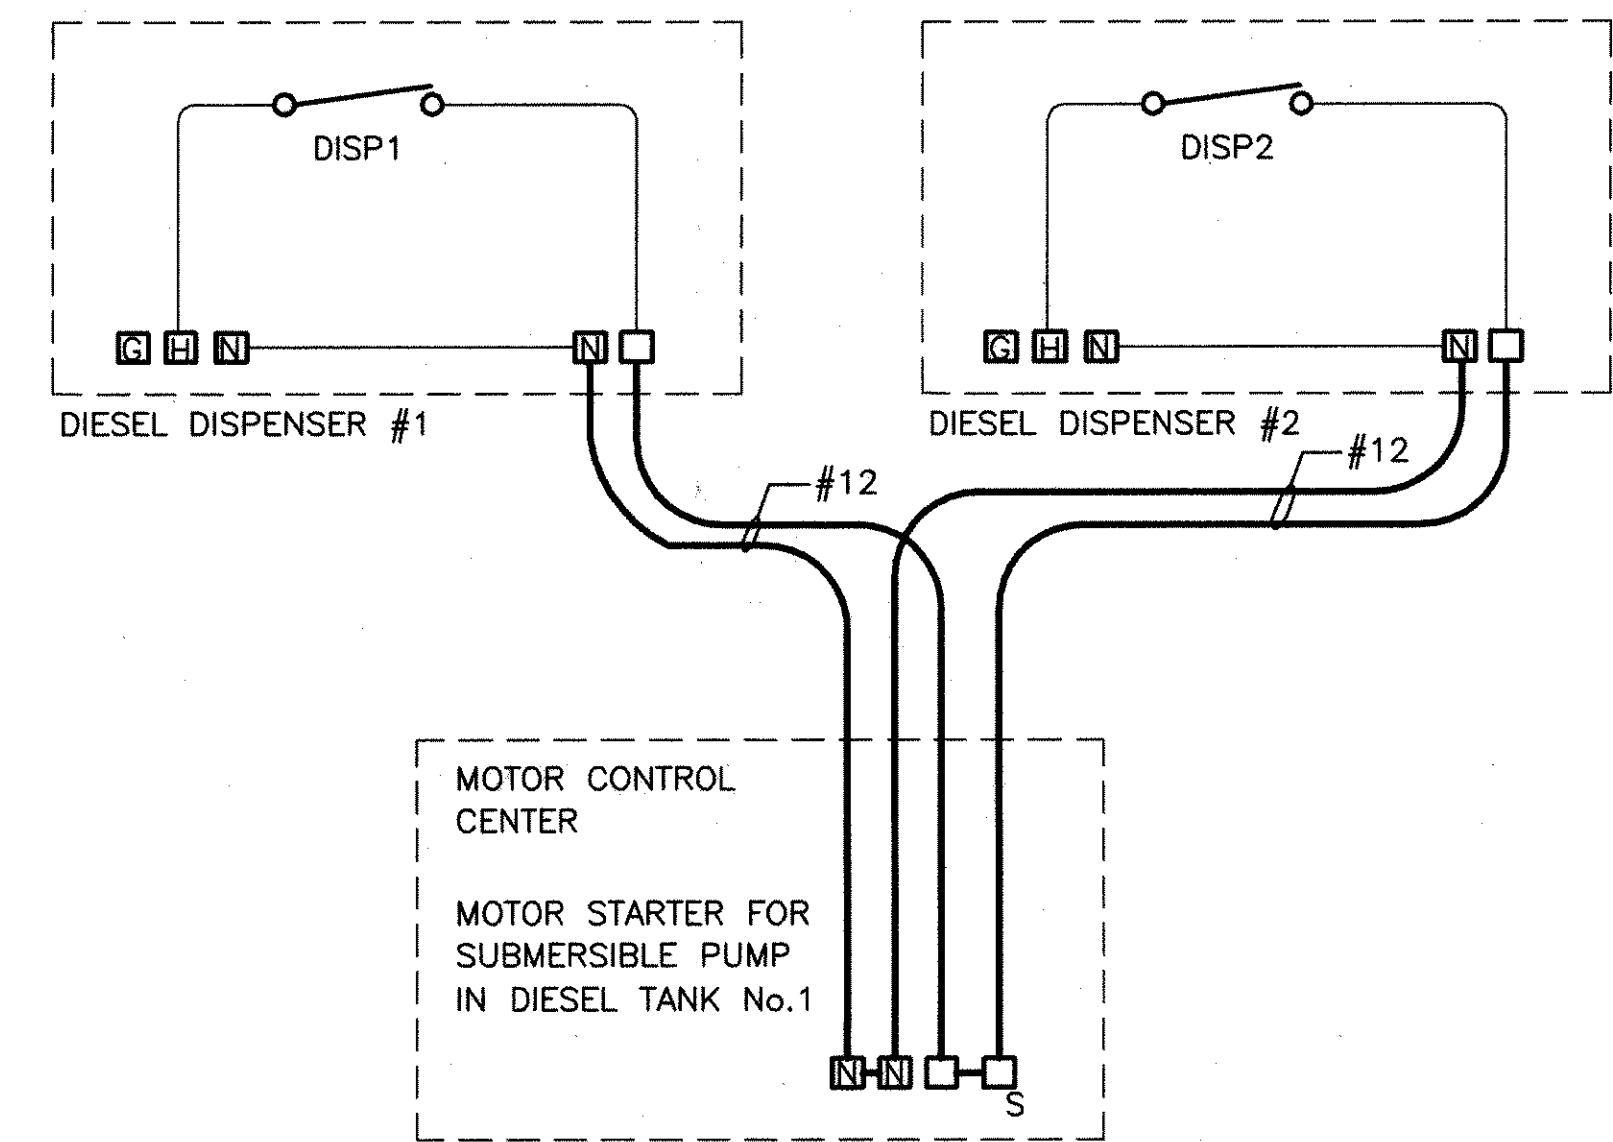

DIESEL SUBMERSIBLE PUMP START WIRING DIAGRAM
N.T.S.




FOR REFERENCE ONLY

AS CONSTRUCTED PLANS
I hereby certify that all construction required
by this sheet has been accomplished as indicated

URS Greiner Woodward Clyde, Inc.
By: *[Signature]* DATE: 1/10/02

AB	7/99	CONTRACTOR'S AS-BUILT CONDITIONS	JV	JV	RAH
REV. NO.	DATE	DESCRIPTION	MADE BY	CHK. BY	APPD. BY
MASSACHUSETTS PORT AUTHORITY BOSTON, MASSACHUSETTS					
BOSTON LOGAN INTERNATIONAL AIRPORT EAST BOSTON, MASSACHUSETTS					
AIRCRAFT FUELING SYSTEMS SCHEDULE B - FUEL STORAGE FACILITY INSTRUMENTATION WIRING DIAGRAM					
CONSULTANT AND SUBCONSULTANT: GREINER INC. TAMPA, FLORIDA EDWARDS AND KELCEY INC. BOSTON, MASSACHUSETTS					
DRAWN BY:	SJD	CHKD. BY:	CJL/DEV	DWG. NO.:	1-4.04
SCALE:	NONE	APPROVED:	TDT	DATE:	2/97
MPA CONTRACT NO.: MPA 1.646C (R)					SHEET NO. 121 OF 200

T:\BOSTON AB\BOSFUELV\FUELSTOR\INST-AB\1-602ABC.DWG 10/09/01 13:02

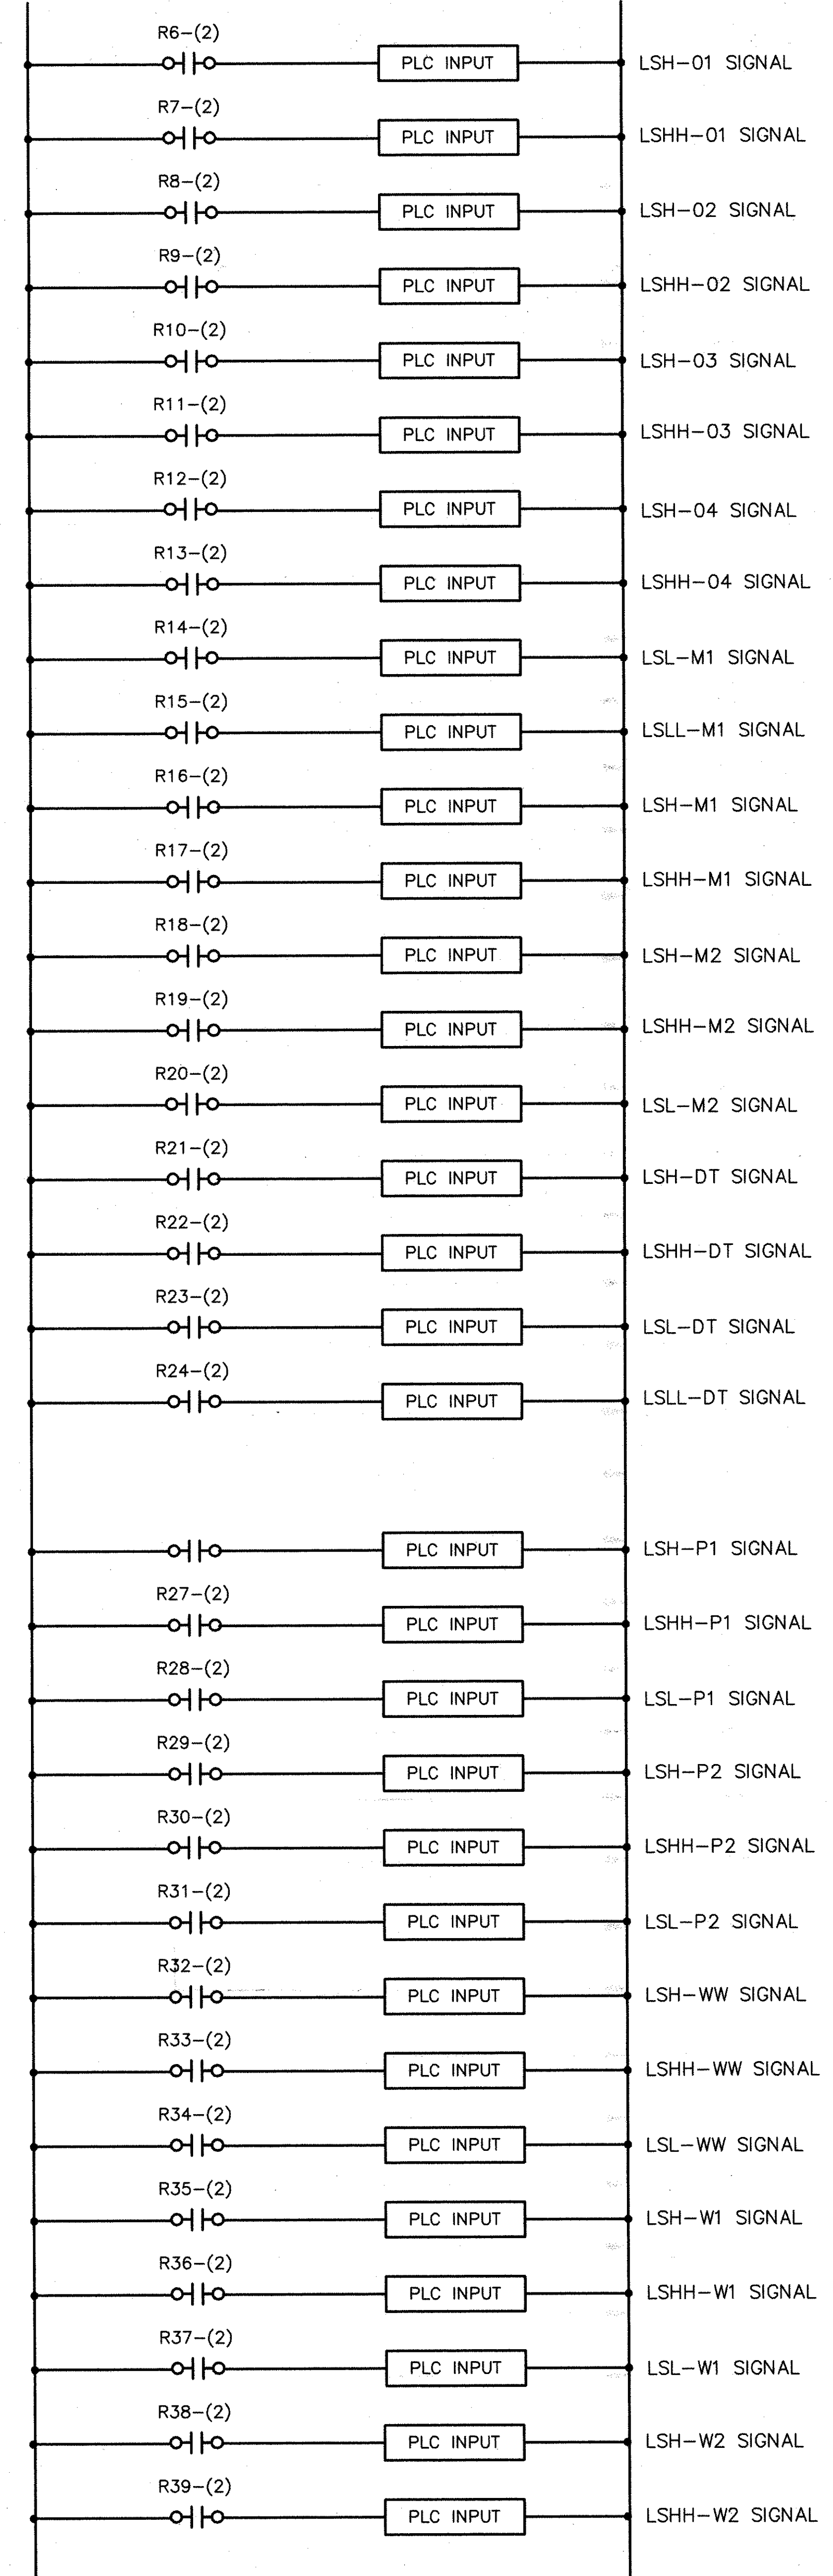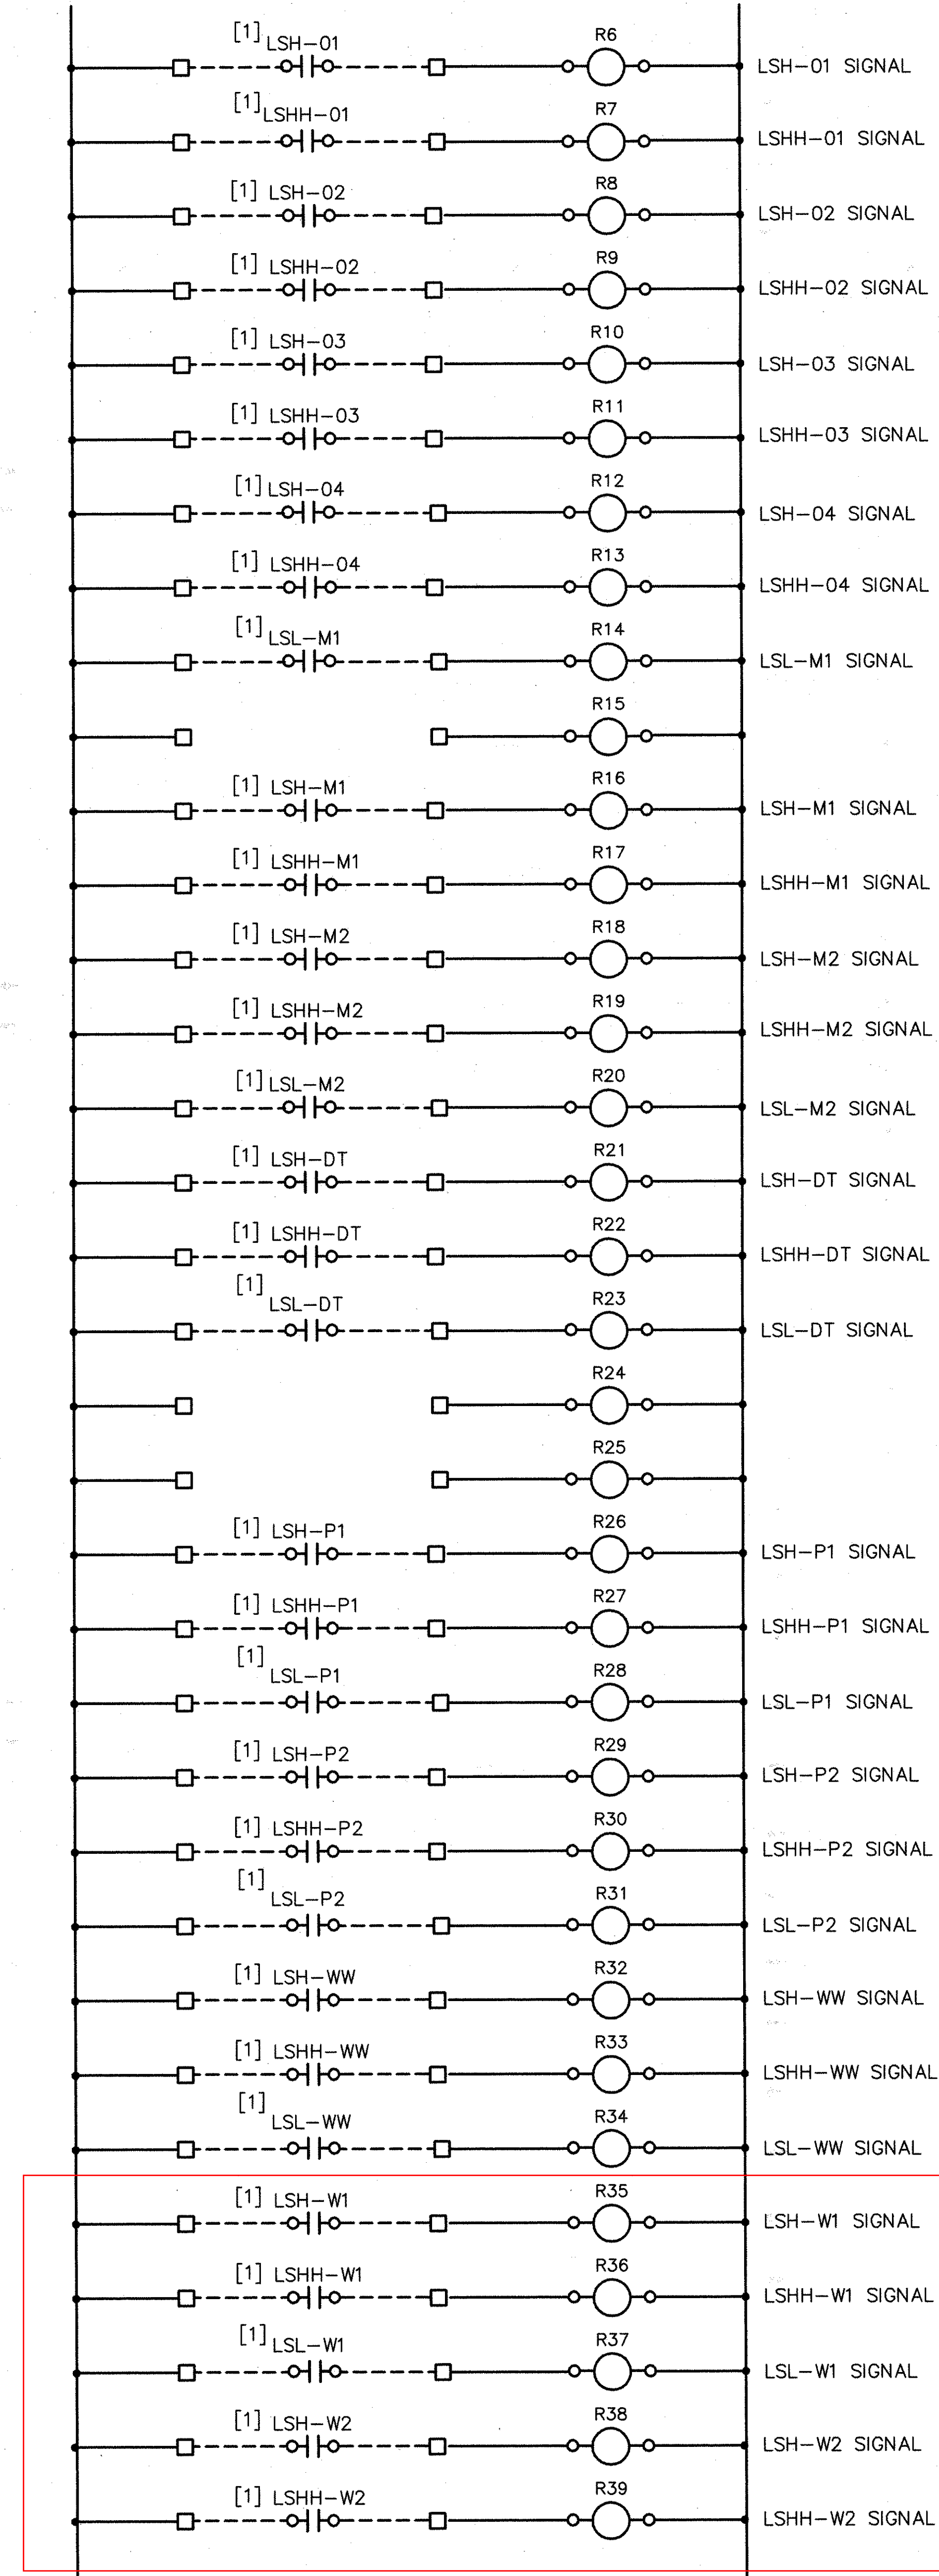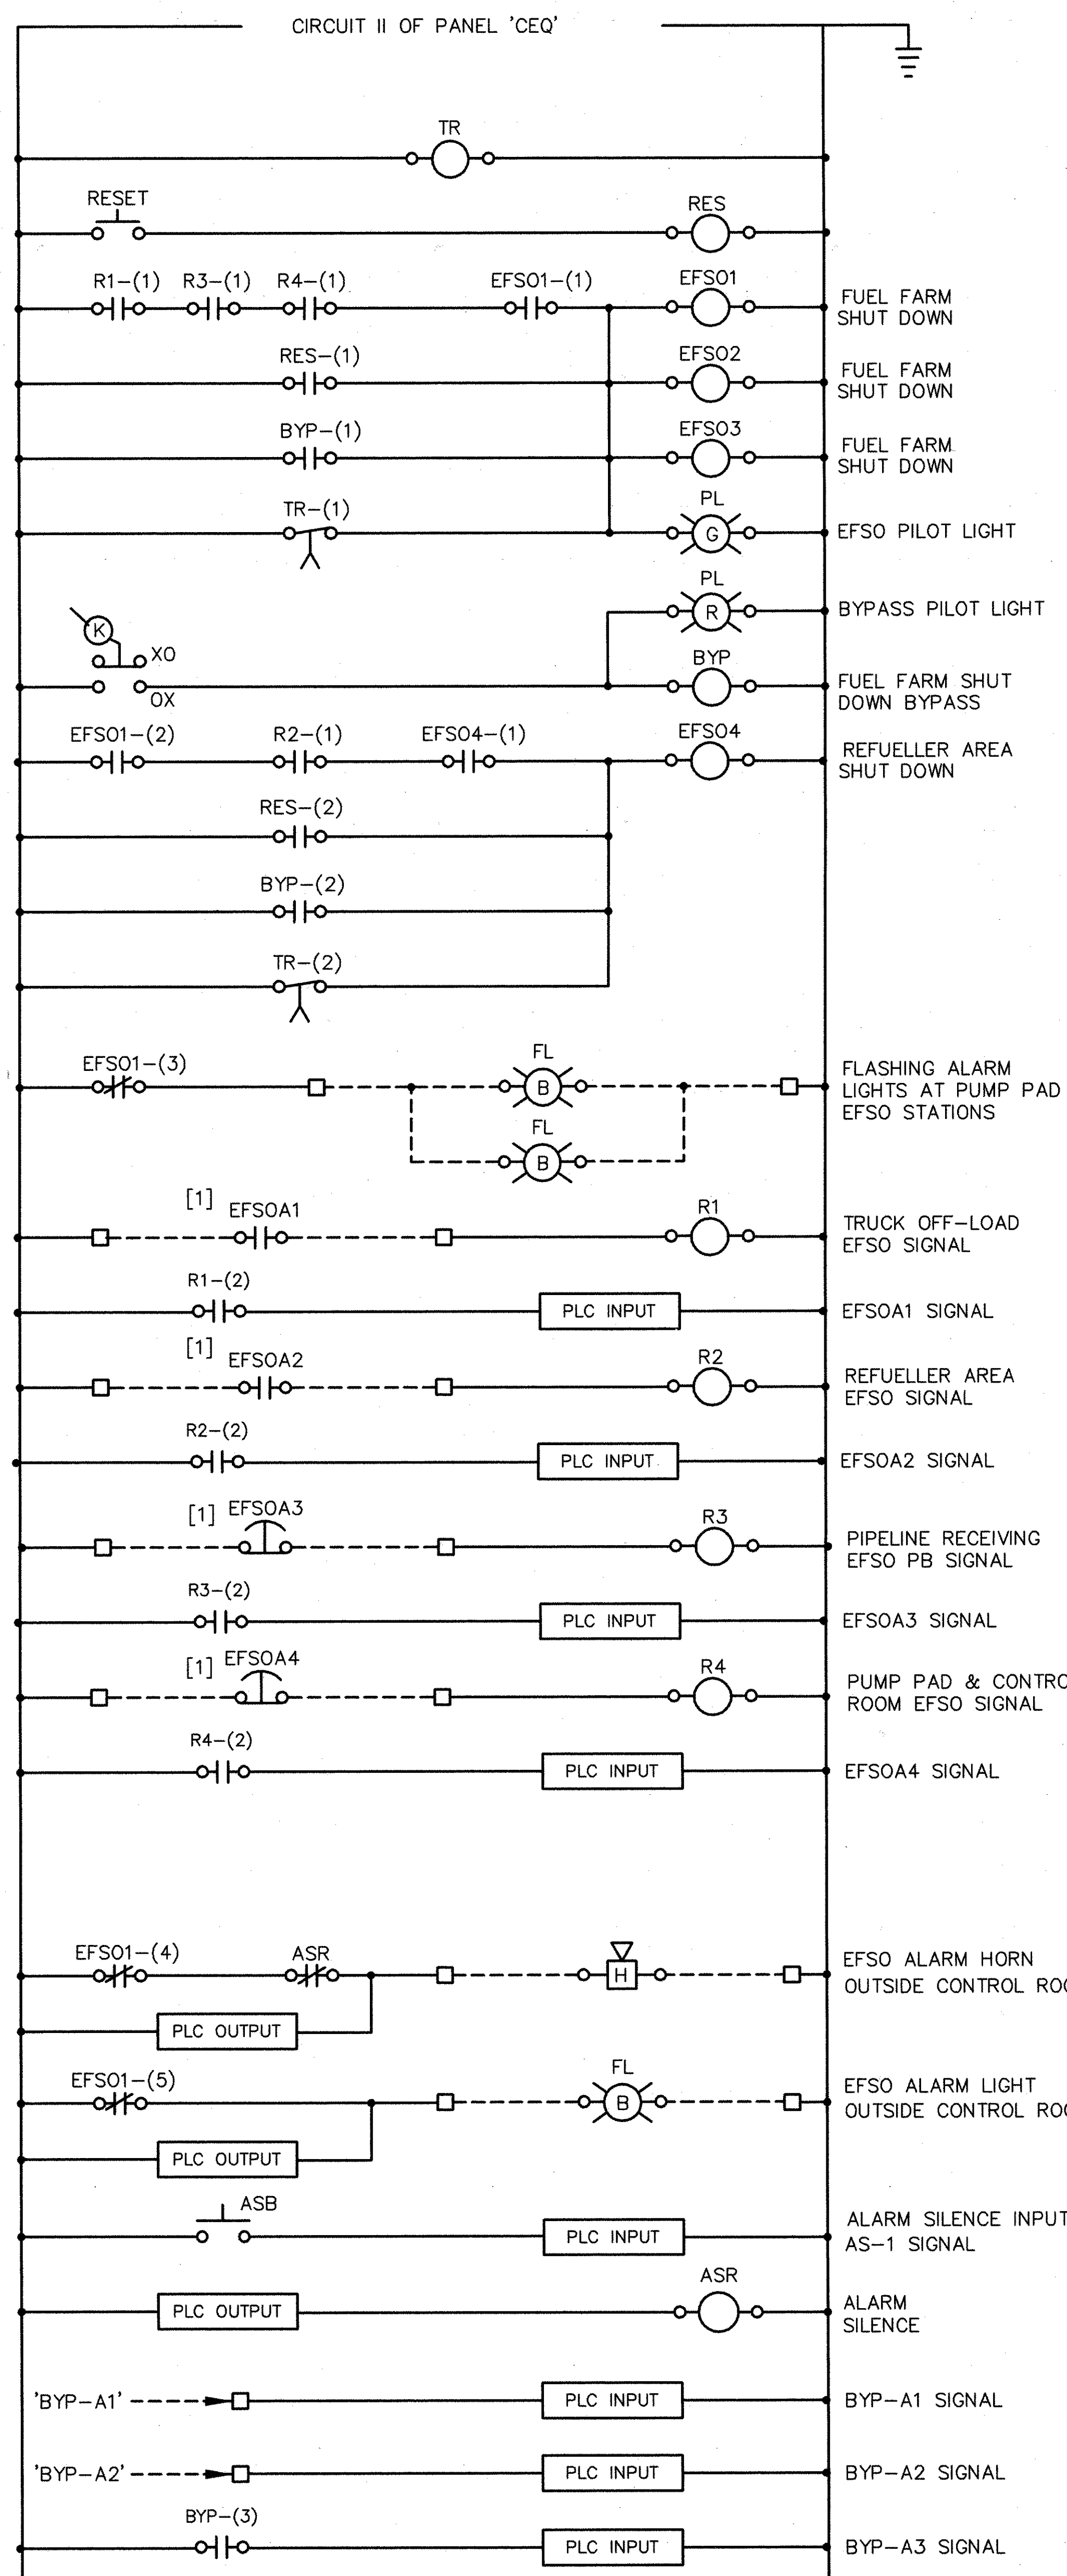

GENERAL NOTES:
1. REFER TO LEGEND ON SHEET I-6.03.

DIAGRAM NOTES:
[1] SEE REMOTE CONTACT SCHEDULE FOR LOCATION ON SHEET I-6.04.

FOR REFERENCE ONLY


AS CONSTRUCTED PLANS
I hereby certify that all construction required by this sheet has been accomplished as indicated

JRS Greiner Woodward Clyde, Inc.
BY: *[Signature]* DATE: 1/96

AB	7/98	CONTRACTOR'S AS-BUILT CONDITIONS	JV	JV	RAH
REV. NO.	DATE	DESCRIPTION	MADE BY	CHK. BY	APPD. BY
MASSACHUSETTS PORT AUTHORITY BOSTON, MASSACHUSETTS					
BOSTON LOGAN INTERNATIONAL AIRPORT EAST BOSTON, MASSACHUSETTS					
AIRCRAFT FUELING SYSTEMS SCHEDULE B - FUEL STORAGE FACILITY CONTROL CABINET WIRING DIAGRAM					
CONSULTANT AND SUBCONSULTANT: GREINER INC. TAMPA, FLORIDA EDWARDS AND KELCEY INC. BOSTON, MASSACHUSETTS					
DRAWN BY: SAD		CHKD. BY: C.JL/DEV		DWG. NO:	
SCALE: NONE		APPROVED: TDT		DATE: 2/97	
MPA CONTRACT NO.: MPA 1.646C (R)				SHEET NO. <i>102</i> OF <i>200</i>	

CONTROL CABINET WIRING DIAGRAM
NOT TO SCALE

AS BUILT

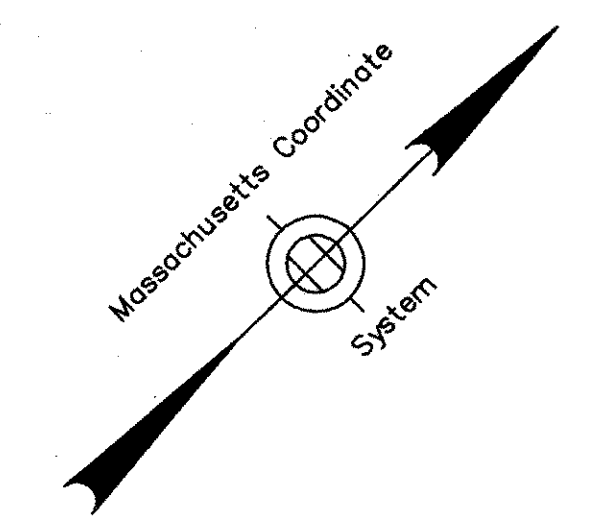


GENERAL NOTES:


1. REFER TO GENERAL NOTES ON SHEET I-1.01.
2. ALL CONDUITS AND DUCTBANKS SHOWN ARE TO BE INSTALLED BY OTHERS UNDER SEPARATE CONTRACT.

REFERENCE NOTES:

- 1 CONTROL CABINET BAY #1 - PLC COMPARTMENT.
- 2 CONTROL CABINET BAY #2 - COMMUNICATIONS COMPARTMENT.
- 3 CONTROL CABINET BAY #3 - DIGITAL COMPARTMENT.
- 4 CONTROL CABINET BAY #4 - 120V SIGNAL COMPARTMENT.
- 5 CONTROL CABINET BAY #5 - TERMINALS COMPARTMENT.
- 6 COMPUTER IN FULL TOWER CASE, BELOW COUNTER.
- 7 KEYBOARD ON COUNTER.
- 8 21" SVGA COLOR MONITOR.
- 9 EXISTING DATA AND POWER OUTLET (TYPICAL).
- 10 LASER REPORT PRINTER.
- 11 BUBBLE JET COLOR GRAPH PRINTER.
- 12 DOT MATRIX ALARM PRINTER.
- 13 VEEDER ROOT TLS-350 UNDERGROUND TANK LEAK DETECTION & LEVEL MONITORING CONTROL CABINET.
- 14 PROVIDE (2) CAT-5, 100-BASE-T CABLE AND (1) BELDEN No. 9463 IN ONE EX. 1" C.
- 15 PROVIDE (3) CAT-5, 100-BASE-T CABLE AND (1) BELDEN No. 9463 IN ONE EX. 1" C.
- 16 PROVIDE 10-#12 IN EX. 1" C. (ATS'S & GEN SIGNALS).
- 17 PROVIDE 2-#12 IN EX. 1" C. (GEN SIGNAL).
- 18 PROVIDE 4-#12 IN EX. 1" C. (ATS-N & ATS-E SIGNALS).

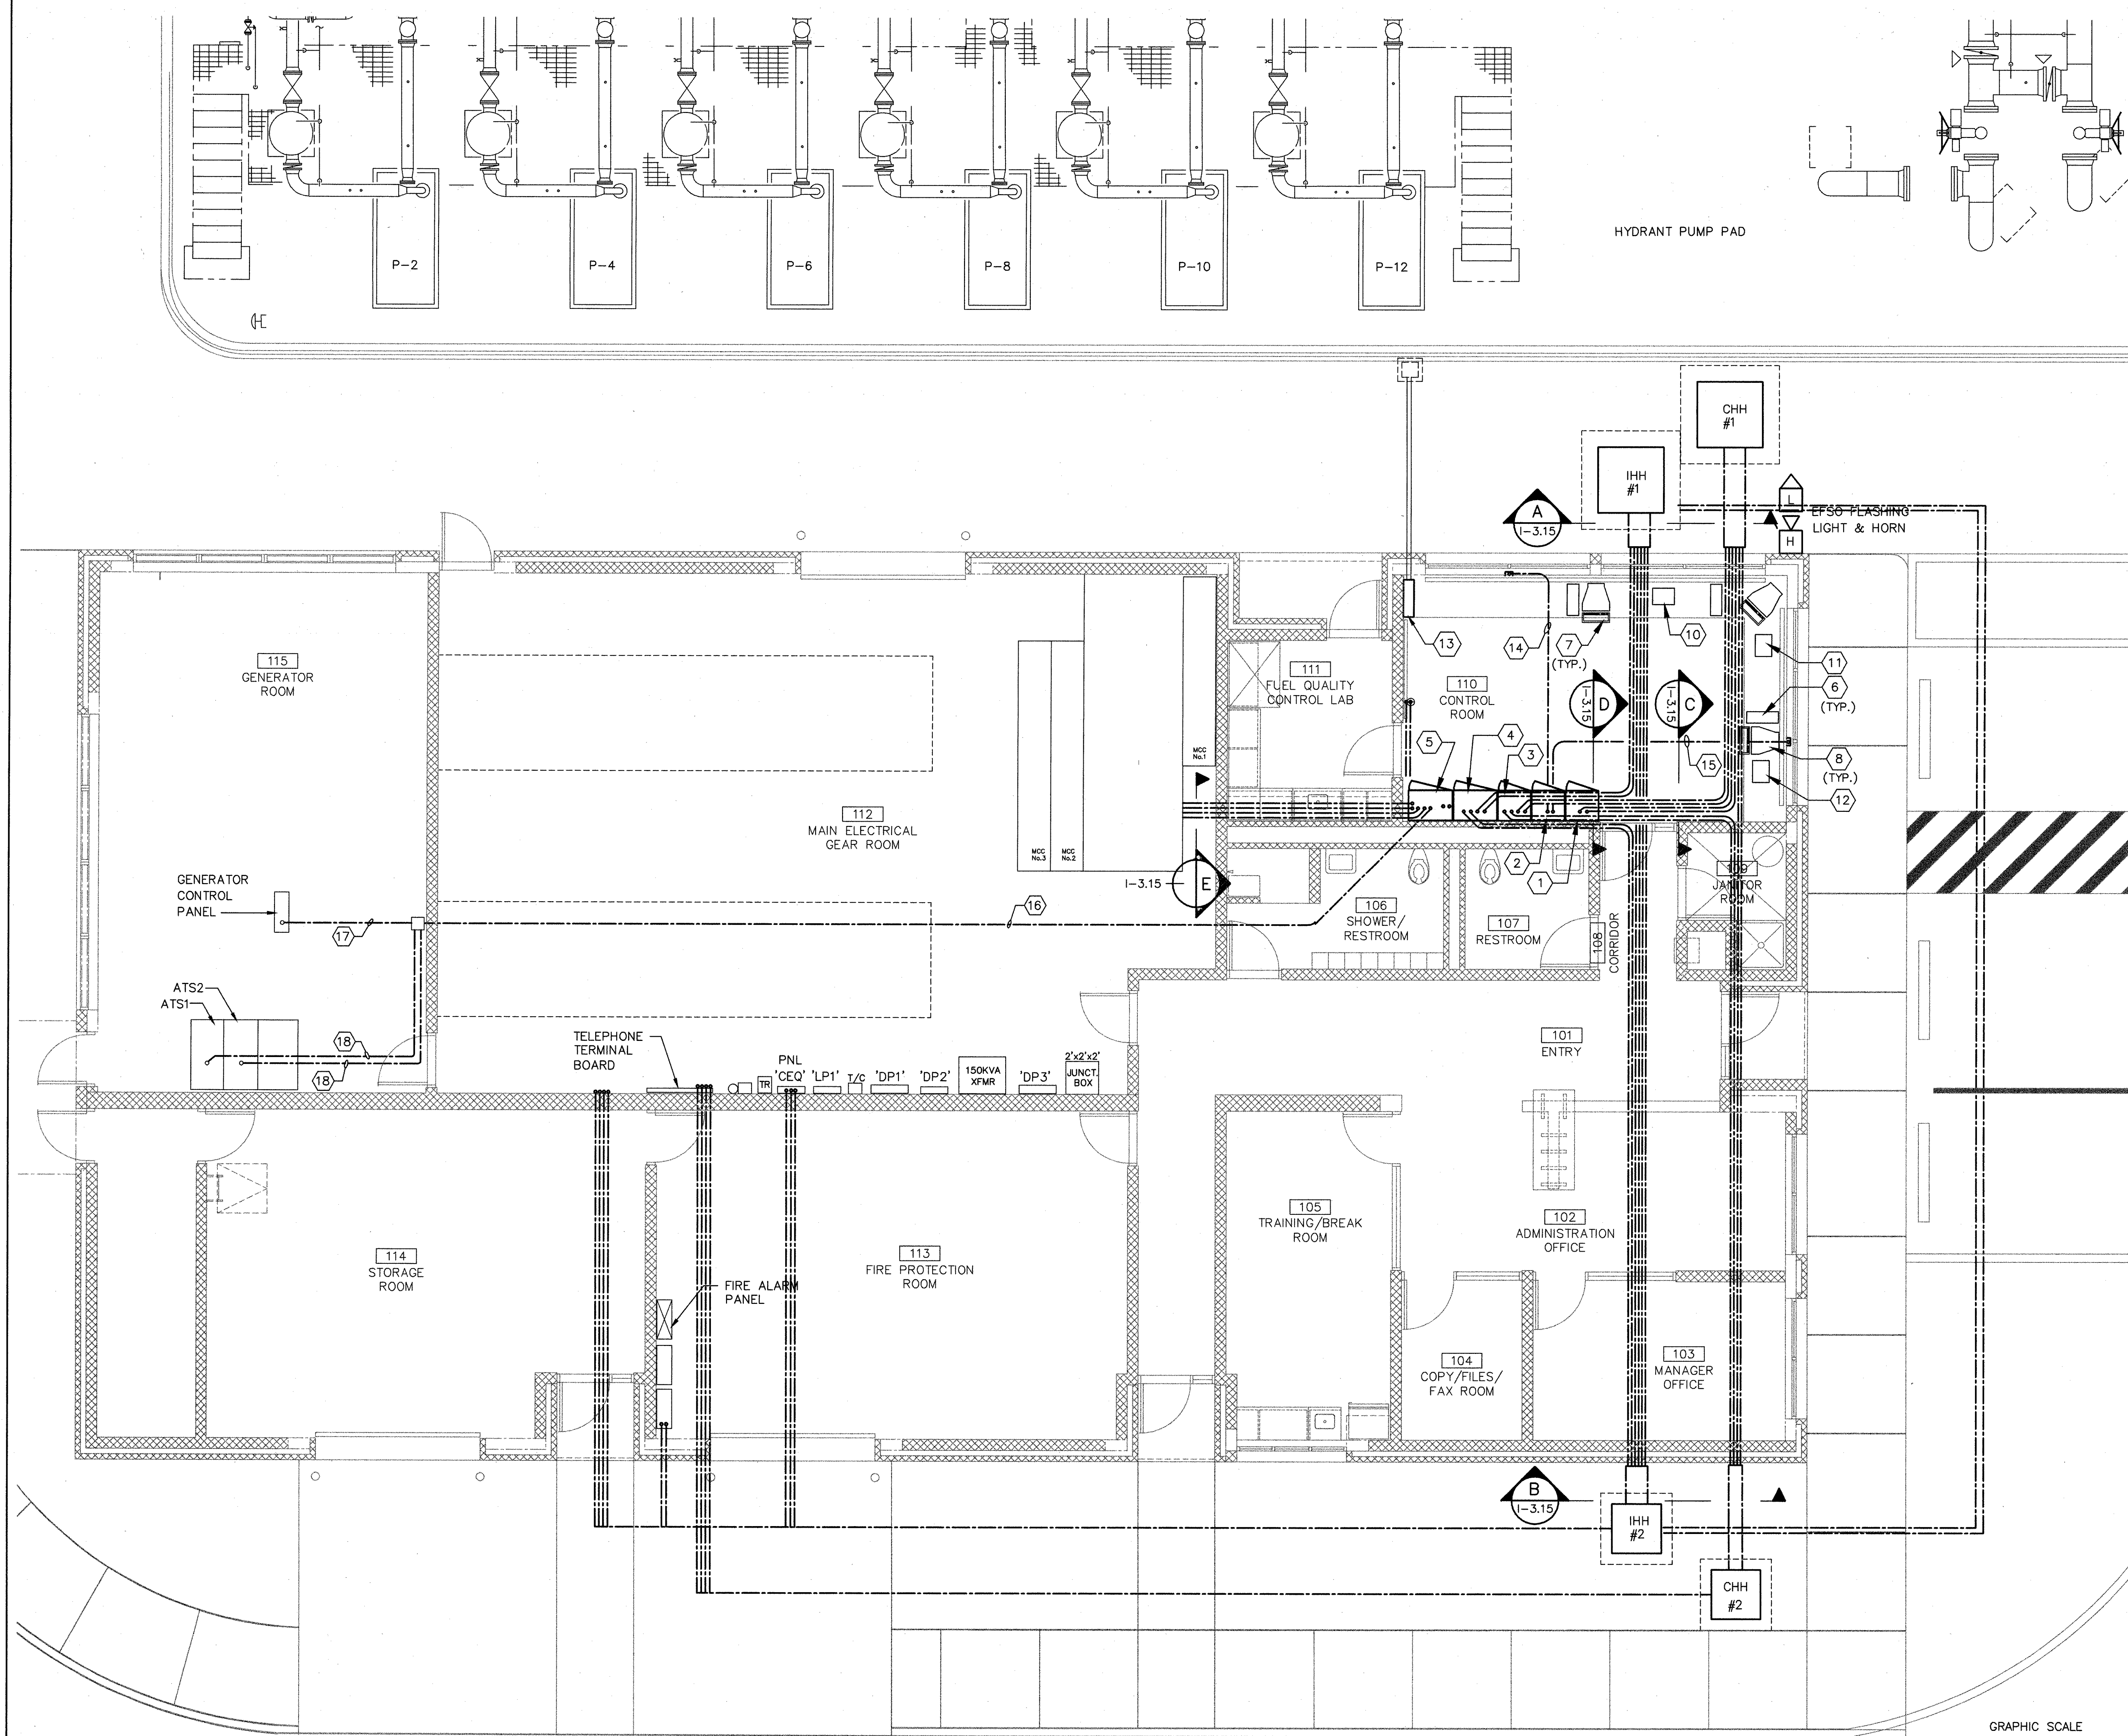

OPERATIONS BUILDING - CONTROL ROOM PARTIAL PLAN
SCALE: 1/4" = 1' - 0"

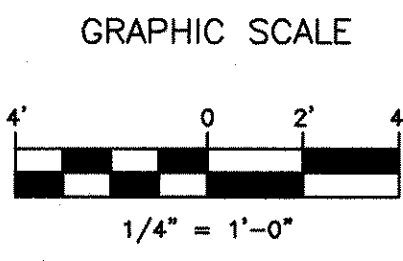

FOR REFERENCE ONLY

REV. NO.	DATE	DESCRIPTION	MADE BY	CHK. BY	APPD. BY
MASSACHUSETTS PORT AUTHORITY BOSTON, MASSACHUSETTS					
BOSTON LOGAN INTERNATIONAL AIRPORT EAST BOSTON, MASSACHUSETTS					
AIRCRAFT FUELING SYSTEMS SCHEDULE B - FUEL STORAGE FACILITY OPERATIONS BUILDING - CONTROL ROOM PARTIAL PLAN					
CONSULTANT AND SUBCONSULTANT: GREINER INC. TAMPA, FLORIDA EDWARDS AND KELCEY INC. BOSTON, MASSACHUSETTS					
DRAWN BY: CUL	CHKD. BY: CUL/DEV	DWG. NO:			
SCALE: AS NOTED	APPROVED: TDT	DATE: AUG. 1996	I-6.05		
MPA CONTRACT NO.: MPA 1.646C (R)					SHEET NO. 102 OF 100

T:\BOSTON AB\BOSFUEL\FUELS\DR\INST-AB\I-605ABC.DWG 10/09/01 13:31

MAINS: 100A MCB VOLTAGE: 208Y/120		PANELBOARD 'CEQ'						LOCATION: ELECTRICAL ROOM MOUNTING: SURFACE	
CKT NO	DESCRIPTION	BREAKER POLE	AMP	KVA	BREAKER AMP	POLE	DESCRIPTION	CKT NO	
1	MAIN	1	20	1.5	0.7	20	TANK #1 RECTIFIER UNIT	2	
3	MAIN	1	20	1.5	0.7	20	TANK #2 RECTIFIER UNIT	4	
5	MAIN	1	20	1.5	0.7	20	TANK #3 RECTIFIER UNIT	6	
7	TANK #1 MOUNTED INSTRUMENTS	1	20	1.5	0.7	20	TANK #4 RECTIFIER UNIT	8	
9	TANK #2 MOUNTED INSTRUMENTS	1	20	1.0	1.5	20	F/S 1,3 INSTRUMENTS	10	
11	TANK #3 MOUNTED INSTRUMENTS	1	20	1.0	1.5	20	F/S 5,7 INSTRUMENTS	12	
13	TANK #4 MOUNTED INSTRUMENTS	1	20	1.5	1.5	20	F/S 9,11 INSTRUMENTS	14	
15	SPARE IN MANHOLE IHH-2	1	20	1.0	1.5	20	F/S 2,4 INSTRUMENTS	16	
17	SPARE	1	20	-	1.5	20	F/S 6,8 INSTRUMENTS	18	
19	SPARE IN MANHOLE IHH-2	1	20	-	1.5	20	F/S 10,12 INSTRUMENTS	20	
21	LEVEL ALARM CABINETS	1	20	1.5	1.5	20	F/S 10,12 INSTRUMENTS	22	
23	OIL/WATER SEP. RECOVERY TANK	1	20	1.5	-	20	SPARE IN MANHOLE IHH-2	24	
25	INBOUND FILTRATION	1	20	1.5	1.5	20	ENRAF PRODUCT RECOVERY	26	
27	SPARE	1	20	-	-	20	SPARE AT REFUELLER CABINET	28	
29	SPARE	1	20	-	-	20	SPARE	30	
31	SPARE	1	20	-	-	20	SPARE	32	
33	SPARE	1	20	-	-	20	SPARE	34	
35	SPARE	1	20	-	-	20	SPARE	36	
37	SPARE	1	20	-	-	20	SPARE	38	
39	SPARE	1	20	-	-	20	SPARE	40	
41	IMS FEED	1	20	1.5	1.5	20	CARD READER	42	
43	SPARE	1	20	-	-	20	SPARE	44	
45	DISPENSER	1	20	1.5	-	20	SPARE	46	


CONNECTED LOAD 32.3 KVA

NOTES:
1. ALL BREAKERS SHALL HAVE AN INTERRUPTING RATING 22,000 AMPS SYMM.

INSTRUMENTATION - POWER PANEL SCHEDULE
NOT TO SCALE

FOR REFERENCE ONLY

AB	3/99	CONTRACTOR'S AS-BUILT CONDITIONS	JTV/CGH	JTV	RAH
REV. NO.	DATE	DESCRIPTION	MADE BY	CHK. BY	APPD. BY
MASSACHUSETTS PORT AUTHORITY BOSTON, MASSACHUSETTS BOSTON LOGAN INTERNATIONAL AIRPORT EAST BOSTON, MASSACHUSETTS AIRCRAFT FUELING SYSTEMS SCHEDULE B - FUEL STORAGE FACILITY POWER PANEL SCHEDULE					
CONSULTANT AND SUBCONSULTANT: GREINER INC. TAMPA, FLORIDA EDWARDS AND KELCEY INC. BOSTON, MASSACHUSETTS					
DRAWN BY: SAD		CHKD. BY: C.J./DEV		DWG. NO:	
SCALE: NONE		APPROVED: TDT		DATE: 2/97	
MPA CONTRACT NO.: MPA 1.646C (R)				SHEET NO. <u>12</u> OF <u>22</u>	

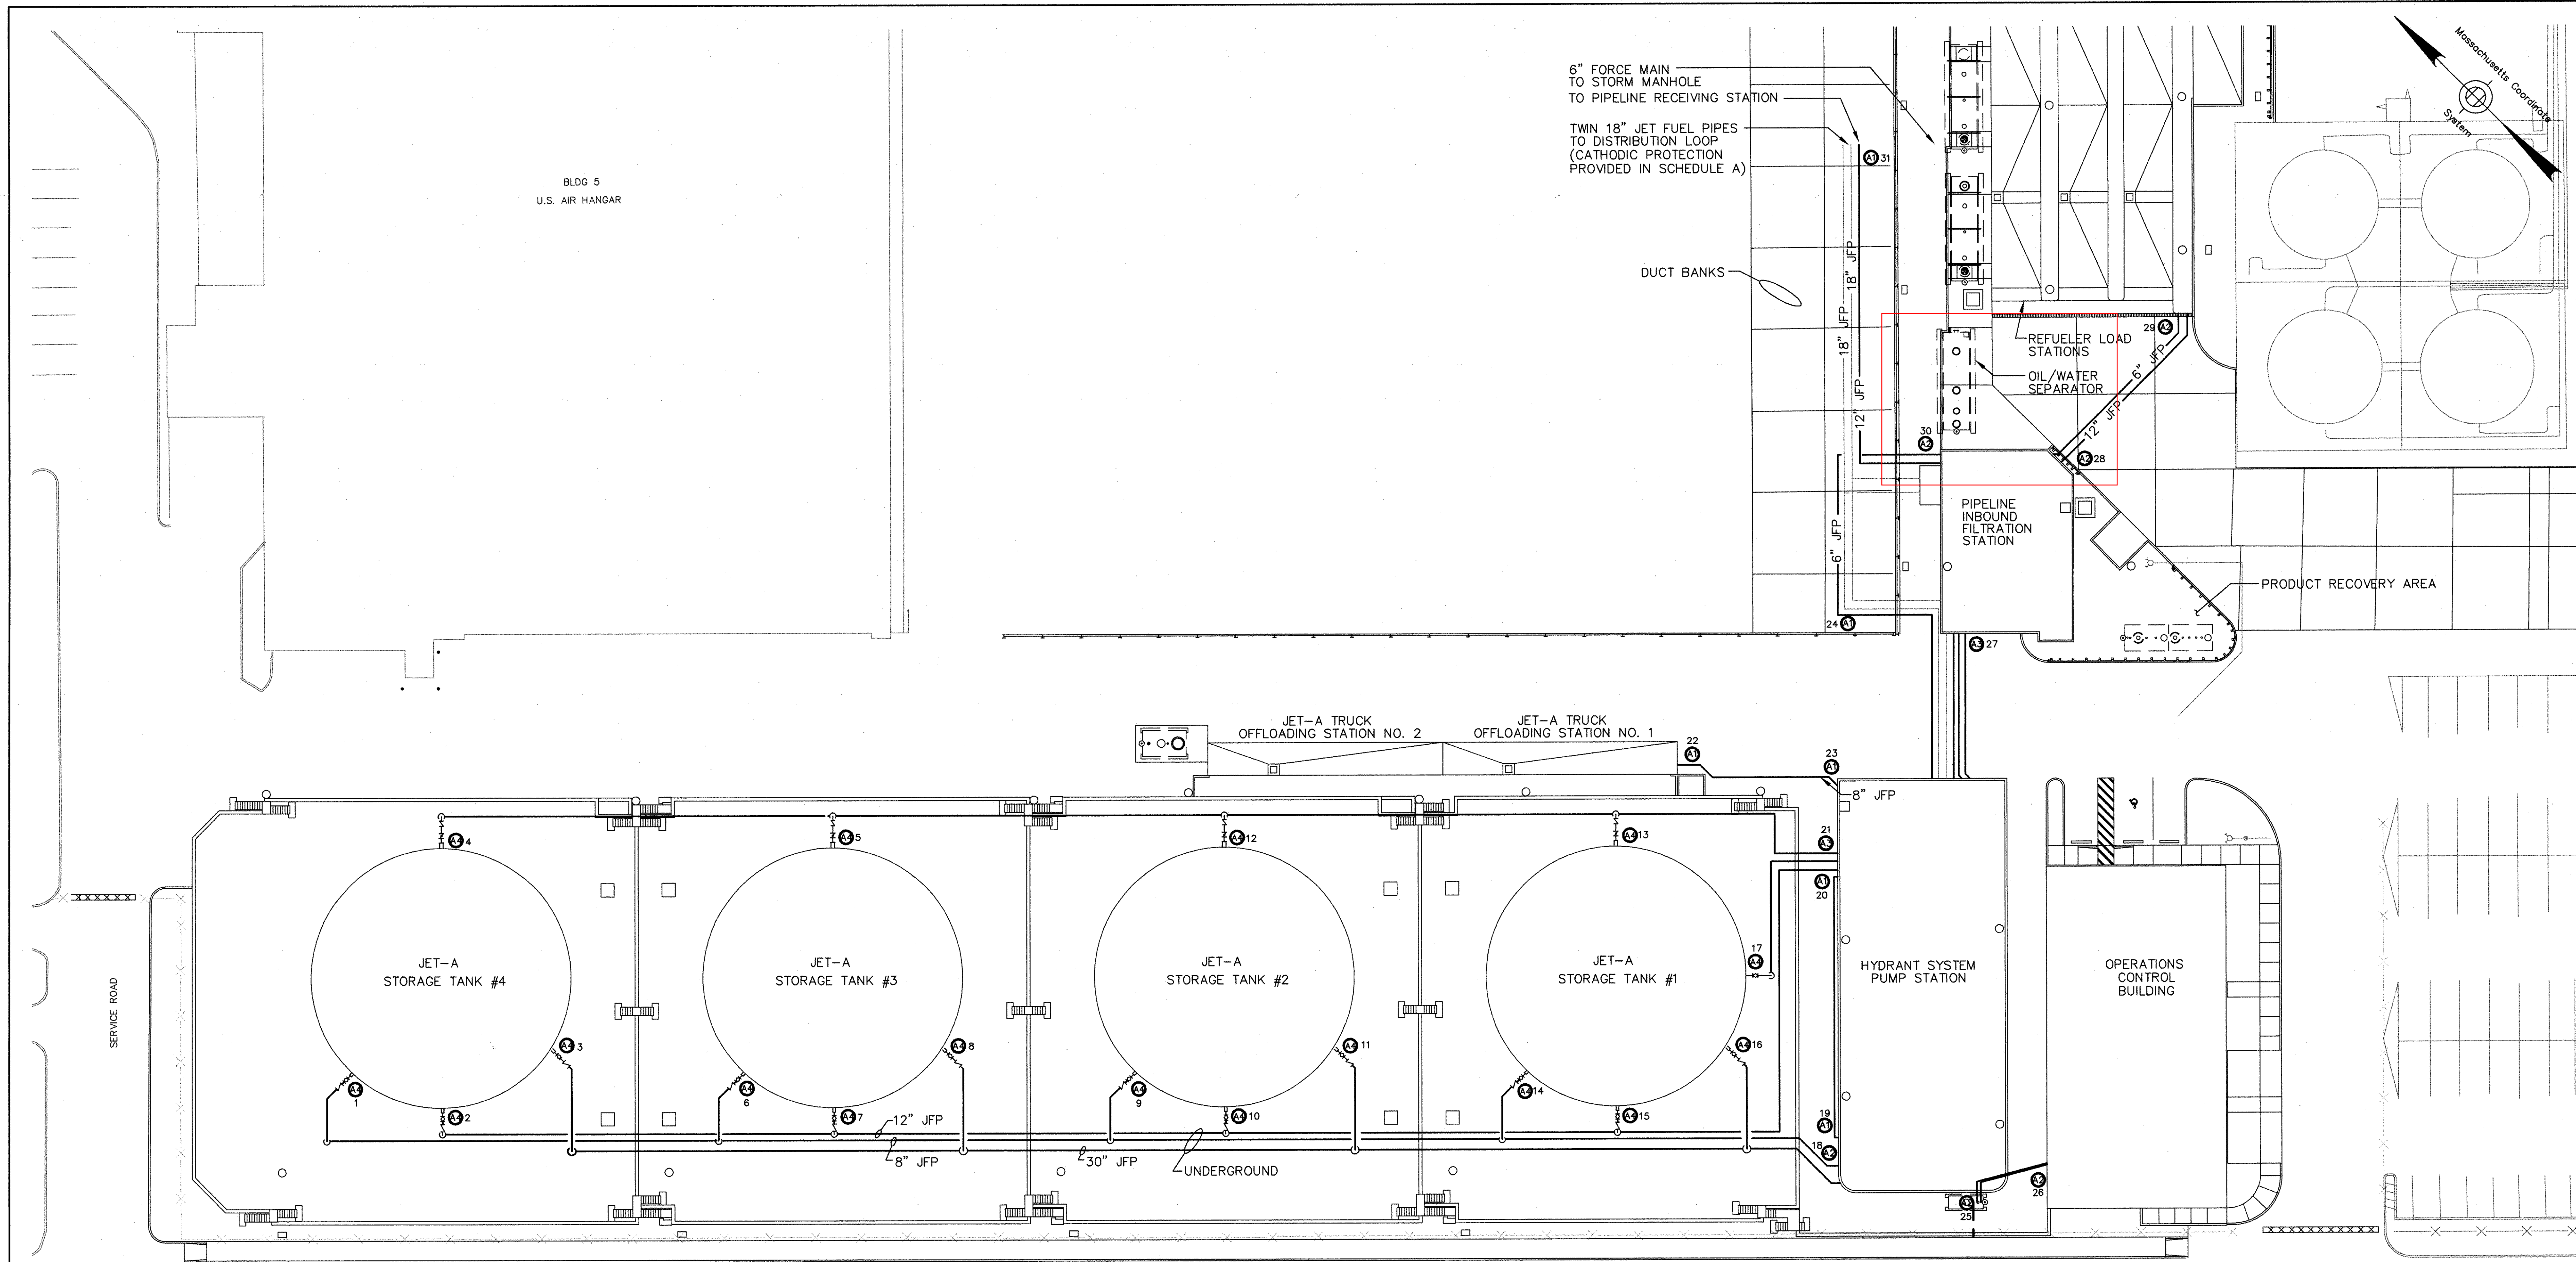

INSTALLATION NOTES:

- CONTRACTOR SHALL VERIFY SITE CONDITIONS AND THE LOCATION OF ALL EXISTING UNDERGROUND STRUCTURES PRIOR TO EXCAVATING.
- LOCATION OF CATHODIC PROTECTION COMPONENTS SHOWN IS APPROXIMATE. MINOR DEVIATION FROM THE POSITIONS SHOWN TO AVOID EXISTING STRUCTURES WILL BE PERMITTED WITH APPROVAL OF THE ARCHITECT/ENGINEER.
- ANODES SHALL BE INSTALLED IN THE VERTICAL POSITION, WITH THE TOP OF THE ANODE APPROXIMATELY 3 FEET BELOW THE PIPE'S OUTER SURFACE. ANODES MAY ONLY BE INSTALLED HORIZONTALLY IF SPECIFICALLY AUTHORIZED IN WRITING BY THE ARCHITECT/ENGINEER.
- ANODES SHALL BE INSTALLED IN A HOLE NOT LESS THAN 2 INCHES LARGER IN DIAMETER THAN THE ANODE. THE ANODE LEAD WIRE SHALL NOT BE USED TO LIFT OR OTHERWISE SUPPORT THE ANODE DURING INSTALLATION. NATIVE NATURAL SAND SOIL MATERIAL SHALL BE PLACED AROUND THE ANODE IN 6 INCH LAYERS AND EACH LAYER THOROUGHLY COMPACTED. WHEN COMPLETELY BACKFILLED, NO LESS THAN 5 GALLONS OF WATER SHALL BE POURED INTO THE HOLE. THE BACKFILL MATERIAL SHALL BE THOROUGHLY SATURATED AND ADDITIONAL MATERIAL ADDED, AS NECESSARY, TO COMPENSATE FOR SHRINKAGE.
- ANODE, PIPE AND REFERENCE CELL LEAD WIRES SHALL BE INSTALLED IN TRENCHES NOT LESS THAN 24 INCHES DEEP. EXCAVATION AND BACKFILLING OF TRENCHES SHALL BE IN ACCORDANCE WITH THE TECHNICAL SPECIFICATIONS.

- PERMANENT REFERENCE CELLS SHALL BE INSTALLED HORIZONTALLY, 6 INCHES BELOW THE PIPE'S OUTER SURFACE IN NATIVE NATURAL SAND SOIL AND NO CLOSER THAN 20' TO A MAGNESIUM ANODE. THE BACKFILL MATERIAL AROUND THE REFERENCE CELL SHALL BE THOROUGHLY COMPACTED. WHEN THE REFERENCE CELL IS COMPLETELY COVERED, NO LESS THAN 5 GALLONS OF WATER SHALL BE POURED INTO THE HOLE. THE BACKFILL MATERIAL SHALL BE THOROUGHLY SATURATED AND ADDITIONAL MATERIAL ADDED, AS NECESSARY, TO COMPENSATE FOR SHRINKAGE.
- TEST STATIONS SHALL BE PROVIDED WITH A 1 INCH WIDE BY 2 INCH LONG TYPE 316 STAINLESS STEEL TAG, PERMANENTLY ATTACHED TO THE ANODE LEAD WIRE INSIDE THE TEST STATION. INFORMATION ENGRAVED ON THIS TAG SHALL INCLUDE THE TEST STATION NUMBER AND ASSOCIATED STRUCTURES.
- LEAD WIRE TERMINATIONS TO THE TEST STATION TERMINAL BLOCK SHALL BE MADE USING APPROPRIATELY SIZED, TINNED SOLID COPPER, RING TONGUE, SOLDERLESS CRIMP-TYPE CONNECTORS. INSTALLATION OF THE CONNECTORS SHALL BE IN ACCORDANCE WITH THE MANUFACTURER'S INSTRUCTIONS AND RECOMMENDED TOOLS.
- COMPLETE ELECTRICAL ISOLATION OF ALL STEEL PIPING SHALL BE OBTAINED BY MAINTAINING A MINIMUM OF 6" CLEARANCE WITH ALL FOREIGN METALLIC STRUCTURES AND INSTALLATION OF FLANGE INSULATION KITS AT ALL ENDPOINTS.

JET FUEL PIPING
SCALE: 1"=20'-0"


LEGEND	
(A)	SEE DETAIL 4 ON SHEET CP3.02 (ANODES 19, 20, 22, 23, 24 & 31)
(A2)	SEE DETAIL 5 ON SHEET CP3.02 (ANODES 18, 25, 26, 28, 29 & 30)
(A3)	SEE DETAIL 6 ON SHEET CP3.02 (ANODES 21 & 27)
(A4)	SEE DETAIL 7 ON SHEET CP3.02 (ANODES 1 - 17)

NOTE:

UTILITY LOCATIONS ARE SHOWN FOR REFERENCE ONLY. REFER TO ASSOCIATED CONSTRUCTION DRAWINGS FOR UTILITY LOCATIONS.

FOR REFERENCE ONLY

JRS Greiner Woodward Clyde, Inc.
BY: *[Signature]* DATE: 10/92

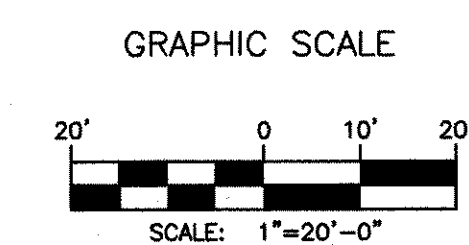

AS CONSTRUCTED PLANS
I hereby certify that all construction required by this sheet has been accomplished as indicated

REV. NO.	DATE	DESCRIPTION	MADE BY	CHK. BY	APPD. BY
AB	7/99	CONTRACTOR'S AS-BUILT CONDITIONS	DJM	DJM	RAH

MASSACHUSETTS PORT AUTHORITY
BOSTON, MASSACHUSETTS

BOSTON LOGAN INTERNATIONAL AIRPORT
EAST BOSTON, MASSACHUSETTS


AIRCRAFT FUELING SYSTEMS
SCHEDULE B - FUEL STORAGE FACILITY
CATHODIC PROTECTION SYSTEM - JET FUEL PIPING

CONSULTANT AND SUBCONSULTANT:
GREINER INC. TAMPA, FLORIDA
SOUTHERN CATHODIC PROTECTION ATLANTA, GEORGIA

DRAWN BY: EW	CHKD. BY: JFF	DWG. NO: CP2.02
SCALE: AS SHOWN	APPROVED: JLP	DATE: 2/97

MPA CONTRACT NO.: MPA 1.646C (R) SHEET NO. 14 OF 200

AS BUILT

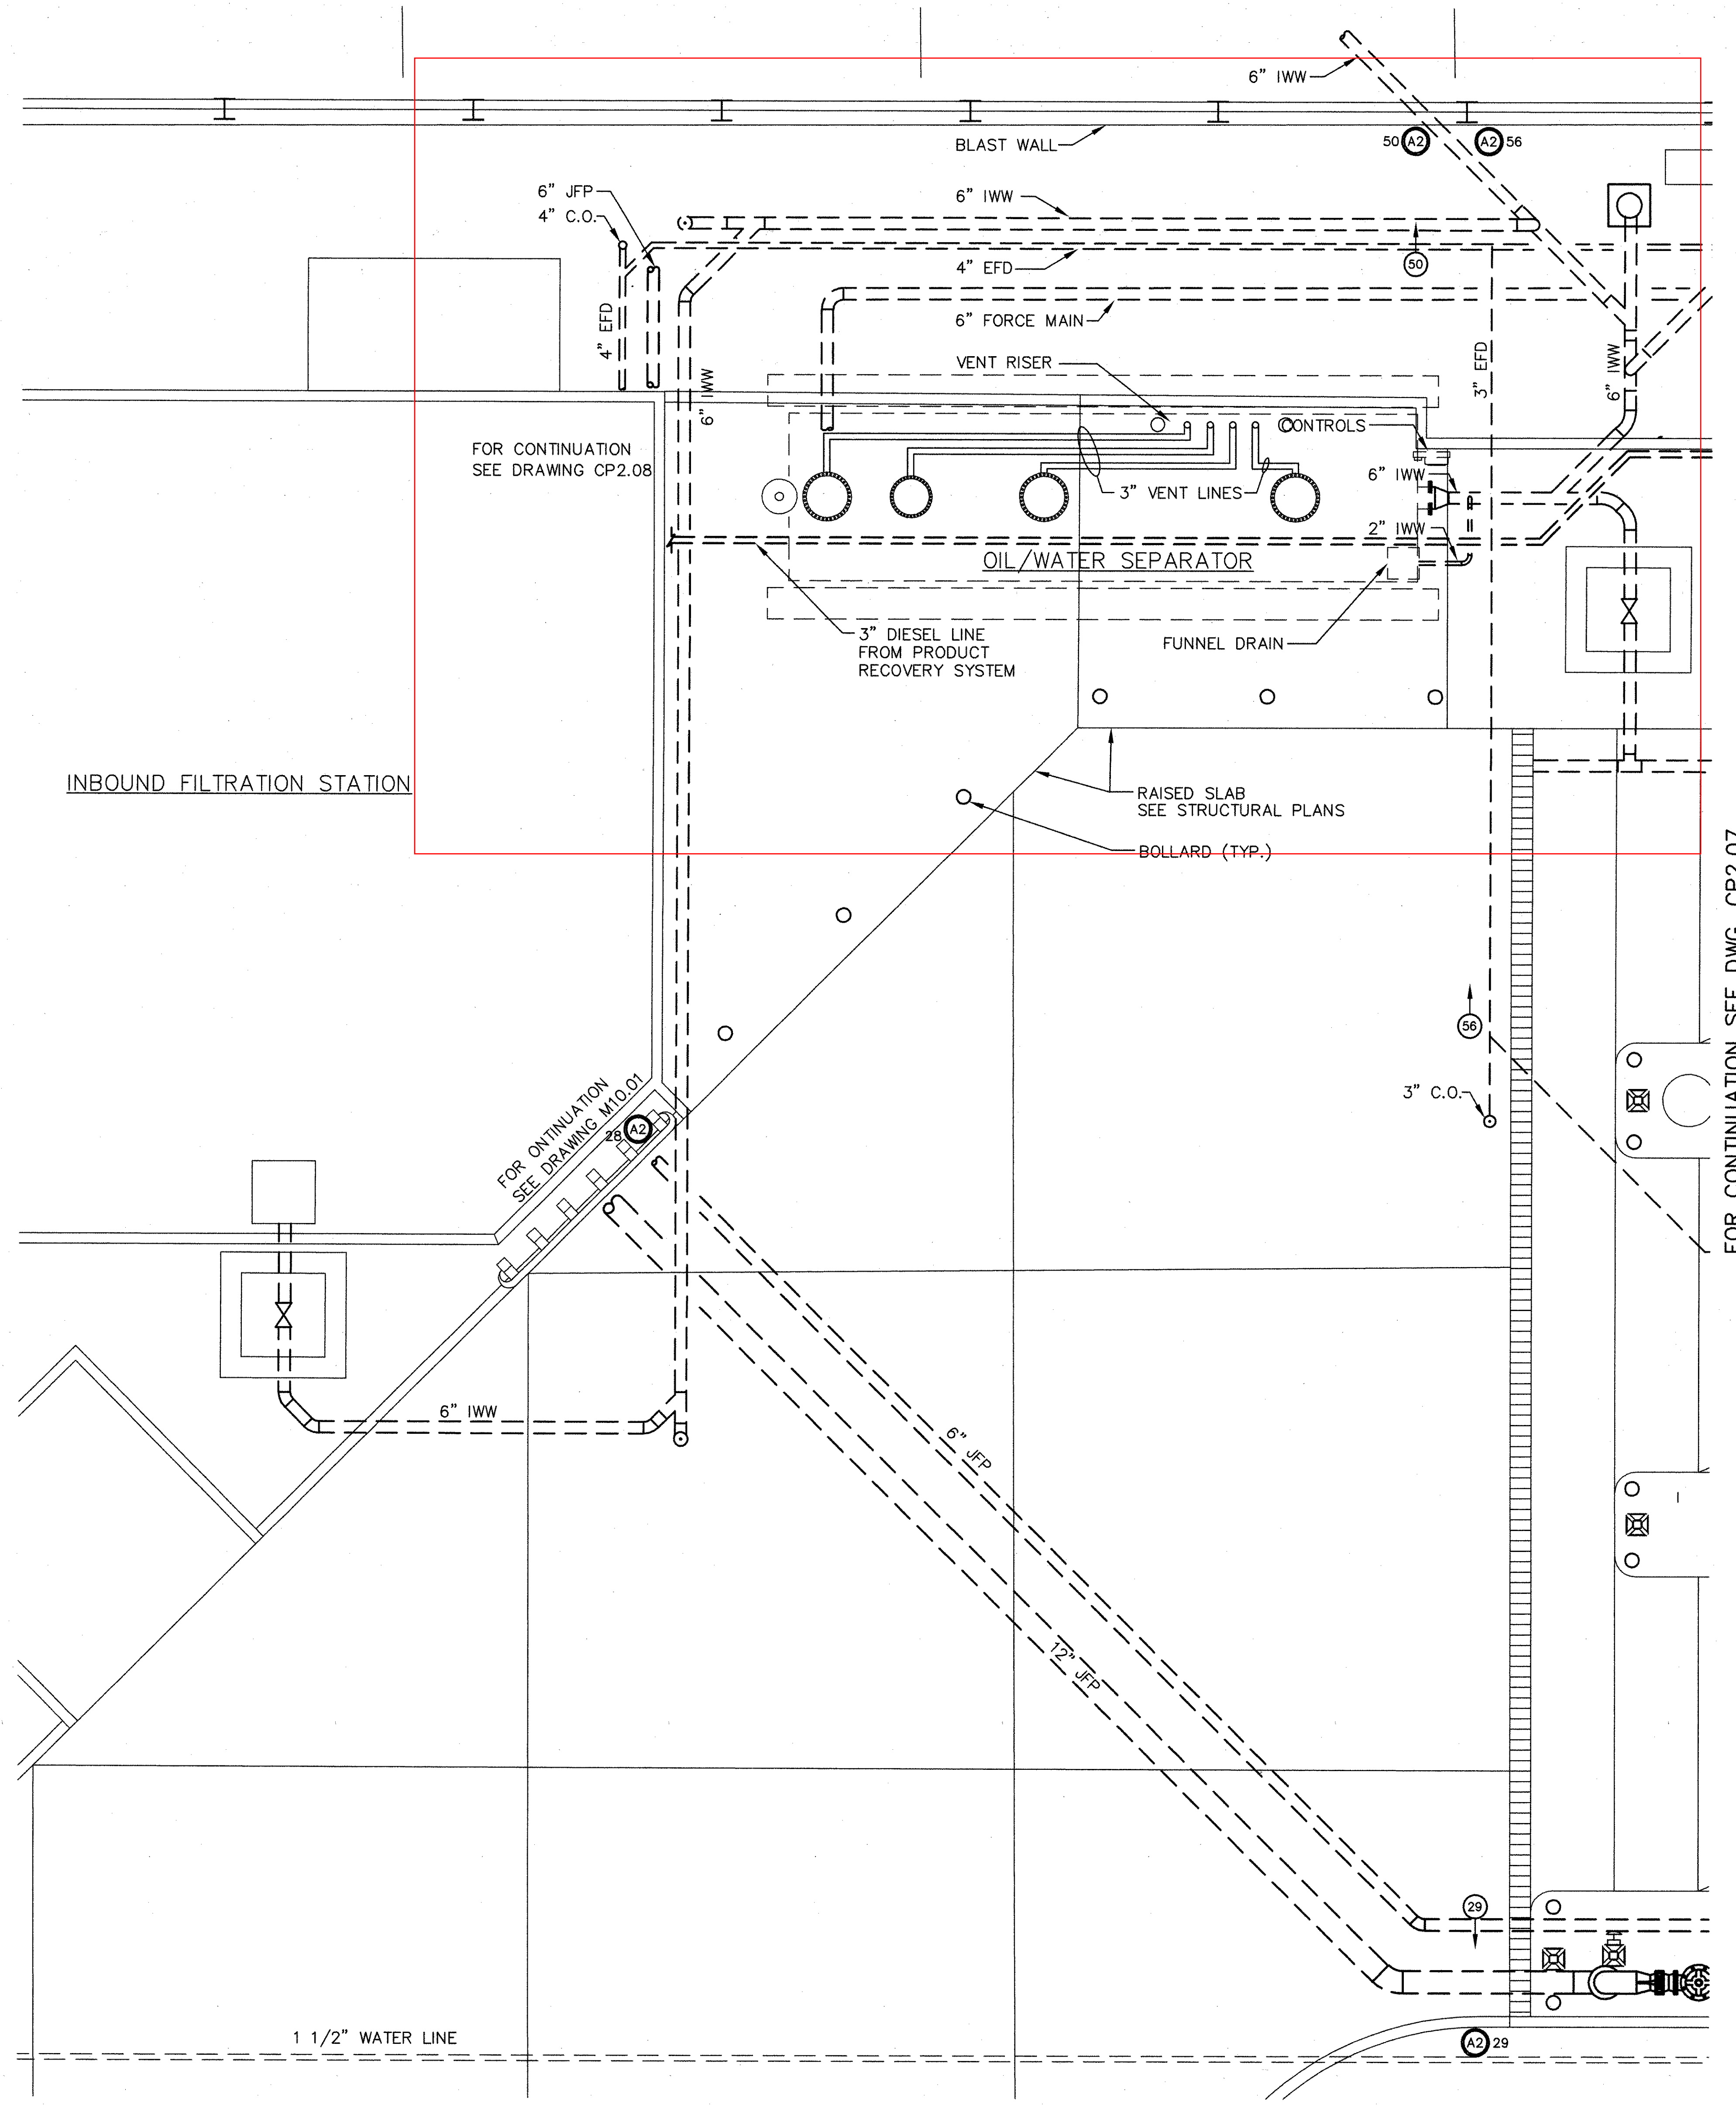

REFUELER LOADING STATION PARTIAL AREA PLAN
SCALE: 1/4"=1'-0"

INSTALLATION NOTES:

- CONTRACTOR SHALL VERIFY SITE CONDITIONS AND THE LOCATION OF ALL EXISTING UNDERGROUND STRUCTURES PRIOR TO EXCAVATING.
- LOCATION OF CATHODIC PROTECTION COMPONENTS SHOWN IS APPROXIMATE. MINOR DEVIATION FROM THE POSITIONS SHOWN TO AVOID EXISTING STRUCTURES WILL BE PERMITTED WITH APPROVAL OF THE ARCHITECT/ENGINEER.
- ANODES SHALL BE INSTALLED IN THE VERTICAL POSITION WITH THE TOP OF THE ANODE APPROXIMATELY 3 FEET BELOW THE PIPE'S OUTER SURFACE. ANODES MAY ONLY BE INSTALLED HORIZONTALLY IF SPECIFICALLY AUTHORIZED IN WRITING BY THE ARCHITECT/ENGINEER.
- ANODES SHALL BE INSTALLED IN A HOLE NOT LESS THAN 2 INCHES LARGER IN DIAMETER THAN THE ANODE. THE ANODE LEAD WIRE SHALL NOT BE USED TO LIFT OR OTHERWISE SUPPORT THE ANODE DURING INSTALLATION. NATIVE NATURAL SAND SOIL MATERIAL SHALL BE PLACED AROUND THE ANODE IN 6 INCH LAYERS AND EACH LAYER THOROUGHLY COMPACTED. WHEN COMPLETELY BACKFILLED, NO LESS THAN 5 GALLONS OF WATER SHALL BE POURED INTO THE HOLE. THE BACKFILL MATERIAL SHALL BE THOROUGHLY SATURATED AND ADDITIONAL MATERIAL ADDED, AS NECESSARY, TO COMPENSATE FOR SHRINKAGE.
- ANODE, PIPE AND REFERENCE CELL LEAD WIRES SHALL BE INSTALLED IN TRENCHES NOT LESS THAN 24 INCHES DEEP. EXCAVATION AND BACKFILLING OF TRENCHES SHALL BE IN ACCORDANCE WITH THE TECHNICAL SPECIFICATIONS.
- PERMANENT REFERENCE CELLS SHALL BE INSTALLED HORIZONTALLY, 6 INCHES BELOW THE PIPE'S OUTER SURFACE IN NATIVE NATURAL SAND SOIL AND NO CLOSER THAN 20' TO A MAGNESIUM ANODE. THE BACKFILL MATERIAL AROUND THE REFERENCE CELL SHALL BE THOROUGHLY COMPACTED. WHEN THE REFERENCE CELL IS COMPLETELY COVERED, NO LESS THAN 5 GALLONS OF WATER SHALL BE POURED INTO THE HOLE. THE BACKFILL MATERIAL SHALL BE THOROUGHLY SATURATED AND ADDITIONAL MATERIAL ADDED, AS NECESSARY, TO COMPENSATE FOR SHRINKAGE.
- TEST STATIONS SHALL BE PROVIDED WITH A 1 INCH WIDE BY 2 INCH LONG TYPE 316 STAINLESS STEEL TAG, PERMANENTLY ATTACHED TO THE ANODE LEAD WIRE INSIDE THE TEST STATION. INFORMATION ENGRAVED ON THIS TAG SHALL INCLUDE THE TEST STATION NUMBER AND ASSOCIATED STRUCTURES.
- LEAD WIRE TERMINATIONS TO THE TEST STATION TERMINAL BLOCK SHALL BE MADE USING APPROPRIATELY SIZED, TINNED SOLID COPPER, RING TONGUE, SOLDERLESS CRIMP-TYPE CONNECTORS. INSTALLATION OF THE CONNECTORS SHALL BE IN ACCORDANCE WITH THE MANUFACTURER'S INSTRUCTIONS AND RECOMMENDED TOOLS.
- COMPLETE ELECTRICAL ISOLATION OF ALL STEEL PIPING SHALL BE OBTAINED BY MAINTAINING A MINIMUM OF 6" CLEARANCE WITH ALL FOREIGN METALLIC STRUCTURES AND INSTALLATION OF FLANGE INSULATION KITS AT ALL ENDPPOINTS.


FOR REFERENCE ONLY

AS CONSTRUCTED PLANS
I hereby certify that all construction required by this sheet has been accomplished as indicated

URS Greiner Woodward Clyde, Inc.
BY: [Signature] DATE: 1/26/97

LEGEND

(A)	SEE DETAIL 4 ON SHEET CP3.02
(B)	SEE DETAIL 5 ON SHEET CP3.02
(C) →	MAGNESIUM ANODE BAG # ARROW POINTS TO TEST STATION LOCATION

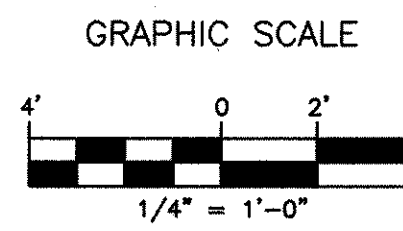

REV. NO.	DATE	DESCRIPTION	MADE BY	CHK. BY	APPD. BY	
AB	7/99	CONTRACTOR'S AS-BUILT CONDITIONS		D.M.	D.J.M.	RAH

MASSACHUSETTS PORT AUTHORITY
BOSTON, MASSACHUSETTS


BOSTON LOGAN INTERNATIONAL AIRPORT
EAST BOSTON, MASSACHUSETTS

AIRCRAFT FUELING SYSTEMS
SCHEDULE B - FUEL STORAGE FACILITY
CATHODIC PROTECTION SYSTEM - REFUELER LOADING STATION
PARTIAL SITE PLAN - JFP & IWW PIPING


CONSULTANT AND SUBCONSULTANT:
GREINER INC. TAMPA, FLORIDA
SOUTHERN CATHODIC PROTECTION ATLANTA, GEORGIA

DRAWN BY: EW	CHKD. BY: JFF	DWG. NO. CP2.06
SCALE: 1/4"=1'-0"	APPROVED: JLP	DATE: 2/97
MPA CONTRACT NO.: MPA 1.646C (R)		SHEET NO. 145 OF 202

AS BUILT

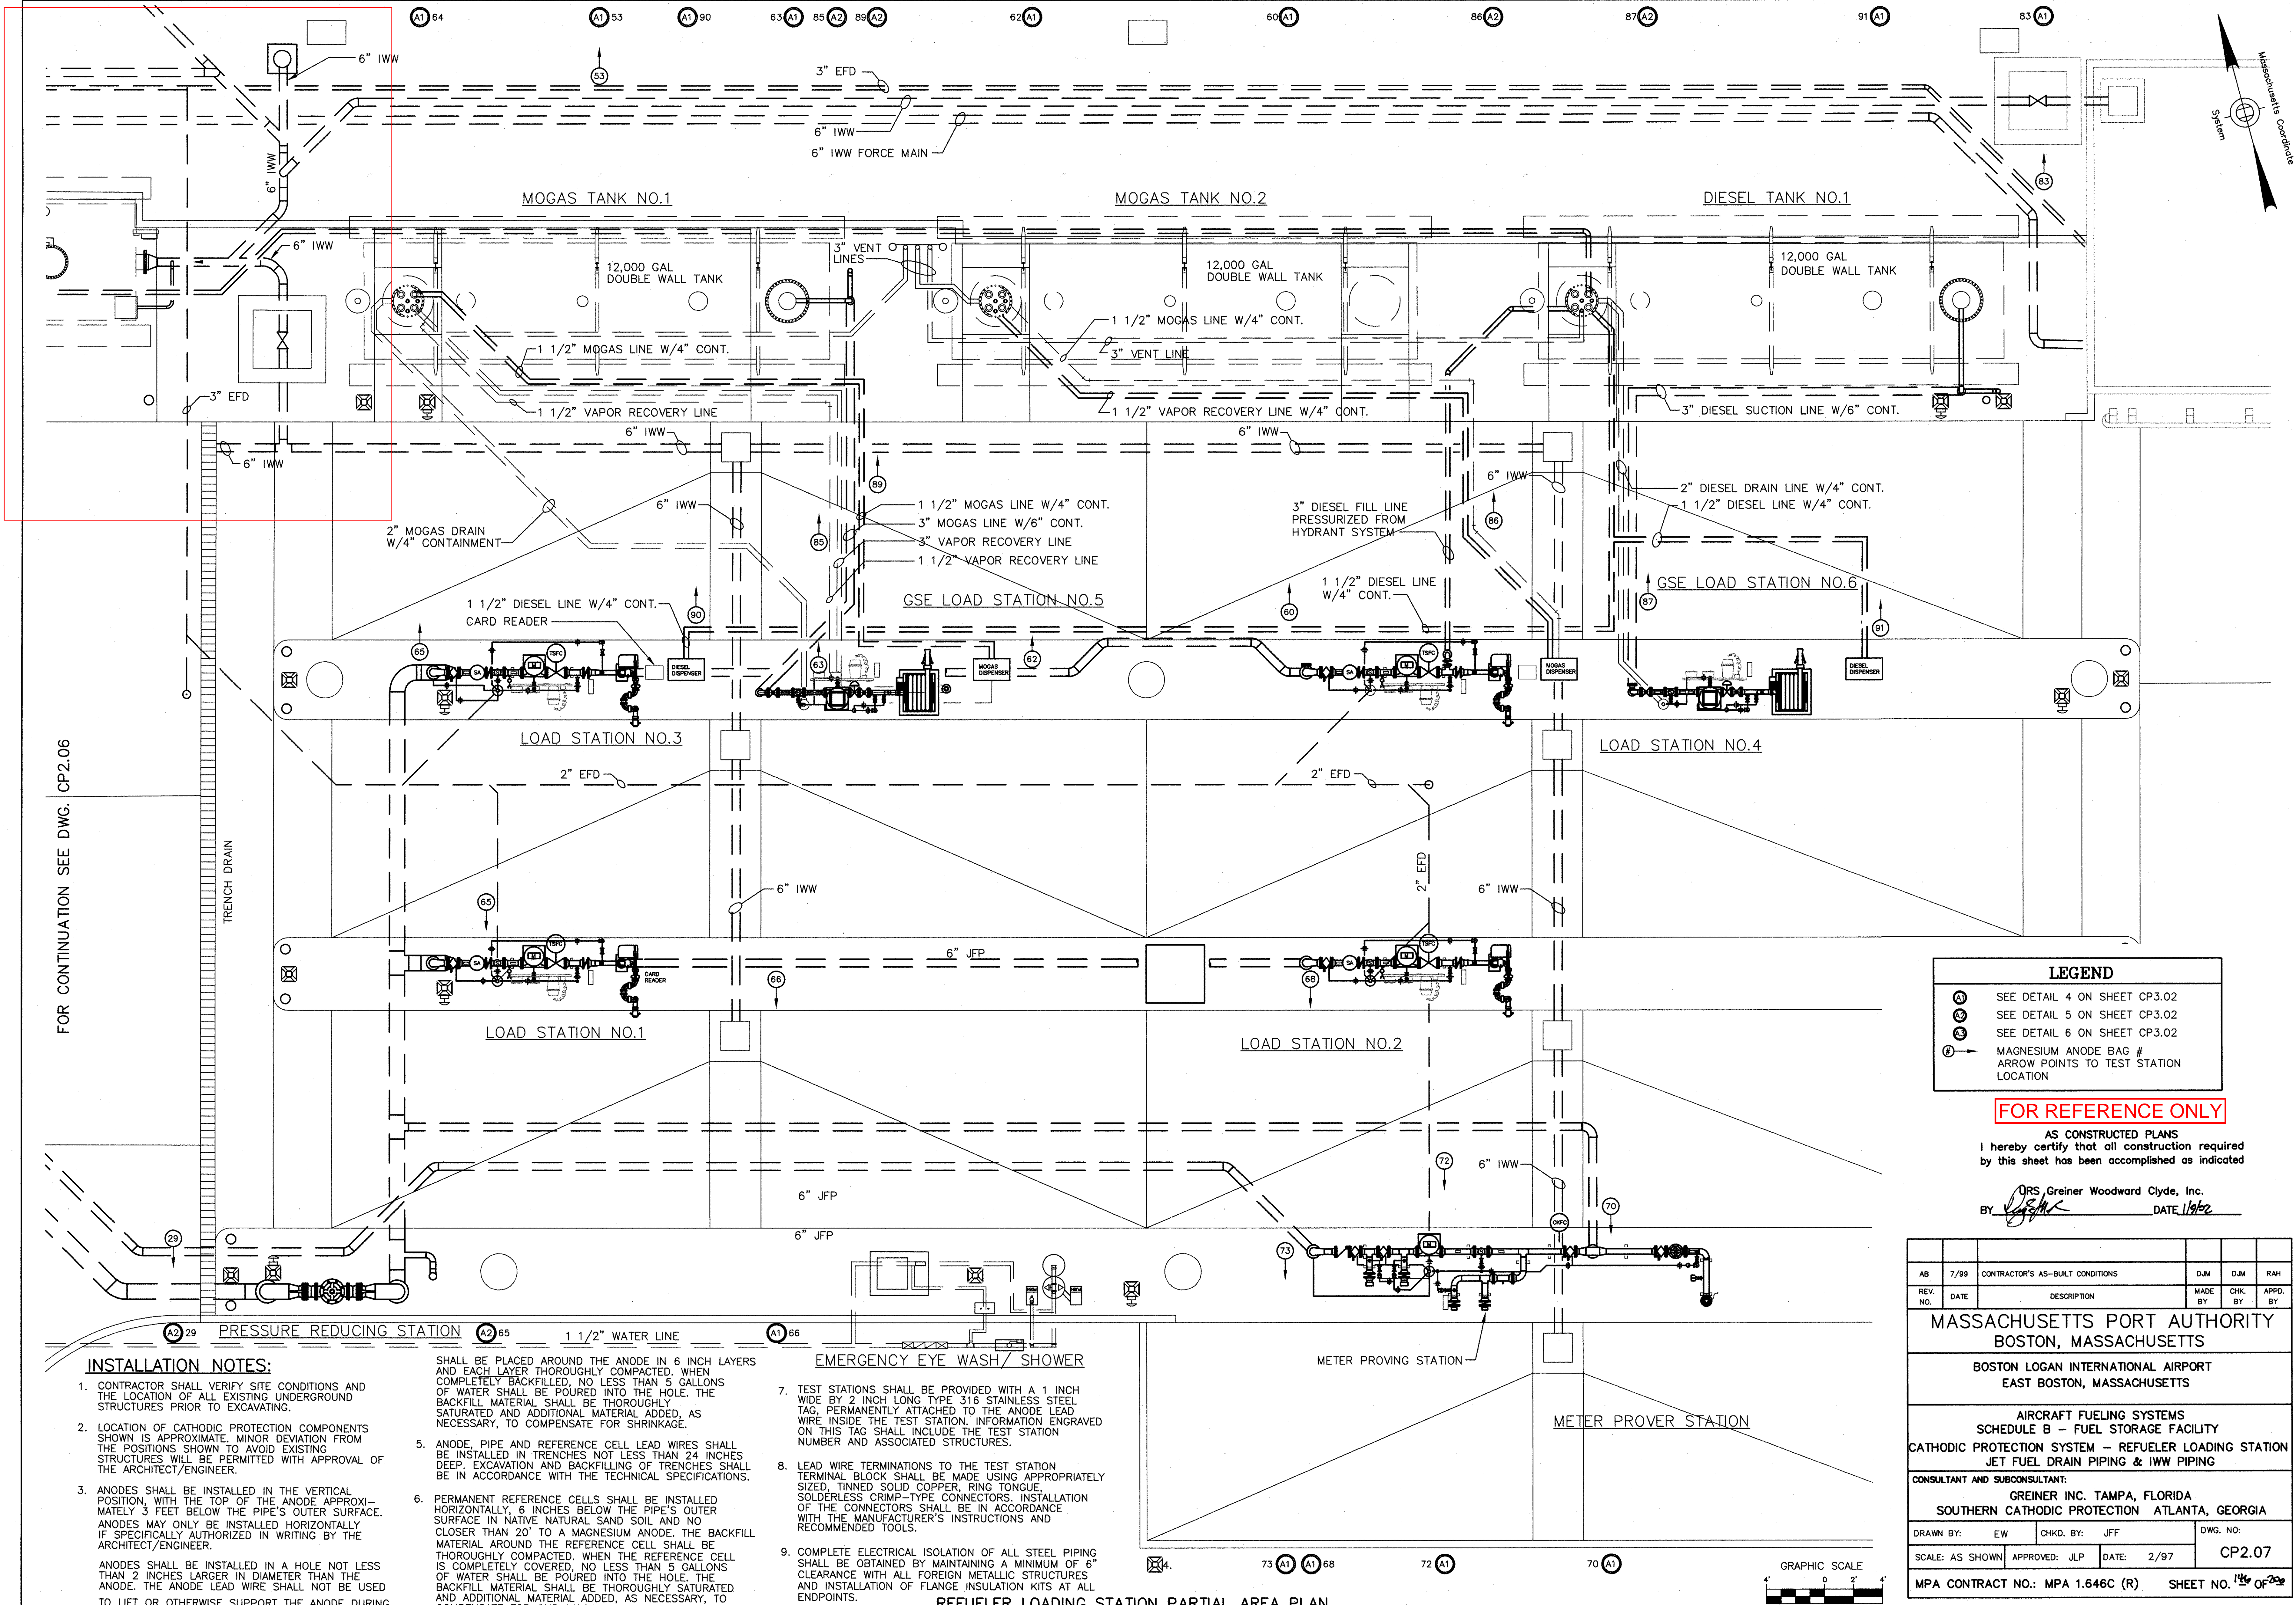

FOR CONTINUATION SEE DWG. CP2.06

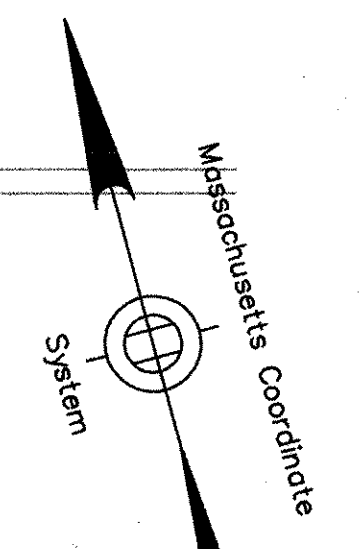

LEGEND	
(A)	SEE DETAIL 4 ON SHEET CP3.02
(B)	SEE DETAIL 5 ON SHEET CP3.02
(C)	SEE DETAIL 6 ON SHEET CP3.02
(D)	MAGNESIUM ANODE BAG #
(E)	ARROW POINTS TO TEST STATION LOCATION

FOR REFERENCE ONLY

AS CONSTRUCTED PLANS
I hereby certify that all construction required
by this sheet has been accomplished as indicated

URS Greiner Woodward Clyde, Inc.
BY: *[Signature]* DATE: 1/2/02

REV. NO.	DATE	DESCRIPTION	MADE BY	CHK. BY	APPD. BY
AB	7/99	CONTRACTOR'S AS-BUILT CONDITIONS		DJM	RAH

MASSACHUSETTS PORT AUTHORITY
BOSTON, MASSACHUSETTS

BOSTON LOGAN INTERNATIONAL AIRPORT
EAST BOSTON, MASSACHUSETTS

AIRCRAFT FUELING SYSTEMS
SCHEDULE B - FUEL STORAGE FACILITY
CATHODIC PROTECTION SYSTEM - REFUELER LOADING STATION
JET FUEL DRAIN PIPING & IWW PIPING

CONSULTANT AND SUBCONSULTANT:
GREINER INC. TAMPA, FLORIDA
SOUTHERN CATHODIC PROTECTION ATLANTA, GEORGIA

DRAWN BY: EW	CHKD. BY: JFF	DWG. NO: CP2.07
SCALE: AS SHOWN	APPROVED: JLP	DATE: 2/97

MPA CONTRACT NO.: MPA 1.646C (R) SHEET NO. 13 OF 20

INSTALLATION NOTES:

- CONTRACTOR SHALL VERIFY SITE CONDITIONS AND THE LOCATION OF ALL EXISTING UNDERGROUND STRUCTURES PRIOR TO EXCAVATING.
- LOCATION OF CATHODIC PROTECTION COMPONENTS SHOWN IS APPROXIMATE. MINOR DEVIATION FROM THE POSITIONS SHOWN TO AVOID EXISTING STRUCTURES WILL BE PERMITTED WITH APPROVAL OF THE ARCHITECT/ENGINEER.
- ANODES SHALL BE INSTALLED IN THE VERTICAL POSITION, WITH THE TOP OF THE ANODE APPROXIMATELY 3 FEET BELOW THE PIPE'S OUTER SURFACE. ANODES MAY ONLY BE INSTALLED HORIZONTALLY IF SPECIFICALLY AUTHORIZED IN WRITING BY THE ARCHITECT/ENGINEER.

ANODES SHALL BE INSTALLED IN A HOLE NOT LESS THAN 2 INCHES LARGER IN DIAMETER THAN THE ANODE. THE ANODE LEAD WIRE SHALL NOT BE USED TO LIFT OR OTHERWISE SUPPORT THE ANODE DURING INSTALLATION. NATIVE NATURAL SAND SOIL MATERIAL


SHALL BE PLACED AROUND THE ANODE IN 6 INCH LAYERS AND EACH LAYER THOROUGHLY COMPACTED. WHEN COMPLETELY BACKFILLED, NO LESS THAN 5 GALLONS OF WATER SHALL BE Poured INTO THE HOLE. THE BACKFILL MATERIAL SHALL BE THOROUGHLY SATURATED AND ADDITIONAL MATERIAL ADDED, AS NECESSARY, TO COMPENSATE FOR SHRINKAGE.



- ANODE, PIPE AND REFERENCE CELL LEAD WIRES SHALL BE INSTALLED IN TRENCHES NOT LESS THAN 24 INCHES DEEP. EXCAVATION AND BACKFILLING OF TRENCHES SHALL BE IN ACCORDANCE WITH THE TECHNICAL SPECIFICATIONS.
- PERMANENT REFERENCE CELLS SHALL BE INSTALLED HORIZONTALLY 6 INCHES BELOW THE PIPE'S OUTER SURFACE IN NATIVE NATURAL SAND SOIL AND NO CLOSER THAN 20" TO A MAGNESIUM ANODE. THE BACKFILL MATERIAL AROUND THE REFERENCE CELL SHALL BE THOROUGHLY COMPACTED. WHEN THE REFERENCE CELL IS COMPLETELY COVERED, NO LESS THAN 5 GALLONS OF WATER SHALL BE Poured INTO THE HOLE. THE BACKFILL MATERIAL SHALL BE THOROUGHLY SATURATED AND ADDITIONAL MATERIAL ADDED, AS NECESSARY, TO COMPENSATE FOR SHRINKAGE.

EMERGENCY EYE WASH/ SHOWER

- TEST STATIONS SHALL BE PROVIDED WITH A 1 INCH WIDE BY 2 INCH LONG TYPE 316 STAINLESS STEEL TAG, PERMANENTLY ATTACHED TO THE ANODE LEAD WIRE INSIDE THE TEST STATION. INFORMATION ENGRAVED ON THIS TAG SHALL INCLUDE THE TEST STATION NUMBER AND ASSOCIATED STRUCTURES.
- LEAD WIRE TERMINATIONS TO THE TEST STATION TERMINAL BLOCK SHALL BE MADE USING APPROPRIATELY SIZED, TINNED SOLID COPPER, RING TONGUE, SOLDERLESS CRIMP-TYPE CONNECTORS. INSTALLATION OF THE CONNECTORS SHALL BE IN ACCORDANCE WITH THE MANUFACTURER'S INSTRUCTIONS AND RECOMMENDED TOOLS.
- COMPLETE ELECTRICAL ISOLATION OF ALL STEEL PIPING SHALL BE OBTAINED BY MAINTAINING A MINIMUM OF 6" CLEARANCE WITH ALL FOREIGN METALLIC STRUCTURES AND INSTALLATION OF FLANGE INSULATION KITS AT ALL ENDPOINTS.

REFUELER LOADING STATION PARTIAL AREA PLAN
SCALE: 1/4" = 1'-0"

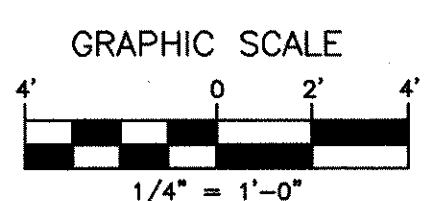

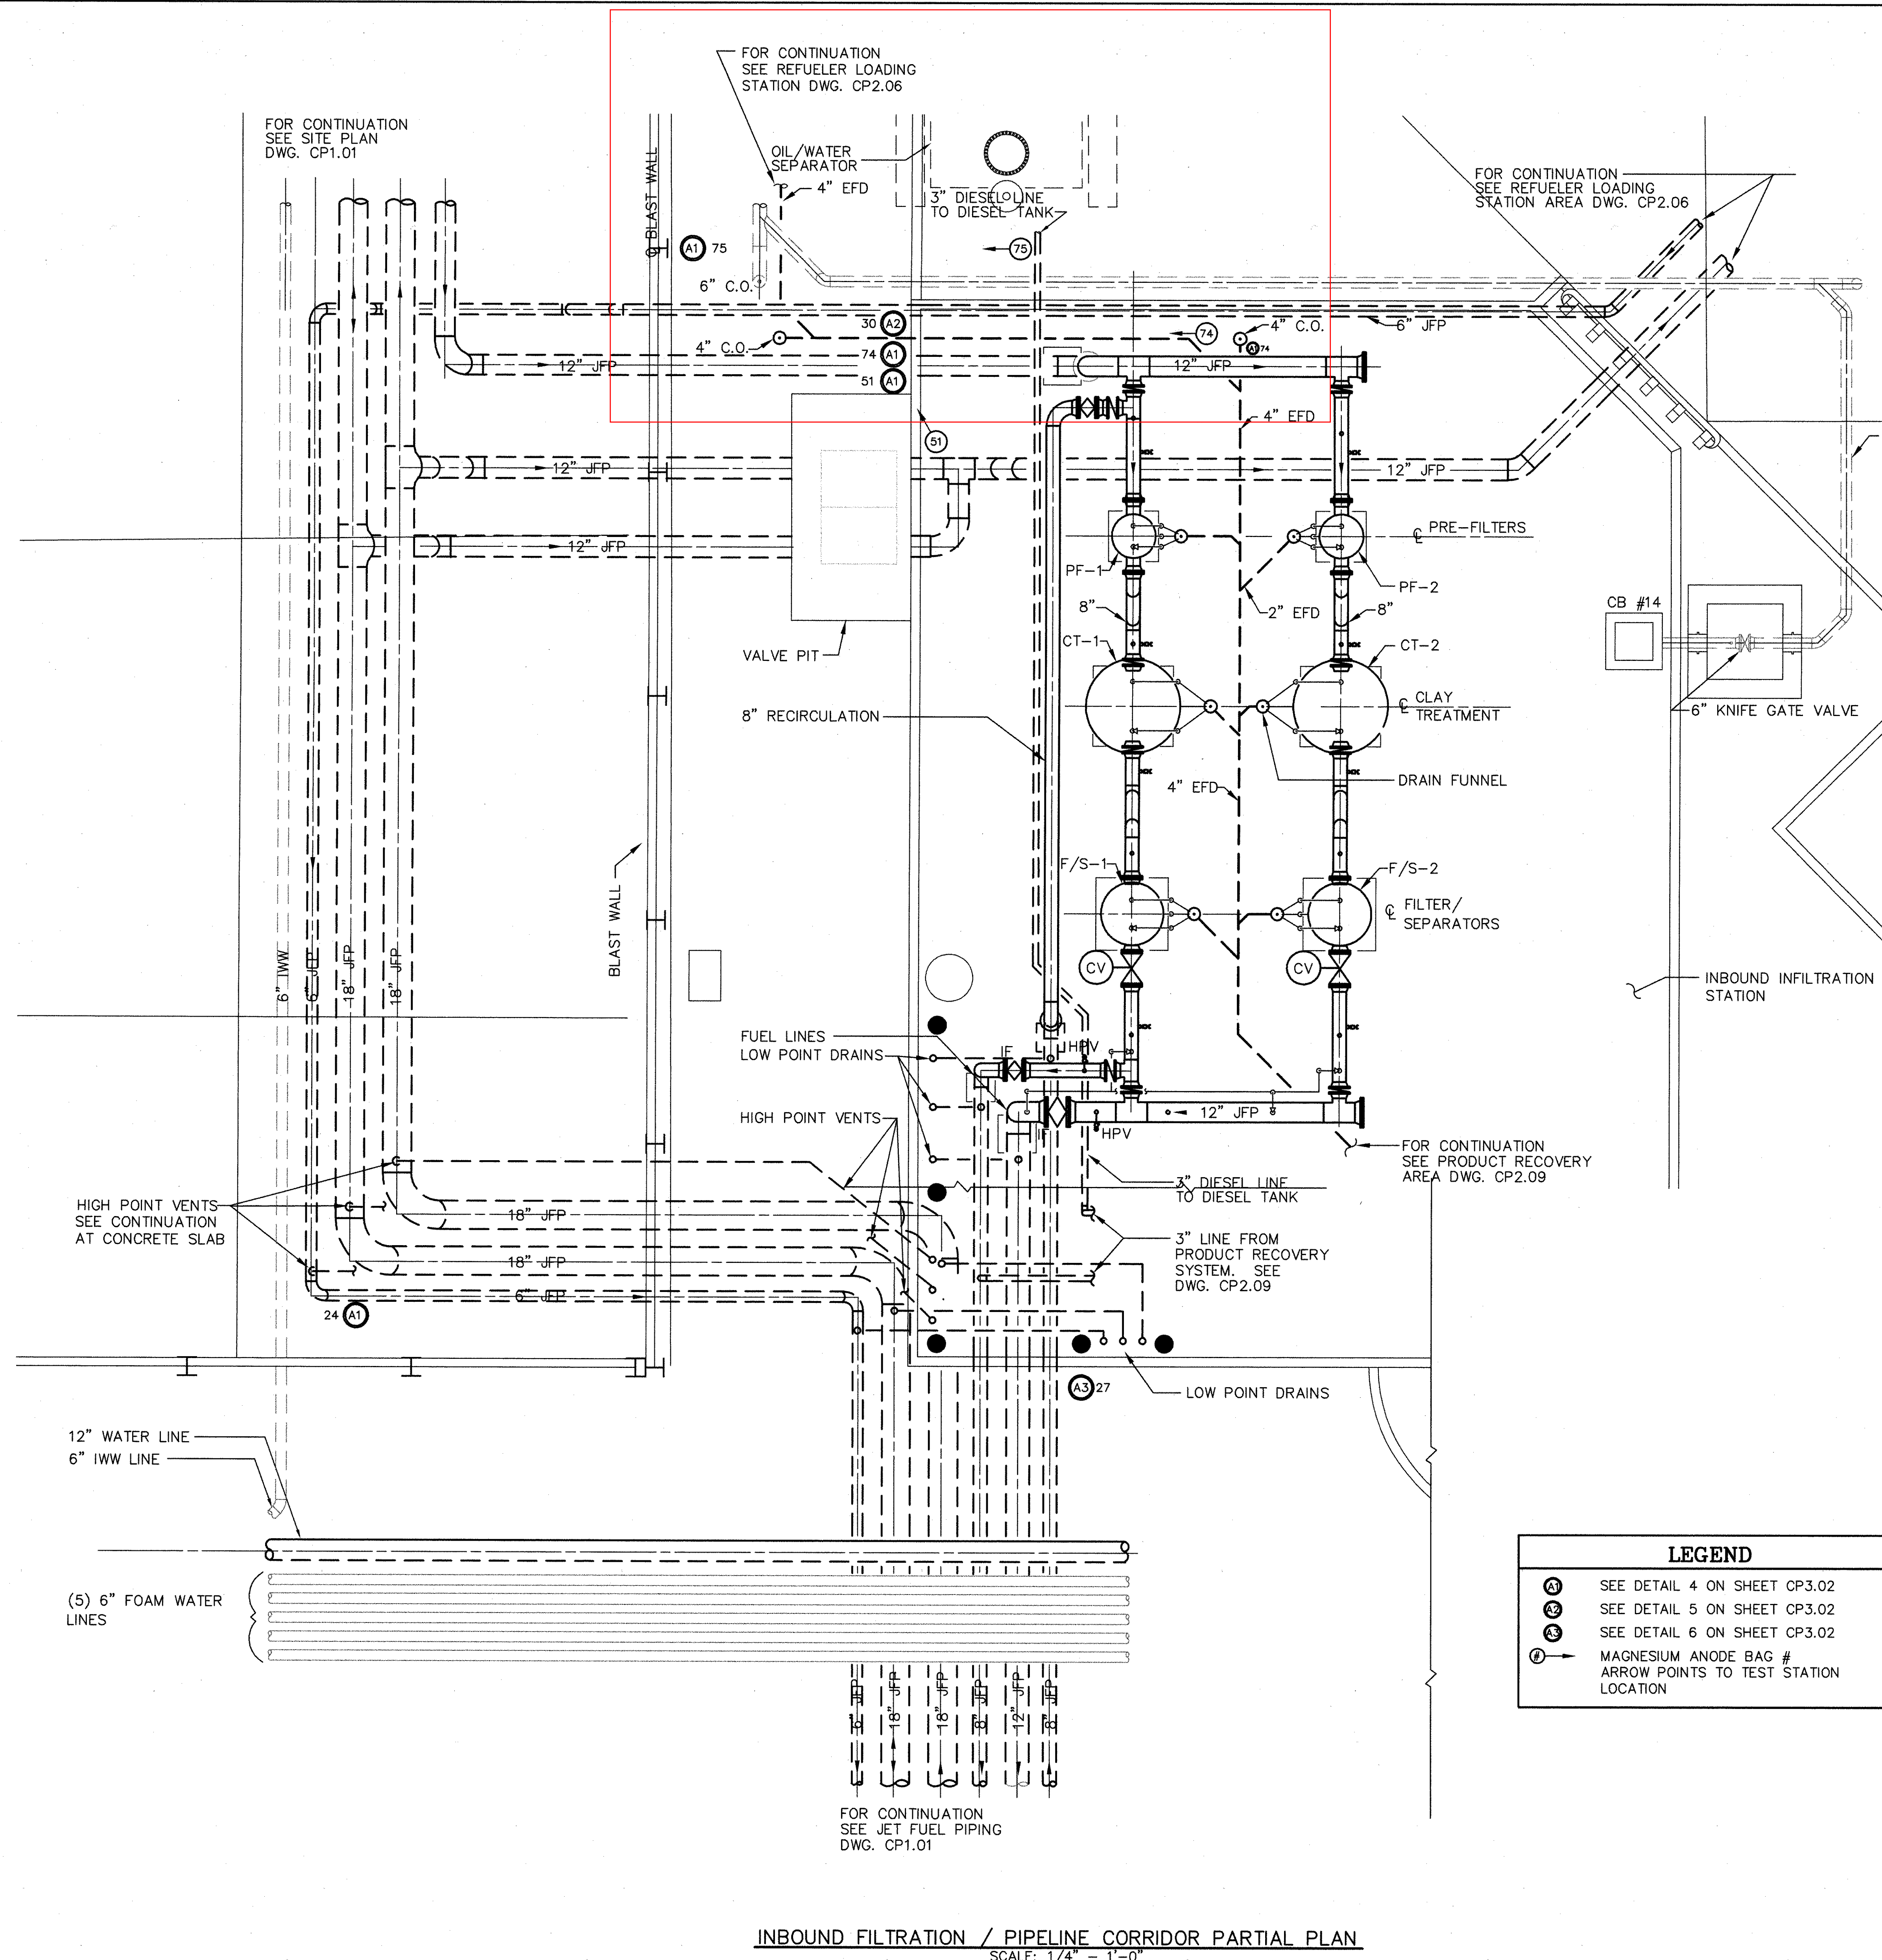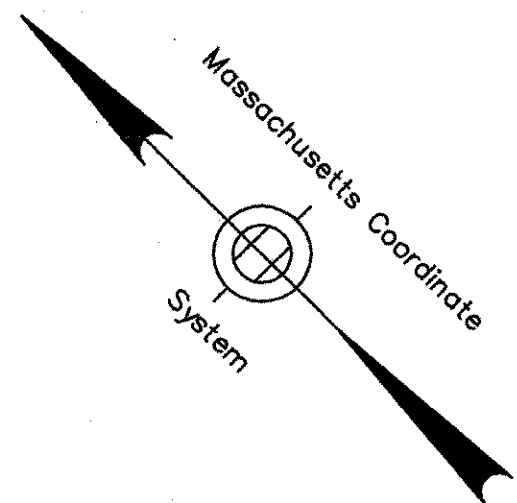

INSTALLATION NOTES:

- CONTRACTOR SHALL VERIFY SITE CONDITIONS AND THE LOCATION OF ALL EXISTING UNDERGROUND STRUCTURES PRIOR TO EXCAVATING.
- LOCATION OF CATHODIC PROTECTION COMPONENTS SHOWN IS APPROXIMATE. MINOR DEVIATION FROM THE POSITIONS SHOWN TO AVOID EXISTING STRUCTURES WILL BE PERMITTED WITH APPROVAL OF THE ARCHITECT/ENGINEER.
- ANODES SHALL BE INSTALLED IN THE VERTICAL POSITION, WITH THE TOP OF THE ANODE APPROXIMATELY 3 FEET BELOW THE PIPE'S OUTER SURFACE. ANODES MAY ONLY BE INSTALLED HORIZONTALLY IF SPECIFICALLY AUTHORIZED BY THE ARCHITECT/ENGINEER.
- ANODES SHALL BE INSTALLED IN A HOLE NOT LESS THAN 2 INCHES LARGER IN DIAMETER THAN THE ANODE. THE ANODE LEAD WIRE SHALL NOT BE USED TO LIFT OR OTHERWISE SUPPORT THE ANODE DURING INSTALLATION. NATIVE NATURAL SAND SOIL MATERIAL SHALL BE PLACED AROUND THE ANODE IN 6 INCH LAYERS AND EACH LAYER THOROUGHLY COMPACTED. WHEN COMPLETELY BACKFILLED, NO LESS THAN 5 GALLONS OF WATER SHALL BE POURED INTO THE HOLE. THE BACKFILL MATERIAL SHALL BE THOROUGHLY SATURATED AND ADDITIONAL MATERIAL ADDED, AS NECESSARY, TO COMPENSATE FOR SHRINKAGE.
- ANODE, PIPE AND REFERENCE CELL LEAD WIRES SHALL BE INSTALLED IN TRENCHES NOT LESS THAN 24 INCHES DEEP. EXCAVATION AND BACKFILLING OF TRENCHES SHALL BE IN ACCORDANCE WITH THE TECHNICAL SPECIFICATIONS.
- PERMANENT REFERENCE CELLS SHALL BE INSTALLED HORIZONTALLY, 6 INCHES BELOW THE PIPE'S OUTER SURFACE IN NATIVE NATURAL SAND SOIL AND NO CLOSER THAN 20' TO A MAGNESIUM ANODE. THE BACKFILL MATERIAL AROUND THE REFERENCE CELL SHALL BE THOROUGHLY COMPACTED. WHEN THE REFERENCE CELL IS COMPLETELY COVERED, NO LESS THAN 5 GALLONS OF WATER SHALL BE POURED INTO THE HOLE. THE BACKFILL MATERIAL SHALL BE THOROUGHLY SATURATED AND ADDITIONAL MATERIAL ADDED, AS NECESSARY, TO COMPENSATE FOR SHRINKAGE.
- TEST STATIONS SHALL BE PROVIDED WITH A 1 INCH WIDE BY 2 INCH LONG TYPE 316 STAINLESS STEEL TAG, PERMANENTLY ATTACHED TO THE ANODE LEAD WIRE INSIDE THE TEST STATION. INFORMATION ENGRAVED ON THIS TAG SHALL INCLUDE THE TEST STATION NUMBER AND ASSOCIATED STRUCTURES.
- LEAD WIRE TERMINATIONS TO THE TEST STATION TERMINAL BLOCK SHALL BE MADE USING APPROPRIATELY SIZED, TINNED SOLID COPPER RING TONGUE SOLDERLESS CRIMP-TYPE CONNECTORS. INSTALLATION OF THE CONNECTORS SHALL BE IN ACCORDANCE WITH THE MANUFACTURER'S INSTRUCTIONS AND RECOMMENDED TOOLS.
- COMPLETE ELECTRICAL ISOLATION OF ALL STEEL PIPING SHALL BE OBTAINED BY MAINTAINING A MINIMUM OF 6" CLEARANCE WITH ALL FOREIGN METALLIC STRUCTURES AND INSTALLATION OF FLANGE INSULATION KITS AT ALL ENDPOINTS.


FOR REFERENCE ONLY

AS CONSTRUCTED PLANS
I hereby certify that all construction required
by this sheet has been accomplished as indicated

By: *[Signature]* DATE: 10/92
JRS Greiner Woodward Clyde, Inc.

LEGEND	
(A1)	SEE DETAIL 4 ON SHEET CP3.02
(A2)	SEE DETAIL 5 ON SHEET CP3.02
(A3)	SEE DETAIL 6 ON SHEET CP3.02
(M)	MAGNESIUM ANODE BAG # ARROW POINTS TO TEST STATION LOCATION

INBOUND FILTRATION / PIPELINE CORRIDOR PARTIAL PLAN
SCALE: 1/4" = 1'-0"

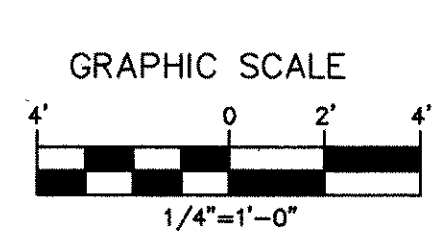

REV. NO.	DATE	DESCRIPTION	MADE BY	CHK. BY	APPD. BY
AB	7/99	CONTRACTOR'S AS-BUILT CONDITIONS		DJM	RAH

MASSACHUSETTS PORT AUTHORITY
BOSTON, MASSACHUSETTS

BOSTON LOGAN INTERNATIONAL AIRPORT
EAST BOSTON, MASSACHUSETTS


AIRCRAFT FUELING SYSTEMS
SCHEDULE B - FUEL STORAGE FACILITY
INBOUND FILTRATION / PIPELINE CORRIDOR PARTIAL PLAN
JFP, JET FUEL DRAIN PIPING & IWW PIPING

CONSULTANT AND SUBCONSULTANT:
GREINER INC. TAMPA, FLORIDA
SOUTHERN CATHODIC PROTECTION ATLANTA, GEORGIA


DRAWN BY: EW CHKD. BY: JFF DWG. NO.: CP2.08
SCALE: AS SHOWN APPROVED: JLP DATE: 2/97

MPA CONTRACT NO.: MPA 1.646C (R) SHEET NO. 147 OF 259


AS BUILT

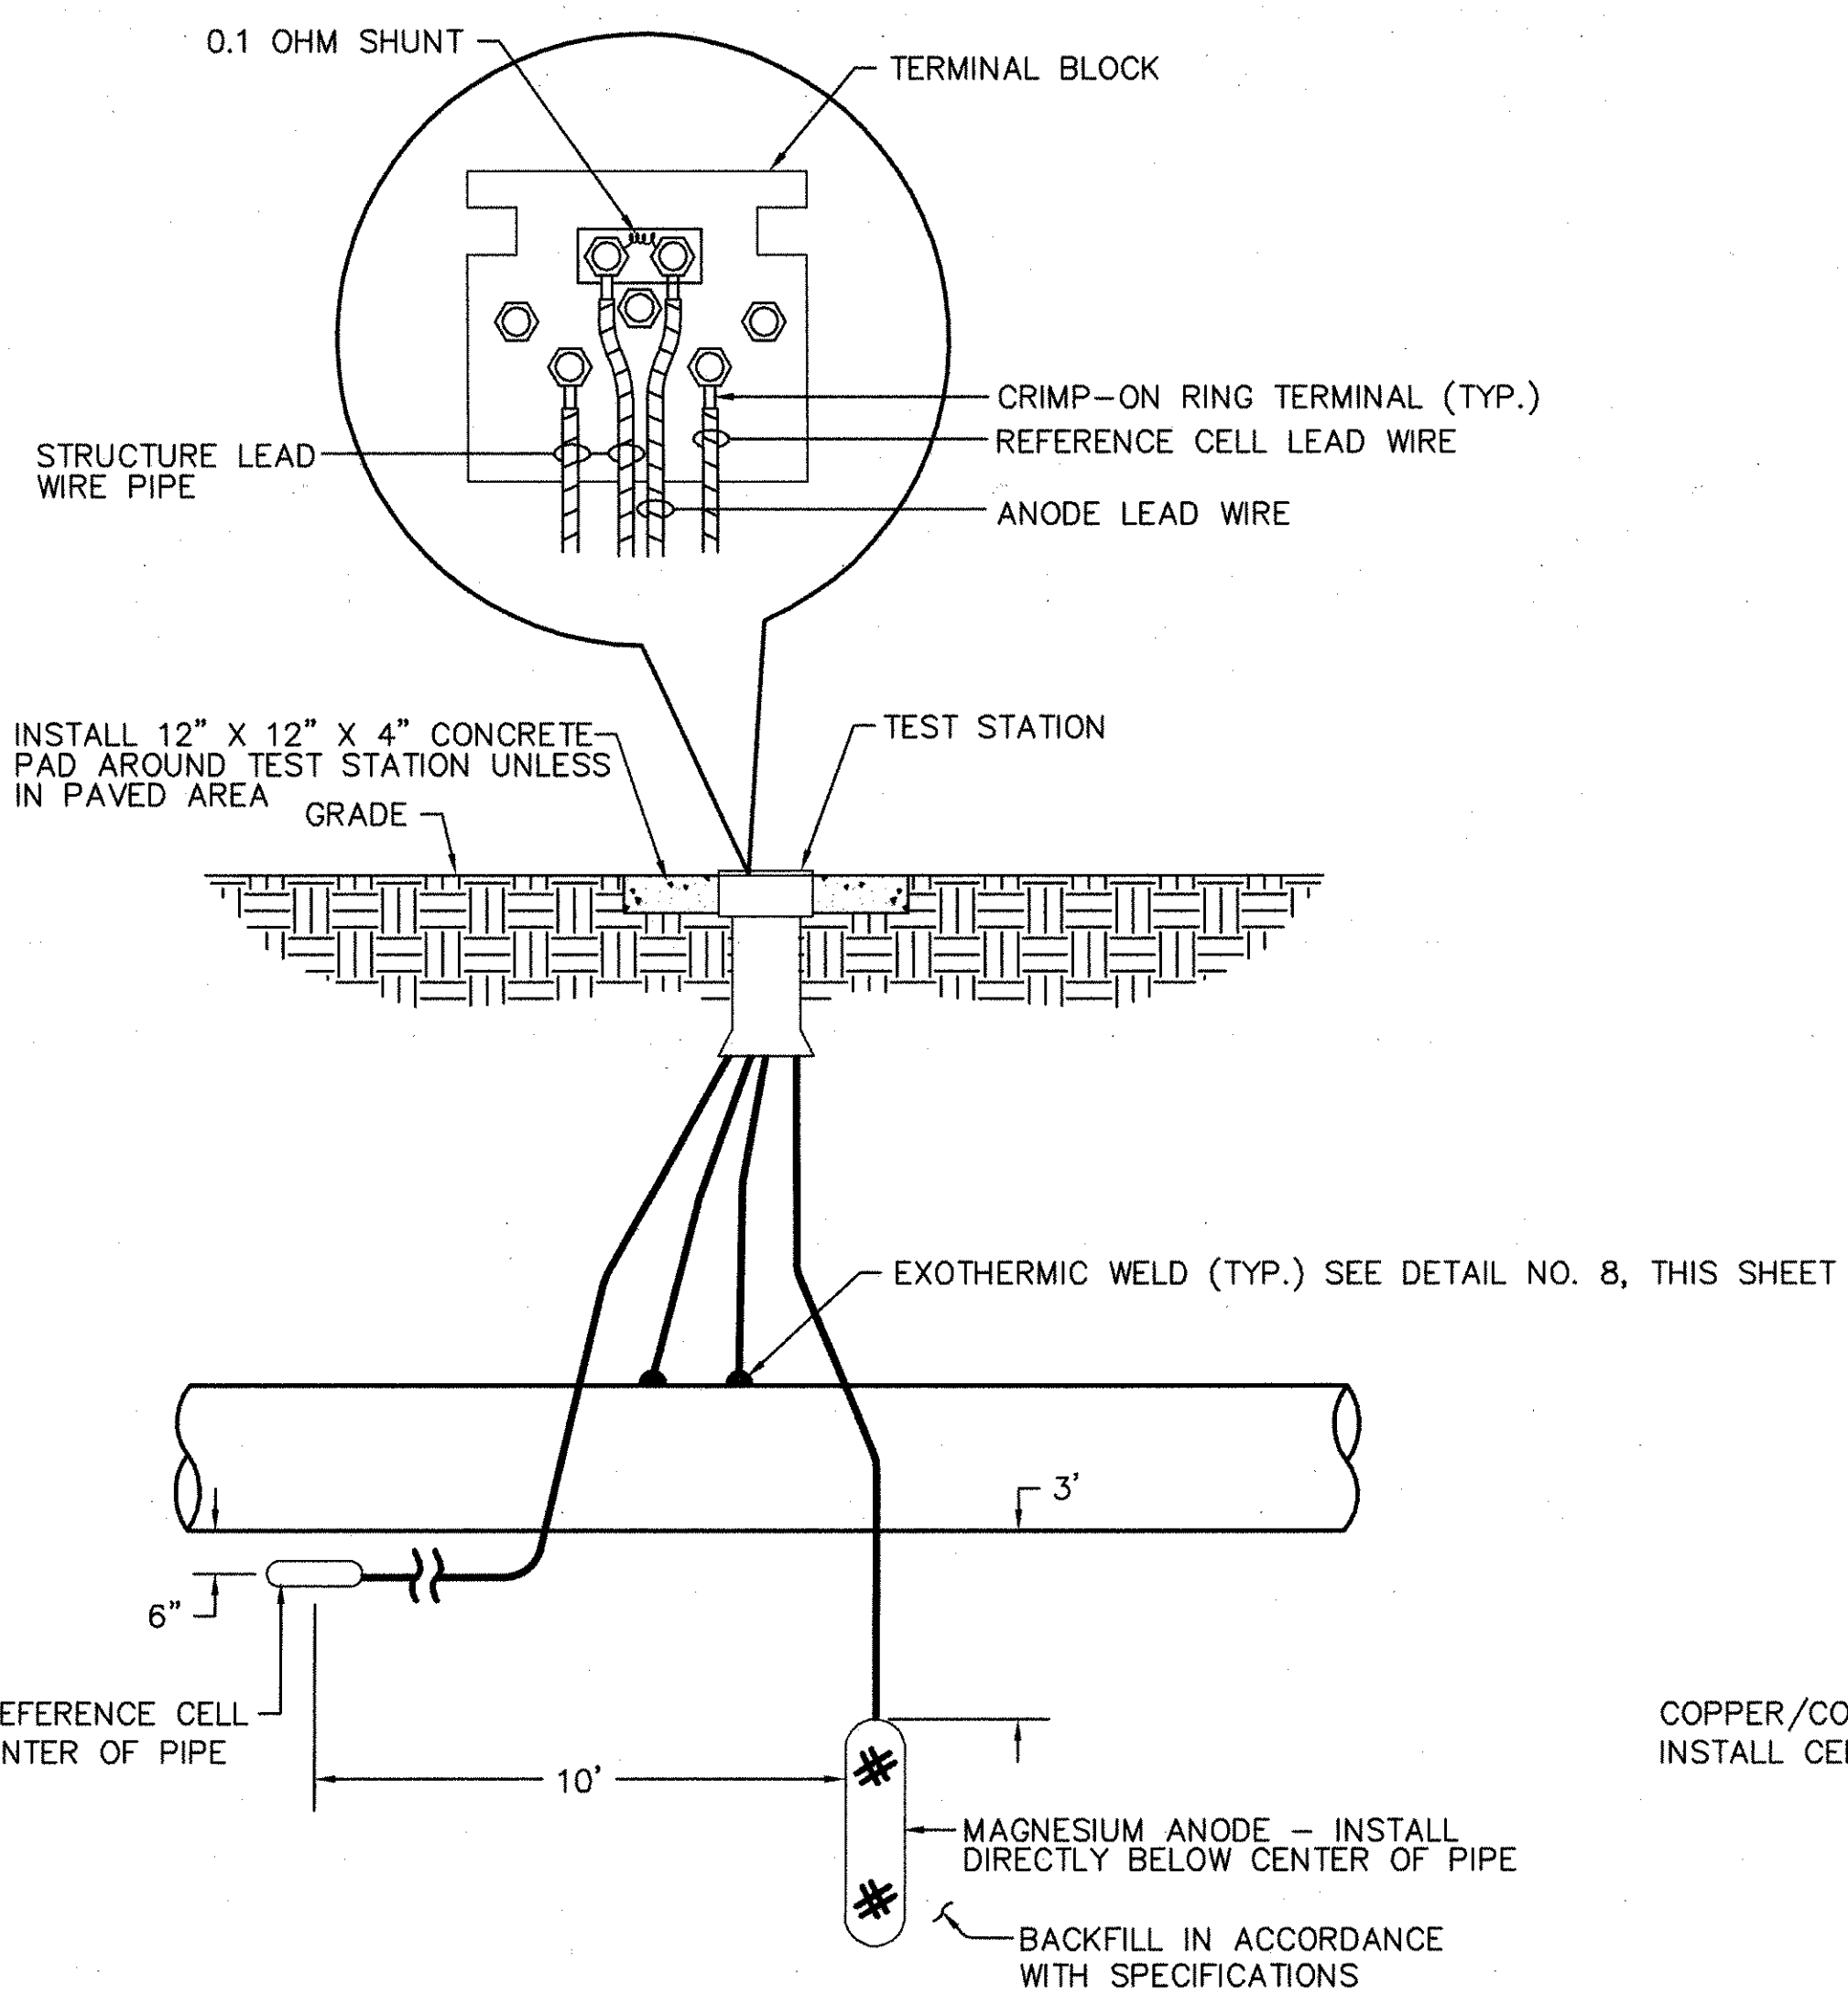



MAGNESIUM ANODE TEST STATION DETAIL 4
SINGLE PIPELINE CP3.02

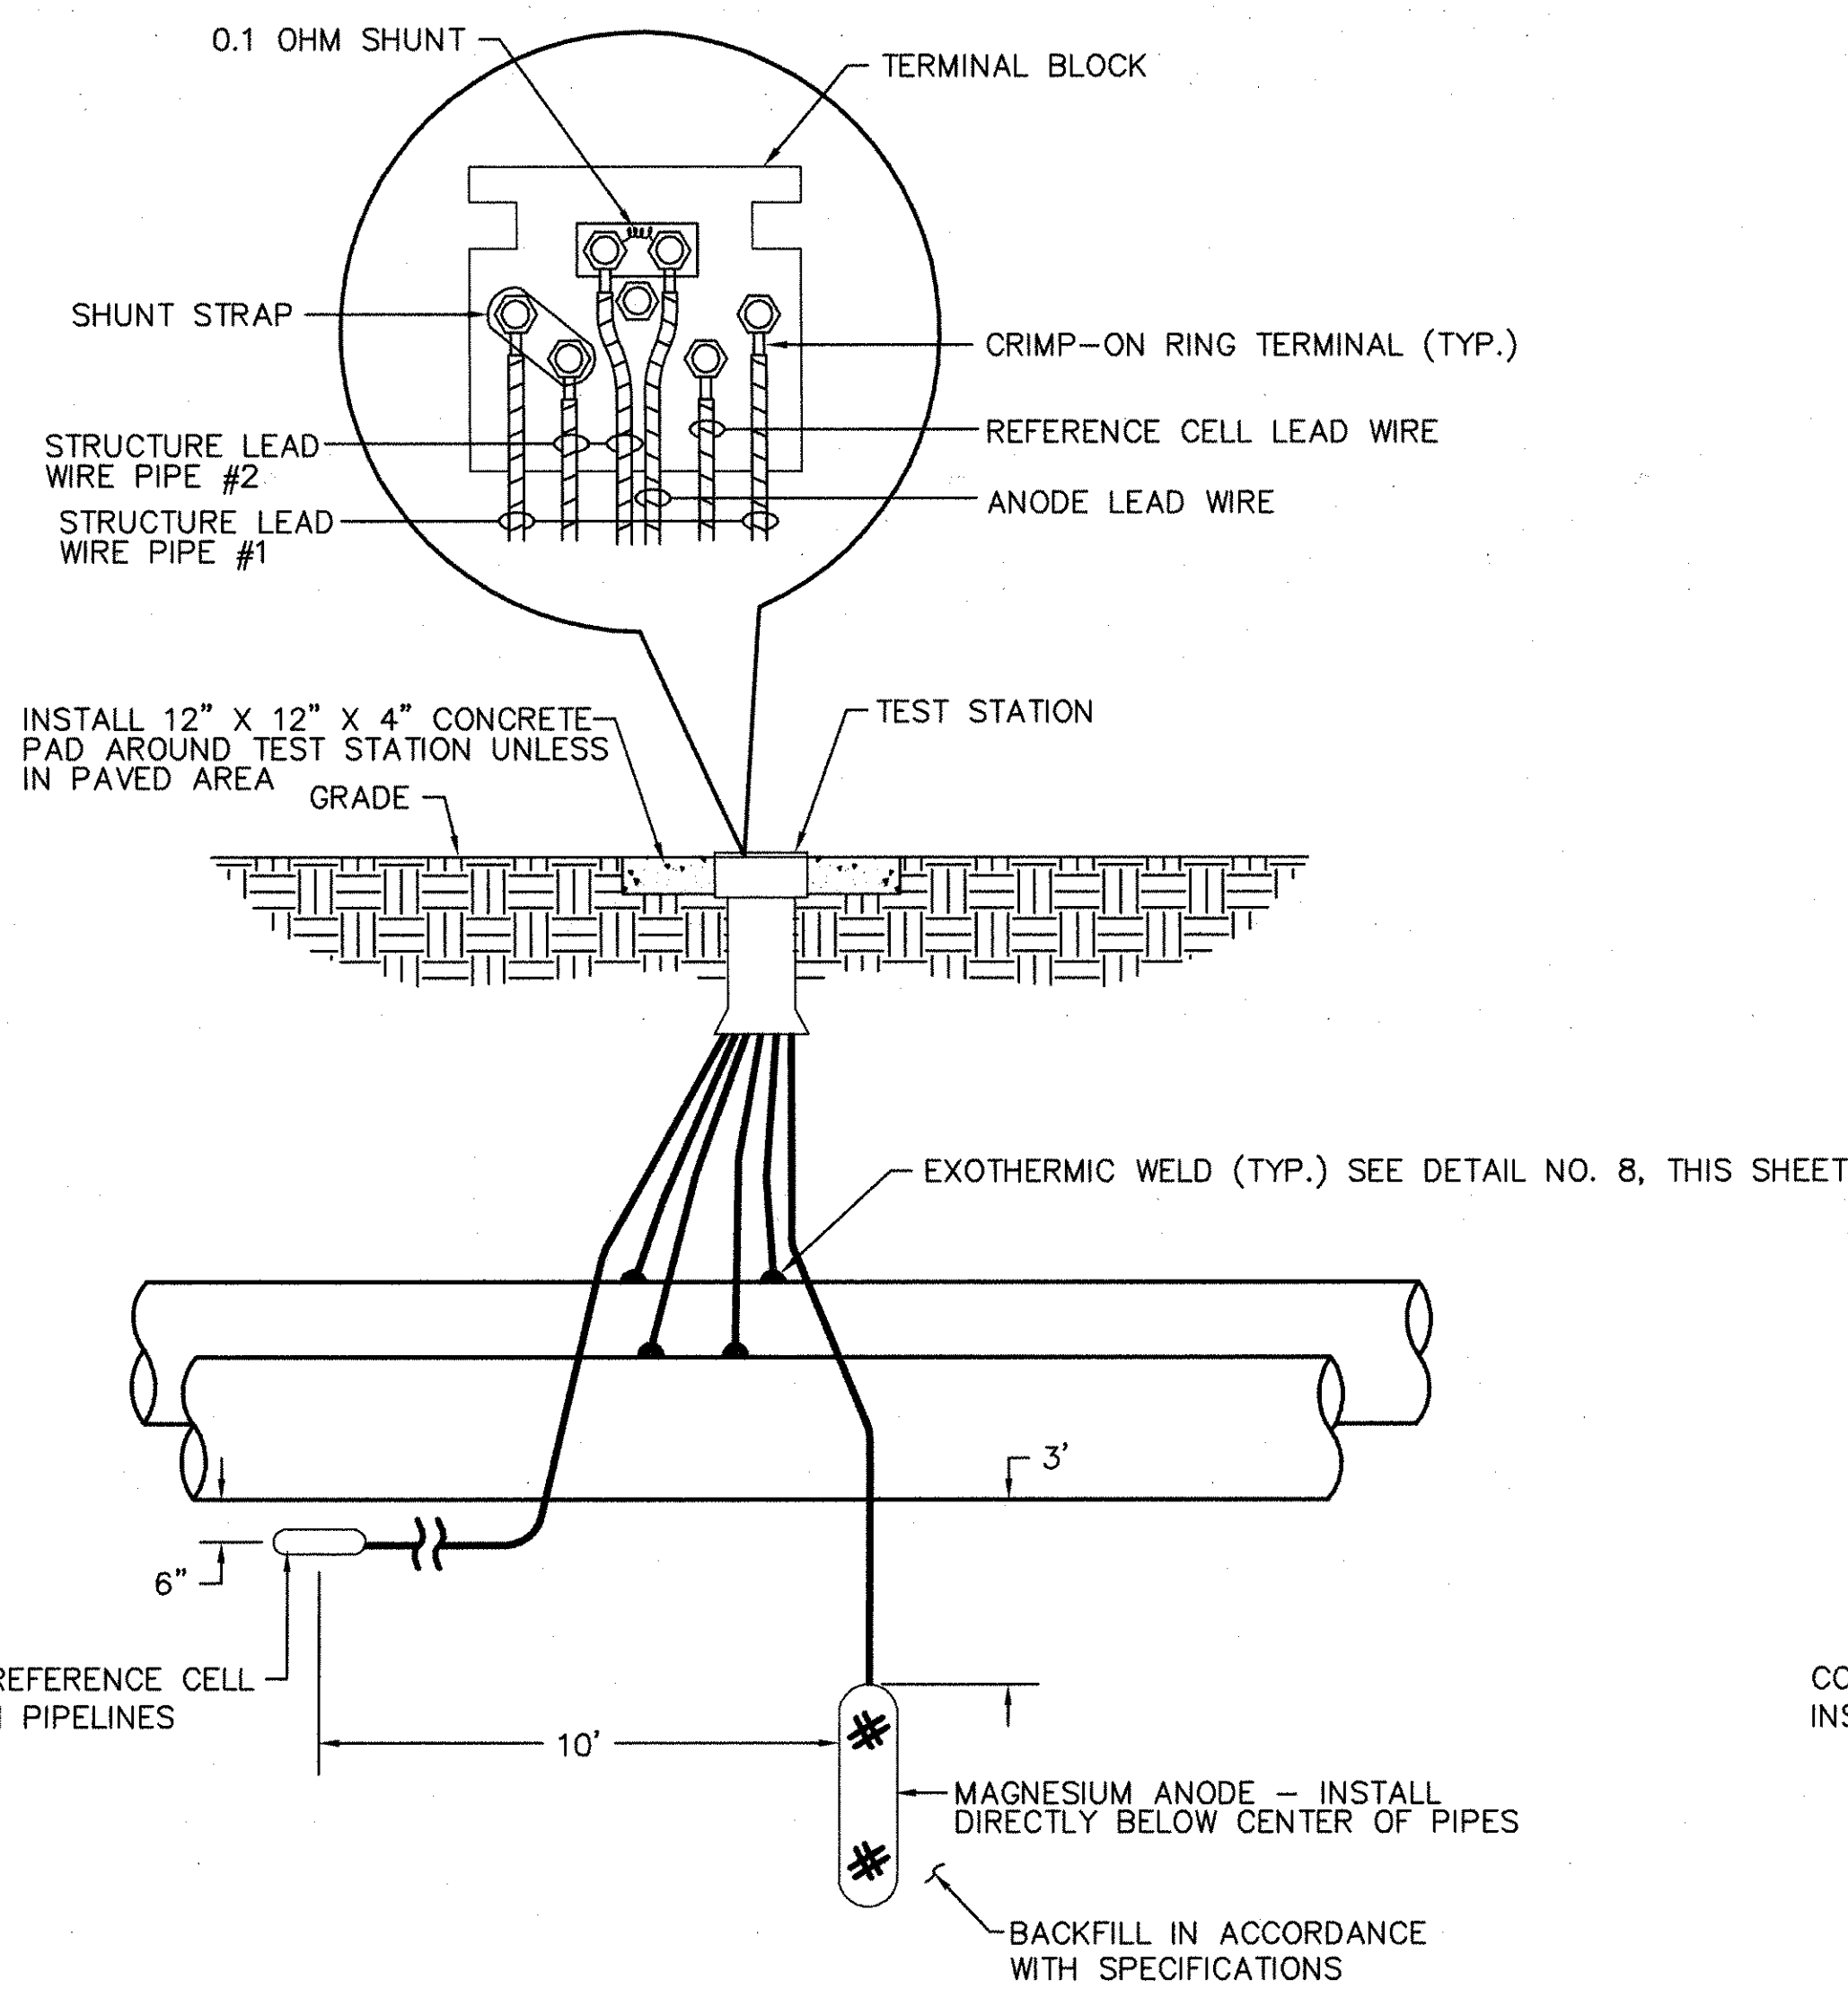


MAGNESIUM ANODE TEST STATION DETAIL 5
DOUBLE PIPELINE CP3.02

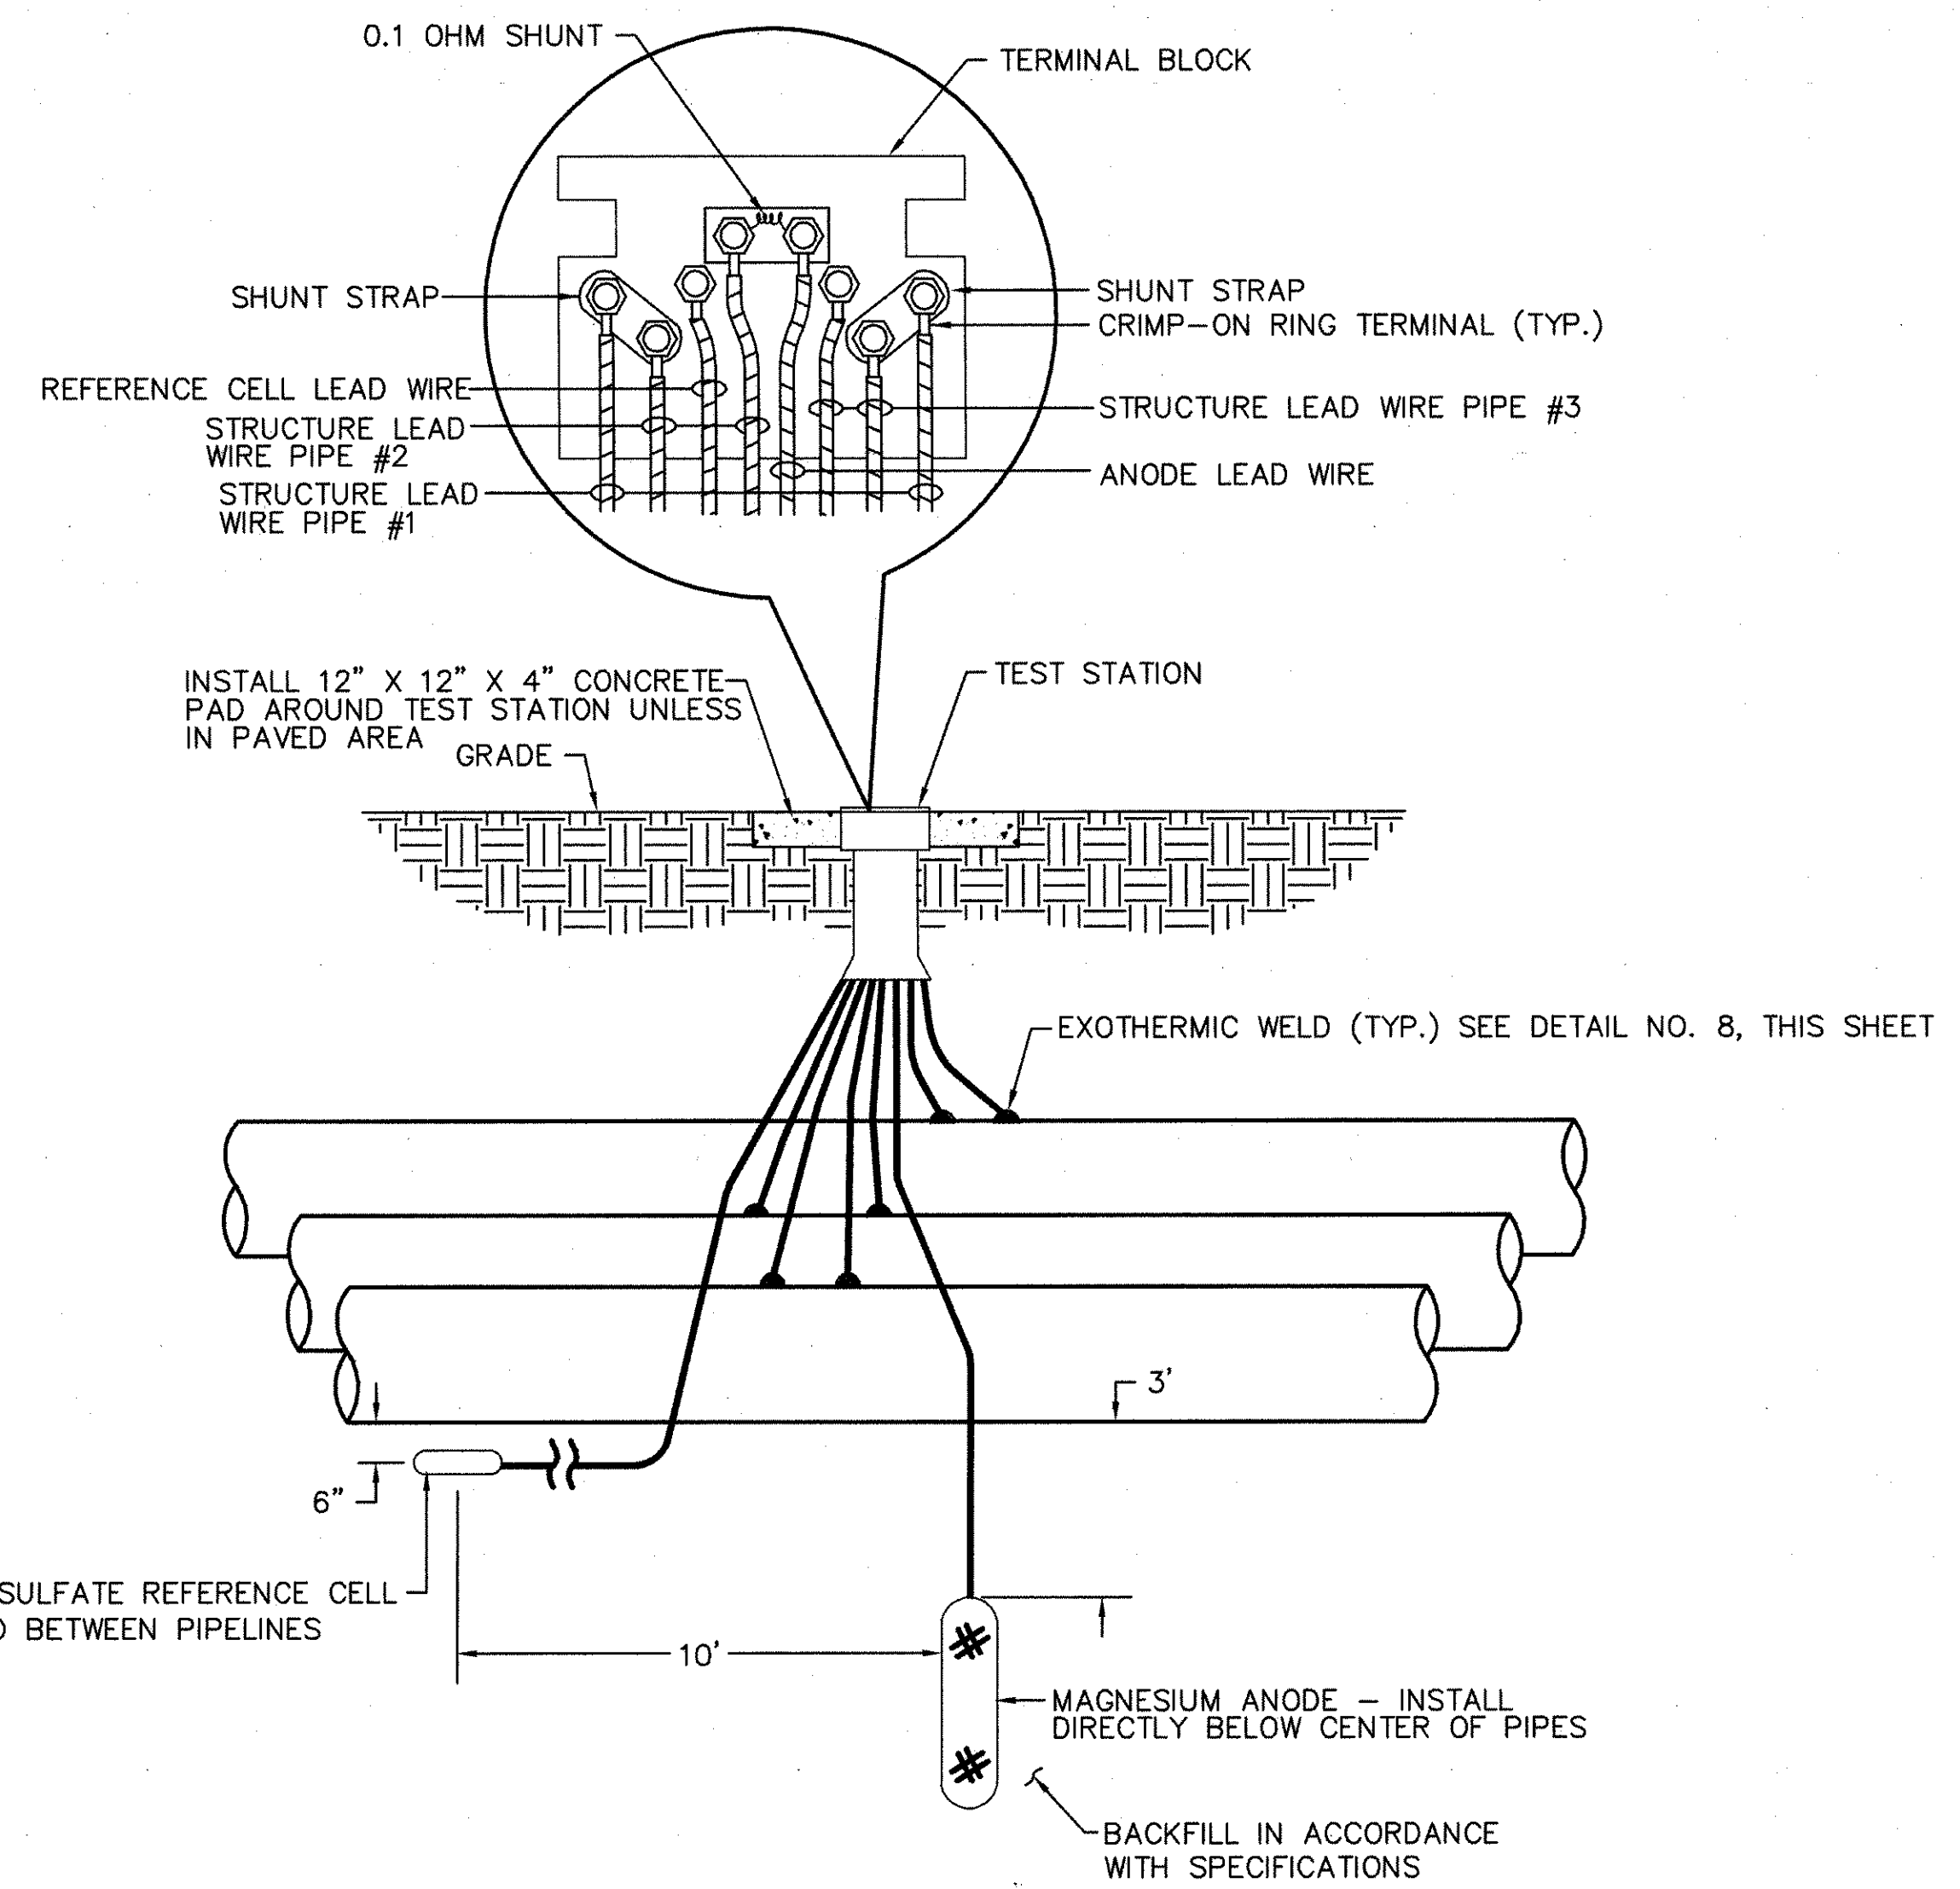

MAGNESIUM ANODE TEST STATION DETAIL 6
TRIPLE PIPELINE CP3.02

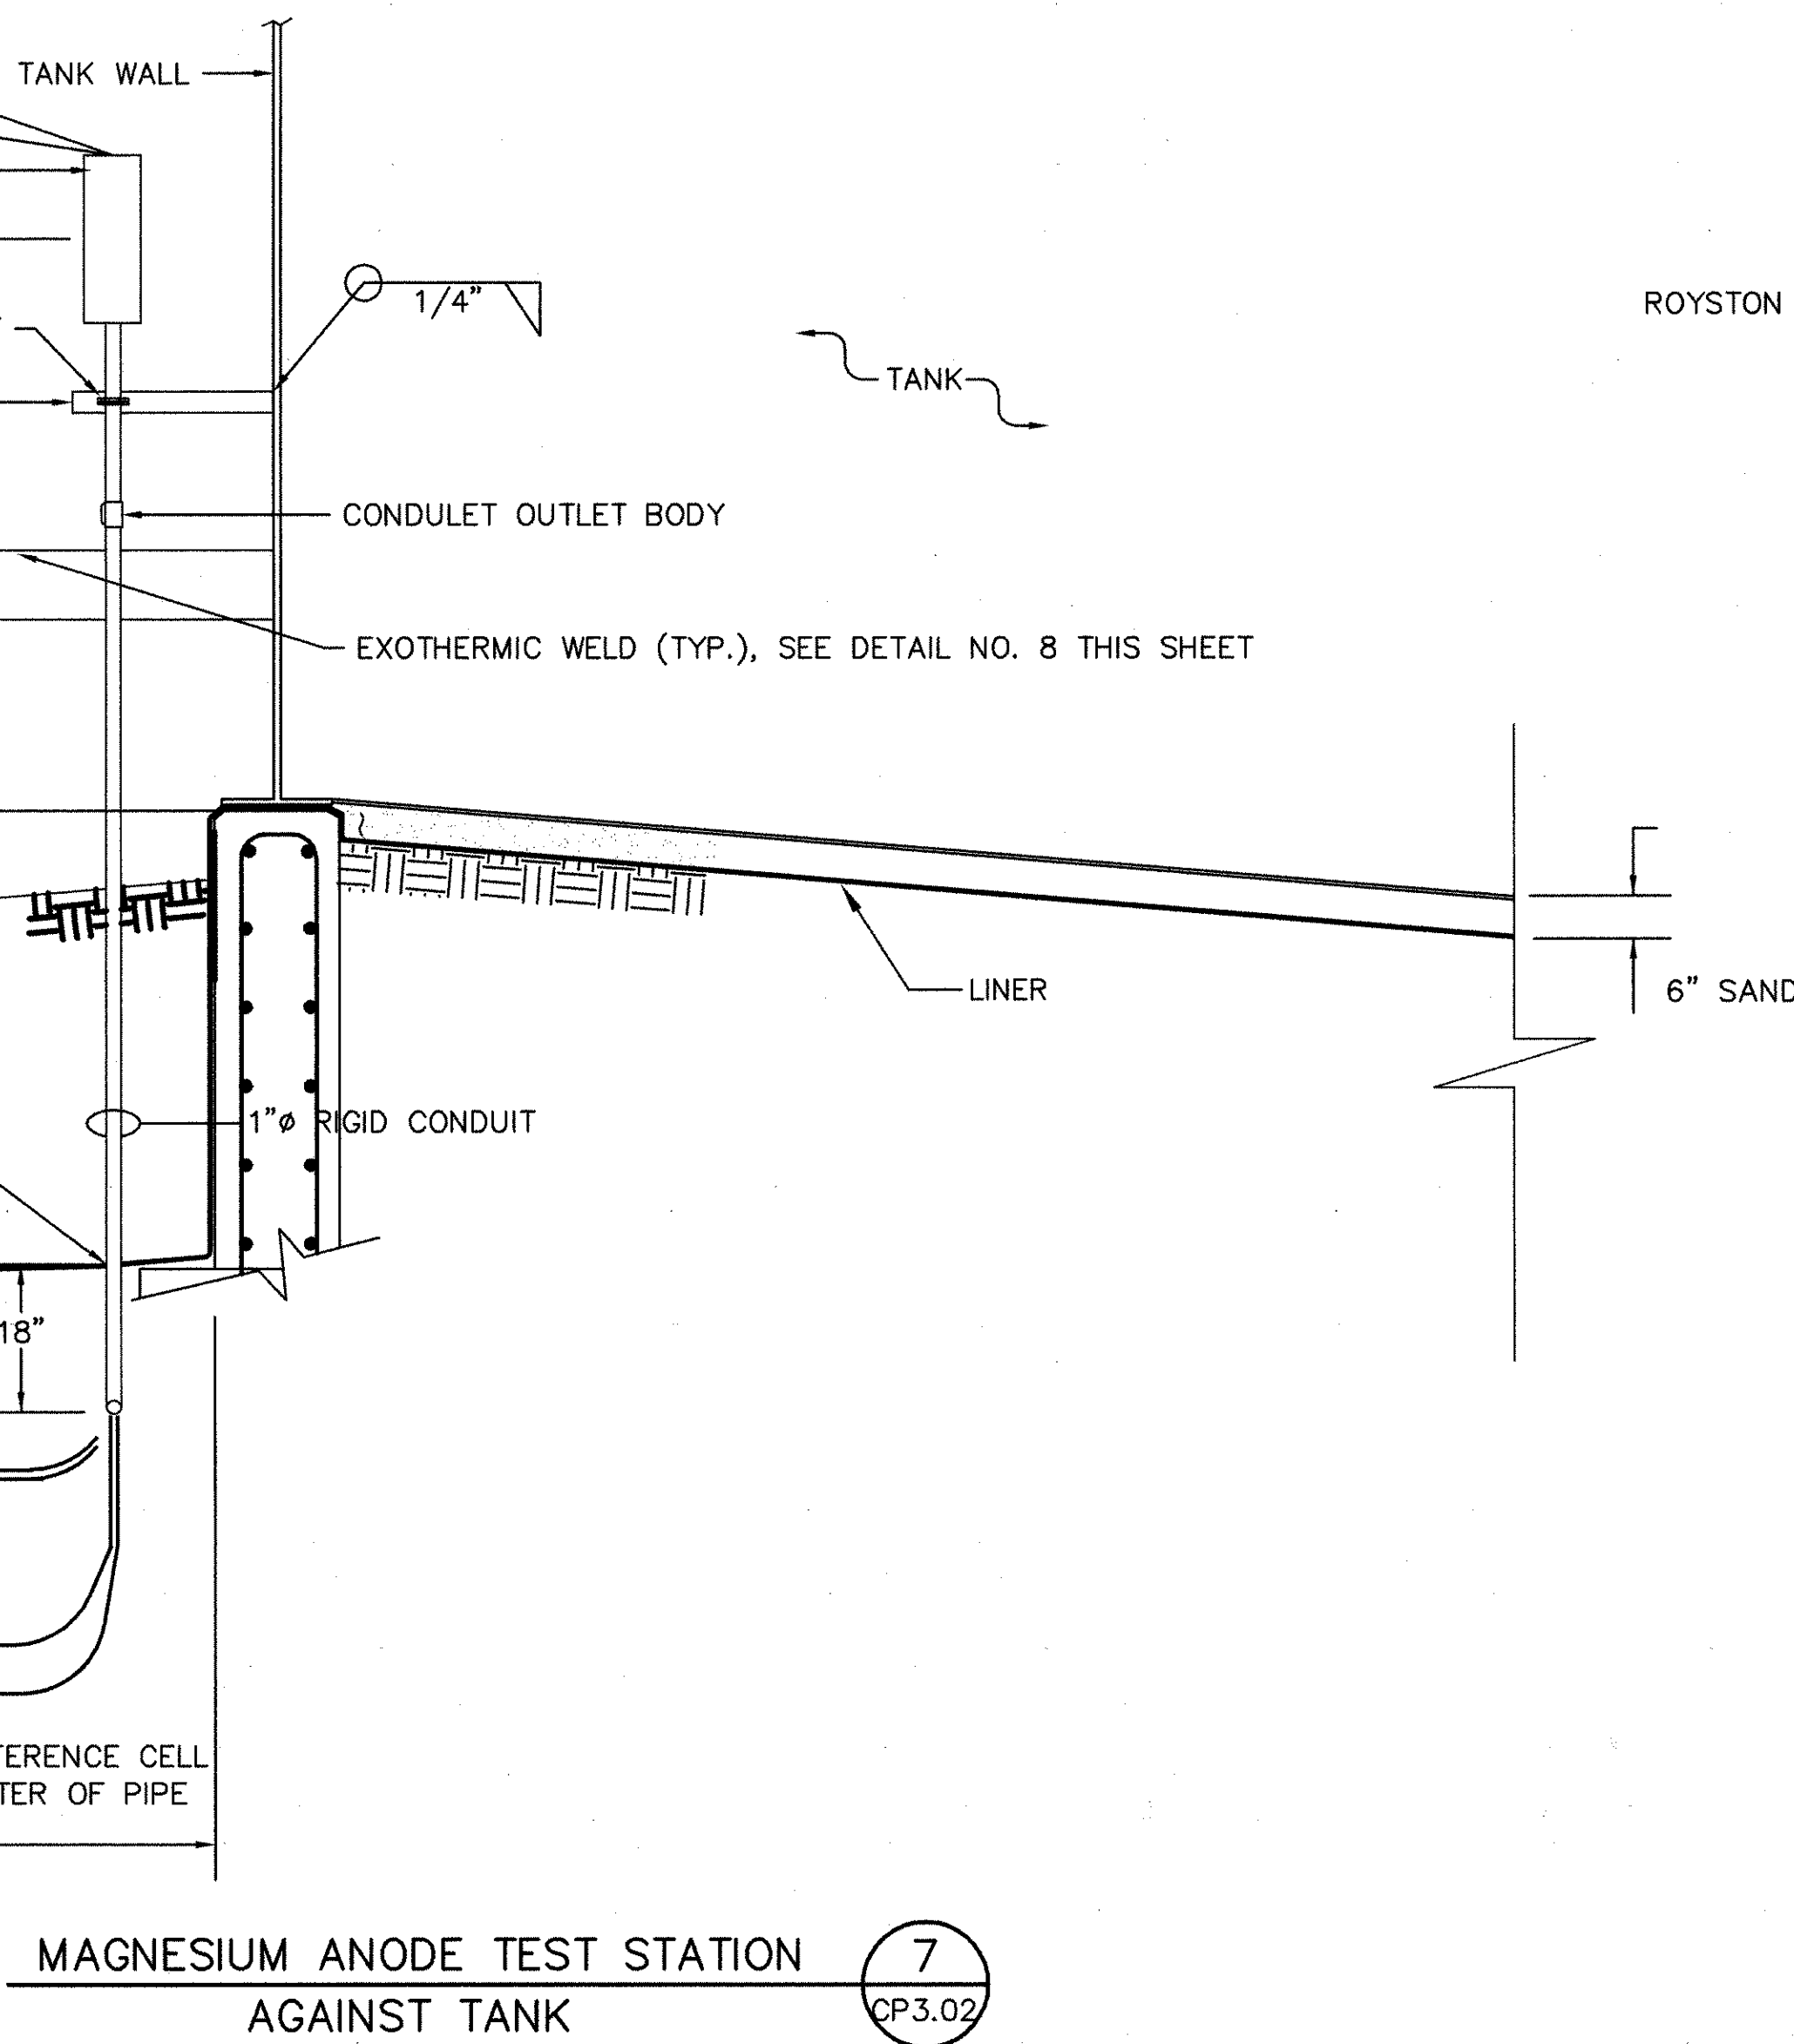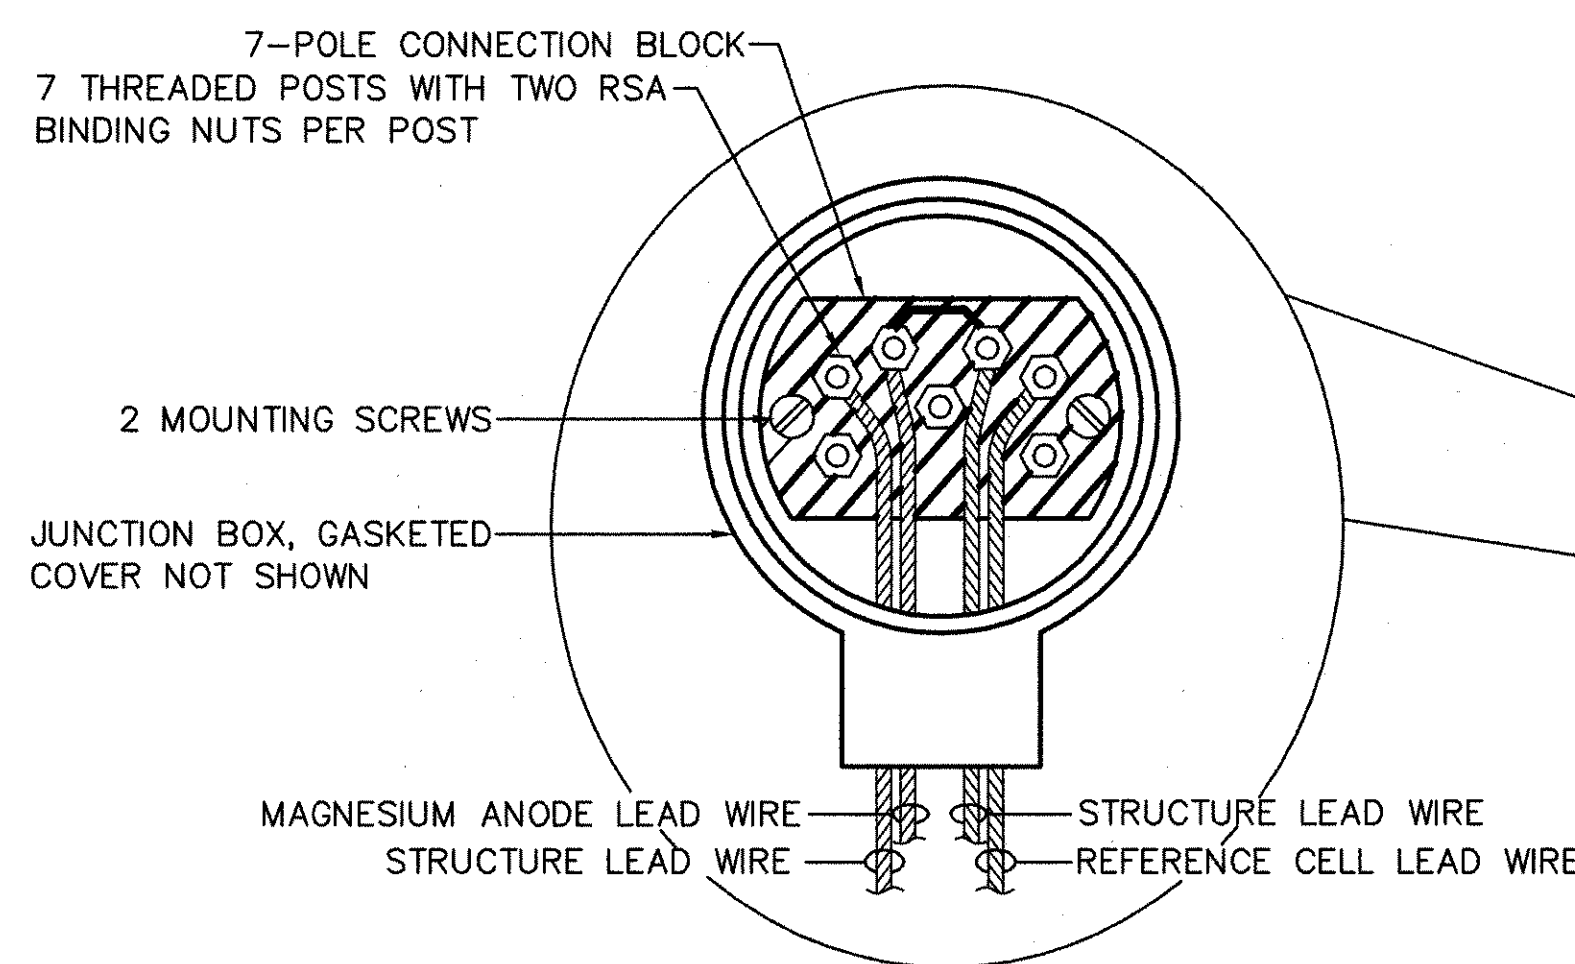

MAGNESIUM ANODE TEST STATION 7
AGAINST TANK CP3.02

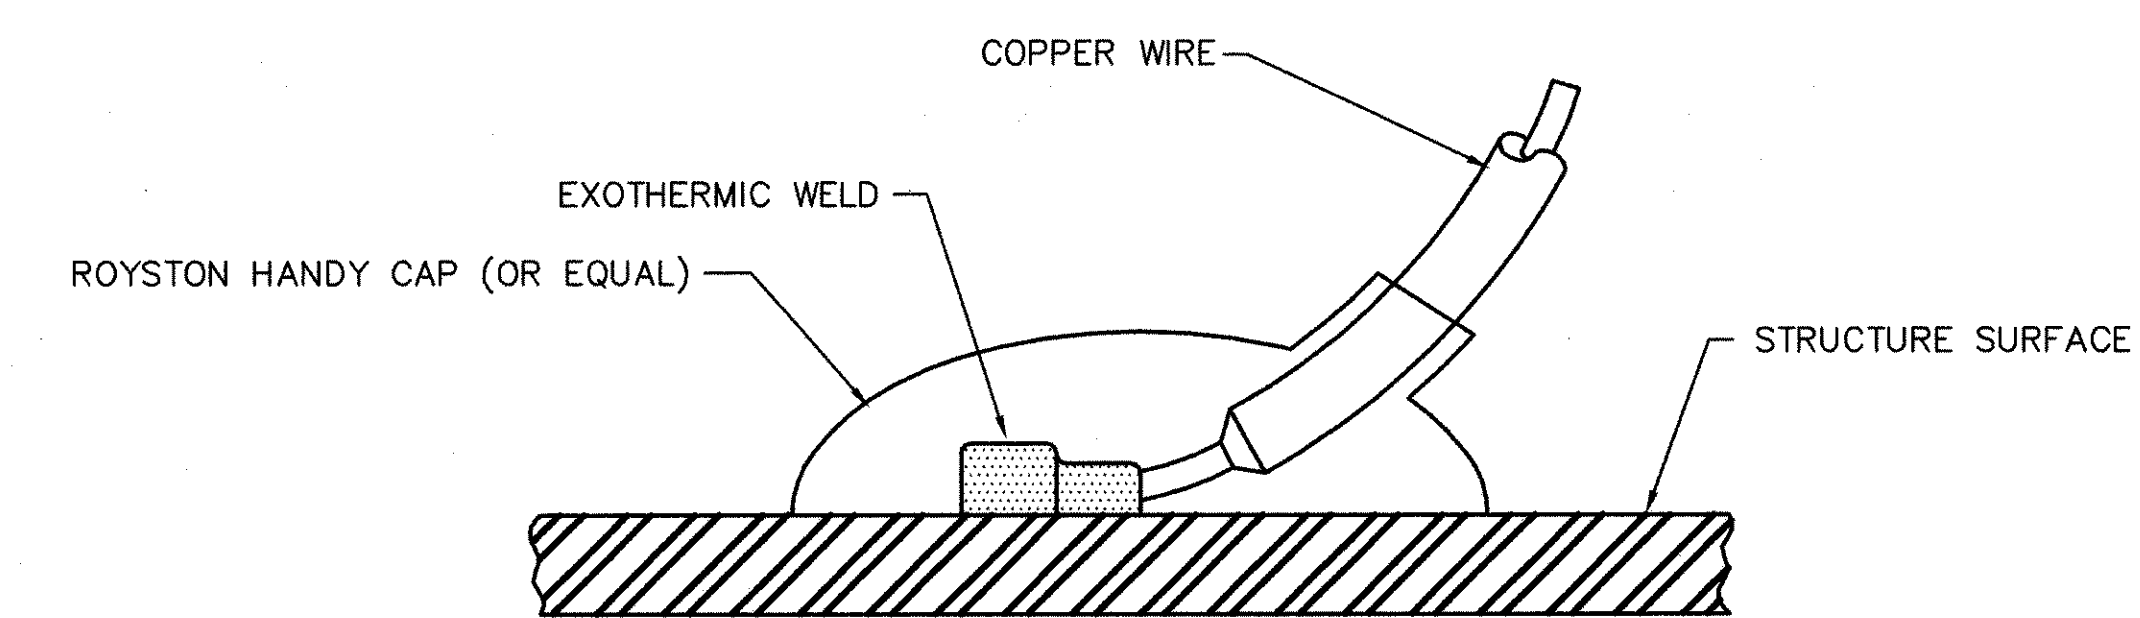

EXOTHERMIC WELD DETAIL 8
CP3.02

- NOTES:
1. METAL SURFACE TO BE DRY AND FREE OF ALL FOREIGN MATERIAL.
 2. CABLE CONNECTION TO HAVE MINIMUM 1/2\"/>

FOR REFERENCE ONLY

AS CONSTRUCTED PLANS
I hereby certify that all construction required
by this sheet has been accomplished as indicated

Greiner Woodward Clyde, Inc.
BY: [Signature] DATE: 1/9/02

REV. NO.	DATE	DESCRIPTION	MADE BY	CHK. BY	APPD. BY
AB	7/99	CONTRACTOR'S AS-BUILT CONDITIONS		DJM	DJM RAH
MASSACHUSETTS PORT AUTHORITY BOSTON, MASSACHUSETTS					
BOSTON LOGAN INTERNATIONAL AIRPORT EAST BOSTON, MASSACHUSETTS					
AIRCRAFT FUELING SYSTEMS SCHEDULE B - FUEL STORAGE FACILITY CATHODIC PROTECTION SYSTEM - DETAILS					
CONSULTANT AND SUBCONSULTANT:					
GREINER INC. TAMPA, FLORIDA SOUTHERN CATHODIC PROTECTION ATLANTA, GEORGIA					
DRAWN BY: EW		CHKD. BY: JFF		DWG. NO. CP3.02	
SCALE: AS SHOWN		APPROVED: JLP		DATE: 2/97	
MPA CONTRACT NO.: MPA 1.646C (R) SHEET NO. 151 OF 150					

ATTACHMENT C

RAIN FOR RENT ENGINEERING

Western Oilfields Supply Company
3404 State Road; Bakersfield, CA 93308
Phone: 661-399-9128, Fax: 661-399-3211



Liquid Ingenuity

ENGINEER: Meagan White

DATE: 3/4/2020

ENG JOB NO: 01-20135

ENG DOC NO: 01-20135-01-01

QUOTE NO: -

REVISION: **Original**

To: Nick Gamache
Branch: 1054
Customer: Bond Brothers
Project: BOS NWMS

GIVEN INFORMATION:

This recommendation is for dewatering an excavation with dimensions no larger than 94' long x 47' wide x 17' deep. The existing grade elevation is 12' above sea level (ASL) and groundwater is at 11' ASL. The underlying stratigraphy of the soil is mostly sandy clay and medium dense sand with silt.

ENGINEERED SOLUTION:

Professionally engineered solution to ensure a safely designed, and operable system.

PUMPS, PIPE, & HOSE: (approximate total lengths)

(2) BBA wellpoint dewatering pumps (1 primary, 1 back-up)
70 +/- wellpoints, 22 ft deep, 4 ft spacing
6inch wellpoint header pipe

***Spillguards, PipeStax, and Hose Bridges are recommended**

SYSTEM DESIGN NARRATIVE:

The Rain for Rent Engineering Department is proposing a wellpoint dewatering system around the perimeter of the excavation. Wellpoints will be spaced 4' center to center and jetted to a depth of 22' or until refusal. From past experience well-points can typically be self-jetted successfully in soils with an "N" value of 15 blows/foot or less. If the points are unable to be injected, drilling will be required at an additional expense. The system shall consist of 70 +/- well points with one (1) primary and one (1) backup BBA PT90 or PT150 dewatering pumps and 6" HDPE SDR 17 wellpoint header pipe. The discharge off each pump shall be 6" pipe/hose discharging into a nearby frac tank. Air/vacuum vents are required at the pump station and at high points along the pipeline.

If deemed necessary, sumps and/or a French Drain can be used to get rid of any nuisance water and/or aid in the dewatering process. If a French Drain is used it should be filled with gravel to help reduce erosion and sloped in such a way to allow groundwater to travel to low point(s). Small submersible pumps should be placed in every low point to remove the perched water. If higher than expected flows are encountered an optional backup pump can be operated for the first few days to help reduce the draw-down time. Constant monitoring and fine-tuning of the dewatering system is vital. Please note Rain for Rent recommends a minimum of seven days of draw-down time. Actual draw-down time may vary depending on site conditions.

The analytical model used to design the above dewatering system can be found in the text Construction Dewatering and Groundwater Control New Methods and Applications. The general parameters for the wellpoint system described above are as follows: an unconfined aquifer with dimensions of 94' long x 47' wide, grade elevation of 12' ASL, and a ground water elevation of 11' ASL. For design purposes the saturated soil is assumed to be silty medium dense sand and sandy clay, with a storage coefficient of 0.2 and a hydraulic conductivity ranging from 50-400 gpd/ft² estimated from the boring logs provided in the geotechnical report. Based upon these assumptions the required steady-state flow-rate for entire excavation will range from 38-179 gpm. Flow-rates may vary substantially depending on actual soil and ground water conditions.

It should be noted that the above steady-state flow rates are greatly impacted by the storage coefficient, height of water table, soil hydraulic conductivity, aquifer thickness, sources of recharge, the time the dewatering system is operating, and several other factors. Also, a considerably higher initial in-flow should be anticipated.

Performance of the dewatering system is not guaranteed. Changes to site conditions, unknown site conditions, and/or changes to design assumptions will impact the performance of the system, and may require additional equipment, changes to dewatering methods, and or changes in construction methods. All associated project cost and impact remains the customers responsibility. Rain for Rent will issue a Change Order to the Customer prior to providing additional equipment and/or labor. Customer retains all geotechnical responsibility associated with the project, including, but not limited to, any and all subsidence. The recommendations contained herein were derived from calculations using published pump curves and information provided by customers, end users, project engineers, and/or other sources. Actual pump and system performance may vary. Any variations of the system's characteristics, including but not limited to, flow, suction lift, discharge distance, and/or submergence may require changes to the system(s). Any system recommendation changes may result in additional cost. In such cases, a change order will be required to proceed. All information contained herein or disclosed by this document is considered confidential and proprietary. Any disclosure, reproduction and/or distribution of this document in whole or in part without the written authorization from Rain for Rent's Engineering Department is prohibited. Please see your estimate and rental agreement for additional terms and conditions, these recommendations are incorporated as a part of those contractual documents.

Equivalent Well Model

AREA	PERIMETER
$r_s = \sqrt{\frac{ab}{\pi}}$	$r_s = \frac{a+b}{\pi}$

a = 94 ft
b = 47 ft

r_s = excavation equivalent radius

area r_s = 37.50 ft

perimeter r_s = 44.88 ft

a/b = 2.00

Radius of Influence R_o

$$R_o = r_s + \sqrt{\frac{Tt}{C_4 C_s}}$$

T = 8,400 gpd/ft
t = 10,080 min
C₄ = 4,790

T = KB = transmissivity

t = pumping time

C₄ = Jacob Plots Constant

K = hydraulic conductivity

B = aquifer depth

C_s = storage coefficient

C_s = 0.05 to 0.2 {Unconfined Aquifer}

C_s = 0.0005 to 0.001 {Confined Aquifer}

Q_w = frictionless flow at equilibrium

H = original saturated thickness

h_w = height of water at the well

rw = radius of the well = rs in equivalent well modeling

grade: 12 ft (MSL)

groundwater: 11 ft (MSL)

device depth: 22 ft

H = 21 ft

h_w = 5 ft

K = 400 gpd/ft²

B = 21 ft

x = 94.00 ft

Radial Flow, Confined Aquifer Q_w = 128.98 gpm

R_o = 4,249 ft r_s = 44.88 ft C_s = 0.001

Radial Flow, Unconfined Aquifer Q_w = 178.86 gpm

R_o = 342 ft r_s = 44.88 ft C_s = 0.2

Radial Flow, Mixed Aquifer Q_w = 155.35 gpm

R_o = 465 ft r_s = 44.88 ft C_s = 0.1

Line Flow, Confined Aquifer Q_w/x = 0.04 gpm/ft

L = 2,114 ft r_s = 23.50 ft C_s = 0.001

Line Flow, Unconfined Aquifer Q_w/x = 0.36 gpm/ft

L = 160 ft r_s = 23.50 ft C_s = 0.2

End Effects (Line Flow), Unconfined Aquifer = 139.00 gpm

R_o = 321 ft r_s = 23.50 ft C_s = 0.2

ANALYTICAL MODELING

Q_w = 179 gpm

wells / points: 70

Q_w per well/point: 2.56 gpm

*Q = 358 gpm

*estimated startup flow rate

Q per well/point: 5.11 gpm

Well / Wellpoint Design

Q_w = 7.00 gpm

$$Q_w = 0.035 l_w r_w \sqrt{K}$$

l_w = 5 ft

r_w = 2 in

Well Spacing = 4 ft

Equivalent Well Model

AREA	PERIMETER
$r_s = \sqrt{\frac{ab}{\pi}}$	$r_s = \frac{a+b}{\pi}$

a = 94 ft
b = 47 ft

r_s = excavation equivalent radius

area r_s = 37.50 ft

perimeter r_s = 44.88 ft

a/b = 2.00

Radius of Influence R_o

$$R_o = r_s + \sqrt{\frac{Tt}{C_4 C_s}}$$

T = 1,050 gpd/ft
t = 10,080 min
C₄ = 4,790

T = KB = transmissivity

t = pumping time

C₄ = Jacob Plots Constant

K = hydraulic conductivity

B = aquifer depth

C_s = storage coefficient

C_s = 0.05 to 0.2 {Unconfined Aquifer}

C_s = 0.0005 to 0.001 {Confined Aquifer}

Q_w = frictionless flow at equilibrium

H = original saturated thickness

h_w = height of water at the well

rw = radius of the well = rs in equivalent well modeling

grade: 12 ft (MSL)

groundwater: 11 ft (MSL)

device depth: 22 ft

H = 21 ft

h_w = 5 ft

K = 50 gpd/ft²

B = 21 ft

x = 94 ft

Radial Flow, Confined Aquifer Q_w = 20.78 gpm

R_o = 1,531 ft r_s = 44.88 ft C_s = 0.001

Radial Flow, Unconfined Aquifer Q_w = 37.64 gpm

R_o = 150 ft r_s = 44.88 ft C_s = 0.2

Radial Flow, Mixed Aquifer Q_w = 31.08 gpm

R_o = 194 ft r_s = 44.88 ft C_s = 0.1

Line Flow, Confined Aquifer Q_w/x = 0.02 gpm/ft

L = 755 ft r_s = 23.50 ft C_s = 0.001

Line Flow, Unconfined Aquifer Q_w/x = 0.11 gpm/ft

L = 64 ft r_s = 23.50 ft C_s = 0.2

End Effects (Line Flow), Unconfined Aquifer = 26.72 gpm

R_o = 129 ft r_s = 23.50 ft C_s = 0.2

ANALYTICAL MODELING

Q_w = 38 gpm

wells / points: 70

Q_w per well/point: 0.54 gpm

*Q = 75 gpm

*estimated startup flow rate

Q per well/point: 1.08 gpm

Well / Wellpoint Design

Q_w = 2.47 gpm

$$Q_w = 0.035 l_w r_w \sqrt{K}$$

l_w = 5 ft

r_w = 2 in

Well Spacing = 4 ft

RAIN FOR RENT ENGINEERING

Western Oilfields Supply Company
3404 State Road; Bakersfield, CA 93308
Phone: 661-399-9128, Fax: 661-399-3211



Liquid Ingenuity

ENGINEER: Meagan White
DATE: 3/4/2020
ENG JOB NO: 01-20135
ENG DOC NO: 01-20135-01-01
OPPORTUNITY NO: -
REVISION: Original

To: Nick Gamache
Branch: 1054
Customer: Bond Brothers
Project: BOS NWMS

SITE CONDITIONS

Site Dimensions:	94 ft long	Grade Elevation:	12 ft (ASL)	K Value:	400 gpd/ft ²
	47 ft wide	Groundwater Elevation:	11 ft (ASL)		
		Device Depth:	22 ft		

ANALYTICAL MODEL

Radial Flow, Unconfined Aquifer

$$Q_w = \frac{K(H^2 - h_w^2)}{458 \ln(R_o/r_w)}$$

Q _w =	179 gpm	Wells/wellpoints	70	Q _w per well:	2.6 gpm
**Q =	358 gpm	**estimated startup flow rate		Q per well:	5.1 gpm

POTENTIAL INDIVIDUAL WELL PERFORMANCE

$$Q_w = 0.035 l_w r_w \sqrt{K}$$

l _w =	5 ft	Q _w =	7 gpm
r _w =	2 in	Spacing =	4.0 ft

Performance of the dewatering system is not guaranteed. Changes to site conditions, unknown site conditions, and/or changes to design assumptions will impact the performance of the system, and may require additional equipment, changes to dewatering methods, and or changes in construction methods. All associated project cost and impact remains the customers responsibility. Rain for Rent will issue a Change Order to the Customer prior to providing additional equipment and/or labor. Customer retains all geotechnical responsibility associated with the project, including, but not limited to, any and all subsidence.

The recommendations contained herein were derived from calculations using published pump curves and information provided by customers, end users, project engineers, and/or other sources. Actual pump and system performance may vary. Any variations of the system's characteristics, including but not limited to, flow, suction lift, discharge distance, and/or submergence may require changes to the system(s). Any system recommendation changes may result in additional cost. In such cases, a change order will be required to proceed. All information contained herein or disclosed by this document is considered confidential and proprietary. Any disclosure, reproduction and/or distribution of this document in whole or in part without the written authorization from Rain for Rent's Engineering Department is prohibited. Please see your estimate and rental agreement for additional terms and conditions, these recommendations are incorporated as a part of those contractual documents.

RAIN FOR RENT ENGINEERING

Western Oilfields Supply Company
3404 State Road; Bakersfield, CA 93308
Phone: 661-399-9128, Fax: 661-399-3211



Liquid Ingenuity

ENGINEER: Meagan White
DATE: 3/4/2020
ENG JOB NO: 01-20135
ENG DOC NO: 01-20135-01-01
OPPORTUNITY NO: -
REVISION: Original

To: Nick Gamache
Branch: 1054
Customer: Bond Brothers
Project: BOS NWMS

SITE CONDITIONS

Site Dimensions:	94 ft long	Grade Elevation:	12 ft (ASL)	K Value:	50 gpd/ft ²
	47 ft wide	Groundwater Elevation:	11 ft (ASL)		
		Device Depth:	22 ft		

ANALYTICAL MODEL

Radial Flow, Unconfined Aquifer

$$Q_w = \frac{K(H^2 - h_w^2)}{458 \ln(R_o/r_w)}$$

Q _w =	38 gpm	Wells/wellpoints	70	Q _w per well:	0.5 gpm
**Q =	75 gpm	**estimated startup flow rate		Q per well:	1.1 gpm

POTENTIAL INDIVIDUAL WELL PERFORMANCE







$$Q_w = 0.035 l_w r_w \sqrt{K}$$

l _w =	5 ft	Q _w =	2 gpm
r _w =	2 in	Spacing =	4.0 ft

Performance of the dewatering system is not guaranteed. Changes to site conditions, unknown site conditions, and/or changes to design assumptions will impact the performance of the system, and may require additional equipment, changes to dewatering methods, and or changes in construction methods. All associated project cost and impact remains the customers responsibility. Rain for Rent will issue a Change Order to the Customer prior to providing additional equipment and/or labor. Customer retains all geotechnical responsibility associated with the project, including, but not limited to, any and all subsidence.

The recommendations contained herein were derived from calculations using published pump curves and information provided by customers, end users, project engineers, and/or other sources. Actual pump and system performance may vary. Any variations of the system's characteristics, including but not limited to, flow, suction lift, discharge distance, and/or submergence may require changes to the system(s). Any system recommendation changes may result in additional cost. In such cases, a change order will be required to proceed. All information contained herein or disclosed by this document is considered confidential and proprietary. Any disclosure, reproduction and/or distribution of this document in whole or in part without the written authorization from Rain for Rent's Engineering Department is prohibited. Please see your estimate and rental agreement for additional terms and conditions, these recommendations are incorporated as a part of those contractual documents.

Table 6.1 Summary of Analytical Models

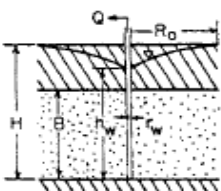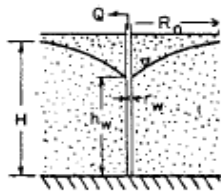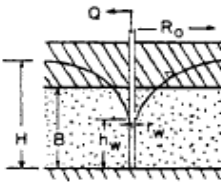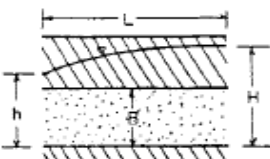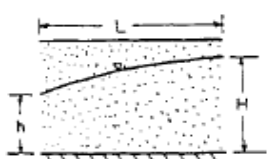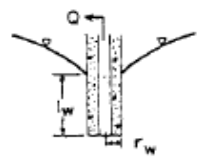Model	Basic equation	U.S. units ^a	Metric units ^b
 <p>Radial flow, confined aquifer</p>	$Q_w = \frac{2\pi KB(H - h_w)}{\ln R_o/r_w}$ <p>$K =$ hydraulic conductivity</p>	$Q_w = \frac{KB(H - h_w)}{229 \ln R_o/r_w}$	$Q_w = \frac{KB(H - h_w)}{2.65 \times 10^{-6} \ln R_o/r_w}$
 <p>Radial flow, water table aquifer</p>	$Q_w = \frac{\pi K(H^2 - h_w^2)}{\ln R_o/r_w}$ <p>$K =$ hydraulic conductivity</p>	$Q_w = \frac{K(H^2 - h_w^2)}{458 \ln R_o/r_w}$	$Q_w = \frac{K(H^2 - h_w^2)}{5.31 \times 10^{-6} \ln R_o/r_w}$
 <p>Radial flow, mixed aquifer</p>	$Q_w = \frac{\pi K(2BH - B^2 - h_w^2)}{\ln R_o/r_w}$ <p>$K =$ hydraulic conductivity</p>	$Q_w = \frac{K(2BH - B^2 - h_w^2)}{458 \ln R_o/r_w}$	$Q_w = \frac{K(2BH - B^2 - h_w^2)}{5.31 \times 10^{-6} \ln R_o/r_w}$
 <p>Confined flow from a line source to a drainage trench</p>	$\frac{Q}{x} = \frac{KB(H - h)}{L}$ <p>$x =$ unit length of trench, for flow from 2 sides, use twice the indicated value $K =$ hydraulic conductivity</p>	$\frac{Q}{x} = \frac{KB(H - h)}{1440L}$	$\frac{Q}{x} = \frac{KB(H - h)}{1.67 \times 10^{-5} L}$
 <p>Water table flow from a line source to a drainage trench</p>	$\frac{Q}{x} = \frac{K(H^2 - h^2)}{2L}$ <p>$x =$ unit length of trench, for flow from 2 sides, use twice the indicated value $K =$ hydraulic conductivity</p>	$\frac{Q}{x} = \frac{K(H^2 - h^2)}{2880L}$	$\frac{Q}{x} = \frac{K(H^2 - h^2)}{3.34 \times 10^{-5} L}$
 <p>Recommended flow per unit length of wet borehole (Sichart)</p>	$Q = 2\pi l_w r_w C \sqrt{K}$ <p>$C =$ empirical coefficient</p>	$Q_w = 0.035 l_w r_w \sqrt{K}$ <p>r_w in in. l_w in ft</p>	$Q_w = 24.91 l_w r_w \sqrt{K}$ <p>r_w in mm l_w in m</p>

^a Except where noted: Q in gpm; H, B, R_o, r_w in ft; K in gpd/ft²

^b Except where noted: Q in L/min; H, B, R_o, r_w in m; K in m/sec

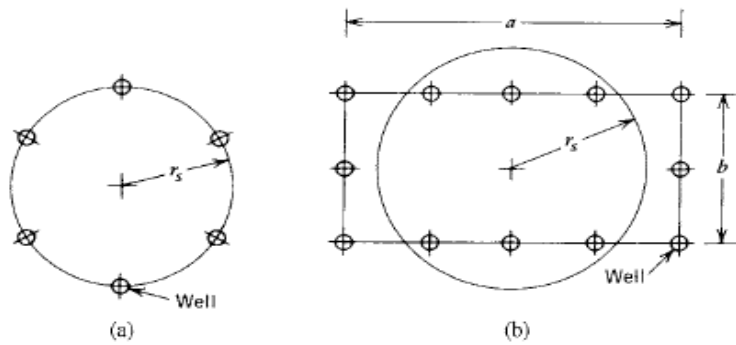


Figure 6.7 Approximation of equivalent radius r_s (a) Circular systems. (b) Rectangular systems.

$$r_s = \sqrt{\frac{ab}{\pi}} \quad (6.8)$$

Some analysts prefer to consider a rectangular system to act as a circular system with the same perimeter:

$$r_s = \frac{a + b}{\pi} \quad (6.9)$$

Either Eq. 6.8 or 6.9 gives reasonable approximations when the wells are spaced closely, when R_0 is great in relation to r_s , and when the ratio a/b is less than about 1.5. If the wells are widely spaced, the actual Q will be significantly higher than that estimated for the equivalent well.

ATTACHMENT D

Anthony Rossato

From: Little, Shauna <Little.Shauna@epa.gov> on behalf of Little, Shauna
Sent: Tuesday, May 12, 2020 1:04 PM
To: Anthony Rossato
Cc: Jacob Butterworth
Subject: RE: M948 - NOI Receiving Water Body Sampling

Yes, saltwater dilution is zero. The WQBELs will still be calculated to determine if they apply. It mostly depends on the concentrations in your influent and whether or not that exceeds the water quality criteria. If you have a copy of the excel spreadsheet, enter your data and the preliminary results are shown in the saltwater results tab. EPA checks those entries when confirming limits in your authorization, so please be sure to attach that excel file.

Regards,

Shauna Little
Physical Scientist
Water Division
U.S. EPA Region 1
Phone: (617) 918-1989

From: Anthony Rossato <arossato@sage-enviro.com>
Sent: Tuesday, May 12, 2020 12:54 PM
To: Little, Shauna <Little.Shauna@epa.gov>
Cc: Jacob Butterworth <jbutterworth@sage-enviro.com>
Subject: RE: M948 - NOI Receiving Water Body Sampling

Shauna,

We just received our source water laboratory data and are planning to utilize the previously discussed data for the receiving water. As the source water is proposed to be discharged to a saltwater body, am I correct in assuming that a dilution factor does not apply and that the TBEL will apply to our discharge?

Regards,
Anthony

From: Little, Shauna <Little.Shauna@epa.gov>
Sent: Tuesday, May 5, 2020 10:17 AM
To: Anthony Rossato <arossato@sage-enviro.com>
Cc: Jacob Butterworth <jbutterworth@sage-enviro.com>
Subject: RE: M948 - NOI Receiving Water Body Sampling

Yes, that's fine.

Regards,

Shauna Little
Physical Scientist
Water Division
U.S. EPA Region I
Phone: (617) 918-1989

From: Anthony Rossato <arossato@sage-enviro.com>
Sent: Tuesday, May 05, 2020 10:13 AM
To: Little, Shauna <Little.Shauna@epa.gov>
Cc: Jacob Butterworth <jbutterworth@sage-enviro.com>
Subject: M948 - NOI Receiving Water Body Sampling

Shauna,

We are currently working on a project which will require dewatering to a catch basin that discharges to an outfall on the Boston Inner Harbor and therefore will be preparing RGP documentation. We are collecting two groundwater samples from the source water today.

A NOI for a NPDES RGP, for a different project with the same receiving water body, was submitted to your department in August 2019. The receiving water body sampling, utilized in the August 2019 NOI, was conducted on June 24, 2019 and is analogous to the receiving water body for the outfall location in our application. Can we utilize the June 24, 2019 surface water data set in our NOI submittal? Please let me know if you have any questions. Thanks.

Regards,
Anthony



Anthony Rossato
Project Manager
Pawtucket / Taunton / Boston

O: (888) 723-9920 ext. 133
F: (401) 723-9973
C: (508) 282-2006
E: ARossato@Sage-Enviro.com
W: www.sage-enviro.com

NOTICE: This email is from SAGE Environmental, Inc. ("SAGE"), and is provided solely for the use of the individual(s) whom the sender intended to address. If you are not the intended recipient of this email, SAGE hereby instructs you: (i) to refrain from disseminating, distributing or copying the information contained in or attached to this message, (ii) to notify the sender immediately, and (iii) to destroy all copies of the original message and attachments. If you receive this email (and any attachments) under a non-disclosure or confidentiality agreement or other confidential relationship with SAGE, you must treat this email (and its attachments) in accordance with the terms and conditions of that relationship. Thank you.

ATTACHMENT E

Enter number values in green boxes below

Enter values in the units specified

↓	
0	Q _R = Enter upstream flow in MGD
0.288	Q _D = Enter discharge flow in MGD
0	Downstream 7Q10

Enter a dilution factor, if other than zero

↓
0

Enter values in the units specified

↓	
0	C _d = Enter influent hardness in mg/L CaCO₃
0	C _s = Enter receiving water hardness in mg/L CaCO₃

Enter **receiving water** concentrations in the units specified

↓	
6.72	pH in Standard Units
0	Temperature in °C
0.989	Ammonia in mg/L
595	Hardness in mg/L CaCO₃
5.72	Salinity in ppt
0	Antimony in µg/L
3.03	Arsenic in µg/L
0	Cadmium in µg/L
0	Chromium III in µg/L
0	Chromium VI in µg/L
5.22	Copper in µg/L
2780	Iron in µg/L
0	Lead in µg/L
0	Mercury in µg/L
2.18	Nickel in µg/L
0	Selenium in µg/L
0	Silver in µg/L
41.9	Zinc in µg/L

Enter **influent** concentrations in the units specified

↓	
0	TRC in µg/L
0.28	Ammonia in mg/L
0	Antimony in µg/L
0	Arsenic in µg/L
0	Cadmium in µg/L
0	Chromium III in µg/L
0	Chromium VI in µg/L
0	Copper in µg/L
128	Iron in µg/L
0	Lead in µg/L
0	Mercury in µg/L
0	Nickel in µg/L
0	Selenium in µg/L
0	Silver in µg/L
5.8	Zinc in µg/L
0	Cyanide in µg/L
0	Phenol in µg/L
0	Carbon Tetrachloride in µg/L
0	Tetrachloroethylene in µg/L
0	Total Phthalates in µg/L
0	Diethylhexylphthalate in µg/L
0	Benzo(a)anthracene in µg/L
0	Benzo(a)pyrene in µg/L
0	Benzo(b)fluoranthene in µg/L
0	Benzo(k)fluoranthene in µg/L
0	Chrysene in µg/L
0	Dibenzo(a,h)anthracene in µg/L
0	Indeno(1,2,3-cd)pyrene in µg/L
0.6	Methyl-tert butyl ether in µg/L

Notes:

Freshwater: Q_R equal to the 7Q10; enter alternate Q_R if approved by the State; enter 0 if no dilution factor approved

Saltwater (estuarine and marine): enter Q_R if approved by the State; enter 0 if no entry

Discharge flow is equal to the design flow or 1 MGD, whichever is less

Only if approved by State as the entry for Q_R; leave 0 if no entry

Saltwater (estuarine and marine): only if approved by the State

Leave 0 if no entry

Freshwater only

pH, temperature, and ammonia required for all discharges

Hardness required for freshwater

Salinity required for saltwater (estuarine and marine)

Metals required for all discharges if present and if dilution factor is > 1

Enter 0 if non-detect or testing not required

if >1 sample, enter maximum

if >10 samples, may enter 95th percentile

Enter 0 if non-detect or testing not required

Dilution Factor	0.0				Compliance Level	
	TBEL applies if bolded		WQBEL applies if bolded		applies if shown	
A. Inorganics						
Ammonia	Report	mg/L	---			
Chloride	Report	µg/L	---			
Total Residual Chlorine	0.2	mg/L	7.5	µg/L	50	µg/L
Total Suspended Solids	30	mg/L	---			
Antimony	206	µg/L	640	µg/L		
Arsenic	104	µg/L	36	µg/L		
Cadmium	10.2	µg/L	8.9	µg/L		
Chromium III	323	µg/L	100.0	µg/L		
Chromium VI	323	µg/L	50	µg/L		
Copper	242	µg/L	3.7	µg/L		
Iron	5000	µg/L	---	µg/L		
Lead	160	µg/L	8.5	µg/L		
Mercury	0.739	µg/L	1.11	µg/L		
Nickel	1450	µg/L	8.3	µg/L		
Selenium	235.8	µg/L	71	µg/L		
Silver	35.1	µg/L	2.2	µg/L		
Zinc	420	µg/L	86	µg/L		
Cyanide	178	mg/L	1.0	µg/L	---	µg/L
B. Non-Halogenated VOCs						
Total BTEX	100	µg/L	---			
Benzene	5.0	µg/L	---			
1,4 Dioxane	200	µg/L	---			
Acetone	7.97	mg/L	---			
Phenol	1,080	µg/L	300	µg/L		
C. Halogenated VOCs						
Carbon Tetrachloride	4.4		1.6	µg/L		
1,2 Dichlorobenzene	600	µg/L	---			
1,3 Dichlorobenzene	320	µg/L	---			
1,4 Dichlorobenzene	5.0	µg/L	---			
Total dichlorobenzene	---	µg/L	---			
1,1 Dichloroethane	70	µg/L	---			
1,2 Dichloroethane	5.0	µg/L	---			
1,1 Dichloroethylene	3.2	µg/L	---			
Ethylene Dibromide	0.05	µg/L	---			
Methylene Chloride	4.6	µg/L	---			
1,1,1 Trichloroethane	200	µg/L	---			
1,1,2 Trichloroethane	5.0	µg/L	---			
Trichloroethylene	5.0	µg/L	---			
Tetrachloroethylene	5.0	µg/L	3.3	µg/L		
cis-1,2 Dichloroethylene	70	µg/L	---			
Vinyl Chloride	2.0	µg/L	---			
D. Non-Halogenated SVOCs						
Total Phthalates	190	µg/L	---	µg/L		
Diethylhexyl phthalate	101	µg/L	2.2	µg/L		
Total Group I Polycyclic Aromatic Hydrocarbons	1.0	µg/L	---			
Benzo(a)anthracene	1.0	µg/L	0.0038	µg/L	---	µg/L
Benzo(a)pyrene	1.0	µg/L	0.0038	µg/L	---	µg/L
Benzo(b)fluoranthene	1.0	µg/L	0.0038	µg/L	---	µg/L
Benzo(k)fluoranthene	1.0	µg/L	0.0038	µg/L	---	µg/L
Chrysene	1.0	µg/L	0.0038	µg/L	---	µg/L
Dibenzo(a,h)anthracene	1.0	µg/L	0.0038	µg/L	---	µg/L
Indeno(1,2,3-cd)pyrene	1.0	µg/L	0.0038	µg/L	---	µg/L
Total Group II Polycyclic Aromatic Hydrocarbons	100	µg/L	---			
Naphthalene	20	µg/L	---			
E. Halogenated SVOCs						
Total Polychlorinated Biphenyls	0.000064	µg/L	---		0.5	µg/L
Pentachlorophenol	1.0	µg/L	---			
F. Fuels Parameters						
Total Petroleum Hydrocarbons	5.0	mg/L	---			
Ethanol	Report	mg/L	---			
Methyl-tert-Butyl Ether	70	µg/L	20	µg/L		
tert-Butyl Alcohol	120	µg/L	---			
tert-Amyl Methyl Ether	90	µg/L	---			

ATTACHMENT F



CERTIFICATE OF ANALYSIS

Jacob Butterworth
Sage Environmental, Inc.
172 Armistice Boulevard
Pawtucket, RI 02860

RE: Logan - Bond (M948)
ESS Laboratory Work Order Number: 20E0082

This signed Certificate of Analysis is our approved release of your analytical results. These results are only representative of sample aliquots received at the laboratory. ESS Laboratory expects its clients to follow all regulatory sampling guidelines. Beginning with this page, the entire report has been paginated. This report should not be copied except in full without the approval of the laboratory. Samples will be disposed of thirty days after the final report has been delivered. If you have any questions or concerns, please feel free to call our Customer Service Department.

Laurel Stoddard
Laboratory Director

REVIEWED

By ESS Laboratory at 2:22 pm, May 14, 2020

Analytical Summary

The project as described above has been analyzed in accordance with the ESS Quality Assurance Plan. This plan utilizes the following methodologies: US EPA SW-846, US EPA Methods for Chemical Analysis of Water and Wastes per 40 CFR Part 136, APHA Standard Methods for the Examination of Water and Wastewater, American Society for Testing and Materials (ASTM), and other recognized methodologies. The analyses with these noted observations are in conformance to the Quality Assurance Plan. In chromatographic analysis, manual integration is frequently used instead of automated integration because it produces more accurate results.

The test results present in this report are in compliance with TNI and relative state standards, and/or client Quality Assurance Project Plans (QAPP). The laboratory has reviewed the following: Sample Preservations, Hold Times, Initial Calibrations, Continuing Calibrations, Method Blanks, Blank Spikes, Blank Spike Duplicates, Duplicates, Matrix Spikes, Matrix Spike Duplicates, Surrogates and Internal Standards. Any results which were found to be outside of the recommended ranges stated in our SOPs will be noted in the Project Narrative.



CERTIFICATE OF ANALYSIS

Client Name: Sage Environmental, Inc.
Client Project ID: Logan - Bond

ESS Laboratory Work Order: 20E0082

SAMPLE RECEIPT

The following samples were received on May 05, 2020 for the analyses specified on the enclosed Chain of Custody Record.

The samples and analyses listed below were analyzed in accordance with the 2017 Remediation General Permit under the National Pollutant Discharge Elimination System (NPDES).

ESS Laboratory is unable to achieve the required detection limit of 0.4 mg/L for Ethanol for the RGP permit. We have also been unable to procure a subcontract laboratory that is able to achieve this limit. The data for Ethanol has been reported using our current method reporting limit.

Revision 1 May 14, 2020: This report has been revised to split samples 20E0082-01 and 20E0082-02 into separate reports per the client's request.

<u>Lab Number</u>	<u>Sample Name</u>	<u>Matrix</u>	<u>Analysis</u>
20E0082-02	UNK-101	Ground Water	1664A, 200.7, 200.8, 245.1, 2540D, 300.0, 3113B, 350.1, 3500Cr B-2009, 420.1, 4500 CN CE, 4500Cl D, 504.1, 524.2, 608.3, 625.1 SIM, 8270D SIM, ASTM D3695, CALC



CERTIFICATE OF ANALYSIS

Client Name: Sage Environmental, Inc.
Client Project ID: Logan - Bond

ESS Laboratory Work Order: 20E0082

PROJECT NARRATIVE

524.2 Volatile Organic Compounds

DE00618-BS1 **Blank Spike recovery is above upper control limit (B+).**
Methyl tert-Butyl Ether (131% @ 70-130%)

625.1(SIM) Semi-Volatile Organic Compounds

20E0082-02 **Surrogate recovery(ies) above upper control limit (S+).**
2,4,6-Tribromophenol (128% @ 15-110%)

D0E0085-CCV1 **Continuing Calibration %Diff/Drift is above control limit (CD+).**
2,4,6-Tribromophenol (60% @ 20%), Di-n-octylphthalate (24% @ 20%)

DE00602-BSD1 **Relative percent difference for duplicate is outside of criteria (D+).**
Benzo(a)pyrene (24% @ 20%), Benzo(b)fluoranthene (22% @ 20%), Benzo(g,h,i)perylene (21% @ 20%),
Benzo(k)fluoranthene (23% @ 20%), Dibenzo(a,h)Anthracene (22% @ 20%), Di-n-octylphthalate (23%
@ 20%), Indeno(1,2,3-cd)Pyrene (28% @ 20%)

Classical Chemistry

20E0082-02 **The maximum holding time listed in 40 CFR Part 136 Table II for pH, Dissolved Oxygen, Sulfite and Residual Chlorine is fifteen minutes.**

No other observations noted.

End of Project Narrative.

DATA USABILITY LINKS

To ensure you are viewing the most current version of the documents below, please clear your internet cookies for www.ESSLaboratory.com. Consult your IT Support personnel for information on how to clear your internet cookies.

[Definitions of Quality Control Parameters](#)

[Semivolatile Organics Internal Standard Information](#)

[Semivolatile Organics Surrogate Information](#)

[Volatile Organics Internal Standard Information](#)

[Volatile Organics Surrogate Information](#)

[EPH and VPH Alkane Lists](#)



CERTIFICATE OF ANALYSIS

Client Name: Sage Environmental, Inc.
Client Project ID: Logan - Bond

ESS Laboratory Work Order: 20E0082

CURRENT SW-846 METHODOLOGY VERSIONS

Analytical Methods

- 1010A - Flashpoint
- 6010C - ICP
- 6020A - ICP MS
- 7010 - Graphite Furnace
- 7196A - Hexavalent Chromium
- 7470A - Aqueous Mercury
- 7471B - Solid Mercury
- 8011 - EDB/DBCP/TCP
- 8015C - GRO/DRO
- 8081B - Pesticides
- 8082A - PCB
- 8100M - TPH
- 8151A - Herbicides
- 8260B - VOA
- 8270D - SVOA
- 8270D SIM - SVOA Low Level
- 9014 - Cyanide
- 9038 - Sulfate
- 9040C - Aqueous pH
- 9045D - Solid pH (Corrosivity)
- 9050A - Specific Conductance
- 9056A - Anions (IC)
- 9060A - TOC
- 9095B - Paint Filter
- MADEP 04-1.1 - EPH
- MADEP 18-2.1 - VPH

Prep Methods

- 3005A - Aqueous ICP Digestion
- 3020A - Aqueous Graphite Furnace / ICP MS Digestion
- 3050B - Solid ICP / Graphite Furnace / ICP MS Digestion
- 3060A - Solid Hexavalent Chromium Digestion
- 3510C - Separatory Funnel Extraction
- 3520C - Liquid / Liquid Extraction
- 3540C - Manual Soxhlet Extraction
- 3541 - Automated Soxhlet Extraction
- 3546 - Microwave Extraction
- 3580A - Waste Dilution
- 5030B - Aqueous Purge and Trap
- 5030C - Aqueous Purge and Trap
- 5035A - Solid Purge and Trap

SW846 Reactivity Methods 7.3.3.2 (Reactive Cyanide) and 7.3.4.1 (Reactive Sulfide) have been withdrawn by EPA. These methods are reported per client request and are not NELAP accredited.



CERTIFICATE OF ANALYSIS

Client Name: Sage Environmental, Inc.
Client Project ID: Logan - Bond
Client Sample ID: UNK-101
Date Sampled: 05/05/20 11:45
Percent Solids: N/A

ESS Laboratory Work Order: 20E0082
ESS Laboratory Sample ID: 20E0082-02
Sample Matrix: Ground Water
Units: ug/L

Extraction Method: 3005A/200.7

Total Metals

<u>Analyte</u>	<u>Results (MRL)</u>	<u>MDL</u>	<u>Method</u>	<u>Limit</u>	<u>DF</u>	<u>Analyst</u>	<u>Analyzed</u>	<u>I/V</u>	<u>F/V</u>	<u>Batch</u>
Antimony	ND (10.0)		200.7		1	KJK	05/07/20 18:04	100	10	DE00527
Arsenic	ND (2.5)		3113B		5	KJK	05/06/20 19:04	100	10	DE00527
Cadmium	ND (0.5)		200.8		5	KJK	05/06/20 14:31	100	10	DE00527
Chromium	ND (2.0)		200.7		1	KJK	05/07/20 18:04	100	10	DE00527
Chromium III	ND (10.0)		200.7		1	CCP	05/07/20 18:04	1	1	[CALC]
Copper	ND (2.0)		200.7		1	KJK	05/07/20 18:04	100	10	DE00527
Iron	128 (10.0)		200.7		1	KJK	05/07/20 18:04	100	10	DE00527
Lead	ND (2.0)		200.7		1	KJK	05/07/20 18:04	100	10	DE00527
Mercury	ND (0.2)		245.1		1	MKS	05/06/20 10:00	20	40	DE00529
Nickel	ND (5.0)		200.7		1	KJK	05/07/20 18:04	100	10	DE00527
Selenium	ND (5.0)		3113B		5	KJK	05/06/20 23:01	100	10	DE00527
Silver	ND (1.0)		200.7		1	KJK	05/07/20 18:04	100	10	DE00527
Total Hardness	131000 (499)		CALC		10	KJK	05/07/20 18:24	1	1	[CALC]
Zinc	5.8 (5.0)		200.7		1	KJK	05/07/20 18:04	100	10	DE00527



CERTIFICATE OF ANALYSIS

Client Name: Sage Environmental, Inc.
Client Project ID: Logan - Bond
Client Sample ID: UNK-101
Date Sampled: 05/05/20 11:45
Percent Solids: N/A
Initial Volume: 25
Final Volume: 25
Extraction Method: 524.2

ESS Laboratory Work Order: 20E0082
ESS Laboratory Sample ID: 20E0082-02
Sample Matrix: Ground Water
Units: ug/L
Analyst: MD

524.2 Volatile Organic Compounds

<u>Analyte</u>	<u>Results (MRL)</u>	<u>MDL</u>	<u>Method</u>	<u>Limit</u>	<u>DF</u>	<u>Analyzed</u>	<u>Sequence</u>	<u>Batch</u>
1,1,1-Trichloroethane	ND (0.5)		524.2		1	05/06/20 16:43	D0E0081	DE00618
1,1,2-Trichloroethane	ND (0.5)		524.2		1	05/06/20 16:43	D0E0081	DE00618
1,1-Dichloroethane	ND (0.5)		524.2		1	05/06/20 16:43	D0E0081	DE00618
1,1-Dichloroethene	ND (0.5)		524.2		1	05/06/20 16:43	D0E0081	DE00618
1,2-Dichlorobenzene	ND (0.5)		524.2		1	05/06/20 16:43	D0E0081	DE00618
1,2-Dichloroethane	ND (0.5)		524.2		1	05/06/20 16:43	D0E0081	DE00618
1,3-Dichlorobenzene	ND (0.5)		524.2		1	05/06/20 16:43	D0E0081	DE00618
1,4-Dichlorobenzene	ND (0.5)		524.2		1	05/06/20 16:43	D0E0081	DE00618
Acetone	ND (5.0)		524.2		1	05/06/20 16:43	D0E0081	DE00618
Benzene	ND (0.5)		524.2		1	05/06/20 16:43	D0E0081	DE00618
Carbon Tetrachloride	ND (0.3)		524.2		1	05/06/20 16:43	D0E0081	DE00618
cis-1,2-Dichloroethene	ND (0.5)		524.2		1	05/06/20 16:43	D0E0081	DE00618
Ethylbenzene	ND (0.5)		524.2		1	05/06/20 16:43	D0E0081	DE00618
Methyl tert-Butyl Ether	0.6 (0.5)		524.2		1	05/06/20 16:43	D0E0081	DE00618
Methylene Chloride	ND (0.5)		524.2		1	05/06/20 16:43	D0E0081	DE00618
Naphthalene	ND (0.5)		524.2		1	05/06/20 16:43	D0E0081	DE00618
Tertiary-amyl methyl ether	ND (1.0)		524.2		1	05/06/20 16:43	D0E0081	DE00618
Tertiary-butyl Alcohol	ND (25.0)		524.2		1	05/06/20 16:43	D0E0081	DE00618
Tetrachloroethene	ND (0.5)		524.2		1	05/06/20 16:43	D0E0081	DE00618
Toluene	ND (0.5)		524.2		1	05/06/20 16:43	D0E0081	DE00618
Trichloroethene	ND (0.5)		524.2		1	05/06/20 16:43	D0E0081	DE00618
Vinyl Chloride	ND (0.2)		524.2		1	05/06/20 16:43	D0E0081	DE00618
Xylene O	ND (0.5)		524.2		1	05/06/20 16:43	D0E0081	DE00618
Xylene P,M	ND (0.5)		524.2		1	05/06/20 16:43	D0E0081	DE00618

	<i>%Recovery</i>	<i>Qualifier</i>	<i>Limits</i>
<i>Surrogate: 1,2-Dichlorobenzene-d4</i>	94 %		80-120
<i>Surrogate: 4-Bromofluorobenzene</i>	94 %		80-120



CERTIFICATE OF ANALYSIS

Client Name: Sage Environmental, Inc.
Client Project ID: Logan - Bond
Client Sample ID: UNK-101
Date Sampled: 05/05/20 11:45
Percent Solids: N/A
Initial Volume: 1070
Final Volume: 1
Extraction Method: 3510C

ESS Laboratory Work Order: 20E0082
ESS Laboratory Sample ID: 20E0082-02
Sample Matrix: Ground Water
Units: ug/L
Analyst: DMC
Prepared: 5/7/20 12:42

608.3 Polychlorinated Biphenyls (PCB)

<u>Analyte</u>	<u>Results (MRL)</u>	<u>MDL</u>	<u>Method</u>	<u>Limit</u>	<u>DF</u>	<u>Analyzed</u>	<u>Sequence</u>	<u>Batch</u>
Aroclor 1016	ND (0.09)		608.3		1	05/07/20 19:03		DE00708
Aroclor 1221	ND (0.09)		608.3		1	05/07/20 19:03		DE00708
Aroclor 1232	ND (0.09)		608.3		1	05/07/20 19:03		DE00708
Aroclor 1242	ND (0.09)		608.3		1	05/07/20 19:03		DE00708
Aroclor 1248	ND (0.09)		608.3		1	05/07/20 19:03		DE00708
Aroclor 1254	ND (0.09)		608.3		1	05/07/20 19:03		DE00708
Aroclor 1260	ND (0.09)		608.3		1	05/07/20 19:03		DE00708
Aroclor 1262	ND (0.09)		608.3		1	05/07/20 19:03		DE00708
Aroclor 1268	ND (0.09)		608.3		1	05/07/20 19:03		DE00708

	<i>%Recovery</i>	<i>Qualifier</i>	<i>Limits</i>
<i>Surrogate: Decachlorobiphenyl</i>	78 %		30-150
<i>Surrogate: Decachlorobiphenyl [2C]</i>	77 %		30-150
<i>Surrogate: Tetrachloro-m-xylene</i>	77 %		30-150
<i>Surrogate: Tetrachloro-m-xylene [2C]</i>	89 %		30-150



CERTIFICATE OF ANALYSIS

Client Name: Sage Environmental, Inc.
Client Project ID: Logan - Bond
Client Sample ID: UNK-101
Date Sampled: 05/05/20 11:45
Percent Solids: N/A
Initial Volume: 1070
Final Volume: 0.25
Extraction Method: 3510C

ESS Laboratory Work Order: 20E0082
ESS Laboratory Sample ID: 20E0082-02
Sample Matrix: Ground Water
Units: ug/L
Analyst: VSC
Prepared: 5/6/20 17:06

625.1(SIM) Semi-Volatile Organic Compounds

<u>Analyte</u>	<u>Results (MRL)</u>	<u>MDL</u>	<u>Method</u>	<u>Limit</u>	<u>DF</u>	<u>Analyzed</u>	<u>Sequence</u>	<u>Batch</u>
Acenaphthene	ND (0.19)		625.1 SIM		1	05/06/20 22:27	D0E0085	DE00602
Acenaphthylene	ND (0.19)		625.1 SIM		1	05/06/20 22:27	D0E0085	DE00602
Anthracene	ND (0.19)		625.1 SIM		1	05/06/20 22:27	D0E0085	DE00602
Benzo(a)anthracene	ND (0.05)		625.1 SIM		1	05/06/20 22:27	D0E0085	DE00602
Benzo(a)pyrene	ND (0.05)		625.1 SIM		1	05/06/20 22:27	D0E0085	DE00602
Benzo(b)fluoranthene	ND (0.05)		625.1 SIM		1	05/06/20 22:27	D0E0085	DE00602
Benzo(g,h,i)perylene	ND (0.19)		625.1 SIM		1	05/06/20 22:27	D0E0085	DE00602
Benzo(k)fluoranthene	ND (0.05)		625.1 SIM		1	05/06/20 22:27	D0E0085	DE00602
bis(2-Ethylhexyl)phthalate	ND (2.34)		625.1 SIM		1	05/06/20 22:27	D0E0085	DE00602
Butylbenzylphthalate	ND (2.34)		625.1 SIM		1	05/06/20 22:27	D0E0085	DE00602
Chrysene	ND (0.05)		625.1 SIM		1	05/06/20 22:27	D0E0085	DE00602
Dibenzo(a,h)Anthracene	ND (0.05)		625.1 SIM		1	05/06/20 22:27	D0E0085	DE00602
Diethylphthalate	ND (2.34)		625.1 SIM		1	05/06/20 22:27	D0E0085	DE00602
Dimethylphthalate	ND (2.34)		625.1 SIM		1	05/06/20 22:27	D0E0085	DE00602
Di-n-butylphthalate	ND (2.34)		625.1 SIM		1	05/06/20 22:27	D0E0085	DE00602
Di-n-octylphthalate	ND (2.34)		625.1 SIM		1	05/06/20 22:27	D0E0085	DE00602
Fluoranthene	ND (0.19)		625.1 SIM		1	05/06/20 22:27	D0E0085	DE00602
Fluorene	ND (0.19)		625.1 SIM		1	05/06/20 22:27	D0E0085	DE00602
Indeno(1,2,3-cd)Pyrene	ND (0.05)		625.1 SIM		1	05/06/20 22:27	D0E0085	DE00602
Naphthalene	ND (0.19)		625.1 SIM		1	05/06/20 22:27	D0E0085	DE00602
Pentachlorophenol	ND (0.84)		625.1 SIM		1	05/06/20 22:27	D0E0085	DE00602
Phenanthrene	ND (0.19)		625.1 SIM		1	05/06/20 22:27	D0E0085	DE00602
Pyrene	ND (0.19)		625.1 SIM		1	05/06/20 22:27	D0E0085	DE00602

	<i>%Recovery</i>	<i>Qualifier</i>	<i>Limits</i>
<i>Surrogate: 1,2-Dichlorobenzene-d4</i>	59 %		30-130
<i>Surrogate: 2,4,6-Tribromophenol</i>	128 %	S+	15-110
<i>Surrogate: 2-Fluorobiphenyl</i>	77 %		30-130
<i>Surrogate: Nitrobenzene-d5</i>	92 %		30-130
<i>Surrogate: p-Terphenyl-d14</i>	111 %		30-130



CERTIFICATE OF ANALYSIS

Client Name: Sage Environmental, Inc.
Client Project ID: Logan - Bond
Client Sample ID: UNK-101
Date Sampled: 05/05/20 11:45
Percent Solids: N/A
Initial Volume: 500
Final Volume: 0.5
Extraction Method: 3535A

ESS Laboratory Work Order: 20E0082
ESS Laboratory Sample ID: 20E0082-02
Sample Matrix: Ground Water
Units: ug/L
Analyst: VSC
Prepared: 5/6/20 15:45

8270D(SIM) Semi-Volatile Organic Compounds w/ Isotope Dilution

<u>Analyte</u>	<u>Results (MRL)</u>	<u>MDL</u>	<u>Method</u>	<u>Limit</u>	<u>DF</u>	<u>Analyzed</u>	<u>Sequence</u>	<u>Batch</u>
1,4-Dioxane	ND (0.250)		8270D SIM		1	05/07/20 3:56	D0E0092	DE00633
		<i>%Recovery</i>	<i>Qualifier</i>	<i>Limits</i>				
<i>Surrogate: 1,4-Dioxane-d8</i>		<i>86 %</i>		<i>15-115</i>				



CERTIFICATE OF ANALYSIS

Client Name: Sage Environmental, Inc.
Client Project ID: Logan - Bond
Client Sample ID: UNK-101
Date Sampled: 05/05/20 11:45
Percent Solids: N/A

ESS Laboratory Work Order: 20E0082
ESS Laboratory Sample ID: 20E0082-02
Sample Matrix: Ground Water

Classical Chemistry

<u>Analyte</u>	<u>Results (MRL)</u>	<u>MDL</u>	<u>Method</u>	<u>Limit</u>	<u>DF</u>	<u>Analyst</u>	<u>Analyzed</u>	<u>Units</u>	<u>Batch</u>
Ammonia as N	0.28 (0.10)		350.1		1	JLK	05/07/20 16:17	mg/L	DE00631
Chloride	61.3 (5.0)		300.0		10	EEM	05/06/20 16:46	mg/L	DE00615
Hexavalent Chromium	ND (10.0)		3500Cr B-2009		1	CCP	05/05/20 19:36	ug/L	DE00519
Phenols	ND (50)		420.1		1	EEM	05/07/20 14:00	ug/L	DE00719
Total Cyanide	ND (5.00)		4500 CN CE		1	EEM	05/07/20 11:30	ug/L	DE00717
Total Petroleum Hydrocarbon	ND (5)		1664A		1	LAB	05/07/20 14:10	mg/L	DE00609
Total Residual Chlorine	ND (20.0)		4500Cl D		1	CCP	05/05/20 18:08	ug/L	DE00518
Total Suspended Solids	ND (5)		2540D		1	CCP	05/05/20 18:19	mg/L	DE00514



CERTIFICATE OF ANALYSIS

Client Name: Sage Environmental, Inc.
Client Project ID: Logan - Bond
Client Sample ID: UNK-101
Date Sampled: 05/05/20 11:45
Percent Solids: N/A
Initial Volume: 35
Final Volume: 2
Extraction Method: 504/8011

ESS Laboratory Work Order: 20E0082
ESS Laboratory Sample ID: 20E0082-02
Sample Matrix: Ground Water
Units: ug/L
Analyst: CAD
Prepared: 5/7/20 7:00

504.1 1,2-Dibromoethane / 1,2-Dibromo-3-chloropropane

<u>Analyte</u>	<u>Results (MRL)</u>	<u>MDL</u>	<u>Method</u>	<u>Limit</u>	<u>DF</u>	<u>Analyzed</u>	<u>Sequence</u>	<u>Batch</u>
1,2-Dibromo-3-Chloropropane	ND (0.015)		504.1		1	05/07/20 10:58		DE00722
1,2-Dibromoethane	ND (0.015)		504.1		1	05/07/20 10:58		DE00722

	<i>%Recovery</i>	<i>Qualifier</i>	<i>Limits</i>
<i>Surrogate: Pentachloroethane</i>	<i>99 %</i>		<i>30-150</i>
<i>Surrogate: Pentachloroethane [2C]</i>	<i>98 %</i>		<i>30-150</i>



CERTIFICATE OF ANALYSIS

Client Name: Sage Environmental, Inc.
Client Project ID: Logan - Bond
Client Sample ID: UNK-101
Date Sampled: 05/05/20 11:45
Percent Solids: N/A
Initial Volume: 1
Final Volume: 1
Extraction Method: No Prep

ESS Laboratory Work Order: 20E0082
ESS Laboratory Sample ID: 20E0082-02
Sample Matrix: Ground Water
Units: mg/L
Analyst: VSC
Prepared: 5/6/20 7:30

Alcohol Scan by GC/FID

<u>Analyte</u>	<u>Results (MRL)</u>	<u>MDL</u>	<u>Method</u>	<u>Limit</u>	<u>DF</u>	<u>Analyst</u>	<u>Analyzed</u>	<u>Sequence</u>	<u>Batch</u>
Ethanol	ND (10)		ASTM D3695		1	VSC	05/06/20 12:38		DE00614



CERTIFICATE OF ANALYSIS

Client Name: Sage Environmental, Inc.
Client Project ID: Logan - Bond

ESS Laboratory Work Order: 20E0082

Quality Control Data

Analyte	Result	MRL	Units	Spike Level	Source Result	%REC	%REC Limits	RPD	RPD Limit	Qualifier
---------	--------	-----	-------	-------------	---------------	------	-------------	-----	-----------	-----------

Total Metals

Batch DE00527 - 3005A/200.7

Blank

Antimony	ND	10.0	ug/L							
Calcium	ND	0.020	mg/L							
Chromium	ND	2.0	ug/L							
Copper	ND	2.0	ug/L							
Iron	ND	10.0	ug/L							
Lead	ND	2.0	ug/L							
Magnesium	ND	0.020	mg/L							
Nickel	ND	5.0	ug/L							
Silver	ND	1.0	ug/L							
Zinc	ND	5.0	ug/L							

Blank

Cadmium	ND	0.5	ug/L							
---------	----	-----	------	--	--	--	--	--	--	--

Blank

Arsenic	ND	0.5	ug/L							
Selenium	ND	1.0	ug/L							

LCS

Antimony	52.1	10.0	ug/L	50.00	104	85-115				
Chromium	48.8	2.0	ug/L	50.00	98	85-115				
Copper	50.7	2.0	ug/L	50.00	101	85-115				
Iron	251	10.0	ug/L	250.0	100	85-115				
Lead	51.9	2.0	ug/L	50.00	104	85-115				
Nickel	50.6	5.0	ug/L	50.00	101	85-115				
Silver	24.5	1.0	ug/L	25.00	98	85-115				
Zinc	51.4	5.0	ug/L	50.00	103	85-115				

LCS

Arsenic	47.2	12.5	ug/L	50.00	94	85-115				
Selenium	88.7	25.0	ug/L	100.0	89	85-115				

LCS Dup

Silver	25.3	1.0	ug/L	25.00	101	85-115	3	20		
--------	------	-----	------	-------	-----	--------	---	----	--	--

LCS Dup

Cadmium	22.5	2.5	ug/L	25.00	90	85-115	5	20		
---------	------	-----	------	-------	----	--------	---	----	--	--

Batch DE00529 - 245.1/7470A

Blank

Mercury	ND	0.2	ug/L							
---------	----	-----	------	--	--	--	--	--	--	--

LCS

Mercury	5.3	0.2	ug/L	6.042	87	85-115				
---------	-----	-----	------	-------	----	--------	--	--	--	--

LCS Dup

Mercury	5.5	0.2	ug/L	6.042	92	85-115	5	20		
---------	-----	-----	------	-------	----	--------	---	----	--	--

524.2 Volatile Organic Compounds

Batch DE00618 - 524.2



CERTIFICATE OF ANALYSIS

Client Name: Sage Environmental, Inc.
Client Project ID: Logan - Bond

ESS Laboratory Work Order: 20E0082

Quality Control Data

Analyte	Result	MRL	Units	Spike Level	Source Result	%REC	%REC Limits	RPD	RPD Limit	Qualifier
---------	--------	-----	-------	-------------	---------------	------	-------------	-----	-----------	-----------

524.2 Volatile Organic Compounds

Batch DE00618 - 524.2

Blank

1,1,1-Trichloroethane	ND	0.5	ug/L							
1,1,2-Trichloroethane	ND	0.5	ug/L							
1,1-Dichloroethane	ND	0.5	ug/L							
1,1-Dichloroethene	ND	0.5	ug/L							
1,2-Dichlorobenzene	ND	0.5	ug/L							
1,2-Dichloroethane	ND	0.5	ug/L							
1,3-Dichlorobenzene	ND	0.5	ug/L							
1,4-Dichlorobenzene	ND	0.5	ug/L							
Acetone	ND	5.0	ug/L							
Benzene	ND	0.5	ug/L							
Carbon Tetrachloride	ND	0.3	ug/L							
cis-1,2-Dichloroethene	ND	0.5	ug/L							
Ethylbenzene	ND	0.5	ug/L							
Methyl tert-Butyl Ether	ND	0.5	ug/L							
Methylene Chloride	ND	0.5	ug/L							
Naphthalene	ND	0.5	ug/L							
Tertiary-amyl methyl ether	ND	1.0	ug/L							
Tertiary-butyl Alcohol	ND	25.0	ug/L							
Tetrachloroethene	ND	0.5	ug/L							
Toluene	ND	0.5	ug/L							
Trichloroethene	ND	0.5	ug/L							
Vinyl Chloride	ND	0.2	ug/L							
Xylene O	ND	0.5	ug/L							
Xylene P,M	ND	0.5	ug/L							
Surrogate: 1,2-Dichlorobenzene-d4	4.99		ug/L	5.000		100	80-120			
Surrogate: 4-Bromofluorobenzene	4.83		ug/L	5.000		97	80-120			

LCS

1,1,1-Trichloroethane	9.3	0.5	ug/L	10.00		93	70-130			
1,1,2-Trichloroethane	11.9	0.5	ug/L	10.00		119	70-130			
1,1-Dichloroethane	12.6	0.5	ug/L	10.00		126	70-130			
1,1-Dichloroethene	10.1	0.5	ug/L	10.00		101	70-130			
1,2-Dichlorobenzene	10.9	0.5	ug/L	10.00		109	70-130			
1,2-Dichloroethane	11.3	0.5	ug/L	10.00		113	70-130			
1,3-Dichlorobenzene	10.6	0.5	ug/L	10.00		106	70-130			
1,4-Dichlorobenzene	10.3	0.5	ug/L	10.00		103	70-130			
Acetone	52.8	5.0	ug/L	50.00		106	70-130			
Benzene	12.3	0.5	ug/L	10.00		123	70-130			
Carbon Tetrachloride	10.2	0.3	ug/L	10.00		102	70-130			
cis-1,2-Dichloroethene	11.2	0.5	ug/L	10.00		112	70-130			
Ethylbenzene	10.4	0.5	ug/L	10.00		104	70-130			
Methyl tert-Butyl Ether	13.1	0.5	ug/L	10.00		131	70-130			B+
Methylene Chloride	11.1	0.5	ug/L	10.00		111	70-130			
Naphthalene	10.9	0.5	ug/L	10.00		109	70-130			
Tertiary-amyl methyl ether	11.6	1.0	ug/L	10.00		116	70-130			



CERTIFICATE OF ANALYSIS

Client Name: Sage Environmental, Inc.
Client Project ID: Logan - Bond

ESS Laboratory Work Order: 20E0082

Quality Control Data

Analyte	Result	MRL	Units	Spike Level	Source Result	%REC	%REC Limits	RPD	RPD Limit	Qualifier
---------	--------	-----	-------	-------------	---------------	------	-------------	-----	-----------	-----------

524.2 Volatile Organic Compounds

Batch DE00618 - 524.2

Tertiary-butyl Alcohol	53.9	25.0	ug/L	50.00		108	70-130			
Tetrachloroethene	10.1	0.5	ug/L	10.00		101	70-130			
Toluene	10.8	0.5	ug/L	10.00		108	70-130			
Trichloroethene	10.9	0.5	ug/L	10.00		109	70-130			
Vinyl Chloride	10.3	0.2	ug/L	10.00		103	70-130			
Xylene O	10.5	0.5	ug/L	10.00		105	70-130			
Xylene P,M	20.6	0.5	ug/L	20.00		103	70-130			
Surrogate: 1,2-Dichlorobenzene-d4	5.20		ug/L	5.000		104	80-120			
Surrogate: 4-Bromofluorobenzene	4.71		ug/L	5.000		94	80-120			

LCS Dup

1,1,1-Trichloroethane	9.0	0.5	ug/L	10.00		90	70-130	3	20	
1,1,2-Trichloroethane	10.9	0.5	ug/L	10.00		109	70-130	9	20	
1,1-Dichloroethane	11.5	0.5	ug/L	10.00		115	70-130	10	20	
1,1-Dichloroethene	9.0	0.5	ug/L	10.00		90	70-130	12	20	
1,2-Dichlorobenzene	9.4	0.5	ug/L	10.00		94	70-130	14	20	
1,2-Dichloroethane	10.4	0.5	ug/L	10.00		104	70-130	8	20	
1,3-Dichlorobenzene	9.1	0.5	ug/L	10.00		91	70-130	15	20	
1,4-Dichlorobenzene	9.2	0.5	ug/L	10.00		92	70-130	11	20	
Acetone	43.8	5.0	ug/L	50.00		88	70-130	19	20	
Benzene	11.4	0.5	ug/L	10.00		114	70-130	7	20	
Carbon Tetrachloride	9.3	0.3	ug/L	10.00		93	70-130	8	20	
cis-1,2-Dichloroethene	10.0	0.5	ug/L	10.00		100	70-130	11	20	
Ethylbenzene	9.4	0.5	ug/L	10.00		94	70-130	10	20	
Methyl tert-Butyl Ether	11.2	0.5	ug/L	10.00		112	70-130	16	20	
Methylene Chloride	9.6	0.5	ug/L	10.00		96	70-130	15	20	
Naphthalene	10.3	0.5	ug/L	10.00		103	70-130	5	20	
Tertiary-amyl methyl ether	10.5	1.0	ug/L	10.00		105	70-130	10	20	
Tertiary-butyl Alcohol	48.7	25.0	ug/L	50.00		97	70-130	10	25	
Tetrachloroethene	9.6	0.5	ug/L	10.00		96	70-130	5	20	
Toluene	9.4	0.5	ug/L	10.00		94	70-130	13	20	
Trichloroethene	9.9	0.5	ug/L	10.00		99	70-130	9	20	
Vinyl Chloride	9.1	0.2	ug/L	10.00		91	70-130	13	20	
Xylene O	9.5	0.5	ug/L	10.00		95	70-130	10	20	
Xylene P,M	19.3	0.5	ug/L	20.00		96	70-130	7	20	
Surrogate: 1,2-Dichlorobenzene-d4	4.82		ug/L	5.000		96	80-120			
Surrogate: 4-Bromofluorobenzene	4.42		ug/L	5.000		88	80-120			

608.3 Polychlorinated Biphenyls (PCB)

Batch DE00708 - 3510C

Blank

Aroclor 1016	ND	0.10	ug/L							
Aroclor 1016 [2C]	ND	0.10	ug/L							
Aroclor 1221	ND	0.10	ug/L							
Aroclor 1221 [2C]	ND	0.10	ug/L							
Aroclor 1232	ND	0.10	ug/L							



CERTIFICATE OF ANALYSIS

Client Name: Sage Environmental, Inc.
Client Project ID: Logan - Bond

ESS Laboratory Work Order: 20E0082

Quality Control Data

Analyte	Result	MRL	Units	Spike Level	Source Result	%REC	%REC Limits	RPD	RPD Limit	Qualifier
---------	--------	-----	-------	-------------	---------------	------	-------------	-----	-----------	-----------

608.3 Polychlorinated Biphenyls (PCB)

Batch DE00708 - 3510C

Aroclor 1232 [2C]	ND	0.10	ug/L							
Aroclor 1242	ND	0.10	ug/L							
Aroclor 1242 [2C]	ND	0.10	ug/L							
Aroclor 1248	ND	0.10	ug/L							
Aroclor 1248 [2C]	ND	0.10	ug/L							
Aroclor 1254	ND	0.10	ug/L							
Aroclor 1254 [2C]	ND	0.10	ug/L							
Aroclor 1260	ND	0.10	ug/L							
Aroclor 1260 [2C]	ND	0.10	ug/L							
Aroclor 1262	ND	0.10	ug/L							
Aroclor 1262 [2C]	ND	0.10	ug/L							
Aroclor 1268	ND	0.10	ug/L							
Aroclor 1268 [2C]	ND	0.10	ug/L							

Surrogate: Decachlorobiphenyl	0.0303		ug/L	0.05000		61	30-150			
Surrogate: Decachlorobiphenyl [2C]	0.0302		ug/L	0.05000		60	30-150			
Surrogate: Tetrachloro-m-xylene	0.0269		ug/L	0.05000		54	30-150			
Surrogate: Tetrachloro-m-xylene [2C]	0.0323		ug/L	0.05000		65	30-150			

LCS

Aroclor 1016	0.84	0.10	ug/L	1.000		84	50-140			
Aroclor 1016 [2C]	0.84	0.10	ug/L	1.000		84	50-140			
Aroclor 1260	0.85	0.10	ug/L	1.000		85	1-164			
Aroclor 1260 [2C]	0.86	0.10	ug/L	1.000		86	1-164			

Surrogate: Decachlorobiphenyl	0.0372		ug/L	0.05000		74	30-150			
Surrogate: Decachlorobiphenyl [2C]	0.0368		ug/L	0.05000		74	30-150			
Surrogate: Tetrachloro-m-xylene	0.0387		ug/L	0.05000		77	30-150			
Surrogate: Tetrachloro-m-xylene [2C]	0.0420		ug/L	0.05000		84	30-150			

LCS Dup

Aroclor 1016	0.83	0.10	ug/L	1.000		83	50-140	1	36	
Aroclor 1016 [2C]	0.83	0.10	ug/L	1.000		83	50-140	1	36	
Aroclor 1260	0.91	0.10	ug/L	1.000		91	1-164	7	38	
Aroclor 1260 [2C]	0.93	0.10	ug/L	1.000		93	1-164	7	38	

Surrogate: Decachlorobiphenyl	0.0423		ug/L	0.05000		85	30-150			
Surrogate: Decachlorobiphenyl [2C]	0.0428		ug/L	0.05000		86	30-150			
Surrogate: Tetrachloro-m-xylene	0.0348		ug/L	0.05000		70	30-150			
Surrogate: Tetrachloro-m-xylene [2C]	0.0379		ug/L	0.05000		76	30-150			

625.1(SIM) Semi-Volatile Organic Compounds

Batch DE00602 - 3510C

Blank

Acenaphthene	ND	0.20	ug/L							
Acenaphthylene	ND	0.20	ug/L							
Anthracene	ND	0.20	ug/L							



CERTIFICATE OF ANALYSIS

Client Name: Sage Environmental, Inc.
Client Project ID: Logan - Bond

ESS Laboratory Work Order: 20E0082

Quality Control Data

Analyte	Result	MRL	Units	Spike Level	Source Result	%REC	%REC Limits	RPD	RPD Limit	Qualifier
---------	--------	-----	-------	-------------	---------------	------	-------------	-----	-----------	-----------

625.1(SIM) Semi-Volatile Organic Compounds

Batch DE00602 - 3510C

Benzo(a)anthracene	ND	0.05	ug/L							
Benzo(a)pyrene	ND	0.05	ug/L							
Benzo(b)fluoranthene	ND	0.05	ug/L							
Benzo(g,h,i)perylene	ND	0.20	ug/L							
Benzo(k)fluoranthene	ND	0.05	ug/L							
bis(2-Ethylhexyl)phthalate	ND	2.50	ug/L							
Butylbenzylphthalate	ND	2.50	ug/L							
Chrysene	ND	0.05	ug/L							
Dibenzo(a,h)Anthracene	ND	0.05	ug/L							
Diethylphthalate	ND	2.50	ug/L							
Dimethylphthalate	ND	2.50	ug/L							
Di-n-butylphthalate	ND	2.50	ug/L							
Di-n-octylphthalate	ND	2.50	ug/L							
Fluoranthene	ND	0.20	ug/L							
Fluorene	ND	0.20	ug/L							
Indeno(1,2,3-cd)Pyrene	ND	0.05	ug/L							
Naphthalene	ND	0.20	ug/L							
Pentachlorophenol	ND	0.90	ug/L							
Phenanthrene	ND	0.20	ug/L							
Pyrene	ND	0.20	ug/L							
Surrogate: 1,2-Dichlorobenzene-d4	0.992		ug/L	2.500		40	30-130			
Surrogate: 2,4,6-Tribromophenol	3.73		ug/L	3.750		99	15-110			
Surrogate: 2-Fluorobiphenyl	1.56		ug/L	2.500		62	30-130			
Surrogate: Nitrobenzene-d5	2.13		ug/L	2.500		85	30-130			
Surrogate: p-Terphenyl-d14	2.56		ug/L	2.500		102	30-130			

LCS

Acenaphthene	2.97	0.20	ug/L	4.000		74	40-140			
Acenaphthylene	3.29	0.20	ug/L	4.000		82	40-140			
Anthracene	3.61	0.20	ug/L	4.000		90	40-140			
Benzo(a)anthracene	3.56	0.05	ug/L	4.000		89	40-140			
Benzo(a)pyrene	3.81	0.05	ug/L	4.000		95	40-140			
Benzo(b)fluoranthene	3.94	0.05	ug/L	4.000		99	40-140			
Benzo(g,h,i)perylene	3.41	0.20	ug/L	4.000		85	40-140			
Benzo(k)fluoranthene	3.50	0.05	ug/L	4.000		88	40-140			
bis(2-Ethylhexyl)phthalate	4.61	2.50	ug/L	4.000		115	40-140			
Butylbenzylphthalate	4.54	2.50	ug/L	4.000		113	40-140			
Chrysene	3.72	0.05	ug/L	4.000		93	40-140			
Dibenzo(a,h)Anthracene	3.46	0.05	ug/L	4.000		86	40-140			
Diethylphthalate	3.93	2.50	ug/L	4.000		98	40-140			
Dimethylphthalate	3.87	2.50	ug/L	4.000		97	40-140			
Di-n-butylphthalate	4.15	2.50	ug/L	4.000		104	40-140			
Di-n-octylphthalate	4.30	2.50	ug/L	4.000		108	40-140			
Fluoranthene	4.15	0.20	ug/L	4.000		104	40-140			
Fluorene	3.45	0.20	ug/L	4.000		86	40-140			
Indeno(1,2,3-cd)Pyrene	3.75	0.05	ug/L	4.000		94	40-140			



CERTIFICATE OF ANALYSIS

Client Name: Sage Environmental, Inc.
Client Project ID: Logan - Bond

ESS Laboratory Work Order: 20E0082

Quality Control Data

Analyte	Result	MRL	Units	Spike Level	Source Result	%REC	%REC Limits	RPD	RPD Limit	Qualifier
---------	--------	-----	-------	-------------	---------------	------	-------------	-----	-----------	-----------

625.1(SIM) Semi-Volatile Organic Compounds

Batch DE00602 - 3510C

Naphthalene	2.33	0.20	ug/L	4.000		58	40-140			
Pentachlorophenol	2.75	0.90	ug/L	4.000		69	30-130			
Phenanthrene	3.52	0.20	ug/L	4.000		88	40-140			
Pyrene	4.03	0.20	ug/L	4.000		101	40-140			
Surrogate: 1,2-Dichlorobenzene-d4	1.51		ug/L	2.500		60	30-130			
Surrogate: 2,4,6-Tribromophenol	3.32		ug/L	3.750		89	15-110			
Surrogate: 2-Fluorobiphenyl	1.98		ug/L	2.500		79	30-130			
Surrogate: Nitrobenzene-d5	1.98		ug/L	2.500		79	30-130			
Surrogate: p-Terphenyl-d14	2.57		ug/L	2.500		103	30-130			

LCS Dup

Acenaphthene	3.11	0.20	ug/L	4.000		78	40-140	5	20	
Acenaphthylene	3.45	0.20	ug/L	4.000		86	40-140	5	20	
Anthracene	3.63	0.20	ug/L	4.000		91	40-140	0.5	20	
Benzo(a)anthracene	3.09	0.05	ug/L	4.000		77	40-140	14	20	
Benzo(a)pyrene	3.01	0.05	ug/L	4.000		75	40-140	24	20	D+
Benzo(b)fluoranthene	3.16	0.05	ug/L	4.000		79	40-140	22	20	D+
Benzo(g,h,i)perylene	2.75	0.20	ug/L	4.000		69	40-140	21	20	D+
Benzo(k)fluoranthene	2.77	0.05	ug/L	4.000		69	40-140	23	20	D+
bis(2-Ethylhexyl)phthalate	3.96	2.50	ug/L	4.000		99	40-140	15	20	
Butylbenzylphthalate	3.99	2.50	ug/L	4.000		100	40-140	13	20	
Chrysene	3.23	0.05	ug/L	4.000		81	40-140	14	20	
Dibenzo(a,h)Anthracene	2.77	0.05	ug/L	4.000		69	40-140	22	20	D+
Diethylphthalate	4.06	2.50	ug/L	4.000		101	40-140	3	20	
Dimethylphthalate	4.09	2.50	ug/L	4.000		102	40-140	6	20	
Di-n-butylphthalate	4.28	2.50	ug/L	4.000		107	40-140	3	20	
Di-n-octylphthalate	3.42	2.50	ug/L	4.000		85	40-140	23	20	D+
Fluoranthene	4.14	0.20	ug/L	4.000		103	40-140	0.2	20	
Fluorene	3.61	0.20	ug/L	4.000		90	40-140	4	20	
Indeno(1,2,3-cd)Pyrene	2.84	0.05	ug/L	4.000		71	40-140	28	20	D+
Naphthalene	2.41	0.20	ug/L	4.000		60	40-140	3	20	
Pentachlorophenol	2.86	0.90	ug/L	4.000		71	30-130	4	20	
Phenanthrene	3.48	0.20	ug/L	4.000		87	40-140	0.9	20	
Pyrene	3.53	0.20	ug/L	4.000		88	40-140	13	20	
Surrogate: 1,2-Dichlorobenzene-d4	1.35		ug/L	2.500		54	30-130			
Surrogate: 2,4,6-Tribromophenol	3.33		ug/L	3.750		89	15-110			
Surrogate: 2-Fluorobiphenyl	1.93		ug/L	2.500		77	30-130			
Surrogate: Nitrobenzene-d5	1.93		ug/L	2.500		77	30-130			
Surrogate: p-Terphenyl-d14	2.07		ug/L	2.500		83	30-130			

8270D(SIM) Semi-Volatile Organic Compounds w/ Isotope Dilution

Batch DE00633 - 3535A

Blank

1,4-Dioxane	ND	0.250	ug/L							
Surrogate: 1,4-Dioxane-d8	2.50		ug/L	5.000		50	15-115			

LCS



CERTIFICATE OF ANALYSIS

Client Name: Sage Environmental, Inc.
Client Project ID: Logan - Bond

ESS Laboratory Work Order: 20E0082

Quality Control Data

Analyte	Result	MRL	Units	Spike Level	Source Result	%REC	%REC Limits	RPD	RPD Limit	Qualifier
---------	--------	-----	-------	-------------	---------------	------	-------------	-----	-----------	-----------

8270D(SIM) Semi-Volatile Organic Compounds w/ Isotope Dilution

Batch DE00633 - 3535A

1,4-Dioxane	8.24	0.250	ug/L	10.00		82	40-140			
Surrogate: 1,4-Dioxane-d8	2.74		ug/L	5.000		55	15-115			

LCS Dup

1,4-Dioxane	9.33	0.250	ug/L	10.00		93	40-140	12	20	
Surrogate: 1,4-Dioxane-d8	2.81		ug/L	5.000		56	15-115			

Classical Chemistry

Batch DE00514 - General Preparation

Blank

Total Suspended Solids	ND	5	mg/L							
------------------------	----	---	------	--	--	--	--	--	--	--

LCS

Total Suspended Solids	86		mg/L	90.70		95	80-120			
------------------------	----	--	------	-------	--	----	--------	--	--	--

Batch DE00518 - General Preparation

Blank

Total Residual Chlorine	ND	20.0	ug/L							
-------------------------	----	------	------	--	--	--	--	--	--	--

LCS

Total Residual Chlorine	1.30		mg/L	1.300		100	85-115			
-------------------------	------	--	------	-------	--	-----	--------	--	--	--

Batch DE00519 - General Preparation

Blank

Hexavalent Chromium	ND	10.0	ug/L							
---------------------	----	------	------	--	--	--	--	--	--	--

LCS

Hexavalent Chromium	497	10.0	ug/L	499.8		99	90-110			
---------------------	-----	------	------	-------	--	----	--------	--	--	--

LCS Dup

Hexavalent Chromium	507	10.0	ug/L	499.8		102	90-110	2	20	
---------------------	-----	------	------	-------	--	-----	--------	---	----	--

Batch DE00609 - General Preparation

Blank

Total Petroleum Hydrocarbon	ND	5	mg/L							
-----------------------------	----	---	------	--	--	--	--	--	--	--

LCS

Total Petroleum Hydrocarbon	16	5	mg/L	19.38		80	66-114			
-----------------------------	----	---	------	-------	--	----	--------	--	--	--

Batch DE00615 - General Preparation

Blank

Chloride	ND	0.5	mg/L							
----------	----	-----	------	--	--	--	--	--	--	--

LCS

Chloride	9.7		mg/L	10.00		97	90-110			
----------	-----	--	------	-------	--	----	--------	--	--	--

Batch DE00631 - NH4 Prep

Blank

Ammonia as N	ND	0.10	mg/L							
--------------	----	------	------	--	--	--	--	--	--	--

LCS

Ammonia as N	1.00	0.10	mg/L	0.9994		100	80-120			
--------------	------	------	------	--------	--	-----	--------	--	--	--

Batch DE00717 - TCN Prep



CERTIFICATE OF ANALYSIS

Client Name: Sage Environmental, Inc.
Client Project ID: Logan - Bond

ESS Laboratory Work Order: 20E0082

Quality Control Data

Analyte	Result	MRL	Units	Spike Level	Source Result	%REC	%REC Limits	RPD	RPD Limit	Qualifier
---------	--------	-----	-------	-------------	---------------	------	-------------	-----	-----------	-----------

Classical Chemistry

Batch DE00717 - TCN Prep

Blank

Total Cyanide	ND	5.00	ug/L							
---------------	----	------	------	--	--	--	--	--	--	--

LCS

Total Cyanide	19.8	5.00	ug/L	20.06		99	90-110			
---------------	------	------	------	-------	--	----	--------	--	--	--

LCS

Total Cyanide	148	5.00	ug/L	150.4		98	90-110			
---------------	-----	------	------	-------	--	----	--------	--	--	--

LCS Dup

Total Cyanide	148	5.00	ug/L	150.4		99	90-110	0.2	20	
---------------	-----	------	------	-------	--	----	--------	-----	----	--

Batch DE00719 - General Preparation

Blank

Phenols	ND	50	ug/L							
---------	----	----	------	--	--	--	--	--	--	--

LCS

Phenols	985	50	ug/L	1000		99	80-120			
---------	-----	----	------	------	--	----	--------	--	--	--

504.1 1,2-Dibromoethane / 1,2-Dibromo-3-chloropropane

Batch DE00722 - 504/8011

Blank

1,2-Dibromo-3-Chloropropane	ND	0.015	ug/L							
1,2-Dibromo-3-Chloropropane [2C]	ND	0.015	ug/L							
1,2-Dibromoethane	ND	0.015	ug/L							
1,2-Dibromoethane [2C]	ND	0.015	ug/L							

Surrogate: Pentachloroethane	0.148		ug/L	0.2000		74	30-150			
Surrogate: Pentachloroethane [2C]	0.147		ug/L	0.2000		74	30-150			

LCS

1,2-Dibromo-3-Chloropropane	0.074	0.015	ug/L	0.08000		92	70-130			
1,2-Dibromo-3-Chloropropane [2C]	0.064	0.015	ug/L	0.08000		80	70-130			
1,2-Dibromoethane	0.070	0.015	ug/L	0.08000		88	70-130			
1,2-Dibromoethane [2C]	0.065	0.015	ug/L	0.08000		81	70-130			

Surrogate: Pentachloroethane	0.0786		ug/L	0.2000		39	30-150			
Surrogate: Pentachloroethane [2C]	0.0729		ug/L	0.2000		36	30-150			

LCS

1,2-Dibromo-3-Chloropropane	0.227	0.015	ug/L	0.2000		114	70-130			
1,2-Dibromo-3-Chloropropane [2C]	0.197	0.015	ug/L	0.2000		99	70-130			
1,2-Dibromoethane	0.195	0.015	ug/L	0.2000		98	70-130			
1,2-Dibromoethane [2C]	0.185	0.015	ug/L	0.2000		93	70-130			

Surrogate: Pentachloroethane	0.216		ug/L	0.2000		108	30-150			
Surrogate: Pentachloroethane [2C]	0.224		ug/L	0.2000		112	30-150			

Alcohol Scan by GC/FID

Batch DE00614 - No Prep



CERTIFICATE OF ANALYSIS

Client Name: Sage Environmental, Inc.

Client Project ID: Logan - Bond

ESS Laboratory Work Order: 20E0082

Quality Control Data

Analyte	Result	MRL	Units	Spike Level	Source Result	%REC	%REC Limits	RPD	RPD Limit	Qualifier
---------	--------	-----	-------	-------------	---------------	------	-------------	-----	-----------	-----------

Alcohol Scan by GC/FID

Batch DE00614 - No Prep

Blank

Ethanol	ND	10	mg/L							
---------	----	----	------	--	--	--	--	--	--	--

LCS

Ethanol	761	10	mg/L	951.9		80	60-140			
---------	-----	----	------	-------	--	----	--------	--	--	--

LCS Dup

Ethanol	755	10	mg/L	951.9		79	60-140	0.8	30	
---------	-----	----	------	-------	--	----	--------	-----	----	--



CERTIFICATE OF ANALYSIS

Client Name: Sage Environmental, Inc.

Client Project ID: Logan - Bond

ESS Laboratory Work Order: 20E0082

Notes and Definitions

- U Analyte included in the analysis, but not detected
- S+ Surrogate recovery(ies) above upper control limit (S+).
- HT The maximum holding time listed in 40 CFR Part 136 Table II for pH, Dissolved Oxygen, Sulfite and Residual Chlorine is fifteen minutes.
- D+ Relative percent difference for duplicate is outside of criteria (D+).
- D Diluted.
- CD+ Continuing Calibration %Diff/Drift is above control limit (CD+).
- B+ Blank Spike recovery is above upper control limit (B+).
- ND Analyte NOT DETECTED at or above the MRL (LOQ), LOD for DoD Reports, MDL for J-Flagged Analytes
- dry Sample results reported on a dry weight basis
- RPD Relative Percent Difference
- MDL Method Detection Limit
- MRL Method Reporting Limit
- LOD Limit of Detection
- LOQ Limit of Quantitation
- DL Detection Limit
- I/V Initial Volume
- F/V Final Volume
- § Subcontracted analysis; see attached report
- 1 Range result excludes concentrations of surrogates and/or internal standards eluting in that range.
- 2 Range result excludes concentrations of target analytes eluting in that range.
- 3 Range result excludes the concentration of the C9-C10 aromatic range.
- Avg Results reported as a mathematical average.
- NR No Recovery
- [CALC] Calculated Analyte
- SUB Subcontracted analysis; see attached report
- RL Reporting Limit
- EDL Estimated Detection Limit
- MF Membrane Filtration
- MPN Most Probably Number
- TNTC Too numerous to Count
- CFU Colony Forming Units



CERTIFICATE OF ANALYSIS

Client Name: Sage Environmental, Inc.
Client Project ID: Logan - Bond

ESS Laboratory Work Order: 20E0082

ESS LABORATORY CERTIFICATIONS AND ACCREDITATIONS

ENVIRONMENTAL

Rhode Island Potable and Non Potable Water: LAI00179

<http://www.health.ri.gov/find/labs/analytical/ESS.pdf>

Connecticut Potable and Non Potable Water, Solid and Hazardous Waste: PH-0750

http://www.ct.gov/dph/lib/dph/environmental_health/environmental_laboratories/pdf/OutOfStateCommercialLaboratories.pdf

Maine Potable and Non Potable Water, and Solid and Hazardous Waste: RI00002

<http://www.maine.gov/dhhs/mecdc/environmental-health/dwp/partners/labCert.shtml>

Massachusetts Potable and Non Potable Water: M-RI002

<http://public.dep.state.ma.us/Labcert/Labcert.aspx>

New Hampshire (NELAP accredited) Potable and Non Potable Water, Solid and Hazardous Waste: 2424

<http://des.nh.gov/organization/divisions/water/dwgb/nhelap/index.htm>

New York (NELAP accredited) Non Potable Water, Solid and Hazardous Waste: 11313

<http://www.wadsworth.org/labcert/elap/comm.html>

New Jersey (NELAP accredited) Non Potable Water, Solid and Hazardous Waste: RI006

http://datamine2.state.nj.us/DEP_OPRA/OpraMain/pi_main?mode=pi_by_site&sort_order=PI_NAMEA&Select+a+Site:=58715

United States Department of Agriculture Soil Permit: P330-12-00139

Pennsylvania: 68-01752

<http://www.dep.pa.gov/Business/OtherPrograms/Labs/Pages/Laboratory-Accreditation-Program.aspx>

ESS Laboratory Sample and Cooler Receipt Checklist

Client: Sage Environmental, Inc. - ML

ESS Project ID: 20E0082

Date Received: 5/5/2020

Shipped/Delivered Via: Client

Project Due Date: 5/8/2020

Days for Project: 3 Day

- 1. Air bill manifest present? No
Air No.: NA
- 2. Were custody seals present? No
- 3. Is radiation count <100 CPM? Yes
- 4. Is a Cooler Present? Yes
Temp: 4.1 Iced with: Ice
- 5. Was COC signed and dated by client? Yes

- 6. Does COC match bottles? Yes
- 7. Is COC complete and correct? Yes
- 8. Were samples received intact? Yes
- 9. Were labs informed about **short holds & rushes**? Yes / No / NA
- 10. Were any analyses received outside of hold time? Yes / No

- 11. Any Subcontracting needed? Yes / No
ESS Sample IDs: _____
Analysis: _____
TAT: _____

- 12. Were VOAs received? Yes / No
a. Air bubbles in aqueous VOAs? Yes / No
b. Does methanol cover soil completely? Yes / No / NA

- 13. Are the samples properly preserved? Yes / No
a. If metals preserved upon receipt: Date: _____ Time: _____ By: _____
b. Low Level VOA vials frozen: Date: _____ Time: _____ By: _____

Sample Receiving Notes:

- 14. Was there a need to contact Project Manager? Yes / No
a. Was there a need to contact the client? Yes / No
Who was contacted? _____ Date: _____ Time: _____ By: _____

Sample Number	Container ID	Proper Container	Air Bubbles Present	Sufficient Volume	Container Type	Preservative	Record pH (Cyanide and 608 Pesticides)
1	38860	Yes	N/A	Yes	1L Amber	NP	
1	38861	Yes	N/A	Yes	1L Amber	NP	
1	38862	Yes	N/A	Yes	1L Amber	NP	
1	38863	Yes	N/A	Yes	1L Amber	NP	
1	38864	Yes	N/A	Yes	1L Amber	NP	
1	38865	Yes	N/A	Yes	1L Amber	NP	
1	38872	Yes	N/A	Yes	1L Amber	H2SO4	
1	38873	Yes	N/A	Yes	1L Amber	H2SO4	
1	38876	Yes	N/A	Yes	1L Poly	NP	
1	38878	Yes	N/A	Yes	500 mL Poly	H2SO4	
1	38880	Yes	N/A	Yes	500 mL Poly	HNO3	
1	38882	Yes	N/A	Yes	250 mL Poly	HNO3	
1	38884	Yes	N/A	Yes	250 mL Poly	NaOH	pH>12 JA
1	38886	Yes	N/A	Yes	250 mL Poly	NP	
1	38888	Yes	No	Yes	VOA Vial	HCl	
1	38889	Yes	No	Yes	VOA Vial	HCl	
1	38890	Yes	No	Yes	VOA Vial	HCl	

ESS Laboratory Sample and Cooler Receipt Checklist

Client: Sage Environmental, Inc. - ML

ESS Project ID: 20E0082

Date Received: 5/5/2020

1	38891	Yes	No	Yes	VOA Vial	HCl
1	38892	Yes	No	Yes	VOA Vial	HCl
1	38893	Yes	No	Yes	VOA Vial	HCl
1	38900	Yes	No	Yes	VOA Vial	NP
2	38866	Yes	N/A	Yes	1L Amber	NP
2	38867	Yes	N/A	Yes	1L Amber	NP
2	38868	Yes	N/A	Yes	1L Amber	NP
2	38869	Yes	N/A	Yes	1L Amber	NP
2	38870	Yes	N/A	Yes	1L Amber	NP
2	38871	Yes	N/A	Yes	1L Amber	NP
2	38874	Yes	N/A	Yes	1L Amber	H2SO4
2	38875	Yes	N/A	Yes	1L Amber	H2SO4
2	38877	Yes	N/A	Yes	1L Poly	NP
2	38879	Yes	N/A	Yes	500 mL Poly	H2SO4
2	38881	Yes	N/A	Yes	500 mL Poly	HNO3
2	38883	Yes	N/A	Yes	250 mL Poly	HNO3
2	38885	Yes	N/A	Yes	250 mL Poly	NaOH
2	38887	Yes	N/A	Yes	250 mL Poly	NP
2	38894	Yes	No	Yes	VOA Vial	HCl
2	38895	Yes	No	Yes	VOA Vial	HCl
2	38896	Yes	No	Yes	VOA Vial	HCl
2	38897	Yes	No	Yes	VOA Vial	HCl
2	38898	Yes	No	Yes	VOA Vial	HCl
2	38899	Yes	No	Yes	VOA Vial	HCl
2	38901	Yes	No	Yes	VOA Vial	NP

pH>12 JA

2nd Review

Were all containers scanned into storage/lab?

Are barcode labels on correct containers?

Are all Flashpoint stickers attached/container ID # circled?

Are all Hex Chrome stickers attached?

Are all QC stickers attached?

Are VOA stickers attached if bubbles noted?

Initials: 

(Yes / No
Yes / No / NA
Yes / No / NA
Yes / No / NA
Yes / No / NA)

Completed By: 

Date & Time: 5/5/20 1739

Reviewed By: 

Date & Time: 5/5/20 1743

Delivered By: 

Date & Time: 5/5/20 1743

ESS Laboratory

Division of Thielsch Engineering, Inc.
 185 Frances Avenue, Cranston, RI 02910-2211
 Tel. (401) 461-7181 Fax (401) 461-4486
 www.esslaboratory.com

CHAIN OF CUSTODY

ESS LAB PROJECT ID
20052

Reporting Limits -
 Discharge into: Fresh Water Salt Water

Turn Time _____ Standard _____ Rush 72 hr Approved By: _____

State where samples were collected: (MA) NH

Is this project for: RGP

Electronic Deliverable Yes No _____
 Format: Excel Access PDB Other _____

Project Manager: Jacob Butterworth

Company: SAGE Environmental, Inc

Address: 172 Armistice Blvd
 Pawtucket, RI

Project # M948

Project Name: Logan-Bond

PO # M948

ESS Lab Sample ID	Date	Collection Time	Grab -G Composite-C	Matrix	Sample Identification	# of Containers	Analysis													Comment #						
							RGP Metals Total	RGP Metals Dissolved	Mercury (Calculation)	Ethanol ASTM D3695	Chloride 300.0*	Total Cyanide 4500 LL	TPH 1664	TSS 2540D*	TRC 4500-CL D*	Ammonia 350.1	Tri Cr (Calc. MUST run T. Cr)	Hex Cr 3500	Phenol 420.1		RGV VOC Long List 524	1,4-Dioxane 8270-SIM	EDB 504.1	RGV SVOC Log List 625-SIM	PCB 608	
<u>1</u>	<u>5-5-20</u>	<u>11:00</u>			<u>BioZ</u>	<u>22</u>	X	X	X	X	X	X	X	X	X	X	X	X	X	X	X	X	X	X	X	1,2,3
<u>2</u>	<u>5-5-20</u>	<u>11:45</u>	<u>G</u>	<u>AG</u>	<u>UNK-101</u>	<u>22</u>	X	X	X	X	X	X	X	X	X	X	X	X	X	X	X	X	X	X	X	2,3

Preservation Code: 1-NP, 2-HCl, 3-H2SO4, 4-HNO3, 5-NaOH, 6-MeOH, 7-Asorbic Acid, 8-ZnAct, 9-_____

Container Type: P-Poly G-Glass AG-Amber Glass S-Sterile V-VOA

Matrix: S-Soil SD-Solid D-Sludge WW-Wastewater GW-Groundwater SW-Surface Water DW-Drinking Water O-Oil W-Wipes F-Filter

Cooler Present Yes No

Seals Intact Yes No NA: Y

Cooler Temperature: 4.1 3.9

Sampled by: [Signature]

Comments: 1) RGP Metals include Sb, As, Cd, Cu, Fe, Pb, Ni, Se, Ag and Zn by 200.7/3113B and Hg by 245.1
 2) Parameters in **BOLD** have Short hold-time
 * **TSS, TRC and Cl taken from the same container**
PERMIT ATTACHED 3) Salt water discharge Reporting

Relinquished by: (Signature) <u>[Signature]</u>	Date/Time <u>5-5-20 17:10</u>	Received by: (Signature) <u>[Signature]</u>	Date/Time <u>5/5/20 17:17</u>	Relinquished by: (Signature)	Date/Time	Received by: (Signature)
Relinquished by: (Signature)	Date/Time	Received by: (Signature)	Date/Time	Relinquished by: (Signature)	Date/Time	Received by: (Signature)

ATTACHMENT G

Steel Tank

Bi-Level

Overview:

Store liquids in confidence with Rain for Rent's 21,000 gallon Steel Bi-level Tank. This mobile tank allows your jobsite to have flexibility in planning your project layout. The Bi-level Tank provides OSHA safe stairways and walkways to make sure your employees are safe when checking water levels or working on the tank. The Bi-level Tank incorporates a center v-sloped floor to drain the contents of the tank to its lowest level. Rain for Rent also offers internally epoxy coated Bi-level Tanks to keep your fluids clean for sensitive environmental applications and provide chemical resistance.

Features:

- Vapor Tight Tanks: rated to 16oz/in² of pressure and 0.4oz/in² of vacuum
- V-drain floor with front and rear 4" 150-lb flanges with lever operated butterfly valves
- OSHA Compliant Stairway
- 1.5" Steel SCH80 level gauge port
- 8" External manifold
- Front 3" Steel SCH40 fill line
- Rear top of tank has a 3" 150-lb flanged port
- Front of tank has (1) 4" 150-lb flanges and (1) 4" Steel SCH40 threaded connection
- Hatch gaskets and valve seats are Buna-N material
- Optional: Internal epoxy coating
- Optional: Steam Coils







Specs:

Material	1/4" A36 Steel, Epoxy Coated (Option)
Capacity	21,000-gallons
Manways	Four (4) 22" hatches
Dry weight	26,000-lbs
Footprint (LxWxH)	516" x 96" x 132"

Accessories:

- Radar Level Gauges
- Mechanical Level Gauge
- E-CONTAIN® Spillguard
- SolidGroud® Traction Mats
- PipeStax®
- HoseTrax®
- Suction and Discharge Hose

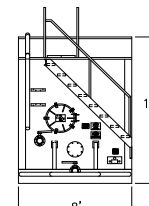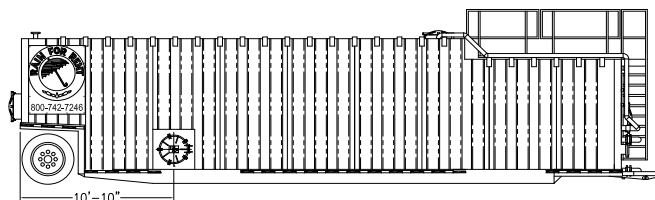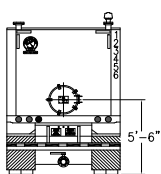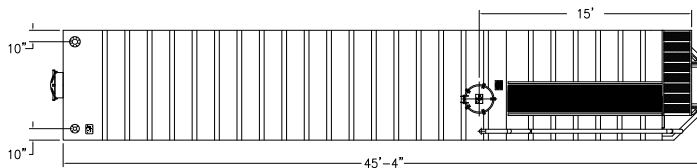

PUMPS • TANKS • FILTRATION • PIPE • SPILLGUARDS

Rain for Rent is a registered trademark of Western Oilfields Supply Company. Features and specifications are subject to change without notice.

Liquid Ingenuity®
800-742-7246
rainforrent.com

Sewage and Trash Pump

DV100c

Overview:

The 6" suction x 4" discharge self-priming centrifugal DV100c trash pump provides up to a maximum of 1,450 gallons per minute pumping and up to 165 feet of head. This pump is usually mounted on a trailer and features the standard PowerPrime Clean Prime Venturi priming system which allows it to run continuously, unattended and even run dry.

Features:

- Continuous self-priming
- Runs dry unattended
- 12 volt, electric start with auto-start capable control panel
- Flex coupled to diesel engine
- 24-hour minimum capacity fuel tank
- Compressor/venturi automatic priming system
- Cast iron wet end with open impellers
- Replaceable wear plates
- SAE Mounted

Specs:



Maximum Flow	1,450 GPM
Maximum Head	165 feet
Pump Size	6" x 4"
Maximum Solids Handling	3 inches
Dry weight	2,400lbs.
Footprint: Trailer mounted model	106.75" x 62"
Fuel tank	40 or 60 gallon
Fuel consumption	1.9 gph @ 2,500 RPM



The DV100c is also available sound attenuated.

Accessories:

- Spillguard
- Suction and Discharge Hoses
- Fuel Nurse Tank

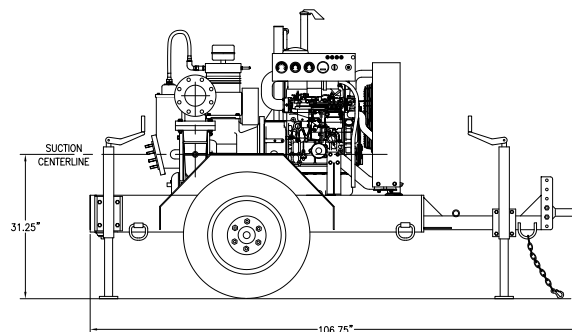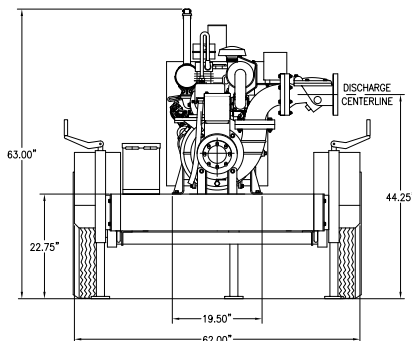

PUMPS • TANKS • FILTRATION • PIPE • SPILLGUARDS

Rain for Rent is a registered trademark of Western Oilfields Supply Company. Features and specifications are subject to change without notice.

Liquid Ingenuity
800-742-7246
rainforrent.com



Rain For Rent

CURVE: 01-0133-02-20

PUMP : DV-100c

SUCTION
6"

DISCHARGE
4"


MAX. SPHERE
3"

IMPELLER
ENCLOSED

IMPELLER
8.25"

IMPELLER &
WEAR RINGS
CAST IRON

ALL INFORMATION CONTAINED IN OR DISCLOSED BY THIS DOCUMENT IS CONSIDERED CONFIDENTIAL AND PROPRIETARY BY RAIN FOR RENT. ALL DISCLOSURES OF DESIGN INFORMATION AND REPRODUCTION OF THIS DOCUMENT AND ALL SALES RIGHTS ARE EXCLUSIVELY RESERVED BY AND TO RAIN FOR RENT AND OTHERS IS PROHIBITED WITHOUT THE PRIOR WRITTEN CONSENT OF RAIN FOR RENT

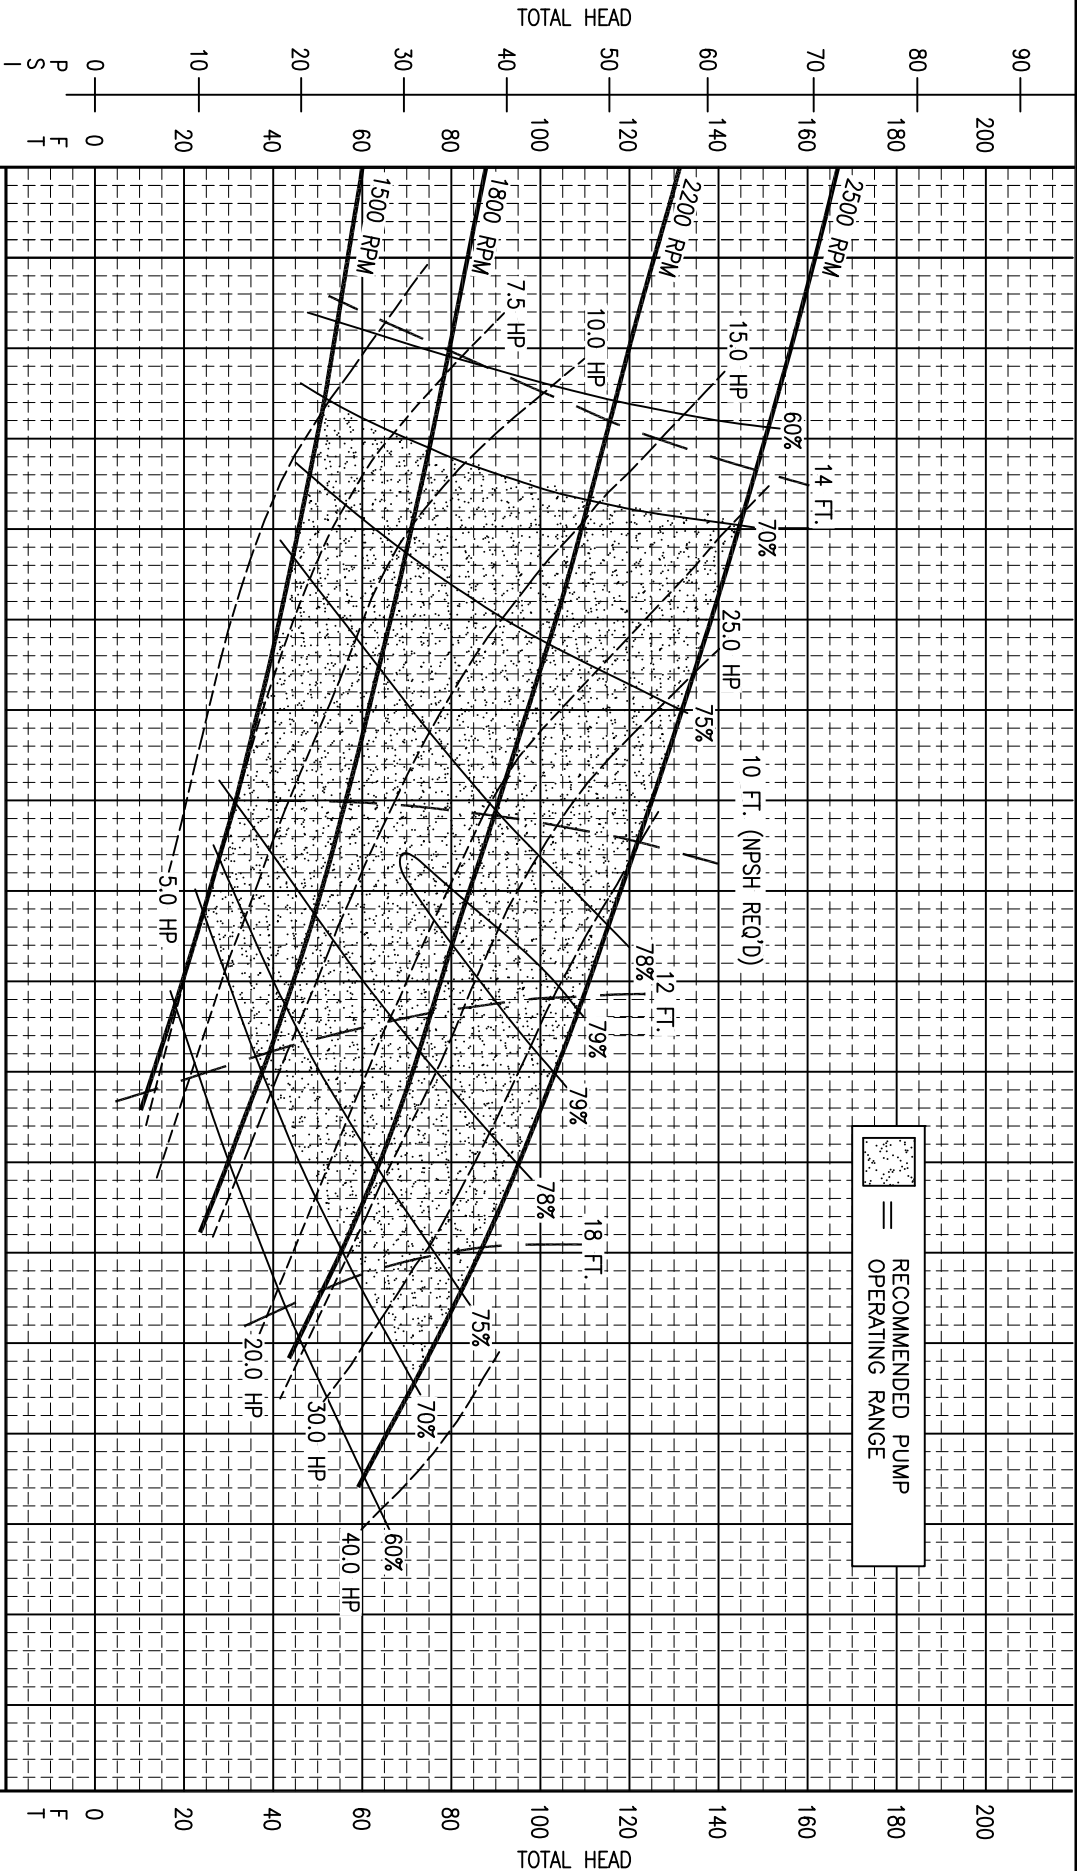

FLOW - CLEAR WATER PERFORMANCE (US GPM)

-PUMP PERFORMANCE CURVES DO NOT INCLUDE CHECK VALVE LOSSES
-POWER CURVES DO NOT INCLUDE PRIMING SYSTEM POWER CONSUMPTION

CONFIDENTIAL



BF 400 Up to 400 GPM

Features

- Manifold connections are 6" 150 lb flanges
- Quadruple bag filter
- Bag filter for high solids holding capacity
- Replaceable bag filters from 100 to 1 micron nominal rating
- No moving parts
- Skid mounted

Technical

- Bag filter chambers connect in parallel
- Units are fitted with bleed valves and pressure gauges
- System can stand alone for sediment removal or be used in combination with filter equipment
- Footprint: 62" long x 36" wide x 61" high
- Dry weight: 1,150 lbs.



Material Specifications

- Chambers constructed of 304 Stainless Steel
- Piping constructed of 304 stainless steel
- Each bag filter chamber holds one (1) 7" x 30" double- stitched filter bag
- Maximum operating pressure: 125psi
- Stainless Steel inlet and outlet manifolds

Available Accessories

- Power Prime Pumps
- Spill Guard Containment berms
- Stainless Steel 304 and Carbon Steel storage tanks in
- Bi-Level, Mixer, Weir and Manifold configurations
- Polyethylene storage tanks
- Cartridge and bag filters
- HDPE pipe and fittings
- Roll off boxes, dewatering bins and vacuum boxes
- Flow meters and pressure reducing/ sustaining valves
- Aluminum Victaulic pipe and fittings
- Suction and discharge hose




Rain for Rent
P.O. Box 2248
Bakersfield CA 93303
800-742-7246
661-393-1542
FAX 661-393-1542
www.rainforrent.com
info@rainforrent.com

Rain for Rent is a registered trademark of Western Oilfields Supply Company. Features and Specifications are subject to change without notice.



LSHP – 100 PSI Series

**EPOXY LINED & PRIMED OR FINISH COATED IN SAFETY BLUE EPOXY
NSF/ANSI STANDARD 61 CERTIFIED LINING
100 PSIG WORKING PRESSURE**

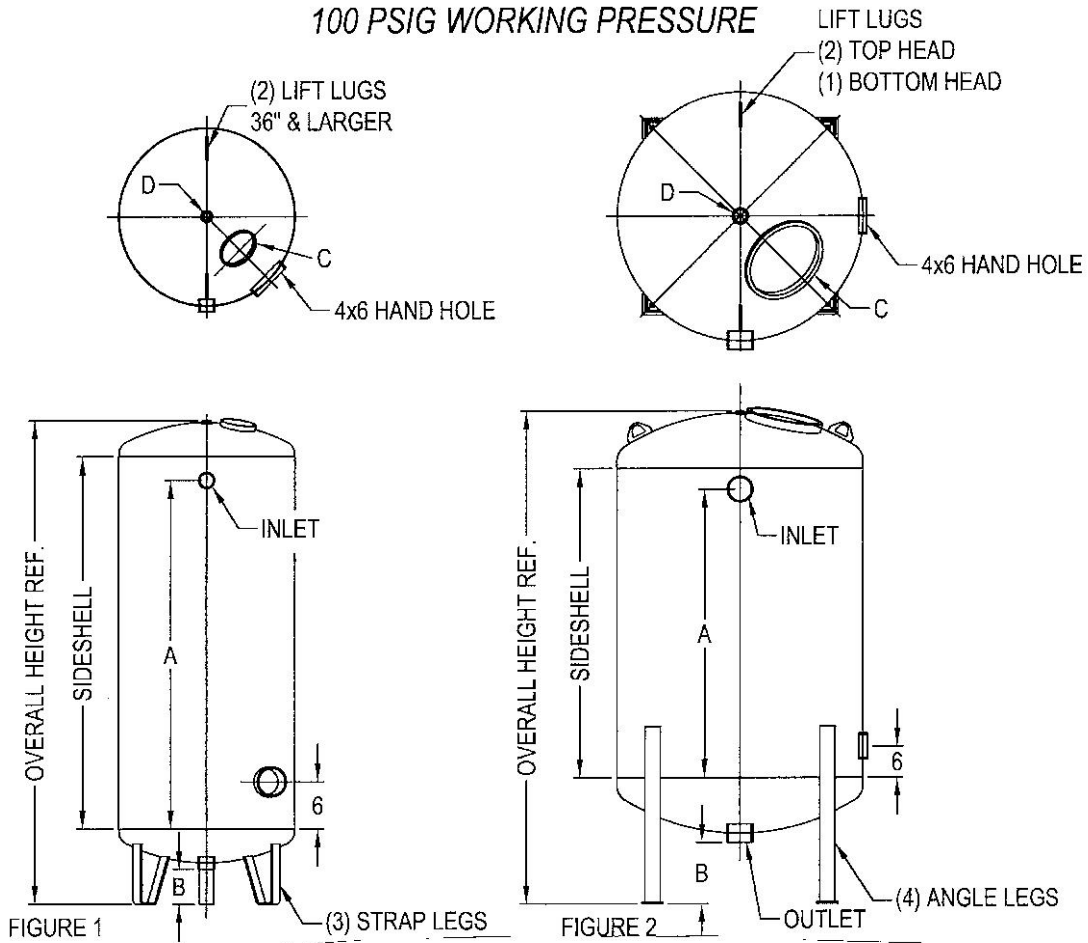

Model	LGAC(lbs.)	Flow Rate(gpm)	Diameter	OAH	Figure	Inlet/Outlet	C	D
LSHP-500	500	25	30"	73"	1	2" NPT	4"x6"	1"
LSHP-1000	1000	50	36"	86"	1	2" NPT	12"x16"	1"
LSHP-2000	2000	100	48"	108"	2	4" NPT	12"x16"	2"
LSHP-3000	3000	150	60"	100"	2	4" NPT	12"x16"	2"
LSHP-5000	5000	250	72"	117"	2	4" FNPT	12"x16"	2"



OWS-100

Oil Water Separator


- Meets API 421 Specifications

FEATURES

- Removes free and dispersed non-emulsified oil
- Removes settleable solids
- Gravity flow oil skimmer
- Easy cleaning via removable vapor tight lids and 4 bottom drains
- No moving parts
- No power required
- Portable – skid mounted
- Leveling jackstands

TECHNICAL INFORMATION

- Parallel corrugated plate gravity displacement type separator.
- Designed in accordance with API 421 to remove free and dispersed non-emulsified oil and settleable solids
- 3 cubic feet sludge capacity

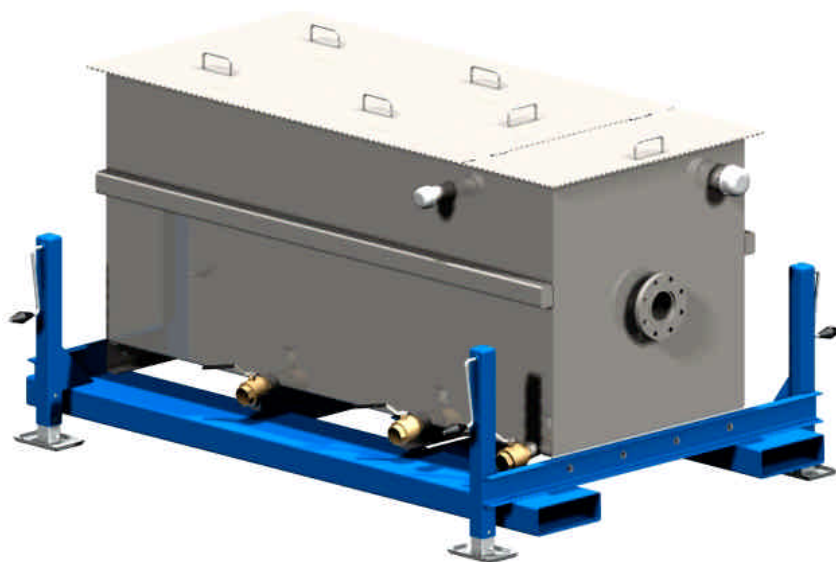

MATERIAL SPECIFICATIONS

- Chambers constructed of 304 stainless steel
- Coalescing packs are made of a special oil attracting material with 1/2" media standard
- OWS-100 Requires 6 coalescing packs
Packs are supplied separately
Each pack is 4' long x 1' wide x 1' tall
- Inlet and outlet are 4" 150# flanges
- Oil drain is 2" male threaded pipe
- Sludge drains are 2" ball valves, female threaded outlet
- Overflow drain is 3" male threaded pipe
- Separator footprint:
96" Long x 66" Wide x 52" High
- Shipping Weight – 1,400 lbs. (Skid Mounted)

FLOW RATES ARE BASED UPON SPECIFIC GRAVITY, AS SHOWN BELOW

SPECIFIC GRAVITY:	0.7	0.85	0.9	0.95
FLOW RATE (GPM):	150	100	75	30

RAIN FOR RENT

Postal Box 2248 • Bakersfield CA 93303
800 742-7246 • 661 399-9124 • FAX 661 393-1542
Internet: www.rainforrent.com



OWS 200

Oil Water Separator


- Meets API 421 Specifications

FEATURES

- Removes free and dispersed non-emulsified oil
- Removes settleable solids
- Gravity flow oil skimmer
- Easy cleaning via removable vapor tight lids and 4 bottom drains
- No moving parts
- No power required
- Portable – skid mounted
- Leveling jackstands

TECHNICAL INFORMATION

- Parallel corrugated plate gravity displacement type separator.
- Designed in accordance with API 421 to remove free and dispersed non-emulsified oil and settleable solids
- 5 cubic feet sludge capacity

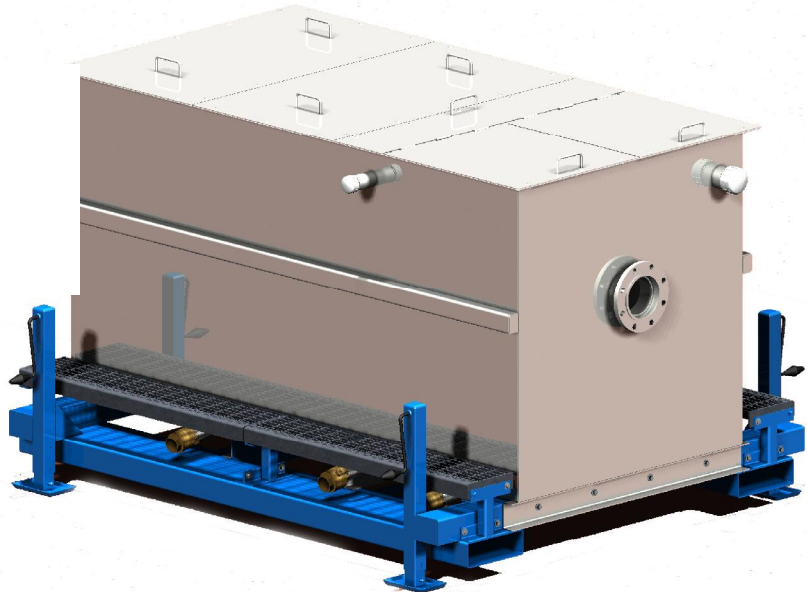

MATERIAL SPECIFICATIONS

- Chambers constructed of 304 stainless steel
- Coalescing packs are made of a special oil attracting material with 1/2" media standard
- OWS 200 requires 12 coalescing packs
Packs are supplied separately
Each pack is 4' long x 1' wide x 1' tall
- Inlet and outlet are 6" 150# flanges
- Oil drain is 2" male threaded pipe
- Sludge drains are 2" ball valves, female threaded outlet
- Overflow drain is 3" male threaded pipe
- Separator footprint:
102" Long x 82" Wide x 64" High
- Dry shipping weight – 2,700 lbs. (Skid Mounted)

FLOW RATES ARE BASED UPON SPECIFIC GRAVITY, AS SHOWN BELOW

SPECIFIC GRAVITY:	0.7	0.85	0.9	0.95
FLOW RATE (GPM):	300	200	150	60

RAIN FOR RENT

Postal Box 2248 • Bakersfield CA 93303
800 742-7246 • 661 399-9124 • FAX 661 393-1542
Internet: www.rainforrent.com

Haloklear®

NATURAL FLOCCULANTS



**WE'VE NEVER
KILLED
A FISH**

The best water treatment system for
your business and the environment

DUAL PRODUCT SYSTEM (DPS)

DOBER

WHAT WE DO



HaloKlear products are used to treat storm, industrial and municipal water, including pollutants in construction site runoff, by reversing the process of water contamination through a combination of advanced, environmentally friendly, natural flocculant technologies.

When it comes to handling dirty water, HaloKlear has built its reputation on creating reliable, effective and safe solutions that can solve all kinds of sediment control problems. HaloKlear's Dual Product System (DPS) uses natural flocculants that completely biodegrade through simple enzymatic activity, resulting in no bioaccumulation. The primary active ingredients are commonly used in the dietary supplement and food industries.

The HaloKlear Residual Test Kit is used to ensure excess flocculants are not leaving the site. This knowledge is comforting for regulators,

contractors and the general public, who can rest assured that the products are not going to cause harm to the environment.

Most importantly, HaloKlear's DPS has a best-in-class performance and has proven itself under vastly varied conditions around the world. It is used in systems ranging from active treatment for mobile water treatment, semi-passive pumped water incorporating coarse filtration and geotextile bags, and completely passive models, such as bio-filtration and check dams. HaloKlear DPS is designed to give contractors and industries in need of water treatment solutions the essential tool they need to meet state and national discharge regulations, as well as EPA Effluent Limitation Guidelines (ELGs).

WE'VE NEVER KILLED A FISH



Don't just clean the water, clean the environment

Our chemistries are less toxic when water is returned to its natural environment. All of HaloKlear's products exhibit exceptionally low toxicity, and the **Dual Product System** has been proven to have **zero toxicity**.* No bioaccumulation concerns exist when and where HaloKlear products are used, and our products are 100% biodegradable through enzymatic activity.

* Third-party toxicity testing concluded that no fish were killed by the Dual Product System (DPS) when both parts were used in combination of following Best Management Practices.

Clean Water.
Naturally.

A CLEAR ADVANTAGE FOR YOUR OPERATION

We'll help you choose from a portfolio of HaloKlear biobased flocculants—from 100% biodegradable natural flocculants to hybrid flocculants—all of which offer a greener alternative to commodity chemicals.

- ✓ Effective alone or paired with other chemistries
- ✓ Appropriate for active, semi-passive and passive applications
- ✓ Use with existing equipment or as part of a customized product
- ✓ Ensure regulatory compliance with on-site residual testing capabilities

DPS PRODUCTS

HaloKlear Dry and Liquid Formula Flocculants

The **Dual Product System (DPS)** uses biodegradable, natural flocculants that perform on a wide array of soil types and pH ranges. In contrast to other products on the market, the HaloKlear Dual Product System creates dense flocs with great shear strength and a low water content that settle very quickly. Solids can be efficiently removed from the water column – increasing performance and productivity while keeping costs low. In addition, the **HaloKlear DPS** is extremely flexible with a successful track record in active, passive, and semi-passive deployment.

LIQUID DPS SYSTEM

- LBP-2101
- LiquiFloc
- Functions in active treatment systems



DRY DPS SYSTEM

- DBP-2100 socks
- GelFloc socks
- Functions in active semi-passive and passive treatment environments



LOOSE DPS SYSTEM

- MB Kits
- Functions in passive treatment environments



PART ONE

LBP-2101 = Liquid
 DBP-2100 = Dry socks
 DBP-2100 MB = Loose, dry

PART TWO

LiquiFloc = Liquid
 GelFloc = Dry socks
 GelFloc MB = Loose, dry

COMPARISONS

VARIABLES	HALOKLEAR DPS	PAMs (POLYACRYLAMIDES) GRANULAR, POWDER & BLOCKS
Soil Types	The HaloKlear Formula works on all construction soil types	Highly soil-specific (100s of different formulations)
Soil Samples	There is no need to send soil samples. The HaloKlear DPS system works on all construction soil types	The majority of soil samples must be collected and shipped to manufacturer's lab for specific polyacrylamide selection, adding time and cost
Dose Rate Calculation	Dose rates can be rapidly determined in the field with the HaloKlear DPS Jar Test Kit	Dose rate calculation must be made by manufacturer after soil sample is received at factory and analyzed, adding time and cost
Organic & Biodegradable	Yes—manufactured from natural occurring flocculants, which degrade through enzymatic activity	Yes—derived from petroleum-based products
Residual Testing	HaloKlear offers an affordable residual test kit, which can be used in the field for immediate results	Laboratory analysis is needed, which can take several days, adding time and cost
Application Range	HaloKlear DPS can be applied on passive, semi-passive, and active treatment systems (Sand-Media, Bags, Cartridges, Screens, etc.). Active treatment systems will benefit due to the type of flock generated (stable and high sheer strength), its ability to retain finer solids, retain a lower percentage of water (i.e. drier solids), and easily be backwashed from the filter	Polyacrylamides can only be used with passive and semi-passive systems and not with active treatment systems, because they will usually produce a gelatinous flock which contains a high percentage of water and will stick/bind to the filtration media (i.e. Sand, Screens, etc.) making it difficult to backwash and clean

APPLICATION METHODS

HaloKlear products achieve significant water quality results in active, semi-passive and passive treatment systems.



HaloKlear DPS “Passive” Treatment Model:

- Acrylamide-free treatment system
- Lowest maintenance requirement
- No mechanized equipment requirement
- Can reduce footprint by up to 50%
- Minimizes or eliminates need for water storage
- Actual flow range dependent on Best Management Practice (BMP) design and frequency/severity of storm events
- Uses natural filtration and settling to reduce costs
- A cost-effective model for meeting EPA & ELG requirements
- Easily applied to new and existing BMPs
- Lowest cost treatment system

TYPICAL RESULTS:
50-250
NTU



The bottle on the far left shows untreated water while the bottle on the right shows water treated with HaloKlear’s new Dual Product System. The picture at right shows the “flocked” soil.



HaloKlear DPS “Semi-Passive” Treatment Model:

- Delivers consistent results
- Acrylamide-free treatment system
- Low maintenance requirement
- Low mechanized equipment requirement
- Significantly reduces footprint compared to traditional active treatment systems
- Does not require backwashing
- Requires HaloKlear SockMaster™ Manifold kit & pump; rated 100-500 GPM
- Low cost compared to traditional active treatment systems
- May use coarse filtration, settling, or both to improve cost effectiveness
- Plug-in-play a variety of configurations including: BMPs, dewatering bags, and recirculation systems
- May be used in conjunction with passive treatment models
- May involve contaminant and nutrient removal

TYPICAL RESULTS:
**20-50
NTU**

HaloKlear DPS “Active” Treatment Model:

- Delivers consistent results
- Acrylamide-free treatment system
- Identical footprint to traditional active treatment systems
- Reduced frequency of backwashing compared to traditional active treatment systems
- Actual flow range dependent on mechanized equipment and pumping capabilities
- Can reduce operational costs compared to traditional active treatment systems
- The use of HaloKlear natural flocculants enhances the efficiency of most filtration equipment used in active treatment systems, by aiding the capture of finer solids, reducing the frequency of back-wash, allowing faster settling of particles in settling tanks, and providing solids/contaminants that have a lower percentage of water, which reduces hauling and disposal costs.

TYPICAL RESULTS:
**10-35
NTU**

INDUSTRIES

In the field, we all face the same problem – we must return water to the environment that meets discharge guidelines. HaloKlear products are a complete line of cost-effective, innovative products that will meet your needs today. These products are not only safe for the environment, but they have helped our customers solve their discharge problems, while enhancing project economics in industries like:



ACCESSORIES

-  Convenient
-  Economical
-  Reliable
-  Dependable
-  Added Safety Layer


HaloKlear Residual Test Kit

The HaloKlear Residual Test Kit uses proven test methods for detecting the presence of free residual chitosan before it can leave the job site. Compared to other test kits, this kit improves accuracy by up to 25%. You can achieve results without the hassle of using outside labs, while ensuring you are compliant with local and federal discharge regulations.



HaloKlear DPS Jar Test Kit

The HaloKlear DPS Jar Test Kit can be used with the HaloKlear DPS Dose Calculator to determine the proper flocculant dose for your water clarification needs. The HaloKlear DPS Dose Calculator, available for download at www.dober.com/water_treatment/haloklear.php, will provide the total quantity of products required in 275-gal totes, 55-gal drums, flocculant socks and dry powder/flake.

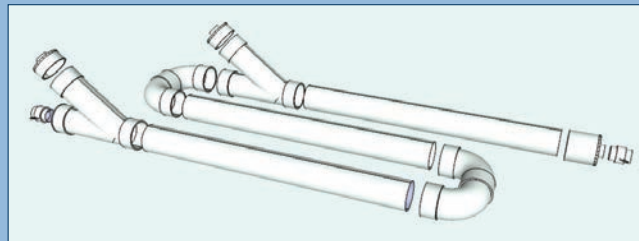

HaloKlear SockMaster Manifold Kit

The HaloKlear SockMaster Manifold Kit, combined with three 10-ft sections of 6-in PVC schedule-40 pipe obtained locally (not included), provides all of the parts required to quickly and easily assemble a complete HaloKlear SockMaster Manifold. The assembled manifold houses the HaloKlear Dual Product System (DPS) sock sets during semi-passive stormwater and wastewater treatment applications. The HaloKlear SockMaster Manifold Kit comes complete with easy to follow assembly instructions and diagram.

ACCREDITATIONS



Haloklear®

NATURAL FLOCCULANTS

OUR COMMITMENT TO OUR CUSTOMERS

Additional Strategic Value

- ✓ We provide education and development for your sales team. Our team encourages you to reach out to schedule a joint sales call or request access to our Dober Digital Lab.
- ✓ In addition to your sales team, we provide on-site training and development for your field staff.
 - We treat your sample in our lab, and then work with you to apply our findings to your field site.

SEND US YOUR SAMPLE!

We will work directly with you on-site and in our corporate lab to make sure you have the best possible product and treatment.

 11230 Katherine's Crossing | Woodridge, IL 60517

 Phone: 630.410.7300 | Toll Free: 800.323.4983

 www.dober.com

DOBER



Performance Media for Water Filtration

Removes iron, manganese, hydrogen sulfide, arsenic and radium.

GreensandPlus™ is a black filter media used for removing soluble iron, manganese, hydrogen sulfide, arsenic and radium from groundwater supplies.

The manganese dioxide coated surface of GreensandPlus acts as a catalyst in the oxidation reduction reaction of iron and manganese.

The silica sand core of GreensandPlus allows it to withstand waters that are low in silica, TDS and hardness without breakdown.

GreensandPlus is effective at higher operating temperatures and higher differential pressures than standard manganese greensand. Tolerance to higher differential pressure can provide for longer run times between backwashes and a greater margin of safety.

Systems may be designed using either vertical or horizontal pressure filters, as well as gravity filters.

GreensandPlus is a proven technology for iron, manganese, hydrogen sulfide, arsenic and radium removal. Unlike other media, there is no need for

extensive preconditioning of filter media or lengthy startup periods during which required water quality may not be met.


GreensandPlus is an exact replacement for manganese greensand. It can be used in CO or IR applications and requires no changes in backwash rate or times or chemical feeds.

GreensandPlus has the WQA Gold Seal Certification for compliance with NSF/ANSI 61.

REACH Registration
 01-2119452801-43-0020
 for import to the EU.


Packaging is available in 1/2 cubic foot bags or 1 metric ton (2,205 lbs) bulk sacks.

GREENSANDPLUS PRESSURE DROP (CLEAN BED)

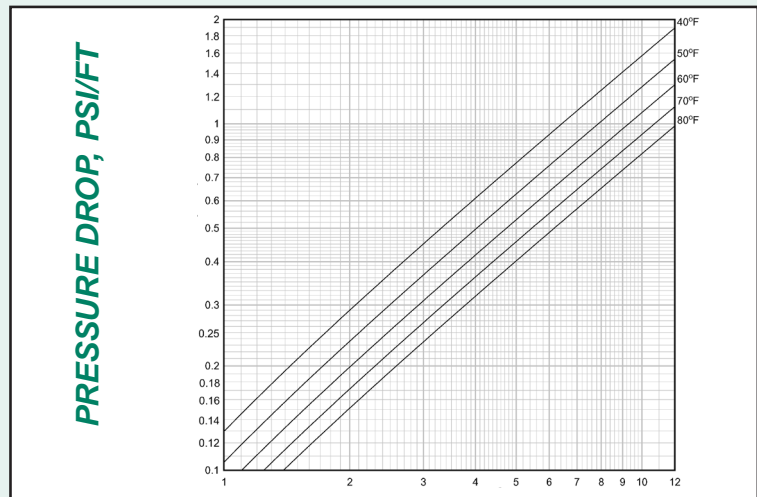

FLOW RATE (GPM/FT²)

BED EXPANSION DURING BACKWASHING

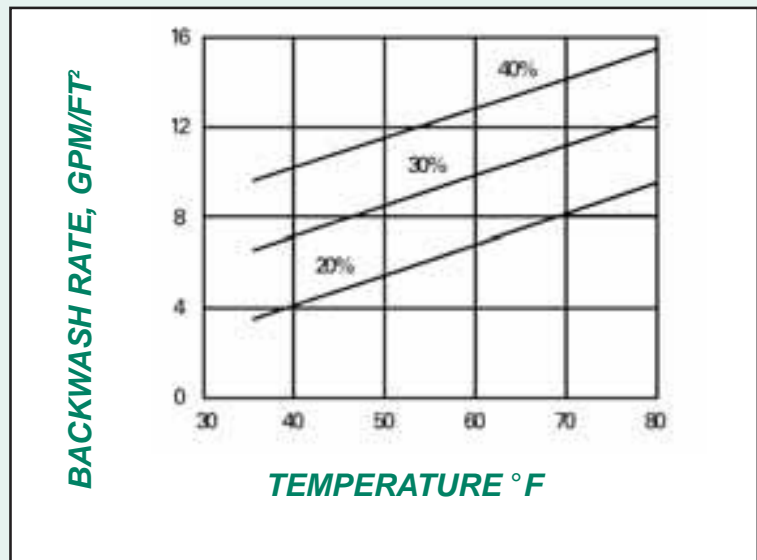

BACKWASH RATE, GPM/FT²

TEMPERATURE °F

PHYSICAL CHARACTERISTICS

Physical Form

Black, nodular granules shipped in a dry form

Apparent Density

88 pounds per cubic foot net (1410.26 kg/m³)

Shipping Weight

90 pounds per cubic foot gross (1442.31 kg/m³)

Specific Gravity

Approximately 2.4

Porosity

Approximately 0.45

Screen Grading (dry)

18 X 60 mesh

Effective Size

0.30 to 0.35 mm

Uniformity Coefficient

Less than 1.60

pH Range

6.2-8.5 (see General Notes)

Maximum Temperature

No limit

Backwash Rate

Minimum 12 gpm/sq. ft. at 55°F (29.4 m/hr @ 12.78°C)
(see expansion chart)

Service Flow Rate


2 -12 gpm/sq. ft (4.9m/hr - 29.4 m/hr)

Minimum Bed Depth

15 inches (381 mm) of each media for dual media beds or 30 inches minimum (762 mm) of GreensandPlus alone.

METHOD OF OPERATION CO

GreensandPlus: Catalytic Oxidation (CO)

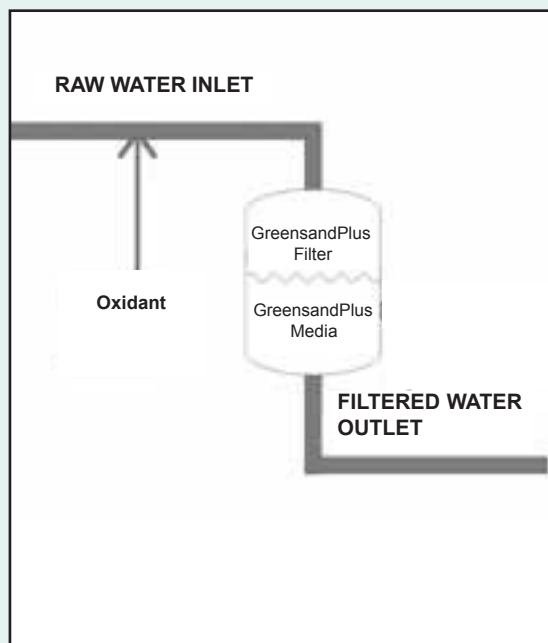

Catalytic Oxidation (CO) operation is recommended in applications where iron removal is the main objective in well waters with or without the presence of manganese. This method involves the feeding of a predetermined amount of chlorine (Cl₂) or other strong oxidant directly to the raw water before the GreensandPlus Filter.

Chlorine should be fed at least 10-20 seconds upstream of the filter, or as far upstream of the filter as possible to insure adequate contact time. A free chlorine residual carried through the filter will maintain GreensandPlus in a continuously regenerated condition.

For operation using chlorine, the demand can be estimated as follows:

$$\text{mg/L Cl}_2 = (1 \times \text{mg/L Fe}) + (3 \times \text{mg/L Mn}) + (6 \times \text{mg/L H}_2\text{S}) + (8 \times \text{mg/L NH}_3)$$

SUGGESTED OPERATING CONDITIONS

Bed Type

Dual media: anthracite 15-18 in. (381 mm - 457 mm) and GreensandPlus 15-24 in. (381 mm - 610 mm)

Capacity

700-1200 grains of oxidized iron and manganese/sq.ft. of bed area based on oxidant demand and operation to iron break through or dp limitations.

Backwash

Sufficient rate using treated water to produce 40% bed expansion until waste water is clear, or for 10 minutes, whichever occurs first.

Air/Water Scour

Optional using 0.8-2.0 cfm/sq. ft. (15 m/hr - 7 m/hr) with a simultaneous treated water backwash at 4.0-4.5 gpm/sq. ft. (9.8 m/hr - 11.03 m/hr).

Raw Water Rinse

At normal service flow rate for 3 minutes or until effluent is acceptable.

Flow Rate

Recommended flow rates with CO operation are 2-12 gpm/sq. ft. (4.9 m/hr - 29.4 m/hr). High concentrations of iron and manganese usually require lower flow rates for equivalent run lengths. Higher flow rates can be considered with very low concentrations of iron and manganese. For optimizing design parameters, pilot plant testing is recommended. The run length between backwashes can be estimated as follows:

What is the run length for a water containing 1.7 mg/L iron and 0.3 mg/L manganese at a 4 gpm/sq. ft. service rate:

Contaminant loading

$$\begin{aligned} &= (1 \times \text{mg/L Fe}) + (2 \times \text{mg/L Mn}) \\ &= (1 \times 1.7) + (2 \times 0.3) \\ &= (2.3 \text{ mg/L or } 2.3/17.1 = 0.13 \\ &\quad \text{grains/gal. (gpg)} \end{aligned}$$

At 1,200 grains / sq. ft. loading \div 0.13 gpg
= 9,230 gal./sq. ft.

At 4 gpm / sq. ft. service rate $9,230/4$
= 2,307 min.

The backwash frequency is approximately every 32-38 hours of actual operation.

The Intermittent regeneration (IR) operation is available for certain applications. Contact your Inversand representative for additional information.

GENERAL NOTES

pH

Raw waters having natural pH of 6.2 or above can be filtered through GreensandPlus without pH correction. Raw waters with a pH lower than 6.2 should be pH-corrected to 6.5-6.8 before filtration. Additional alkali should be added following the filters if a pH higher than 6.5-6.8 is desired in the treated water. This prevents the possible adverse reaction and formation of a colloidal precipitate that sometimes occurs with iron and alkali at a pH above 6.8.

Initial Conditioning of GreensandPlus

GreensandPlus media must be backwashed prior to adding the anthracite cap. The GreensandPlus backwash rate must be a minimum of 12 gpm/sq. ft. @ 55° F.

After backwashing is complete, the GreensandPlus must be conditioned. Mix 0.5 gal. (1.9 L) of 6% household bleach or 0.2 gal (0.75 L) of 12% sodium hypochlorite for

Initial Conditioning of GreensandPlus

every 1 cu. ft. (28.3 L cu. m) of GreensandPlus into 6.5 gallons (25 L) of water.

Drain the filter enough to add the diluted chlorine mix. Apply the diluted chlorine to the filter being sure to allow the solution to contact the GreensandPlus media. Let soak for a minimum of 4 hours, then rinse to waste until the "free" chlorine residual is less than 0.2 mg/L. The GreensandPlus is now ready for service.

REFERENCES

USA

American Water Company, CA
San Jacinto, CA
City of Tallahassee, FL
Adedge Technologies, Inc., Buford, GA
City of Mason City, IL
City of Goshen, IN
City of Hutchinson, KS
City of Burlington, MA
Dedham Water Co., MA
Raynham Center, MA
Northbrook Farms, MD
Sykesville, MD
Tonka Equipment Company, Plymouth, MN
City of New Bern, NC
Onslow County, NC
Hungerford & Terry, Inc., Clayton, NJ
Fort Dix, NJ
Jackson Twsp. MUA, NJ

Radium and Arsenic Removal Using GreensandPlus

The GreensandPlus CO process has been found to be successful in removing radium and arsenic from well water. This occurs via adsorption onto the manganese and/or iron precipitates that are formed. For radium removal, soluble manganese must be present in or added to the raw water for removal to occur. Arsenic removal requires iron to be present in or added to the raw water to accomplish removal. Pilot plant testing is recommended in either case.

USA

Churchill County, NV
Suffolk County Water Authority, NY
City of Urbana, OH
Roberts Filter Group, Darby, PA

International

Watergroup, Saskatoon, SK Canada
BI Pure Water, Surrey, BC Canada
Sydney, Nova Scotia, Canada
PT Beta Pramesta, Jakarta, Indonesia
PT Besflo Prima, Jakarta, Indonesia
Eurotrol, Milanese, Italy
Gargon Industrial, Mexico City, Mexico
River Sands Pty. Ltd., Queensland, Australia
Filtration Tech, Auckland, New Zealand
Alamo Water Poland, Izabeln, Poland
Aquatrol Company, Moscow, Russia
Impulse Group, St. Petersburg, Russia
Brenntag Nordic, Taby, Sweden
EcoFilter Technology, Liechtenstein



The manufacturing of GreensandPlus is an ongoing, 24/7 process to ensure the highest quality water treatment media.

REACH Registration
01-2119452801-43-0020
for import to the EU.

Distributed by:



Inversand Company
SINCE 1925

226 Atlantic Avenue • P.O. Box 650
Clayton, NJ 08312 USA
T: 856-881-2345 • F: 856-881-6859

E: info@inversand.com • www.inversand.com

Disclaimer: The information and recommendations in this publication are true and reliable to the best of our knowledge. These recommendations are offered in good faith but without warranty or liability for consequential damage as conditions and method of use of our products are varied and beyond our control. We suggest the user determine the suitability and performance of our products before they are adopted on a commercial scale.



HaloKlear DBP-2100 Socks

Safety Data Sheet

according to Federal Register / Vol. 77, No. 58 / Monday, March 26, 2012 / Rules and Regulations

Date of issue: 03/24/2016 Version: 1.0

SECTION 1: Identification of the substance/mixture and of the company/undertaking

1.1. Product identifier

Product form : Substance
Substance name : HaloKlear DBP-2100 Socks
Chemical name : Xanthan Gum
CAS No : 11138-66-2
Product code : 210014

1.2. Relevant identified uses of the substance or mixture and uses advised against

Use of the substance/mixture : Flocculant

1.3. Details of the supplier of the safety data sheet

Dober Chemical Corp.
11230 Katherine's Crossing
Suite 100
Woodridge, IL 60517 - USA
T 630-410-7300 - F 630-410-7444
regulatory@dobergroup.com - www.dober.com

1.4. Emergency telephone number

Emergency number : 1-800-255-3924 / 1-813-248-0585
ChemTel

SECTION 2: Hazards identification

2.1. Classification of the substance or mixture

GHS-US classification

Not classified

2.2. Label elements

GHS-US labelling

No labelling applicable

2.3. Other hazards

Other hazards not contributing to the classification : May form combustible dust concentrations in air. May cause eye irritation.

2.4. Unknown acute toxicity (GHS-US)

Not applicable

SECTION 3: Composition/information on ingredients

3.1. Substance

Substance type : Mono-constituent
Name : HaloKlear DBP-2100 Socks
CAS No : 11138-66-2

Full text of H-statements: see section 16

3.2. Mixture

Not applicable

4.1. Description of first aid measures

First-aid measures general : Never give anything by mouth to an unconscious person. If you feel unwell, seek medical advice (show the label where possible).
First-aid measures after inhalation : Allow breathing of fresh air. Allow the victim to rest.
First-aid measures after skin contact : Remove affected clothing and wash all exposed skin area with mild soap and water, followed by warm water rinse.
First-aid measures after eye contact : Rinse immediately with plenty of water. Obtain medical attention if pain, blinking or redness persist.
First-aid measures after ingestion : Rinse mouth. Do NOT induce vomiting. Obtain emergency medical attention.

HaloKlear DBP-2100 Socks

Safety Data Sheet

according to Federal Register / Vol. 77, No. 58 / Monday, March 26, 2012 / Rules and Regulations

4.2. Most important symptoms and effects, both acute and delayed

Symptoms/injuries : Not expected to present a significant hazard under anticipated conditions of normal use.

4.3. Indication of any immediate medical attention and special treatment needed

No additional information available

SECTION 5: Firefighting measures

5.1. Extinguishing media

Suitable extinguishing media : Foam. Dry powder. Carbon dioxide. Water spray. Sand.

Unsuitable extinguishing media : Do not use a heavy water stream.

5.2. Special hazards arising from the substance or mixture

Reactivity : The product is non-reactive under normal conditions of use, storage and transport.

5.3. Advice for firefighters

Firefighting instructions : Exercise caution when fighting any chemical fire. Eliminate all ignition sources if safe to do so. Use water spray or fog for cooling exposed containers.

Protection during firefighting : Do not enter fire area without proper protective equipment, including respiratory protection.

Other information : Spills produce extremely slippery surfaces. Avoid dust formation.

SECTION 6: Accidental release measures

6.1. Personal precautions, protective equipment and emergency procedures

General measures : Use special care to avoid static electric charges.

6.1.1. For non-emergency personnel

Emergency procedures : Evacuate unnecessary personnel.

6.1.2. For emergency responders

Protective equipment : Equip cleanup crew with proper protection.

Emergency procedures : Ventilate area.

6.2. Environmental precautions

None known.

6.3. Methods and material for containment and cleaning up

Methods for cleaning up : On land, sweep or shovel into suitable containers. Minimize generation of dust. Store away from other materials.

6.4. Reference to other sections

See Heading 8. Exposure controls and personal protection.

SECTION 7: Handling and storage

7.1. Precautions for safe handling

Precautions for safe handling : Wash hands and other exposed areas with mild soap and water before eating, drinking or smoking and when leaving work. Provide good ventilation in process area to prevent formation of vapour. No smoking.

7.2. Conditions for safe storage, including any incompatibilities

Storage conditions : Keep only in the original container in a cool, well-ventilated place. Keep container closed when not in use.

Incompatible products : Oxidizing agent.

Incompatible materials : Sources of ignition.

7.3. Specific end use(s)

No additional information available

SECTION 8: Exposure controls/personal protection

8.1. Control parameters

HaloKlear DBP-2100 Socks (11138-66-2)	
ACGIH	Not applicable
OSHA	Not applicable

HaloKlear DBP-2100 Socks

Safety Data Sheet

according to Federal Register / Vol. 77, No. 58 / Monday, March 26, 2012 / Rules and Regulations

8.2. Exposure controls

Personal protective equipment	: Avoid all unnecessary exposure.
Hand protection	: Wear protective gloves/protective clothing/eye protection/face protection protective gloves.
Eye protection	: Chemical goggles or safety glasses.
Respiratory protection	: Use a properly fitted, particulate filter respirator complying with an approved standard if a risk assessment indicates this is necessary. Respirator selection must be based on known or anticipated exposure levels, the hazards of the product and the safe working limits of the selected respirator.
Other information	: Do not eat, drink or smoke during use.

SECTION 9: Physical and chemical properties

9.1. Information on basic physical and chemical properties

Physical state	: Solid
Colour	: White to tan
Odour	: odourless
Odour threshold	: No data available
pH	: approximately neutral (1% solution)
Relative evaporation rate (butylacetate=1)	: No data available
Melting point	: No data available
Freezing point	: No data available
Boiling point	: No data available
Flash point	: No data available
Auto-ignition temperature	: No data available
Decomposition temperature	: No data available
Flammability (solid, gas)	: No data available
Vapour pressure	: No data available
Relative vapour density at 20 °C	: No data available
Relative density	: No data available
Solubility	: Water: 100 %
Log Pow	: No data available
Log Kow	: No data available
Viscosity, kinematic	: No data available
Viscosity, dynamic	: No data available
Explosive properties	: No data available
Oxidising properties	: No data available
Explosive limits	: No data available

9.2. Other information

No additional information available

SECTION 10: Stability and reactivity

10.1. Reactivity

The product is non-reactive under normal conditions of use, storage and transport.

10.2. Chemical stability

Stable under normal conditions.

10.3. Possibility of hazardous reactions

No dangerous reactions known under normal conditions of use.

10.4. Conditions to avoid

Avoid dust formation.

10.5. Incompatible materials

Oxidizing agent.

10.6. Hazardous decomposition products

Thermal decomposition generates : Carbon dioxide. Carbon monoxide. Fume.

HaloKlear DBP-2100 Socks

Safety Data Sheet

according to Federal Register / Vol. 77, No. 58 / Monday, March 26, 2012 / Rules and Regulations

SECTION 11: Toxicological information

11.1. Information on toxicological effects

Acute toxicity	: Not classified
Skin corrosion/irritation	: Not classified pH: approximately neutral (1% solution)
Serious eye damage/irritation	: Not classified pH: approximately neutral (1% solution)
Respiratory or skin sensitisation	: Not classified
Germ cell mutagenicity	: Not classified
Carcinogenicity	: Not classified
Reproductive toxicity	: Not classified
Specific target organ toxicity (single exposure)	: Not classified
Specific target organ toxicity (repeated exposure)	: Not classified
Aspiration hazard	: Not classified
Potential adverse human health effects and symptoms	: Based on available data, the classification criteria are not met.

SECTION 12: Ecological information

12.1. Toxicity

HaloKlear DBP-2100 Socks (11138-66-2)	
LC50 fish 1	491 mg/l Rainbow Trout; 96 hour

12.2. Persistence and degradability

HaloKlear DBP-2100 Socks (11138-66-2)	
Persistence and degradability	This product is biodegradable.

12.3. Bioaccumulative potential

HaloKlear DBP-2100 Socks (11138-66-2)	
Bioaccumulative potential	Inherently biodegradable.

12.4. Mobility in soil

HaloKlear DBP-2100 Socks (11138-66-2)	
Mobility in soil	Not available

12.5. Other adverse effects

Effect on the global warming	: No known ecological damage caused by this product.
Other information	: No other effects known.

SECTION 13: Disposal considerations

13.1. Waste treatment methods

Waste treatment methods	: Dispose of contents/container in accordance with licensed collector's sorting instructions.
Ecology - waste materials	: None known.

SECTION 14: Transport information

UN-No. (DOT)	: Non Regulated
UN-No. (IMDG)	: Non Regulated
UN-No. (IATA)	: Non Regulated

14.2. UN proper shipping name

Proper Shipping Name (DOT)	: Not applicable
----------------------------	------------------

HaloKlear DBP-2100 Socks

Safety Data Sheet

according to Federal Register / Vol. 77, No. 58 / Monday, March 26, 2012 / Rules and Regulations

Proper Shipping Name (IMDG) : Not applicable

Proper Shipping Name (IATA) : Not applicable

14.3. Transport hazard class(es)

Transport hazard class(es) (DOT) : Not applicable

:

Transport hazard class(es) (IMDG) : Not applicable

Transport hazard class(es) (IATA) : Not applicable

14.4. Packing group

Packing group (DOT) : Not applicable

Packing group (IMDG) : Not applicable

Packing group (IATA) : Not applicable

14.5. Environmental hazards

Marine pollutant(IMDG) : No

Marine pollutant(IATA) : No

SECTION 15: Regulatory information

15.1. US Federal regulations

All components of this product are listed, or excluded from listing, on the United States Environmental Protection Agency Toxic Substances Control Act (TSCA) inventory

This product or mixture does not contain a toxic chemical or chemicals in excess of the applicable de minimis concentration as specified in 40 CFR §372.38(a) subject to the reporting requirements of section 313 of Title III of the Superfund Amendments and Reauthorization Act of 1986 and 40 CFR Part 372.

15.2. International regulations

CANADA

No additional information available

15.3. US State regulations

California Proposition 65 - This product does not contain any substances known to the state of California to cause cancer, developmental and/or reproductive harm

SECTION 16: Other information


Other information : None.

NFPA health hazard : 0 - Exposure under fire conditions would offer no hazard beyond that of ordinary combustible materials.

NFPA fire hazard : 0 - Materials that will not burn.

NFPA reactivity : 0 - Normally stable, even under fire exposure conditions, and are not reactive with water.

NFPA specific hazard : NA - Not Applicable

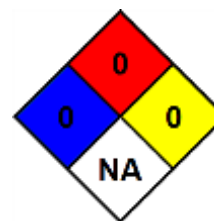

HaloKlear DBP-2100 Socks

Safety Data Sheet

according to Federal Register / Vol. 77, No. 58 / Monday, March 26, 2012 / Rules and Regulations

HMIS III Rating

Health	: 0 - No significant risk to health
Flammability	: 0
Physical	: 0
Personal Protection	: B

Dober SDS US

To the best of our knowledge, the information contained herein is accurate. However, neither the above-named supplier, nor any of its subsidiaries, assumes any liability whatsoever for the accuracy or completeness of the information contained herein. Final determination of suitability of any material is the sole responsibility of the user. All materials may present unknown hazards and should be used with caution. Although certain hazards are described herein, we cannot guarantee that these are the only hazards that exist.

BHR-P50

HYBRID FLOCCULANT

Description

HaloKlear's unique hybrid flocculant, **BHR-P50**, offers a greener alternative to commodity chemicals. Our blend is free of acrylamide monomers and is part of our continued efforts to innovate towards more eco-friendly water treatment solutions. From industrial wastewater clarification to nutrient control in ponds and lakes, **BHR-P50** offers a wide range of performance benefits without increasing costs.

Industry Applications

- Stormwater management
- Construction
- Environmental Water remediation

Deployment Method

The liquid **BHR-P50** is deployed similar to commodity polyaluminum chloride. Typical application uses metering pumps. **BHR-P50** can be applied using several delivery methods, including semi-passive and active systems.

Packaging

Lot Number must be legible on each container. Container types: 275-gallon IBC tote with camlock or threaded outlet or 55-gallon drum.

Handling and Storage

All containers must be free of leaks, damage, and gross contamination. Product should be maintained between 40°F and 90°F. Keep from freezing.

Product Benefits

- High Shear Strength & Filterability
- Dense Floc That is Easily Dewaterable
- Low Bioaccumulation of Inorganic Salts
- Low Ecotoxicity Profile
- Effective Across a Wide Spectrum of pH and Salinity.
- Tested & Approved to Standard 60 for Drinking Water Treatment

Product Properties

Appearance	Homogenous white-to-yellow opaque liquid
Viscosity	500 – 1,300 cP
Specific Gravity	0.95 – 1.15
pH	2.3 – 3.7
LC50 fish 1	3222 ppm Rainbow Trout; 96 hour

Field Handling Recommendations

Keep out of direct sunlight. Some separation may occur but will not affect performance. For more information, contact your Dober representative.

Safety Data

BHR-P50 is a corrosive substance. Before handling this material read the corresponding Material Safety Data Sheet for safety and health data.

For additional information contact Dober at:

(800) 323-4983

info@dober.com

www.dober.com/water_treatment



DOBER



Model PF 400

Particulate Filter

Features

- Quadruple bag and double cartridge filtration
- Four (4) bag filters for high solids holding capacity
- Two (2) multiple cartridge filters for fine solids removal
- Replaceable filtration cartridges from 100 to .5 micron nominal rating
- Manifold valving for ease of use
- Isolation valving for ease of service
- No moving parts
- Separate sampling ports for all chambers

Technical

- Bag filters are used with cartridge filters, in series, to provide efficient filtration
- Units fitted with bleed valves and pressure gauges
- Initial pressure drop is less than 5 psi at 400 gpm
- System can stand alone for sediment removal or be used in combination with media vessels
- Multiple cartridge filters provide large surface area for longer service life
- Skid footprint: 90" long x 84" wide x 72" high
- Skid dry weight: 2,400 lbs

Material Specifications

- Chambers constructed of 304 Stainless Steel
- Piping constructed of 304 Stainless Steel
- 3", 150 lb flange inlet and outlet
- Each bag filter chamber holds one (1) 7" x 30" double-stitched filter bag
- Each cartridge chamber holds twelve (12) 40" single open-ended cartridges with 2-1/2" OD and 1" ID
- Maximum operating pressure: 125 psi
- HDPE pipe and fitting
- Roll off boxes, dewatering bins and vacuum boxes
- Flow meters and pressure reducing/ sustaining valves
- Aluminum Victaulic pipe and fittings
- Suction and discharge hose

Available Accessories

- Power Prime Pumps
- Spill Guard Containment berms
- Stainless Steel 304 and Carbon Steel storage tanks
- in Bi-Level, Mixer, Weir and Manifold configurations
- HDPE pipe and fittings
- Roll off boxes, dewatering bins and vacuum boxes
- Flow meters and pressure reducing/sustaining valves
- Aluminum Victaulic pipe and fittings
- Suction and discharge hose



Maximum PSI: 125
Maximum Flow: 400 GPM



Rain for Rent
P.O. Box 2248
Bakersfield CA 93303
800-742-7246
661-393-1542
FAX 661-393-1542
www.rainforrent.com
info@rainforrent.com

Rain for Rent is a registered trademark of Western Oilfields Supply Company. Features and Specifications are subject to change without notice.

Purolite® A600

Polystyrenic Gel, Type I Strong
Base Anion Resin, Chloride form

PRINCIPAL APPLICATIONS

- Demineralization - Industrial
- Silica Removal

ADVANTAGES

- Efficient regeneration

REGULATORY APPROVALS

- IFANCA Halal Certified
- Kosher Certified

TYPICAL PACKAGING

- 1 ft³ Sack
- 25 L Sack
- 5 ft³ Drum (Fiber)
- 1 m³ Supersack
- 42 ft³ Supersack

TYPICAL PHYSICAL & CHEMICAL CHARACTERISTICS:

Polymer Structure	Gel polystyrene crosslinked with divinylbenzene
Appearance	Spherical Beads
Functional Group	Type I Quaternary Ammonium
Ionic Form	Cl ⁻ form
Total Capacity	1.4 eq/L (30.6 Kgr/ft³) (Cl ⁻ form)
Moisture Retention	43 - 48 % (Cl ⁻ form)
Particle Size Range	300 - 1200 µm
< 300 µm (max.)	1 %
Uniformity Coefficient (max.)	1.7
Reversible Swelling, Cl ⁻ → OH ⁻ (max.)	20 %
Specific Gravity	1.09
Shipping Weight (approx.)	685 - 720 g/L (42.8 - 45.0 lb/ft³)
Temperature Limit	100 °C (212.0 °F) (Cl ⁻ form)
Temperature Limit	60 °C (140.0 °F) (OH ⁻ form)



Americas
T +1 610 668 9090
F +1 610 668 8139
americas@purolite.com

EMEA
T +44 1443 229334
F +44 1443 227073
europe@purolite.com


Asia Pacific
T +86 571 876 31382
F +86 571 876 31385
asiapacific@purolite.com

Hydraulic Characteristics

PRESSURE DROP

The pressure drop across a bed of ion exchange resin depends on the particle size distribution, bed depth, and voids volume of the exchange material, as well as on the flow rate and viscosity of the influent solution. Factors affecting any of these parameters—such as the presence of particulate matter filtered out by the bed, abnormal compressibility of the resin, or the incomplete classification of the bed—will have an adverse effect, and result in an increased head loss. Depending on the quality of the influent water, the application and the design of the plant, service flow rates may vary from 10 to 40 BV/h.


PRESSURE DROP ACROSS RESIN BED

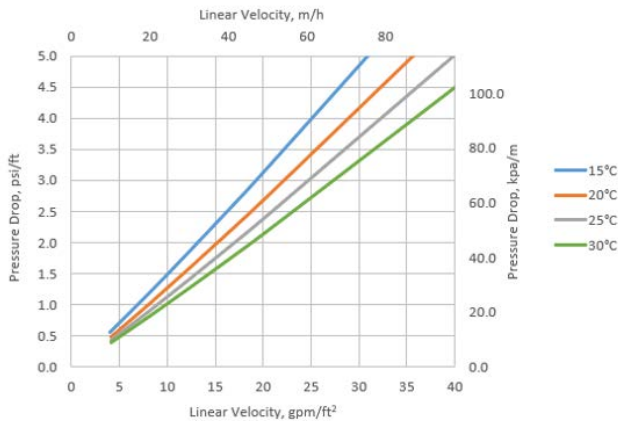

BACKWASH

During up-flow backwash, the resin bed should be expanded in volume between 50 and 70% for at least 10 to 15 minutes. This operation will free particulate matter, clear the bed of bubbles and voids, and reclassify the resin particles ensuring minimum resistance to flow. When first putting into service, approximately 30 minutes of expansion is usually sufficient to properly classify the bed. It is important to note that bed expansion increases with flow rate and decreases with influent fluid temperature. Caution must be taken to avoid loss of resin through the top of the vessel by over expansion of the bed.

BACKWASH EXPANSION OF RESIN BED

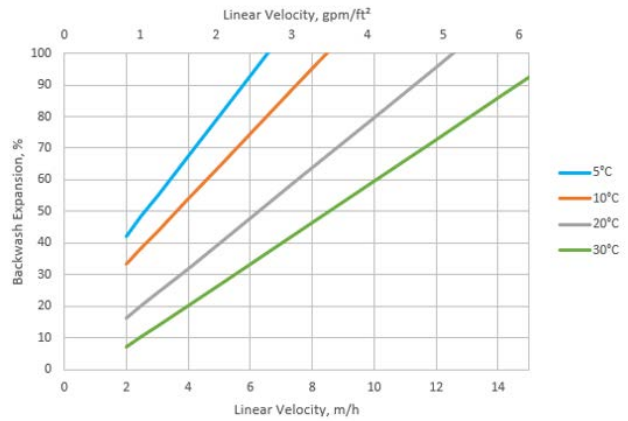

Americas
 T +1 610 668 9090
 F +1 610 668 8139
 americas@purolite.com

EMEA
 T +44 1443 229334
 F +44 1443 227073
 europe@purolite.com

Asia Pacific
 T +86 571 876 31382
 F +86 571 876 31385
 asiapacific@purolite.com

Purolite® C100

Polystyrenic Gel, Strong Acid Cation Resin, Sodium form

PRINCIPAL APPLICATIONS

- Softening - Industrial
- Industrial demineralization when regenerated with acids

ADVANTAGES

- High operating capacity
- Good kinetic performance
- Excellent physical and chemical stability

SYSTEMS

- Coflow regenerated systems
- Conventional counterflow systems

REGULATORY APPROVALS

- IFANCA Halal Certified
- Kosher Certified
- Certified by the WQA to NSF/ANSI-61 Standard

TYPICAL PACKAGING

- 1 ft³ Sack
- 25 L Sack
- 5 ft³ Drum (Fiber)
- 1 m³ Supersack
- 42 ft³ Supersack
- Bulk Tanker (North America only)

TYPICAL PHYSICAL & CHEMICAL CHARACTERISTICS:

Polymer Structure	Gel polystyrene crosslinked with divinylbenzene
Appearance	Spherical Beads
Functional Group	Sulfonic Acid
Ionic Form	Na ⁺ form
Total Capacity	2.0 eq/L (43.7 Kgr/ft ³) (Na ⁺ form)
Moisture Retention	44 - 48 % (Na ⁺ form)
Particle Size Range	300 - 1200 µm
< 300 µm (max.)	1 %
Uniformity Coefficient (max.)	1.7
Reversible Swelling, Na ⁺ → H ⁺ (max.)	8 %
Specific Gravity	1.29
Shipping Weight (approx.)	800 - 840 g/L (50.0 - 52.5 lb/ft ³)
Temperature Limit	120 °C (248.0 °F)



Americas
T +1 610 668 9090
F +1 610 668 8139
americas@purolite.com

EMEA
T +44 1443 229334
F +44 1443 227073
europe@purolite.com


Asia Pacific
T +86 571 876 31382
F +86 571 876 31385
asiapacific@purolite.com

Hydraulic Characteristics

PRESSURE DROP

The pressure drop across a bed of ion exchange resin depends on the particle size distribution, bed depth, and voids volume of the exchange material, as well as on the flow rate and viscosity of the influent solution. Factors affecting any of these parameters—such as the presence of particulate matter filtered out by the bed, abnormal compressibility of the resin, or the incomplete classification of the bed—will have an adverse effect, and result in an increased head loss. Depending on the quality of the influent water, the application and the design of the plant, service flow rates may vary from 10 to 40 BV/h.


PRESSURE DROP ACROSS RESIN BED

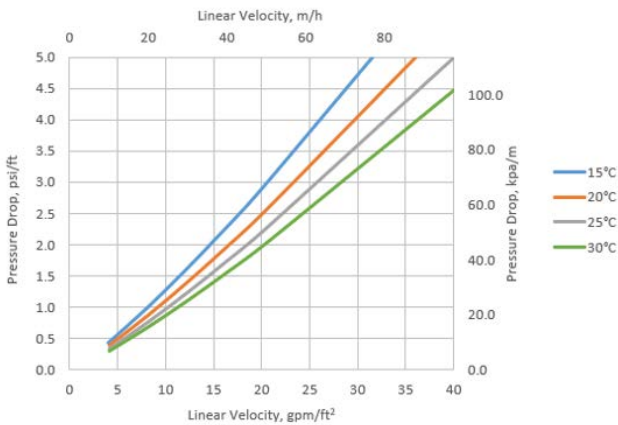

BACKWASH

During up-flow backwash, the resin bed should be expanded in volume between 50 and 70% for at least 10 to 15 minutes. This operation will free particulate matter, clear the bed of bubbles and voids, and reclassify the resin particles ensuring minimum resistance to flow. When first putting into service, approximately 30 minutes of expansion is usually sufficient to properly classify the bed. It is important to note that bed expansion increases with flow rate and decreases with influent fluid temperature. Caution must be taken to avoid loss of resin through the top of the vessel by over expansion of the bed.

BACKWASH EXPANSION OF RESIN BED

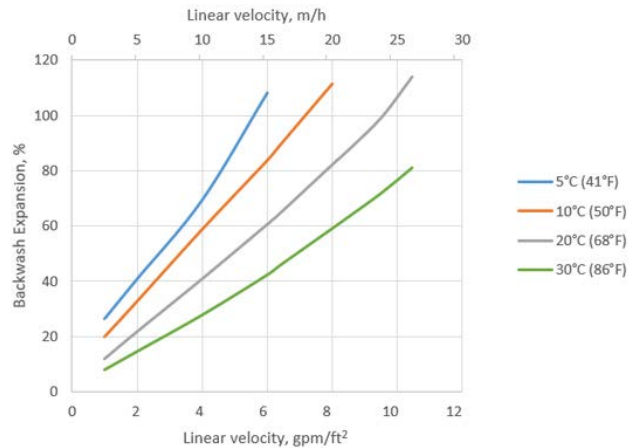

Americas
 T +1 610 668 9090
 F +1 610 668 8139
americas@purolite.com

EMEA
 T +44 1443 229334
 F +44 1443 227073
europe@purolite.com



Asia Pacific
 T +86 571 876 31382
 F +86 571 876 31385
asiapacific@purolite.com



COC – L 60

Coconut Shell Carbon for Water Purification

COC-L60 Granular Activated Carbon (GAC) is manufactured from select grades of coconut shell and features a high density, large micropore volume and high surface area. It's commonly used for the purification of potable water, beverage manufacture, dialysis, aquarium water and a variety of food grade applications. In properly designed systems, **COC-L60** will effectively remove chlorine, chloramines, lead, radon, TCE, PCE, THM's, Phenols, pesticides, detergents, taste & odor, etc. **COC-L60** meets AWWA Standard B-600-74, ANSI/NSF Standard 61 for drinking water applications.

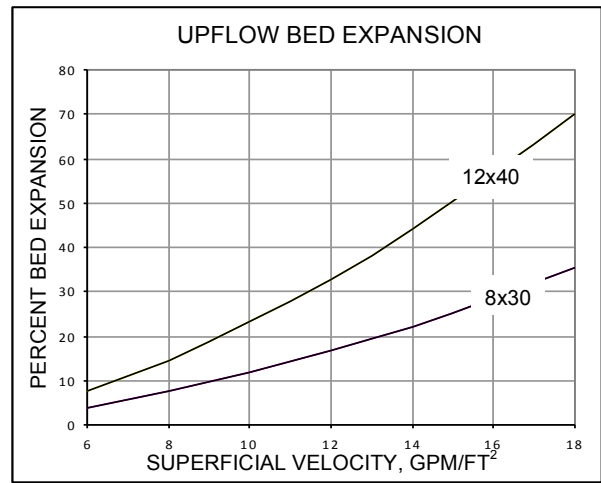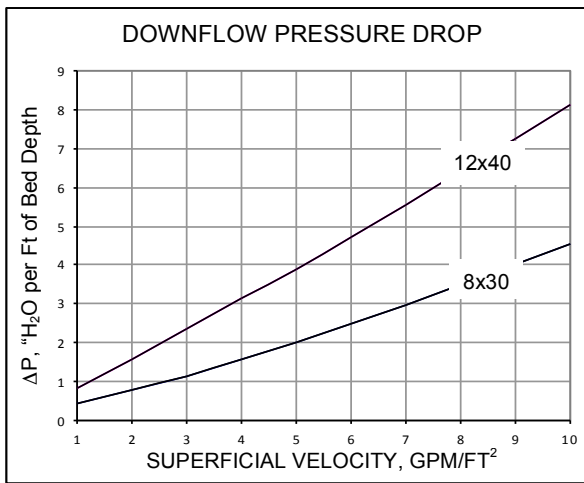

TYPICAL PHYSICAL PROPERTIES / SPECIFICATIONS

Iodine Number	1100
Apparent Density (ASTM 2854), g/cc	0.48 – 0.50
	lb/ft ³
	29-31
Abrasion No., min.	85
Particle Size – mesh size	8x30
	12x40
	20x50
Total Surface Area (BET), m ² /g	1150 - 1200
Ash (ASTM D-2866) -% w/w	3.0
Moisture, max as packed- % w/w	3%



STANDARD PACKAGING:

55lb or 27.5lb POLYLINE D POLYPROPYLENE BAGS. 200lb FIBER DRUMS. 1100lb SUPERSACKS.


This information is offered solely for your consideration and verification. It has been gathered from reference materials and/or test procedures and is believed to be true and accurate. None of this information shall constitute a warranty or representation, expressed or implied for which we assume legal responsibility or that the information or goods is fit for any particular use either alone or in combination with other goods or processes.

HS-200 Organoclay Series Powerful, cost effective industrial water filtration & remediation media

The pressure to minimize water pollution is rising all the time. Stringent industrial water standards mean it's vital to have an effective water filtration system in place. Otherwise you risk liability costs, fines or even the total shutdown of your facility.

Hydrosil's HS-200 organoclay series is the ultimate water filtration material. Long lasting and cost effective, this zeolite based organoclay is an exceptional adsorbent of oil, heavy metals and other contaminants. HS-200 can adsorb up to 70% of its own weight in hydrocarbons and reduce your discharge to acceptable limits.

Hydrosil's HS-200 can be used as filtration media in tanks, upstream for pre-treatment or downstream of an oil-water separator. HS-200 provides highly effective water filtration & remediation that will minimize your environmental impact, avoid the risk of fines and enable you to meet your corporate responsibility goals.

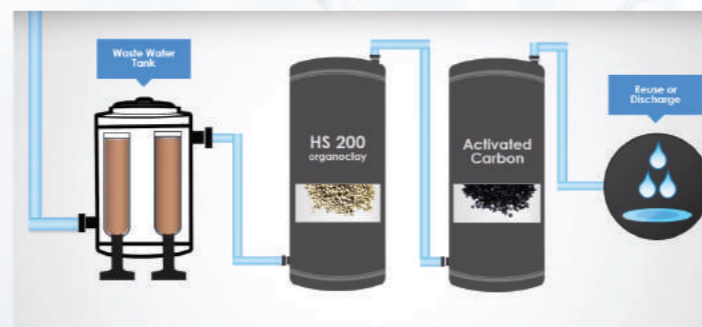

HS-200 The ultimate water filtration material

HS-200's exceptional water cleansing qualities are a result of our proprietary modification process of zeolite. Zeolite has a high adsorption capacity with a porous surface, and our process enlarges its surface area to maximize the amount of pollutants that can be separated and locked away. It's ability to adsorb 70% of its weight makes HS-200 the best material available for separating hydrocarbons, ionic heavy metals, organics and other contaminants on contact.

HS-200 benefits

Highly adsorbent - Can adsorb heavy metals and up to 70% of its weight in hydrocarbons, heavy metals and other contaminants.

No shrinking or swelling - The crystalline rigid framework eliminates shrinking and swelling.

Cation exchange capacity - HS-200 can release beneficial elements while capturing waste products.

Longer lasting - Minimal maintenance and a longer lifespan than other processed organoclays.

More active ingredients - HS-200 provides 333% more active product ingredients per volume than organophilic clay.

Cost Savings - Long lifespan reduces replacement frequency and provides cost savings on labor and reduced wastewater treatment costs.

Customizable - Customized blends available to match your specific water filtration requirements.

Applications

- Pipeline pressure testing runoff
- Dewatering
- Oil industry
- Pulp and paper mills
- Marine applications
- Protection of RO membranes
- Tank and storage vessel cleaning
- Pesticide removal
- Condensate systems
- Industrial water runoff
- Storm water runoff
- Cooling tower water

Multiple ways in which HS-200 can be used in water filtration

Free standing - HS-200 can be loaded into wastewater holding tanks and used for still bed filtration.

Pre-Treatment - Bedded upstream to improve the performance of other filtration processes, including reverse osmosis, activated carbons and resins.

Post-Treatment - Used downstream of an oil-water separator or coalescence filter and used as a cleaning and polishing agent.

Please contact Hydrosil International Ltd. or your Local Distributor.

Hydrosil International Ltd. makes no warranty, either expressed or implied, including any warranties of merchantability and fitness for a particular purpose.



HYDROSIL

INTERNATIONAL LTD.



HYDROSIL
INTERNATIONAL LTD.

HS-200 Series Versatility

Free Standing Mode: Used on its own, HS-200 series can be loaded in drums for use as an efficient filtration media. Other applications include tank cleaning, oil spill mitigation, and lining/capping projects.

Pre-Treatment Mode: HS-200 Series can be used upstream to enhance the performance and extend the useful life of other filtration processes and media such as reverse osmosis, activated carbon and resins.

Post-Treatment Mode: HS-200 Series utilized downstream of an oil-water separator or coalesce filter, has the ability to act as an effective cleaning and polishing agent.

Application Parameters:

Bulk Density: 58 lbs/Ft³ (929 kg/M³)

10 - 15 minutes depending on concentration of contaminant(s) to be removed.


Temperature Range: 33 - 170 F^o (1 -77 C^o)

pH Range: 4 -10

Pre-treatment prior to activated carbon and ion exchange resin columns; Pre-treatment for RO systems; Polishing for oil and water separators and DAF units.



Zeolite Particle Surface (Negative Charged)

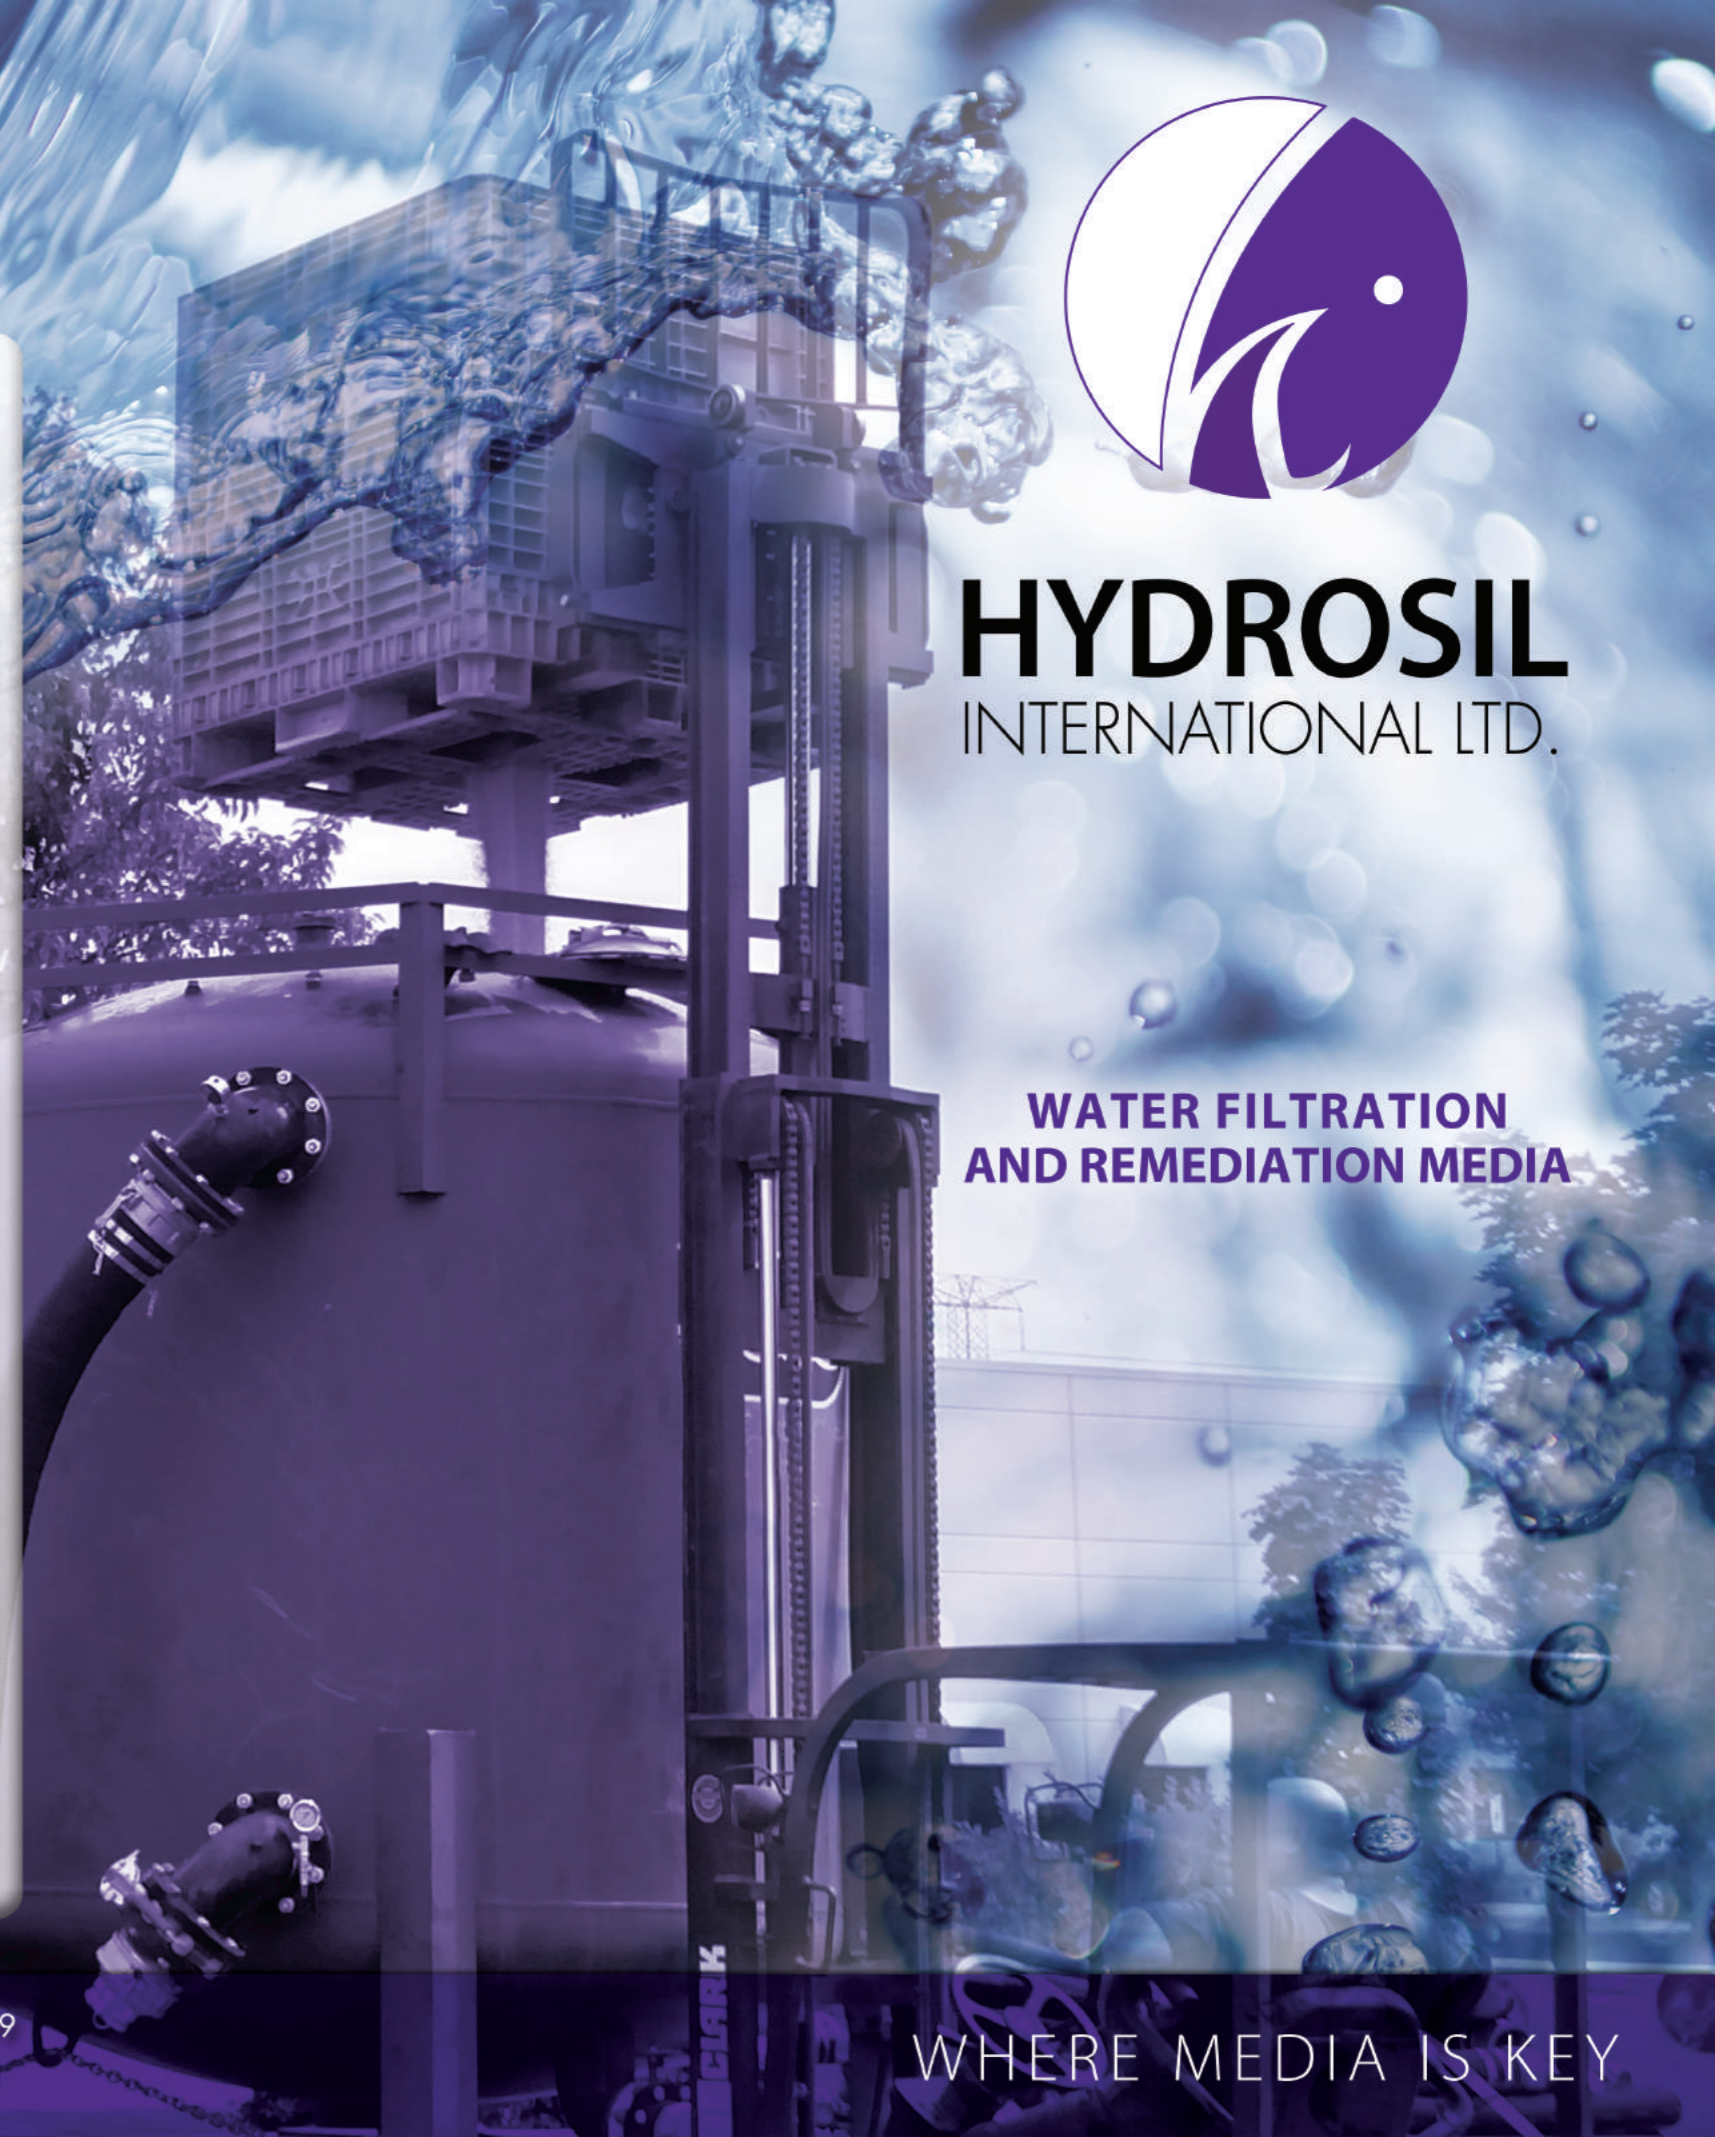

**WATER FILTRATION
AND REMEDIATION MEDIA**

Distributed by:

125 Prairie Lake Road, East Dundee, IL 60118 | 1.847.844.0680 | Fax 1.847.844.0799
1.800.PURPLE.1 | Email sales@hydrosilintl.com | Website www.hydrosilintl.com

WHERE MEDIA IS KEY

ATTACHMENT H



United States Department of the Interior



FISH AND WILDLIFE SERVICE
New England Ecological Services Field Office
70 Commercial Street, Suite 300
Concord, NH 03301-5094
Phone: (603) 223-2541 Fax: (603) 223-0104
<http://www.fws.gov/newengland>

In Reply Refer To:

May 13, 2020

Consultation Code: 05E1NE00-2020-SLI-2547

Event Code: 05E1NE00-2020-E-07653

Project Name: Logan International Airport - Wastewater Treatment Facility Improvements

Subject: List of threatened and endangered species that may occur in your proposed project location, and/or may be affected by your proposed project

To Whom It May Concern:

The enclosed species list identifies threatened, endangered, proposed and candidate species, as well as proposed and final designated critical habitat, that may occur within the boundary of your proposed project and/or may be affected by your proposed project. The species list fulfills the requirements of the U.S. Fish and Wildlife Service (Service) under section 7(c) of the Endangered Species Act (Act) of 1973, as amended (16 U.S.C. 1531 *et seq.*).

New information based on updated surveys, changes in the abundance and distribution of species, changed habitat conditions, or other factors could change this list. Please feel free to contact us if you need more current information or assistance regarding the potential impacts to federally proposed, listed, and candidate species and federally designated and proposed critical habitat. Please note that under 50 CFR 402.12(e) of the regulations implementing section 7 of the Act, the accuracy of this species list should be verified after 90 days. This verification can be completed formally or informally as desired. The Service recommends that verification be completed by visiting the ECOS-IPaC website at regular intervals during project planning and implementation for updates to species lists and information. An updated list may be requested through the ECOS-IPaC system by completing the same process used to receive the enclosed list.

The purpose of the Act is to provide a means whereby threatened and endangered species and the ecosystems upon which they depend may be conserved. Under sections 7(a)(1) and 7(a)(2) of the Act and its implementing regulations (50 CFR 402 *et seq.*), Federal agencies are required to utilize their authorities to carry out programs for the conservation of threatened and endangered species and to determine whether projects may affect threatened and endangered species and/or designated critical habitat.

A Biological Assessment is required for construction projects (or other undertakings having similar physical impacts) that are major Federal actions significantly affecting the quality of the human environment as defined in the National Environmental Policy Act (42 U.S.C. 4332(2)(c)). For projects other than major construction activities, the Service suggests that a biological evaluation similar to a Biological Assessment be prepared to determine whether the project may affect listed or proposed species and/or designated or proposed critical habitat. Recommended contents of a Biological Assessment are described at 50 CFR 402.12.

If a Federal agency determines, based on the Biological Assessment or biological evaluation, that listed species and/or designated critical habitat may be affected by the proposed project, the agency is required to consult with the Service pursuant to 50 CFR 402. In addition, the Service recommends that candidate species, proposed species and proposed critical habitat be addressed within the consultation. More information on the regulations and procedures for section 7 consultation, including the role of permit or license applicants, can be found in the "Endangered Species Consultation Handbook" at:

<http://www.fws.gov/endangered/esa-library/pdf/TOC-GLOS.PDF>

Please be aware that bald and golden eagles are protected under the Bald and Golden Eagle Protection Act (16 U.S.C. 668 *et seq.*), and projects affecting these species may require development of an eagle conservation plan (http://www.fws.gov/windenergy/eagle_guidance.html). Additionally, wind energy projects should follow the wind energy guidelines (<http://www.fws.gov/windenergy/>) for minimizing impacts to migratory birds and bats.

Guidance for minimizing impacts to migratory birds for projects including communications towers (e.g., cellular, digital television, radio, and emergency broadcast) can be found at: <http://www.fws.gov/migratorybirds/CurrentBirdIssues/Hazards/towers/towers.htm>; <http://www.towerkill.com>; and <http://www.fws.gov/migratorybirds/CurrentBirdIssues/Hazards/towers/comtow.html>.

We appreciate your concern for threatened and endangered species. The Service encourages Federal agencies to include conservation of threatened and endangered species into their project planning to further the purposes of the Act. Please include the Consultation Tracking Number in the header of this letter with any request for consultation or correspondence about your project that you submit to our office.

Attachment(s):

- Official Species List
-

Official Species List

This list is provided pursuant to Section 7 of the Endangered Species Act, and fulfills the requirement for Federal agencies to "request of the Secretary of the Interior information whether any species which is listed or proposed to be listed may be present in the area of a proposed action".

This species list is provided by:

New England Ecological Services Field Office

70 Commercial Street, Suite 300

Concord, NH 03301-5094

(603) 223-2541

Project Summary

Consultation Code: 05E1NE00-2020-SLI-2547

Event Code: 05E1NE00-2020-E-07653

Project Name: Logan International Airport - Wastewater Treatment Facility Improvements

Project Type: DREDGE / EXCAVATION

Project Description: Dewatering for Construction

Project Location:

Approximate location of the project can be viewed in Google Maps: <https://www.google.com/maps/place/42.375880057595815N71.02375528969503W>



Counties: Suffolk, MA

Endangered Species Act Species

There is a total of 0 threatened, endangered, or candidate species on this species list.

Species on this list should be considered in an effects analysis for your project and could include species that exist in another geographic area. For example, certain fish may appear on the species list because a project could affect downstream species.

IPaC does not display listed species or critical habitats under the sole jurisdiction of NOAA Fisheries¹, as USFWS does not have the authority to speak on behalf of NOAA and the Department of Commerce.

See the "Critical habitats" section below for those critical habitats that lie wholly or partially within your project area under this office's jurisdiction. Please contact the designated FWS office if you have questions.

-
1. [NOAA Fisheries](#), also known as the National Marine Fisheries Service (NMFS), is an office of the National Oceanic and Atmospheric Administration within the Department of Commerce.

Critical habitats

THERE ARE NO CRITICAL HABITATS WITHIN YOUR PROJECT AREA UNDER THIS OFFICE'S JURISDICTION.



United States Department of the Interior



FISH AND WILDLIFE SERVICE
New England Ecological Services Field Office
70 Commercial Street, Suite 300
Concord, NH 03301-5094
Phone: (603) 223-2541 Fax: (603) 223-0104
<http://www.fws.gov/newengland>

In Reply Refer To:

May 13, 2020

Consultation Code: 05E1NE00-2020-SLI-2548

Event Code: 05E1NE00-2020-E-07655

Project Name: Logan International Airport - Wastewater Treatment Facility Improvements

Subject: List of threatened and endangered species that may occur in your proposed project location, and/or may be affected by your proposed project

To Whom It May Concern:

The enclosed species list identifies threatened, endangered, proposed and candidate species, as well as proposed and final designated critical habitat, that may occur within the boundary of your proposed project and/or may be affected by your proposed project. The species list fulfills the requirements of the U.S. Fish and Wildlife Service (Service) under section 7(c) of the Endangered Species Act (Act) of 1973, as amended (16 U.S.C. 1531 *et seq.*).

New information based on updated surveys, changes in the abundance and distribution of species, changed habitat conditions, or other factors could change this list. Please feel free to contact us if you need more current information or assistance regarding the potential impacts to federally proposed, listed, and candidate species and federally designated and proposed critical habitat. Please note that under 50 CFR 402.12(e) of the regulations implementing section 7 of the Act, the accuracy of this species list should be verified after 90 days. This verification can be completed formally or informally as desired. The Service recommends that verification be completed by visiting the ECOS-IPaC website at regular intervals during project planning and implementation for updates to species lists and information. An updated list may be requested through the ECOS-IPaC system by completing the same process used to receive the enclosed list.

The purpose of the Act is to provide a means whereby threatened and endangered species and the ecosystems upon which they depend may be conserved. Under sections 7(a)(1) and 7(a)(2) of the Act and its implementing regulations (50 CFR 402 *et seq.*), Federal agencies are required to utilize their authorities to carry out programs for the conservation of threatened and endangered species and to determine whether projects may affect threatened and endangered species and/or designated critical habitat.

A Biological Assessment is required for construction projects (or other undertakings having similar physical impacts) that are major Federal actions significantly affecting the quality of the human environment as defined in the National Environmental Policy Act (42 U.S.C. 4332(2)(c)). For projects other than major construction activities, the Service suggests that a biological evaluation similar to a Biological Assessment be prepared to determine whether the project may affect listed or proposed species and/or designated or proposed critical habitat. Recommended contents of a Biological Assessment are described at 50 CFR 402.12.

If a Federal agency determines, based on the Biological Assessment or biological evaluation, that listed species and/or designated critical habitat may be affected by the proposed project, the agency is required to consult with the Service pursuant to 50 CFR 402. In addition, the Service recommends that candidate species, proposed species and proposed critical habitat be addressed within the consultation. More information on the regulations and procedures for section 7 consultation, including the role of permit or license applicants, can be found in the "Endangered Species Consultation Handbook" at:

<http://www.fws.gov/endangered/esa-library/pdf/TOC-GLOS.PDF>

Please be aware that bald and golden eagles are protected under the Bald and Golden Eagle Protection Act (16 U.S.C. 668 *et seq.*), and projects affecting these species may require development of an eagle conservation plan (http://www.fws.gov/windenergy/eagle_guidance.html). Additionally, wind energy projects should follow the wind energy guidelines (<http://www.fws.gov/windenergy/>) for minimizing impacts to migratory birds and bats.

Guidance for minimizing impacts to migratory birds for projects including communications towers (e.g., cellular, digital television, radio, and emergency broadcast) can be found at: <http://www.fws.gov/migratorybirds/CurrentBirdIssues/Hazards/towers/towers.htm>; <http://www.towerkill.com>; and <http://www.fws.gov/migratorybirds/CurrentBirdIssues/Hazards/towers/comtow.html>.

We appreciate your concern for threatened and endangered species. The Service encourages Federal agencies to include conservation of threatened and endangered species into their project planning to further the purposes of the Act. Please include the Consultation Tracking Number in the header of this letter with any request for consultation or correspondence about your project that you submit to our office.

Attachment(s):

- Official Species List
-

Official Species List

This list is provided pursuant to Section 7 of the Endangered Species Act, and fulfills the requirement for Federal agencies to "request of the Secretary of the Interior information whether any species which is listed or proposed to be listed may be present in the area of a proposed action".

This species list is provided by:

New England Ecological Services Field Office

70 Commercial Street, Suite 300

Concord, NH 03301-5094

(603) 223-2541

Project Summary

Consultation Code: 05E1NE00-2020-SLI-2548

Event Code: 05E1NE00-2020-E-07655


Project Name: Logan International Airport - Wastewater Treatment Facility Improvements

Project Type: DREDGE / EXCAVATION

Project Description: Dewatering for Construction

Project Location:

Approximate location of the project can be viewed in Google Maps: <https://www.google.com/maps/place/42.35787796201252N71.02773645779624W>

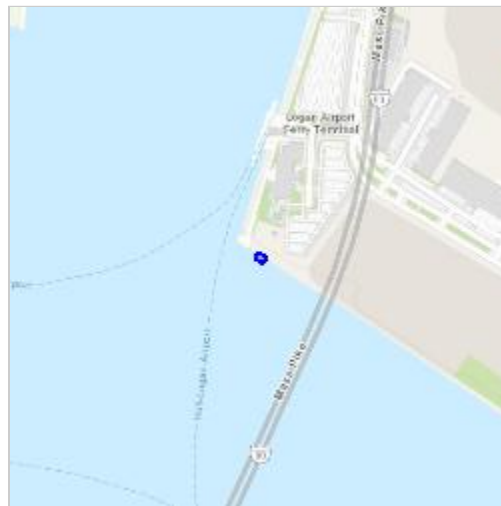

Counties: Suffolk, MA

Endangered Species Act Species

There is a total of 0 threatened, endangered, or candidate species on this species list.

Species on this list should be considered in an effects analysis for your project and could include species that exist in another geographic area. For example, certain fish may appear on the species list because a project could affect downstream species.

IPaC does not display listed species or critical habitats under the sole jurisdiction of NOAA Fisheries¹, as USFWS does not have the authority to speak on behalf of NOAA and the Department of Commerce.

See the "Critical habitats" section below for those critical habitats that lie wholly or partially within your project area under this office's jurisdiction. Please contact the designated FWS office if you have questions.

-
1. [NOAA Fisheries](#), also known as the National Marine Fisheries Service (NMFS), is an office of the National Oceanic and Atmospheric Administration within the Department of Commerce.

Critical habitats

THERE ARE NO CRITICAL HABITATS WITHIN YOUR PROJECT AREA UNDER THIS OFFICE'S JURISDICTION.

ATTACHMENT I

Massachusetts Cultural Resource Information System

MACRIS

MACRIS Search Results

Search Criteria: Town(s): Boston; Place: East Boston; Street Name: prescott; Resource Type(s): Area, Building, Burial Ground, Object, Structure;

Inv. No.	Property Name	Street	Town	Year
BOS.29	Corsano, James Apartment Block	146 Gove St	Boston	1911
BOS.53	Ginsburg, Louis A. Three Decker	205-207 Lexington St	Boston	1901
BOS.54	Ginsburg, Louis A. Three Decker	209-211 Lexington St	Boston	1901
BOS.55	Ginsburg, Louis A. Three Decker	213 Lexington St	Boston	1901
BOS.56	Burnham, Lewis Three Decker	217 Lexington St	Boston	c 1890
BOS.57	Burnham, Lewis Three Decker	219 Lexington St	Boston	c 1890
BOS.50	Knowles, Paul House	220 Lexington St	Boston	c 1884
BOS.58	Burnham, Lewis Three Decker	221 Lexington St	Boston	c 1890
BOS.14173	Sheridan, Gen. Philip H. Elementary School	1 Prescott St	Boston	1914
BOS.135	McLaren, Alexander and John Building	263 Princeton St	Boston	1875
BOS.136	McLaren, Alexander and John Building	265 Princeton St	Boston	1875
BOS.131	Pinkham - Perry - Sanderson House	296-300 Princeton St	Boston	c 1860
BOS.152	Saint John the Baptist Roman Catholic Church	336 Saratoga St	Boston	1913
BOS.153	East Boston Chemical Company #7 Fire House	360 Saratoga St	Boston	1901