



SAIC Engineering, Inc.
A Subsidiary of Science Applications
International Corporation

10 Riverside Drive, Lakeville, Massachusetts 02347
Office: (508) 946-3500 • Fax: (508) 946-3509

Letter of Transmittal

Date: <u>6/21/94</u>	Job/Contract No.: <u>Aerovox</u>
Attention: <u>Ms. Gayle Gorman</u>	
Re: <u>Superfund Site - GHR Engineering Corp.</u> <u>Aerovox</u> <u>P.4</u>	

To: Ms. Gayle Gorman, Project Mgr.
New Bedford Harbor Project
EPA Region I
JFK Bldg. Mail Code: HRM
Boston, MA 02203-2211



We are sending you Attached Under separate cover via _____ SDMS DocID **451225**

- Shop drawings Prints Plans Samples Specifications
 Copy of letter Change order _____

Copies	Date	No.	Description
1	Rev. 1/6/83		Photocopy of portion of map - AEROVOX "Site Plan Showing Monitoring Well Locations" - GHR Engineering Corp.
			Produced For The 12/96 AVX FOIA Request New Bedford Harbor Superfund Site

These are transmitted:

- | | | |
|--|---|---|
| <input type="checkbox"/> For approval | <input type="checkbox"/> Approved as submitted | <input type="checkbox"/> Resubmit _____ copies for approval |
| <input type="checkbox"/> For your use | <input type="checkbox"/> Approved as noted | <input type="checkbox"/> Submit _____ copies for distribution |
| <input checked="" type="checkbox"/> As requested | <input type="checkbox"/> Returned for corrections | <input type="checkbox"/> Return _____ corrected prints |
| <input type="checkbox"/> For review and comment | <input type="checkbox"/> _____ | |
| <input type="checkbox"/> For bids due _____ 19____ | <input type="checkbox"/> PRINTS RETURNED AFTER LOAN TO US | |

Remarks: Well elevations shown have since been re-surveyed


Document produced to AVX in
response to July 31, 2006 inquiry

Copy to: Mr. Peter SZWAJA, AEROVOX

Signed: [Signature]

White Copy-For your file Yellow Copy -Return to originator Pink Copy-Originator file

If enclosures are not as noted kindly notify us at once

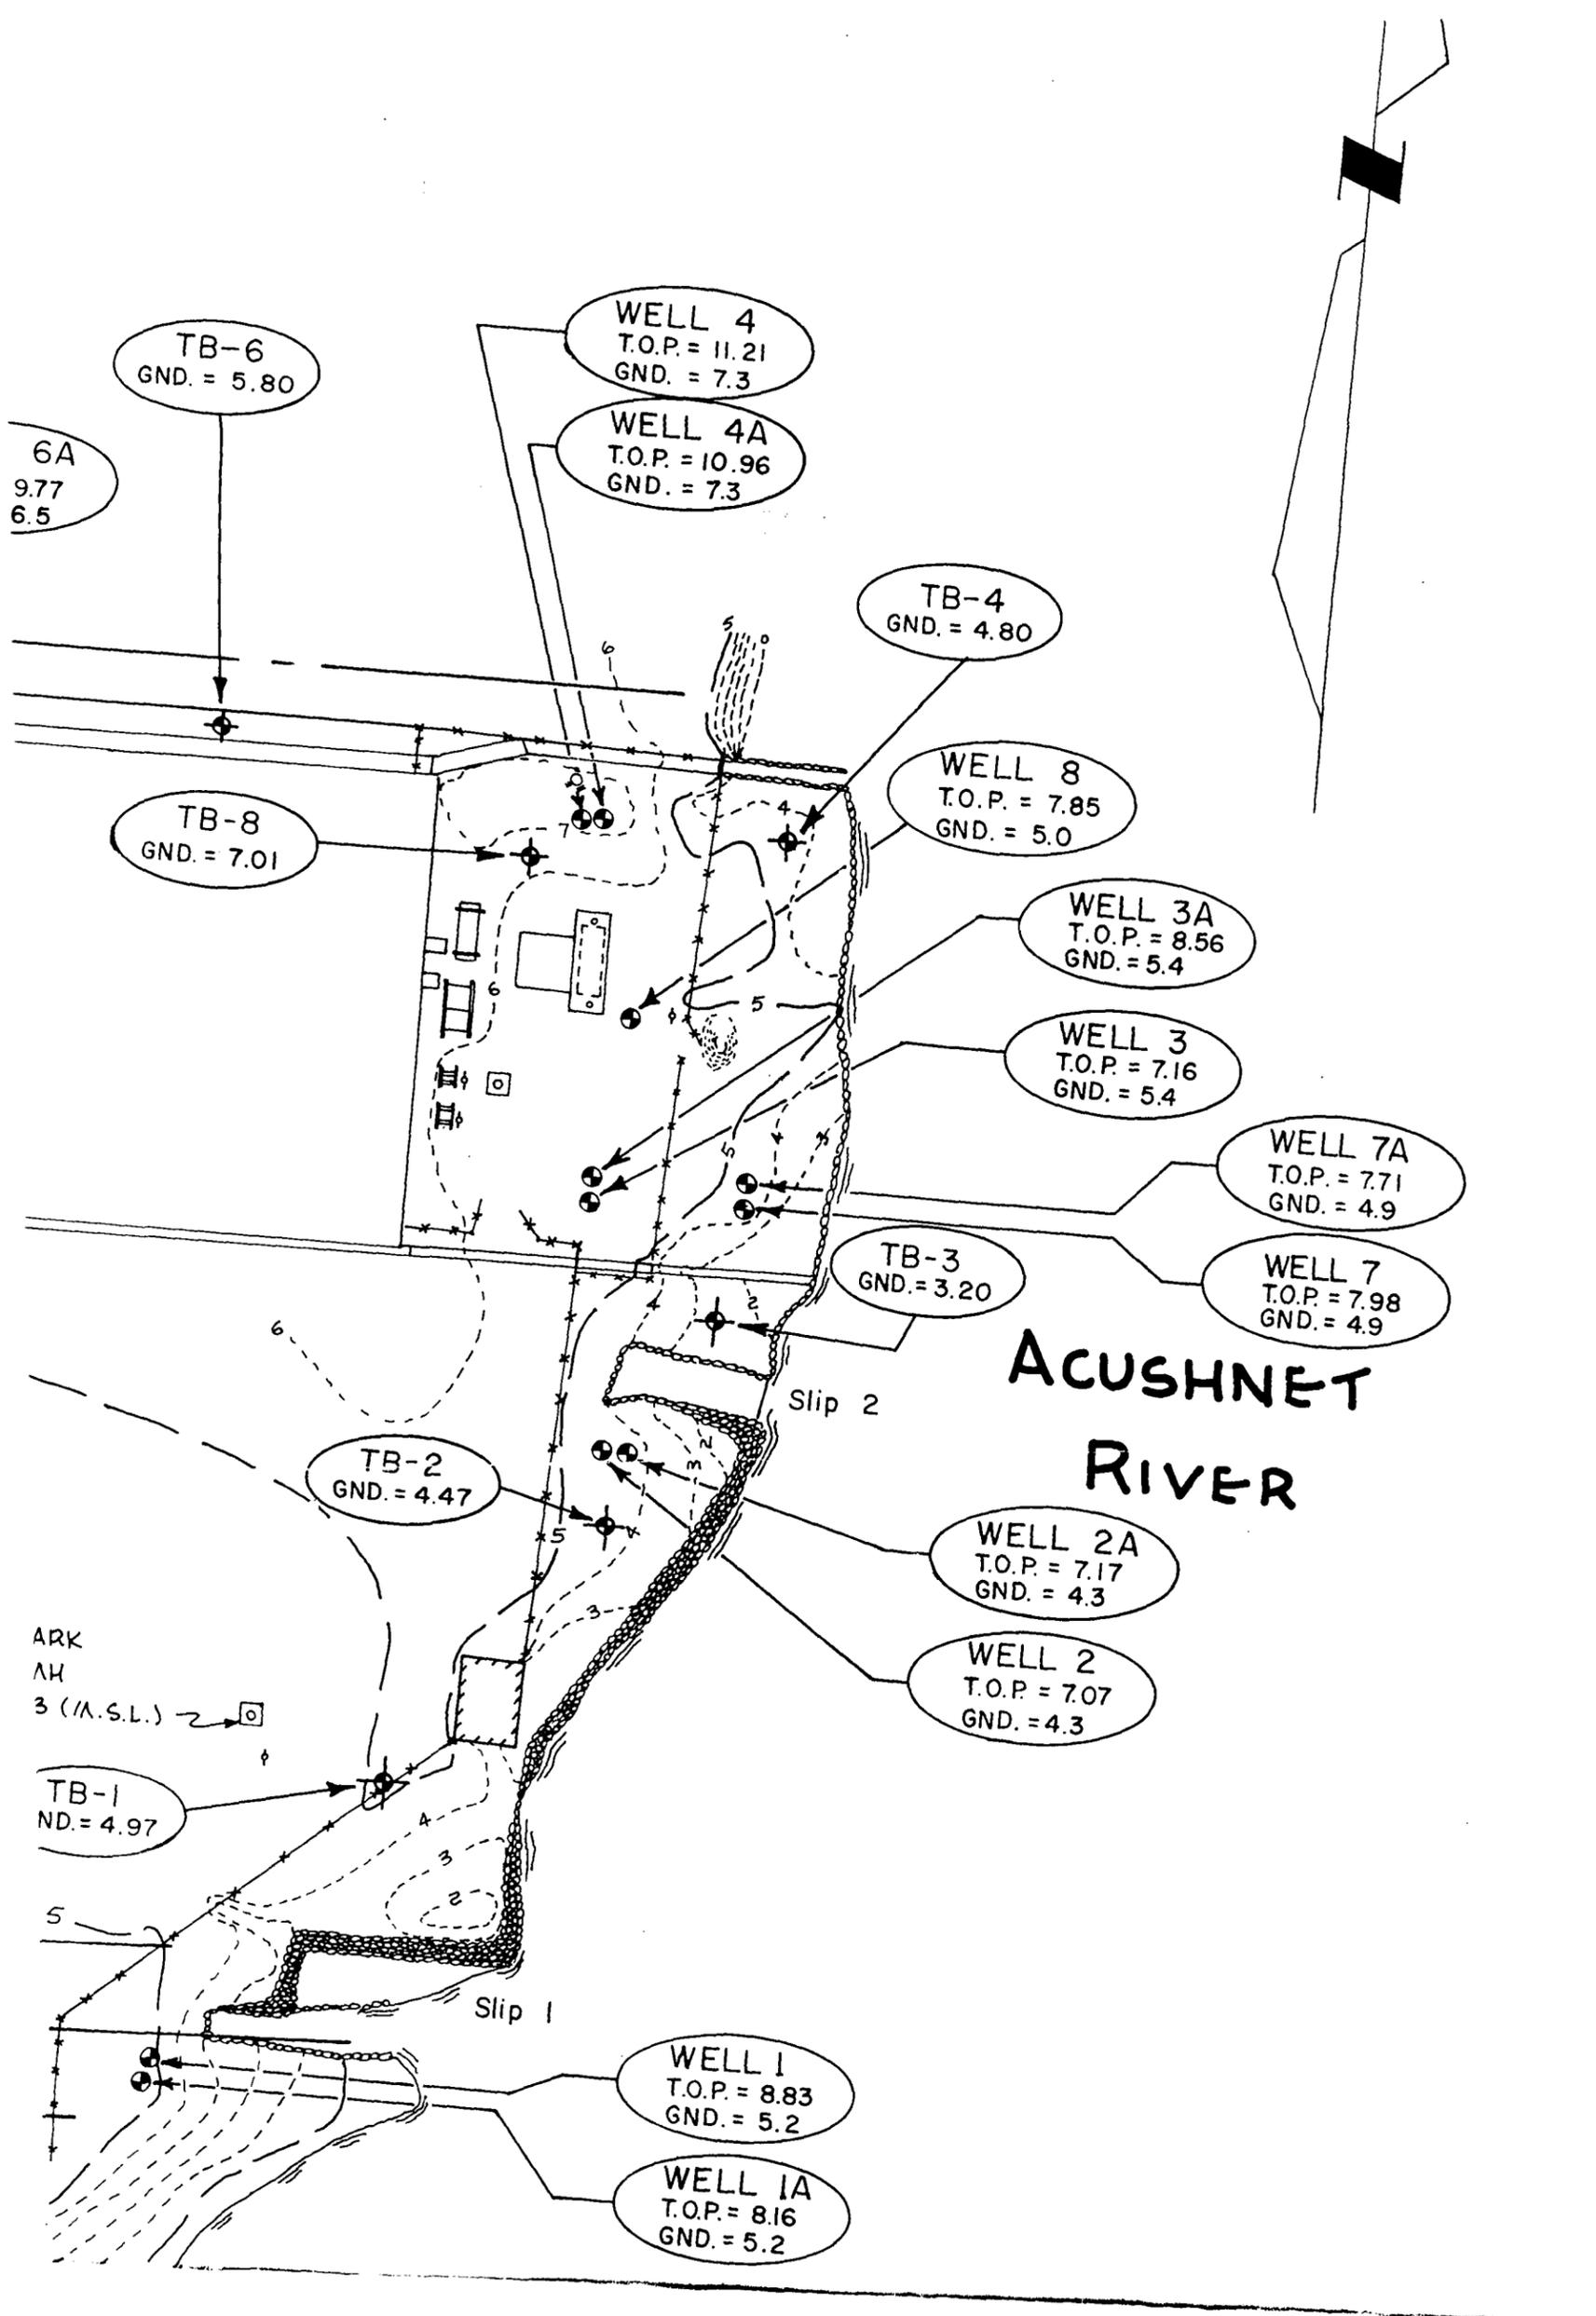

REVISED - JAN. 6, 1983

AEROVOX PLANT, NEW BEDFORD, MASS.



ENGINEERING CORPORATION
75 TARKILN HILL ROAD · NEW BEDFORD, MA. 02745

DATE: 9-17-82
SCALE: 1" = 50'
DRAWN: D.F.
CHECKED: J.J.G.
JOB NO: 2463

CLIENT
AEROVOX INCORPORATED

DWG. TITLE
SITE PLAN SHOWING
MONITORING WELL LOCATIONS

Richard P. ...

DWG. NO.
SP-1