


184 HIGH STREET
SUITE 502
BOSTON MA 02110
(617) 728-0070

REVISIONS

#	DATE	DESCRIPTION
1	7/11/11	LAND BORINGS
2	7/12/12	LEGEND CHANGE FOR CLARITY

THESE DRAWINGS PREPARED BY APEX FOR THIS PROJECT ARE INSTRUMENTS OF APEX'S SERVICE FOR USE SOLELY WITH RESPECT TO THIS PROJECT, AND APEX SHALL BE DEEMED THE AUTHOR OF THE DRAWING AND SHALL RETAIN ALL COMMON LAW, STATUTORY AND OTHER RESERVED RIGHTS WITH RESPECT THERETO, INCLUDING COPYRIGHT. THE DOCUMENTS SHALL NOT BE USED ON OTHER PROJECTS, FOR ADDITIONS TO THIS PROJECT OR FOR COMPLETION OF THIS PROJECT BY OTHERS, EXCEPT BY AGREEMENT IN WRITING AND WITH APPROPRIATE COMPENSATION TO APEX.

APPROX. PROPERTY LINE TYP.

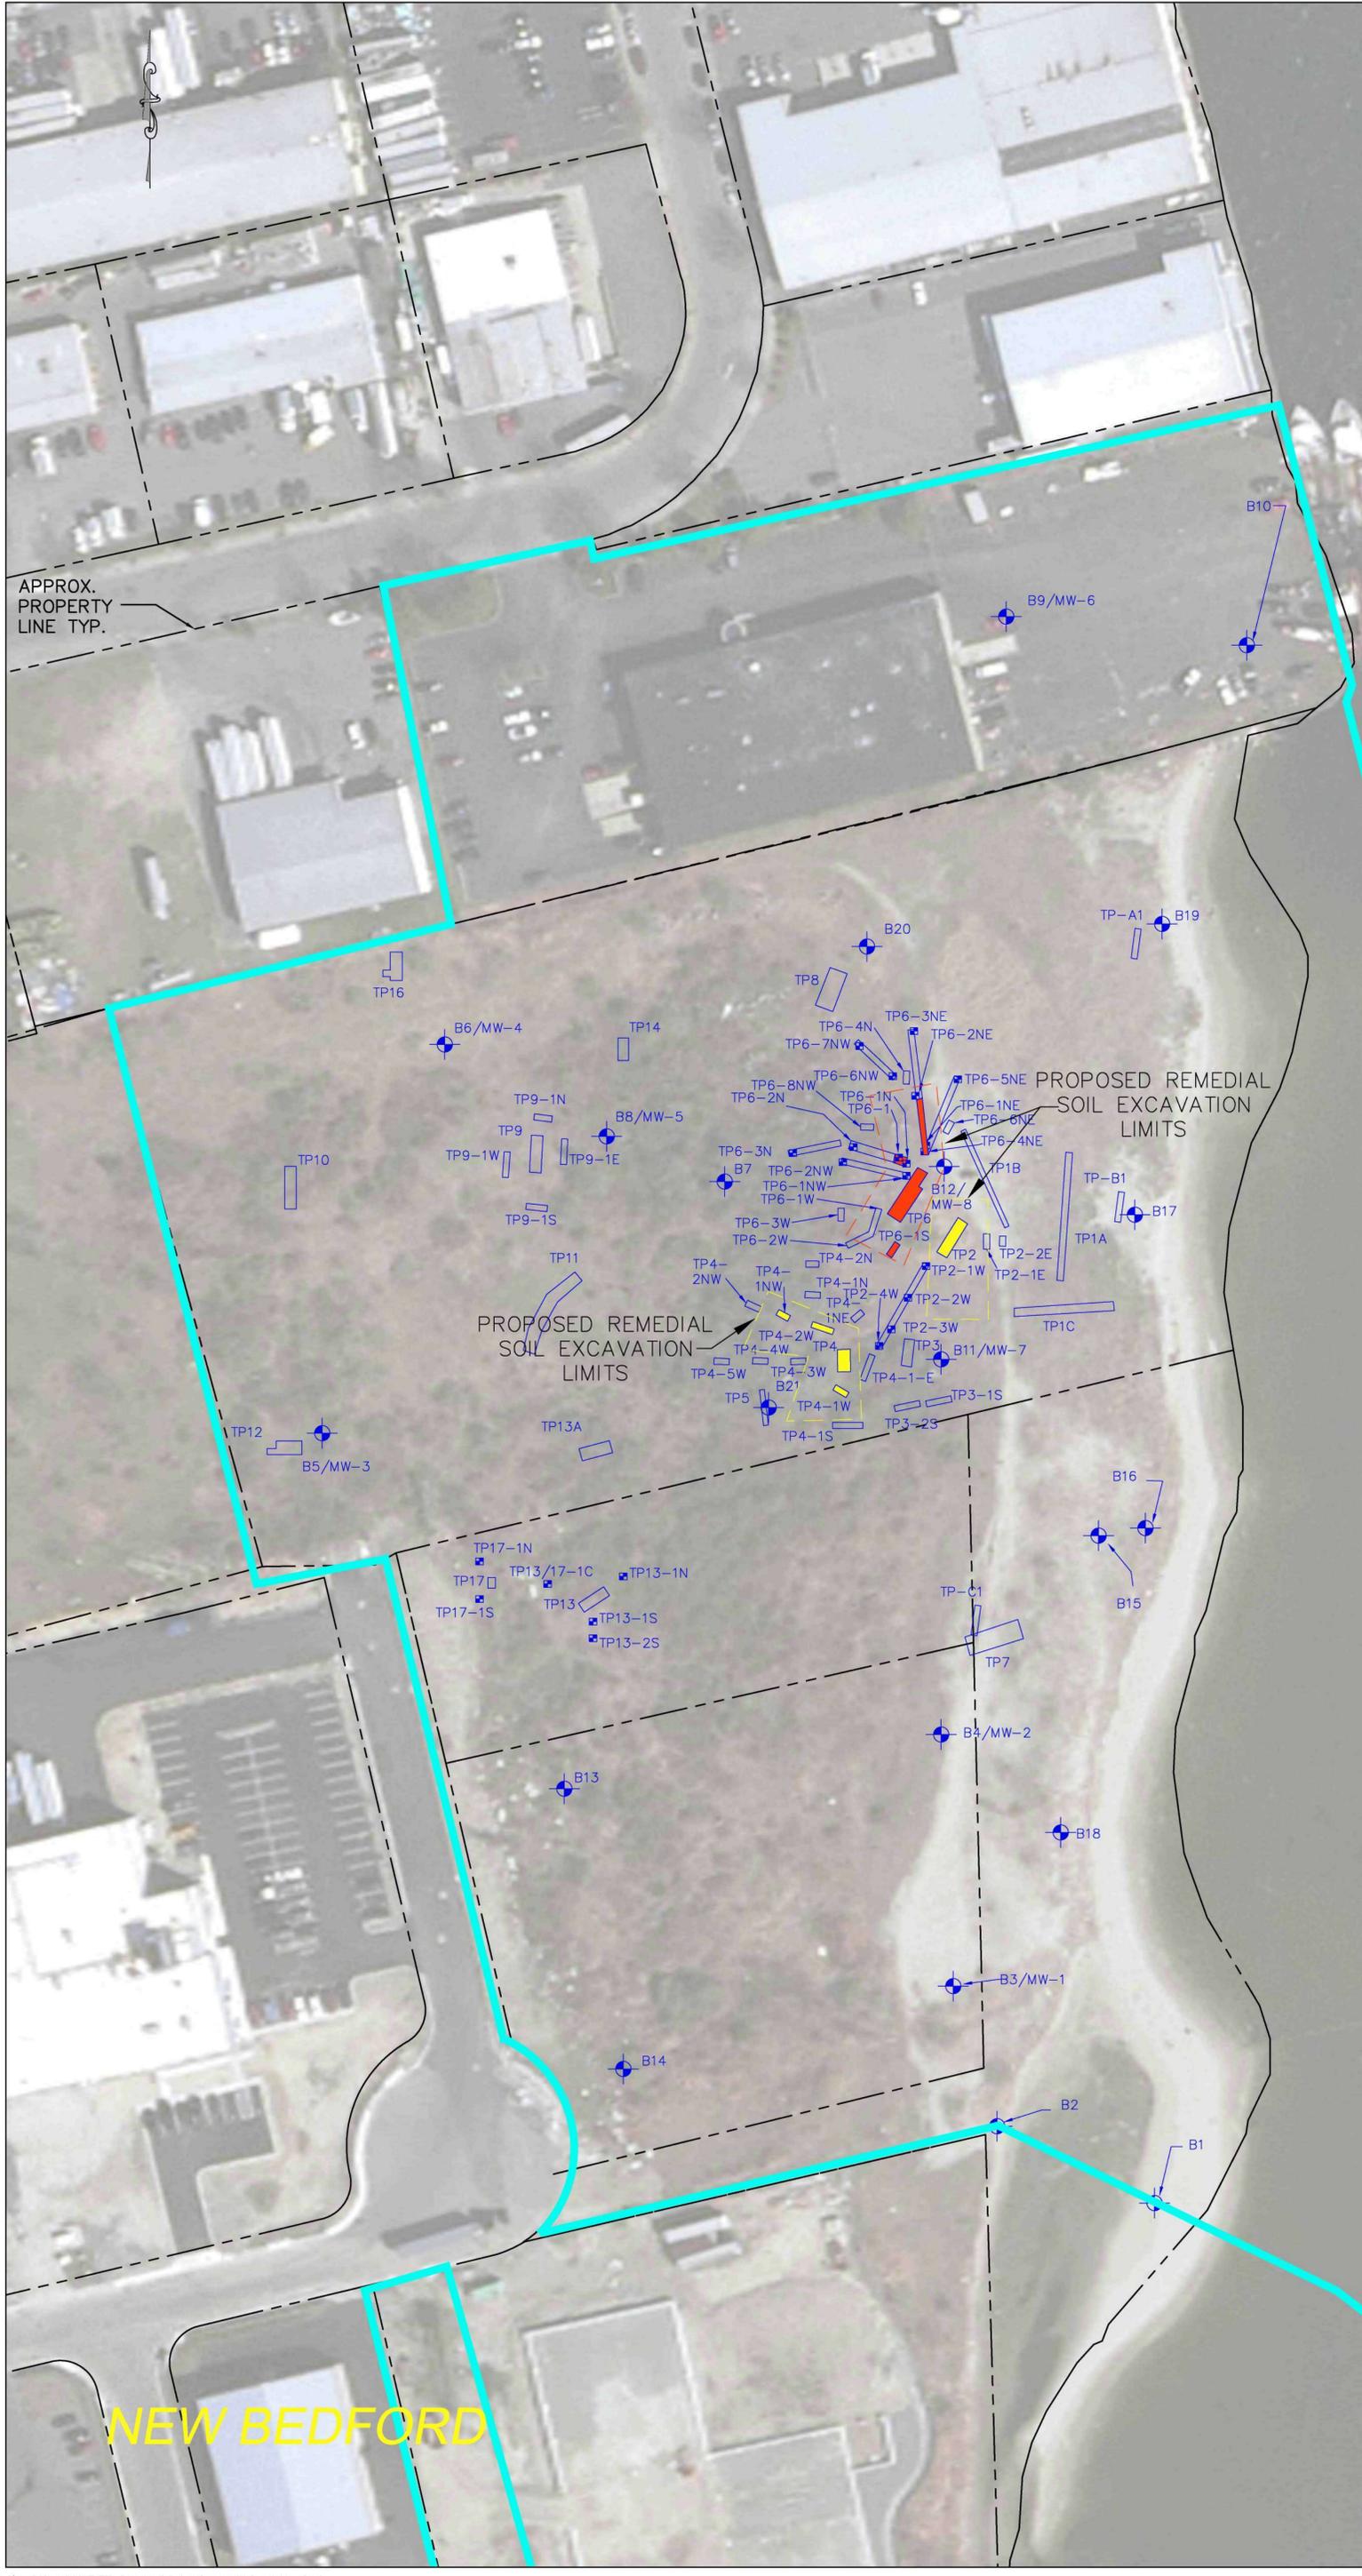


- NOTES:
1. THE PROPOSED BORING LOCATIONS SHOWN HEREON ARE APPROXIMATE.
 2. PROPERTY LINES AND OWNERSHIP SHOWN HEREON ARE FOR REFERENCE ONLY AND BASED ON AN ELECTRONIC PLAN PROVIDED BY THOMPSON FARLAND, INC. THIS PLAN IS NOT INTENDED TO BE USED AS A PLAN OF RECORD, OR FOR THE DETERMINATION OF PROPERTY LINES, BOUNDARIES, OR LINES OF OWNERSHIP.
 3. BACKGROUND IMAGES SHOWN HEREON ARE PROVIDED COURTESY OF MASSGIS.
 4. STRUCTURES AND FEATURES LOCATED BEYOND THE PROJECT LIMITS, ARE TAKEN FROM AN AERIAL SURVEY CONDUCTED BY THE ARMY CORPS OF ENGINEERS AND SHOULD BE CONSIDERED APPROXIMATE.

- UPLAND BORING SHOWING BEDROCK ELEVATION
- BORING/MONITORING WELL LOCATION
- OVER WATER GEOTECHNICAL BORING
- LARGE TEST PIT BOUNDARIES
- SMALL TEST PIT LOCATION
- PROPOSED SOIL EXCAVATION PCB CONCENTRATION > 25 PPM
- PROPOSED SOIL EXCAVATION EPH/TPH CONCENTRATION > 10,000 PPM
- EXISTING TEST PIT PCB CONCENTRATION > 50 PPM
- EXISTING TEST PIT EPH/TPH CONCENTRATION > 10,000 PPM

PREPARED FOR:
MASSACHUSETTS CLEAN ENERGY CENTER

DRAWING TITLE:
NEW BEDFORD MARINE COMMERCE TERMINAL AS-BUILT BORING AND TEST PIT LOCATIONS

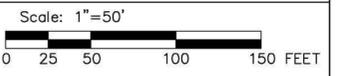

Date	10/28/10	Drawing No.
Proj. Mgr.		
Design	CWM	
Check	JAB	
Drawn	GAD	
Job No.	6690	
Last Rev.	11/22/10	FIG. 1