DRAWING NUMBER	APPROVED BY	CHECKED BY	DRAWN BY	OFFICE	X-REF	IMAGE
CNTRDALE-CAP1	---	---	EMD/JJC/EDA 10/7/99	HOPK	---	---

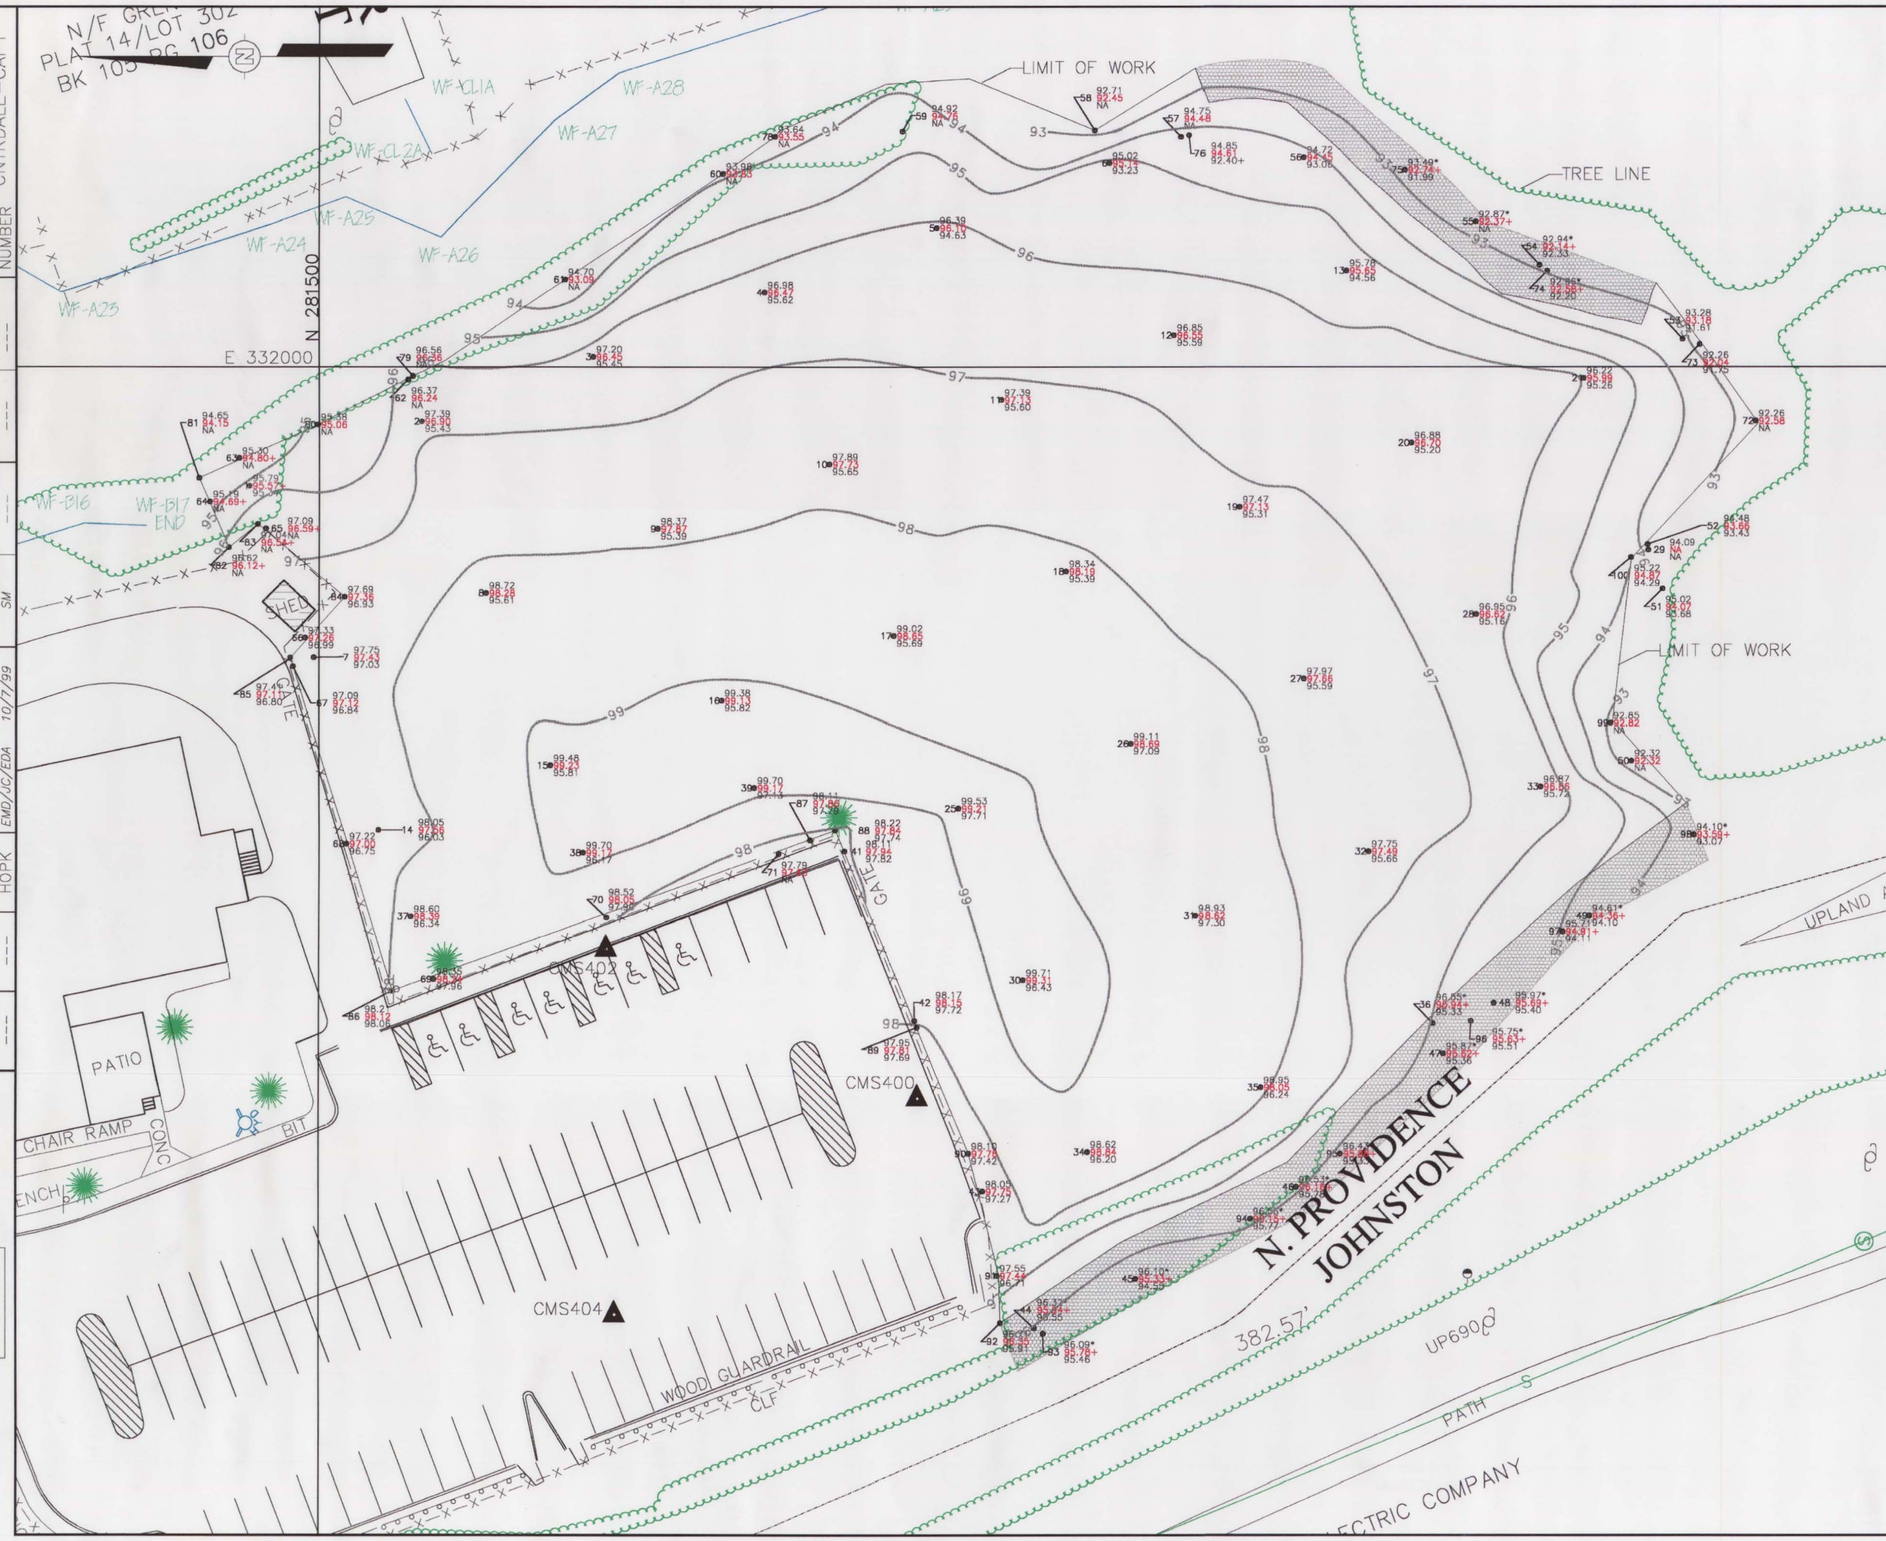

LEGEND

- CATCH BASIN
- DRAIN MANHOLE
- ELECTRIC MANHOLE
- COMMUNICATIONS MANHOLE
- SEWER MANHOLE
- TELEPHONE MANHOLE
- MANHOLE
- CURB INLET
- GAS VALVE
- GAS SHUT OFF VALVE
- WATERGATE
- WATER SHUT OFF VALVE
- FIRE HYDRANT
- POST INDICATOR VALVE
- MONITOR WELL
- SOIL SAMPLE
- LIGHT POLE
- POWER POLE
- GUY WIRE
- SIGN
- TREE
- HAYBALES
- LEDGE
- CONCRETE
- FENCE
- WETLAND LINE
- DRAIN LINE
- SEWER LINE
- TELEPHONE/ELEC LINE
- TOWNLINE
- BENCHMARK
- BOUND
- IRON PIPE OR ROD
- DRILL HOLE

RIP RAP

GRID POINT IDENTIFICATION
GRID POINT LOCATION
95.79 – AS-BUILT FINAL GRADE ELEVATION
95.52+ – AS-BUILT TOP OF FINAL COVER ELEVATION
93.34 – AS-BUILT TOP OF GEOTEXTILE ELEVATION

* – APPROXIMATE TOP OF RIP RAP ELEVATIONS
+ – ESTIMATED ELEVATIONS
RED ELEVATIONS ARE APPLICABLE TO DRAWING

SCALE
0 20 40 60 FEET

VERIFY SCALE
0 1"

IT CORPORATION
88C ELM STREET
HOPKINTON, MASSACHUSETTS
(508) 435-9561

SITE MAP
CAP #1 FINAL COVER CONTOURS

CENTREDALE MANOR
NORTH PROVIDENCE, RHODE ISLAND

Superfund Records Center
SITE: Centredale
BREAK: 17.4
OTHER: 474511
SDMS DocID 474511