Industri-Plex Site OU1,
Interactive Property Map:
Click on the tax map number
to view the corresponding As Built
Records.

INDUSTRI-PLEX SITE
OU-1 COVER CERTIFICATION REPORT
LOCUS PLAN OF ATTACHMENT 1
(VOLUMES A, B & C)

RECORD DRAWINGS

WOBURN, MASSACHUSETTS
OCTOBER 24, 2008

RESTRICTED AREAS BY CLASSES OF LAND

CLASS OF LAND	DESCRIPTION
A	MAY CONTAIN CONTAMINATED GROUNDWATER
B	MAY CONTAIN CONTAMINATED GROUNDWATER, AND MAY CONTAIN CONTAMINATED SOILS. NO COVER WAS REQUIRED WITHIN CLASS B.
C	MAY CONTAIN CONTAMINATED GROUNDWATER, AND CONTAINS CONTAMINATED SOIL AND COVER.
D	MAY CONTAIN CONTAMINATED GROUNDWATER, AND CONTAINS CONTAMINATED SOIL AND COVER. CLASS D ALSO CONTAINS FOUR ANIMAL HIDE PILES.

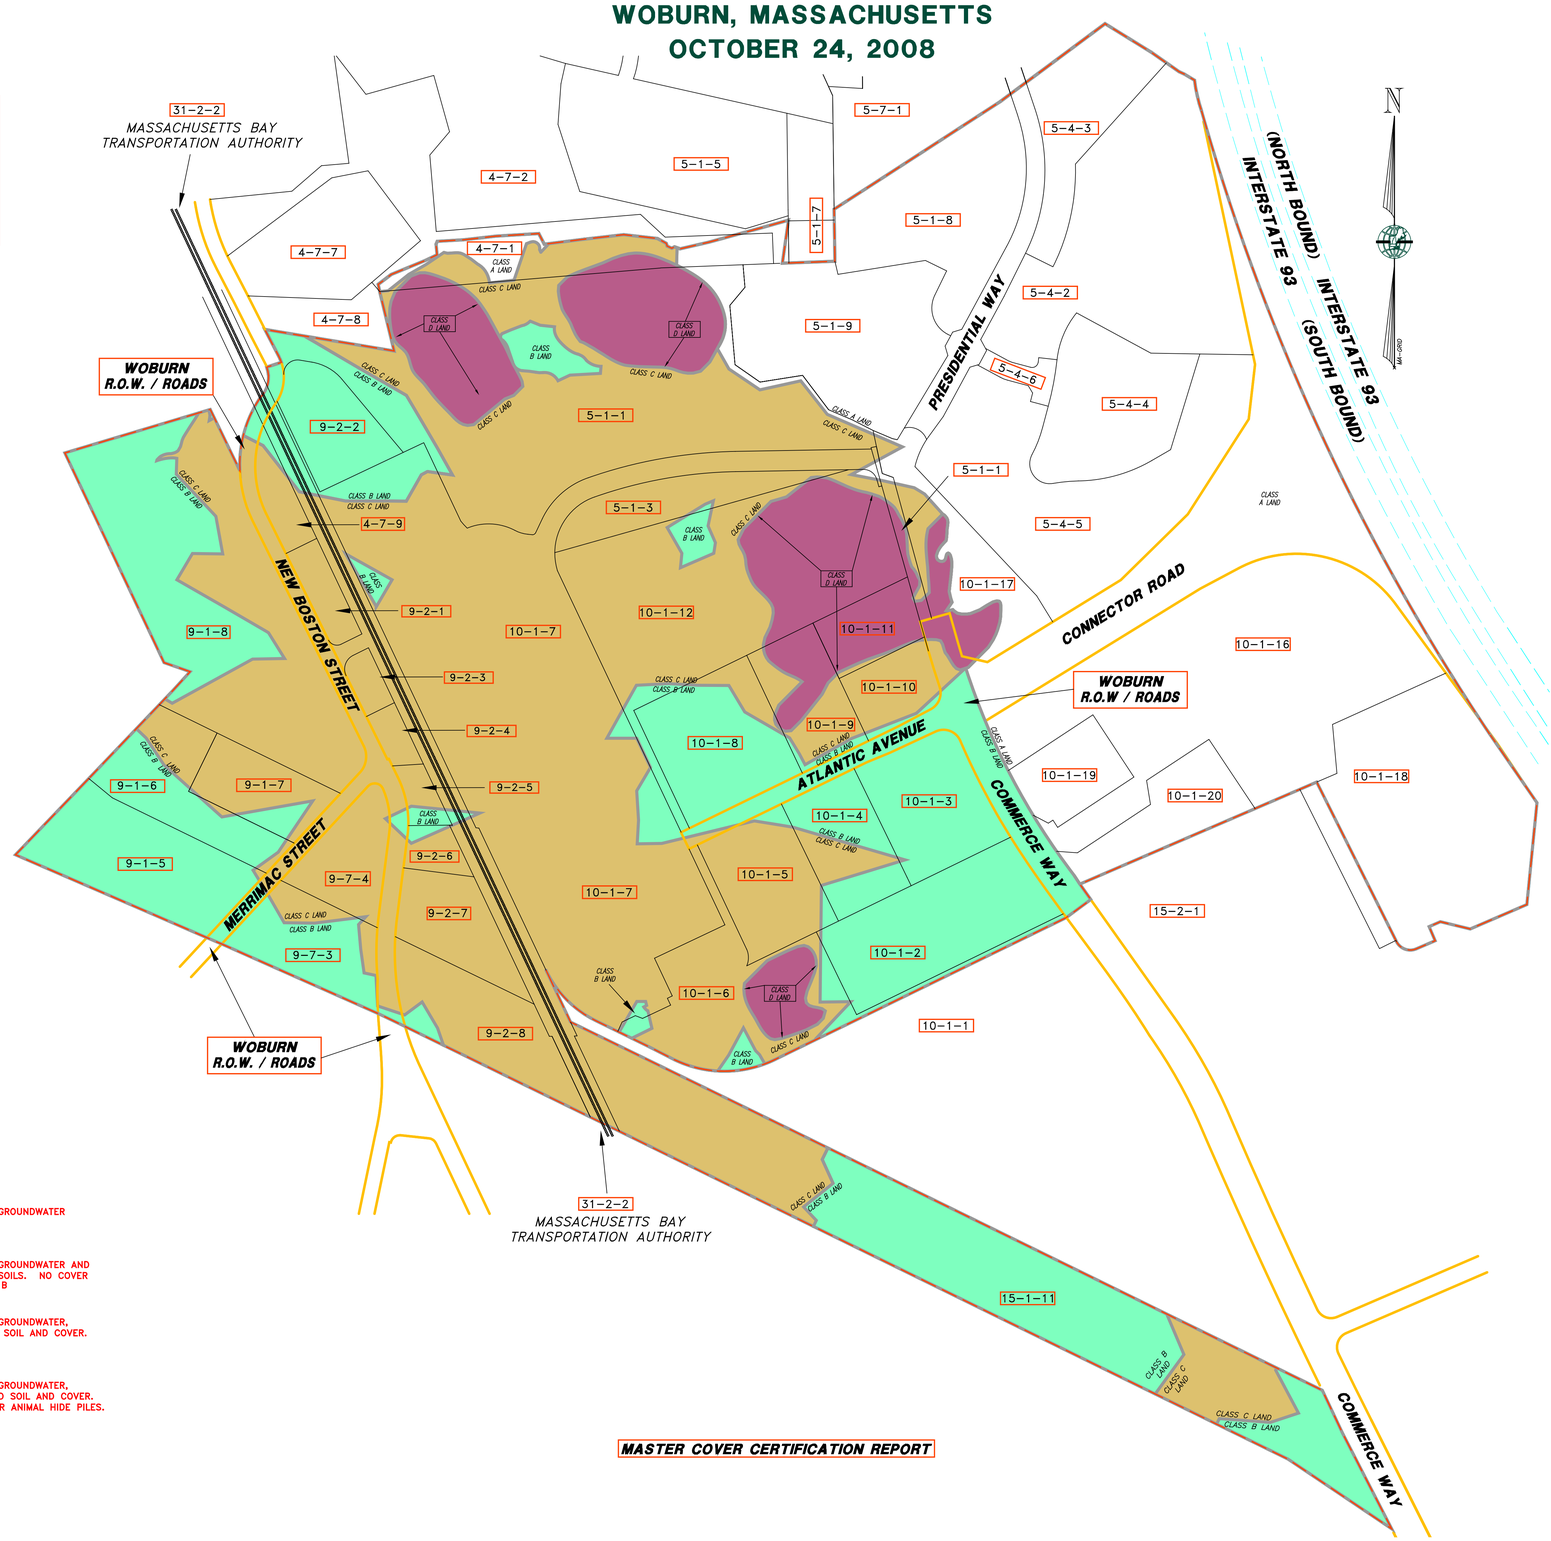

LEGEND:

- BOUNDARY LINE
- RIGHT-OF-WAY
- IPLEX SITE LIMIT
- LAND CLASS LINE
- 5-1-1 TAX MAP PARCEL NO.

LOT # CHART

LOT #	TAX MAP #	ADDRESS
LOT IC-1	4-7-9	229 NEW BOSTON STREET
LOT IC-2	9-2-1	225 NEW BOSTON STREET
LOT IC-3	9-2-3	223 NEW BOSTON STREET R
LOT IC-4	9-2-4	223 NEW BOSTON STREET
LOT IC-5	9-2-5	219 NEW BOSTON STREET
LOT IC-6	9-2-6	211 NEW BOSTON STREET
LOT IC-7	9-2-7	211 NEW BOSTON STREET
LOT IC-8	9-2-8	NEW BOSTON STREET
LOT IC-9	9-7-3	MERRIMAC STREET
LOT IC-10	9-1-5	MERRIMAC STREET
LOT IC-11	9-1-6	204 MERRIMAC STREET
LOT IC-12	9-1-7	225 MERRIMAC STREET
LOT IC-13	9-1-8	216 NEW BOSTON STREET
LOT IC-14	9-7-4	210 NEW BOSTON STREET
LOT IC-15	31-2-2	N/A
LOT IC-16	15-1-11	COMMERCE WAY
LOT IC-17	10-1-8	41 ATLANTIC AVENUE
LOT IC-18	10-1-5	20 ATLANTIC AVENUE
LOT IC-19	10-1-4	10 ATLANTIC AVENUE
LOT IC-20	10-1-3	120 COMMERCE WAY
LOT IC-21	10-1-10	130 COMMERCE WAY
LOT IC-22	10-1-11	COMMERCE WAY
LOT IC-23	10-1-9	ATLANTIC AVENUE
LOT IC-24	10-1-12	COMM. WAY & ATLANTIC AVE
LOT IC-25	10-1-17	COMMERCE WAY LOT 5
LOT IC-26	5-1-1	SEE IC-28
LOT IC-27	5-1-3	N/A
LOT IC-28	5-1-1	315 NEW BOSTON STREET
LOT IC-29	4-7-1	NEW BOSTON STREET R
LOT IC-30	10-1-6	30 ATLANTIC AVENUE
LOT IC-31	10-1-7	100 ATLANTIC AVENUE
LOT IC-32	9-2-2	NEW BOSTON STREET
LOT IC-33	5-1-9	236 PRESIDENTIAL WAY
LOT IC-34	5-1-8	225 PRESIDENTIAL WAY
LOT IC-35	5-4-3	PRESIDENTIAL WAY
LOT IC-36	5-4-2	200 PRESIDENTIAL WAY
LOT IC-37	5-4-6	PRESIDENTIAL WAY
LOT IC-38	5-4-4	300 PRESIDENTIAL WAY
LOT IC-39	5-4-5	400 PRESIDENTIAL WAY
LOT IC-40	10-1-16	101 COMMERCE WAY
LOT IC-41	10-1-2	112 COMMERCE WAY
LOT IC-42	10-1-19	103 COMMERCE WAY
LOT IC-43	10-1-20	99 COMMERCE WAY
LOT IC-44	10-1-18	COMMERCE WAY LOT 2
LOT IC-45	5-1-1	COMMERCE WAY LOT 4
LOT IC-46		WOBURN R.O.W. / ROADS

MASTER COVER CERTIFICATION REPORT

CLASS A LAND
MAY CONTAIN CONTAMINATED GROUNDWATER

CLASS B LAND
MAY CONTAIN CONTAMINATED GROUNDWATER AND MAY CONTAIN CONTAMINATED SOILS. NO COVER WAS REQUIRED WITHIN CLASS B

CLASS C LAND
MAY CONTAIN CONTAMINATED GROUNDWATER, AND CONTAINS CONTAMINATED SOIL AND COVER.

CLASS D LAND
MAY CONTAIN CONTAMINATED GROUNDWATER, AND CONTAINS CONTAMINANTED SOIL AND COVER. CLASS D ALSO CONTAINS FOUR ANIMAL HIDE PILES.

MASTER COVER CERTIFICATION REPORT

GRAPHIC SCALE
200' 100' 0 200' 400' 600'

REV.	DATE	DESCRIPTION	DR	CK

PROFESSIONAL LAND SURVEYOR

PROFESSIONAL ENGINEER

PREPARED FOR: ROUX ASSOCIATES, INC. Environmental Consulting & Management

PREPARED BY: MERIDIAN Land Services, Inc. ENGINEERS • LAND SURVEYORS • SUBSTRATE • LAND PLANNERS

DESIGNED BY: Golder Associates Manchester, New Hampshire 400 Commercial Street Manchester, N.H. USA 03101 603-668-0880 • FAX 603-668-1199

PROJECT RECORD - LOCUS PLAN

ATTACHMENT 1 (VOLUMES A, B & C)

INDUSTRI-PLEX SITE REMEDIAL TRUST
WOBURN, MASSACHUSETTS

OCTOBER 24, 2008

SCALE: 1" = 200'

DESIGNED BY: MDP	LOCUS
DRAFTED BY: MDP	SHEET NO.
CHECKED BY: MDP	
FILE: SITE-LOCUS.dwg	PROJECT: 2900.00
DO NOT SCALE DRAWING	SHEET 1 OF 1

Oct 24, 2008 - 10:47am MDP Land Desktop 2004 - LDT4
H:\sms\02900-D-AB\2900.39\UTILITY\EXHIBITS\

SDMS DocID 448241

Industri-Plex Site OU1, Interactive Property Address Chart: Click on the lot number, tax map number, or address to view the corresponding As Built Records.

INDUSTRI-PLEX SITE COVER CERTIFICATION REPORT

LOT # CHART

LOT #	TAX MAP #	ADDRESS
LOT IC-1	4-7-9	229 NEW BOSTON STREET
LOT IC-2	9-2-1	225 NEW BOSTON STREET
LOT IC-3	9-2-3	223 NEW BOSTON STREET R
LOT IC-4	9-2-4	223 NEW BOSTON STREET
LOT IC-5	9-2-5	219 NEW BOSTON STREET
LOT IC-6	9-2-6	217 NEW BOSTON STREET
LOT IC-7	9-2-7	211 NEW BOSTON STREET
LOT IC-8	9-2-8	NEW BOSTON STREET
LOT IC-9	9-7-3	MERRIMAC STREET
LOT IC-10	9-1-5	MERRIMAC STREET
LOT IC-11	9-1-6	204 MERRIMAC STREET
LOT IC-12	9-1-7	225 MERRIMAC STREET
LOT IC-13	9-1-8	216 NEW BOSTON STREET
LOT IC-14	9-7-4	210 NEW BOSTON STREET
LOT IC-15	31-2-2	N/A
LOT IC-16	15-1-11	COMMERCE WAY
LOT IC-17	10-1-8	41 ATLANTIC AVENUE
LOT IC-18	10-1-5	20 ATLANTIC AVENUE
LOT IC-19	10-1-4	10 ATLANTIC AVENUE
LOT IC-20	10-1-3	120 COMMERCE WAY
LOT IC-21	10-1-10	130 COMMERCE WAY
LOT IC-22	10-1-11	COMMERCE WAY
LOT IC-23	10-1-9	ATLANTIC AVENUE
LOT IC-24	10-1-12	COMM. WAY & ATLANTIC AVE
LOT IC-25	10-1-17	COMMERCE WAY LOT 5
LOT IC-26	5-1-1	SEE IC-28
LOT IC-27	5-1-3	N/A
LOT IC-28	5-1-1	315 NEW BOSTON STREET
LOT IC-29	4-7-1	NEW BOSTON STREET R
LOT IC-30	10-1-6	30 ATLANTIC AVENUE
LOT IC-31	10-1-7	100 ATLANTIC AVENUE
LOT IC-32	9-2-2	NEW BOSTON STREET
LOT IC-33	5-1-9	236 PRESIDENTIAL WAY
LOT IC-34	5-1-8	225 PRESIDENTIAL WAY
LOT IC-35	5-4-3	PRESIDENTIAL WAY
LOT IC-36	5-4-2	200 PRESIDENTIAL WAY
LOT IC-37	5-4-6	PRESIDENTIAL WAY
LOT IC-38	5-4-4	300 PRESIDENTIAL WAY
LOT IC-39	5-4-5	400 PRESIDENTIAL WAY
LOT IC-40	10-1-16	101 COMMERCE WAY
LOT IC-41	10-1-2	112 COMMERCE WAY
LOT IC-42	10-1-19	103 COMMERCE WAY
LOT IC-43	10-1-20	99 COMMERCE WAY
LOT IC-44	10-1-18	COMMERCE WAY LOT 2
LOT IC-45	5-1-1	COMMERCE WAY LOT 4
LOT IC-46		WOBURN R.O.W. / ROADS

MASTER COVER CERTIFICATION REPORT