RETURN TO SER AR INDEX

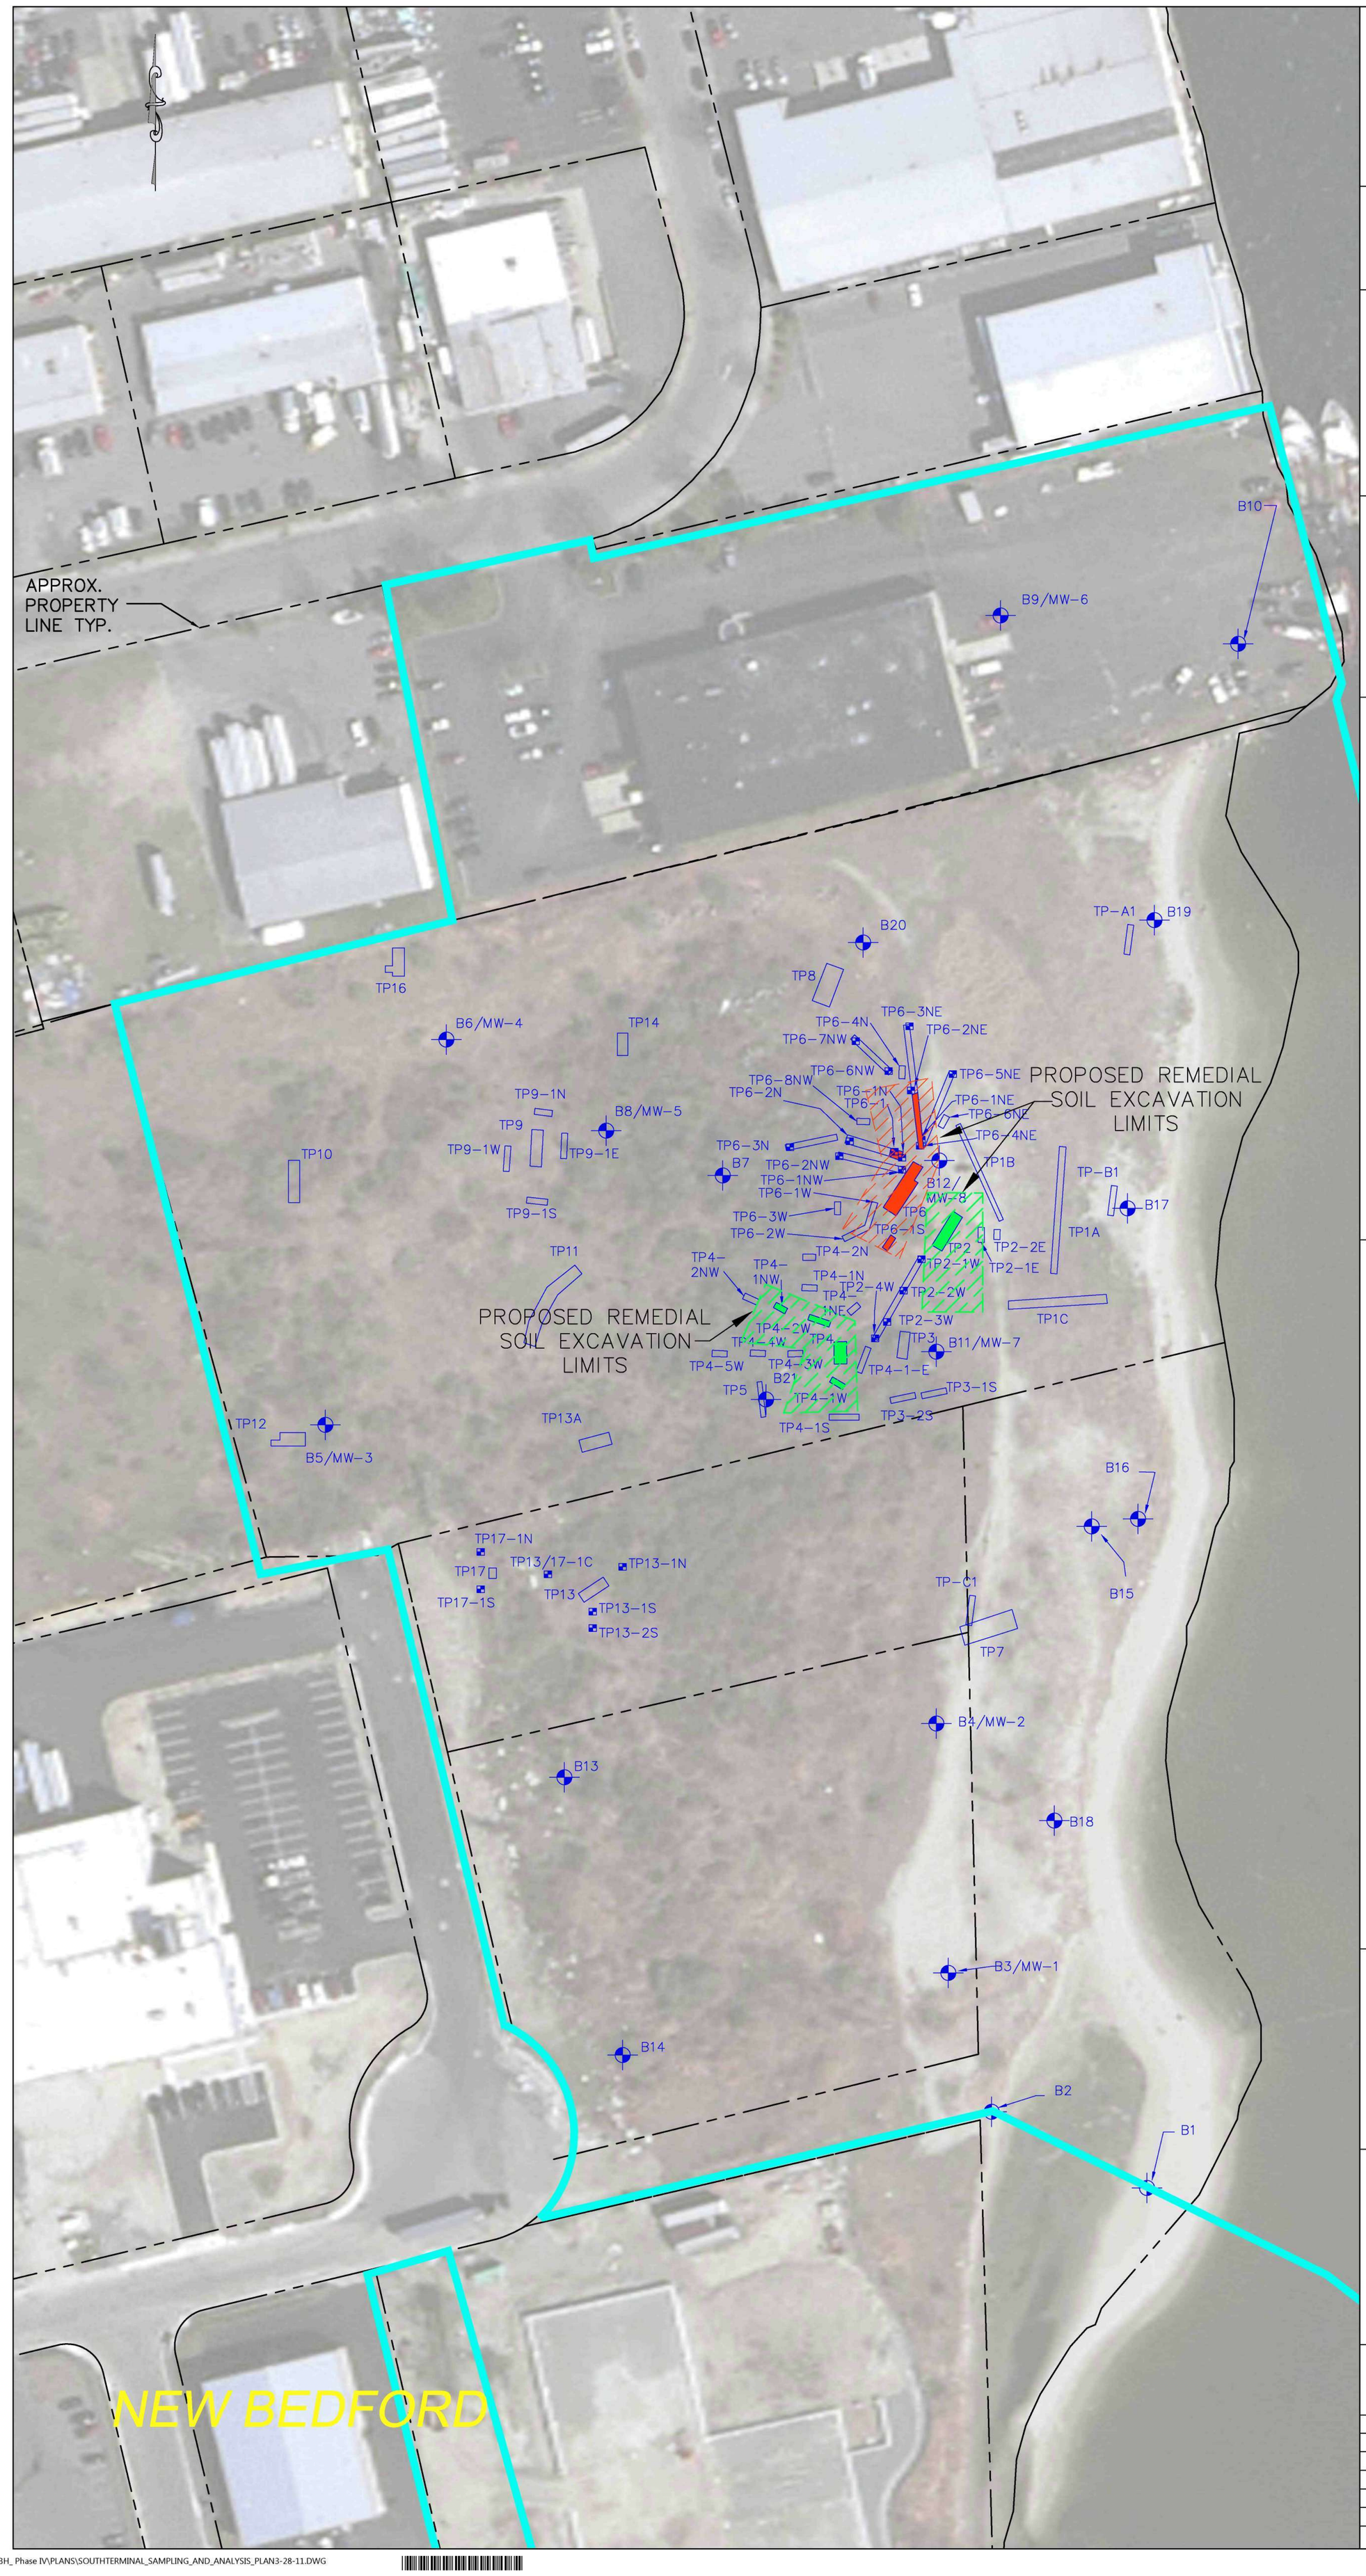

Apex Companies, LLC.

184 HIGH STREET
SUITE 502
BOSTON MA 02110
(617) 728-0070

REVISIONS

#	DATE	DESCRIPTION
1	7/11/11	LAND BORINGS
2	7/12/12	LEGEND CHANGE FOR CLARITY

THESE DRAWINGS PREPARED BY APEX FOR THIS PROJECT ARE INSTRUMENTS OF APEX'S SERVICE FOR USE SOLELY WITH RESPECT TO THIS PROJECT, AND APEX SHALL BE DEEMED THE AUTHOR OF THE DRAWING AND SHALL RETAIN ALL COMMON LAW, STATUTORY AND OTHER RESERVED RIGHTS WITH RESPECT THERETO, INCLUDING COPYRIGHT. THE DOCUMENTS SHALL NOT BE USED ON OTHER PROJECTS, FOR ADDITIONS TO THIS PROJECT OR FOR COMPLETION OF THIS PROJECT BY OTHERS, EXCEPT BY AGREEMENT IN WRITING AND WITH APPROPRIATE COMPENSATION TO APEX.

NOTES:

1. THE PROPOSED BORING LOCATIONS SHOWN HEREON ARE APPROXIMATE.
2. PROPERTY LINES AND OWNERSHIP SHOWN HEREON ARE FOR REFERENCE ONLY AND BASED ON AN ELECTRONIC PLAN PROVIDED BY THOMPSON FARLAND, INC. THIS PLAN IS NOT INTENDED TO BE USED AS A PLAN OF RECORD, OR FOR THE DETERMINATION OF PROPERTY LINES, BOUNDARIES, OR LINES OF OWNERSHIP.
3. BACKGROUND IMAGES SHOWN HEREON ARE PROVIDED COURTESY OF MASSGIS.
4. STRUCTURES AND FEATURES LOCATED BEYOND THE PROJECT LIMITS, ARE TAKEN FROM AN AERIAL SURVEY CONDUCTED BY THE ARMY CORPS OF ENGINEERS AND SHOULD BE CONSIDERED APPROXIMATE.

A-2011-LB-B13 BEDROCK ELEV=-11.2 — UPLAND BORING SHOWING BEDROCK ELEVATION

B9/MW-6 — BORING/MONITORING WELL LOCATION

OVER WATER GEOTECHNICAL BORING

TP6 — LARGE TEST PIT BOUNDARIES

SMALL TEST PIT LOCATION

PROPOSED SOIL EXCAVATION PCB CONCENTRATION > 25 PPM

PROPOSED SOIL EXCAVATION EPH/TPH CONCENTRATION > 10,000 PPM

EXISTING TEST PIT PCB CONCENTRATION > 50 PPM

EXISTING TEST PIT EPH/TPH CONCENTRATION > 10,000 PPM

PREPARED FOR:

MASSACHUSETTS CLEAN ENERGY CENTER

DRAWING TITLE:

NEW BEDFORD MARINE COMMERCE TERMINAL AS-BUILT BORING AND TEST PIT LOCATIONS

Scale: 1"=50'

0 25 50 100 150 FEET

Date	10/28/10
Proj. Mgr.	
Design	CWM
Check	JAB
Drawn	GAD
Job. No.	6690
Last Rev.	11/22/10

Drawing No.

FIG. 1

P:\Jobs\6690 NBH_ Phase IV\PLANS\SOUTHTERMINAL_SAMPLING_AND_ANALYSIS_PLAN3-28-11.DWG

SDMS Doc ID 70005556